

**OHIO TURNPIKE AND  
INFRASTRUCTURE COMMISSION**

**ADDENDUM NO. 1**

**PROJECT NO. 59-16-01**

**REPAIRS AND RESURFACING  
EASTBOUND AND WESTBOUND ROADWAYS  
MILEPOST 38.90 TO MILEPOST 43.30  
FULTON COUNTY, OHIO**

**OPENING DATE: 2:00 P.M. (EASTERN TIME), FEBRUARY 2, 2016**

**ALL BIDS MUST BE ELECTRONICALLY SUBMITTED**

**ATTENTION OF RESPONDENTS IS DIRECTED TO:**

ANSWERS TO QUESTIONS RECEIVED  
THROUGH 5:00 P.M. JANUARY 27, 2016

AND

CHANGES TO THE CONTRACT DOCUMENTS  
PLAN SHEETS 2, 5, 10 and 11 of 11

AND

CHANGES TO THE BID SCHEDULE OF ITEMS


AND

INCLUSION OF STANDARD DRAWING RPM-1

AND

PROVISION OF AS-BUILT DRAWINGS FOR FIBER OPTIC CABLE

Issued by the Ohio Turnpike and Infrastructure Commission on January 28, 2016. Issuance authorized by Anthony D. Yacobucci, Chief Engineer, and Mark R. Musson, Director of Contract Administration.

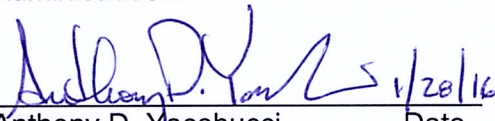  
Anthony D. Yacobucci Date 1/28/16

  
Mark R. Musson Date 1/28/16

**OHIO TURNPIKE AND INFRASTRUCTURE COMMISSION  
ADDENDUM NO. 1  
PROJECT NO. 59-16-01**

**ANSWERS TO QUESTIONS RECEIVED THROUGH 5:00 P.M., JANUARY 27, 2016**

- Q#1** Item SP 402 Asphalt concrete Intermediate course PG 76-22 (FR) on sheet 10 has an ( \* ) directing this all as an contingency quantity. Is this all an contingency item?
- A#1* This Addendum modifies Plan Sheet 10 of 11 to remove the asterisk (\*) from item SP 402 Asphalt Concrete Intermediate Course, PG 76-22 (FR) and revise the quantity from ~~8,420~~ to **7,420** CU.YD. This addendum adds item **SP 402 ASPHALT CONCRETE INTERMEDIATE COURSE, PG 64-22, 1,000 CU.YD.** to Plan Sheet 10 of 11. Additionally, the Bid Form has been modified to correct the quantity for Reference No. 19 from ~~8,420~~ to **7,420** CU.YD. and add Reference No. **62 SP 402 ASPHALT CONCRETE INTERMEDIATE COURSE, PG 64-22, 1,000 CU.YD.** The revised Plan Sheet and Bid Form are included with this Addendum No. 1.
- Q#2** On sheet 5/11, the details for shoulder replacement and shoulder surface repairs both call for an contingent item of SP 402 Asphalt concrete Intermediate course PG 64-22. There is no bid item for Asphalt concrete Intermediate course PG 64-22 listed in the bid items?
- A#2* This Addendum modifies Plan Sheet 5 of 11 to revise TYPICAL SECTION - SHOULDER SURFACE REPAIR detail description for ITEM SP 402 as follows: ASPHALT CONCRETE INTERMEDIATE COURSE, ~~USING CRUSHED STONE~~, PG 64-22. The revised plan sheet is included with this Addendum No. 1. For the addition of the Bid Items, see the response to Q#1.
- Q#3** With the large number of areas to be excavated on this project (1450 locations for Ref 61 Existing Aggregate drain outlet clean out), can the owner provide information on where the utilities are located on this project? Will any of the utilities require that they have a representative on site if your excavating over their line, If so what are their hours?
- A#3* *The Contractor is required to contact the Ohio Utilities Protection Service to locate any utilities within the Project limits. The utility owners will determine the need for any field representatives if it is affected by the proposed work. The Commission is also providing as-built drawings, in accordance with IB Art. 2.1.4 for information purposes only, showing the approximate location of the fiber optic cable in the right of way. However, the Plan Note for Item SPECIAL - EXISTING AGGREGATE DRAIN OUTLET CLEAN OUT on Plan Sheet 2 of 11 is modified so that the work will only be performed on the right/outside shoulder, and the associated quantity on Plan Sheet 10 of 11 and Reference No. 61 on the Bid Form have been revised from ~~44,500~~ SQ. YD. to **7,250** SQ. YD.*
- Q#4** Ref # 19 SP402 Asphalt Intermediate course PG76-22 (FR). Is crushed aggregate allowed in this mix or is crushed Slag to be used?

A#4 Per SP 400 at Article II. (C)(1)(a), the course aggregate can consist of crushed carbonate stone or crushed air cooled blast furnace slag, whichever the Contractor prefers. Accordingly, crushed stone is permitted for Reference No. 19 SP 402 ASPHALT CONCRETE INTERMEDIATE COURSE, PG 76-22 (FR).

**Q#5 Can the as-built drawings for the fiber optic be provided to bidders. Per the specifications, the location of the fiber optic was to be shown in the plans. There is nothing that shows this location within the plans.**

A#5 Plans showing the approximate location of the QWEST fiber optic cable within the limits of the Project are being made available with this Addendum No. 1.

**Q#6 Per OTIC SD TCR -2, Will a barrier vehicle be required at each crew work location within one continuous closure, or does one barrier vehicle at the beginning of closed lane suffice coverage for all crews working within said closure?**

A#6 A barrier vehicle and flagger is needed 100' prior to each work area.

### **MODIFICATIONS TO THE CONTRACT DOCUMENTS**

The following changes are made to the Contract Documents for Contract No. 59-16-01:

Modifications to the Plan Drawings: Additions are called out with a cloud and deletions are marked with a revision triangle as thus:



Plan Sheets 2, 5 and 10 of 11 are modified as described in the responses to the questions above.

Plan Sheet 11 of 11 is modified to insert a Note for **ITEM SPECIAL - LONGITUDINAL JOINT STABILIZER, POLYMER EMULSION.**

The Bid Form is modified as described in response to Q#1 and Q#3, and as described in the new Note on Plan Sheet 11 of 11.

This Addendum No. 1 also serves to furnish Standard Drawing RPM-1 to the plan holders, and as-built plans for the fiber optic cable.


Addendum No. 1 to Contract 59-16-01 is hereby acknowledged:

\_\_\_\_\_  
(Firm Name)

\_\_\_\_\_  
(Signature)

\_\_\_\_\_  
(Printed Name)

Date: \_\_\_\_\_

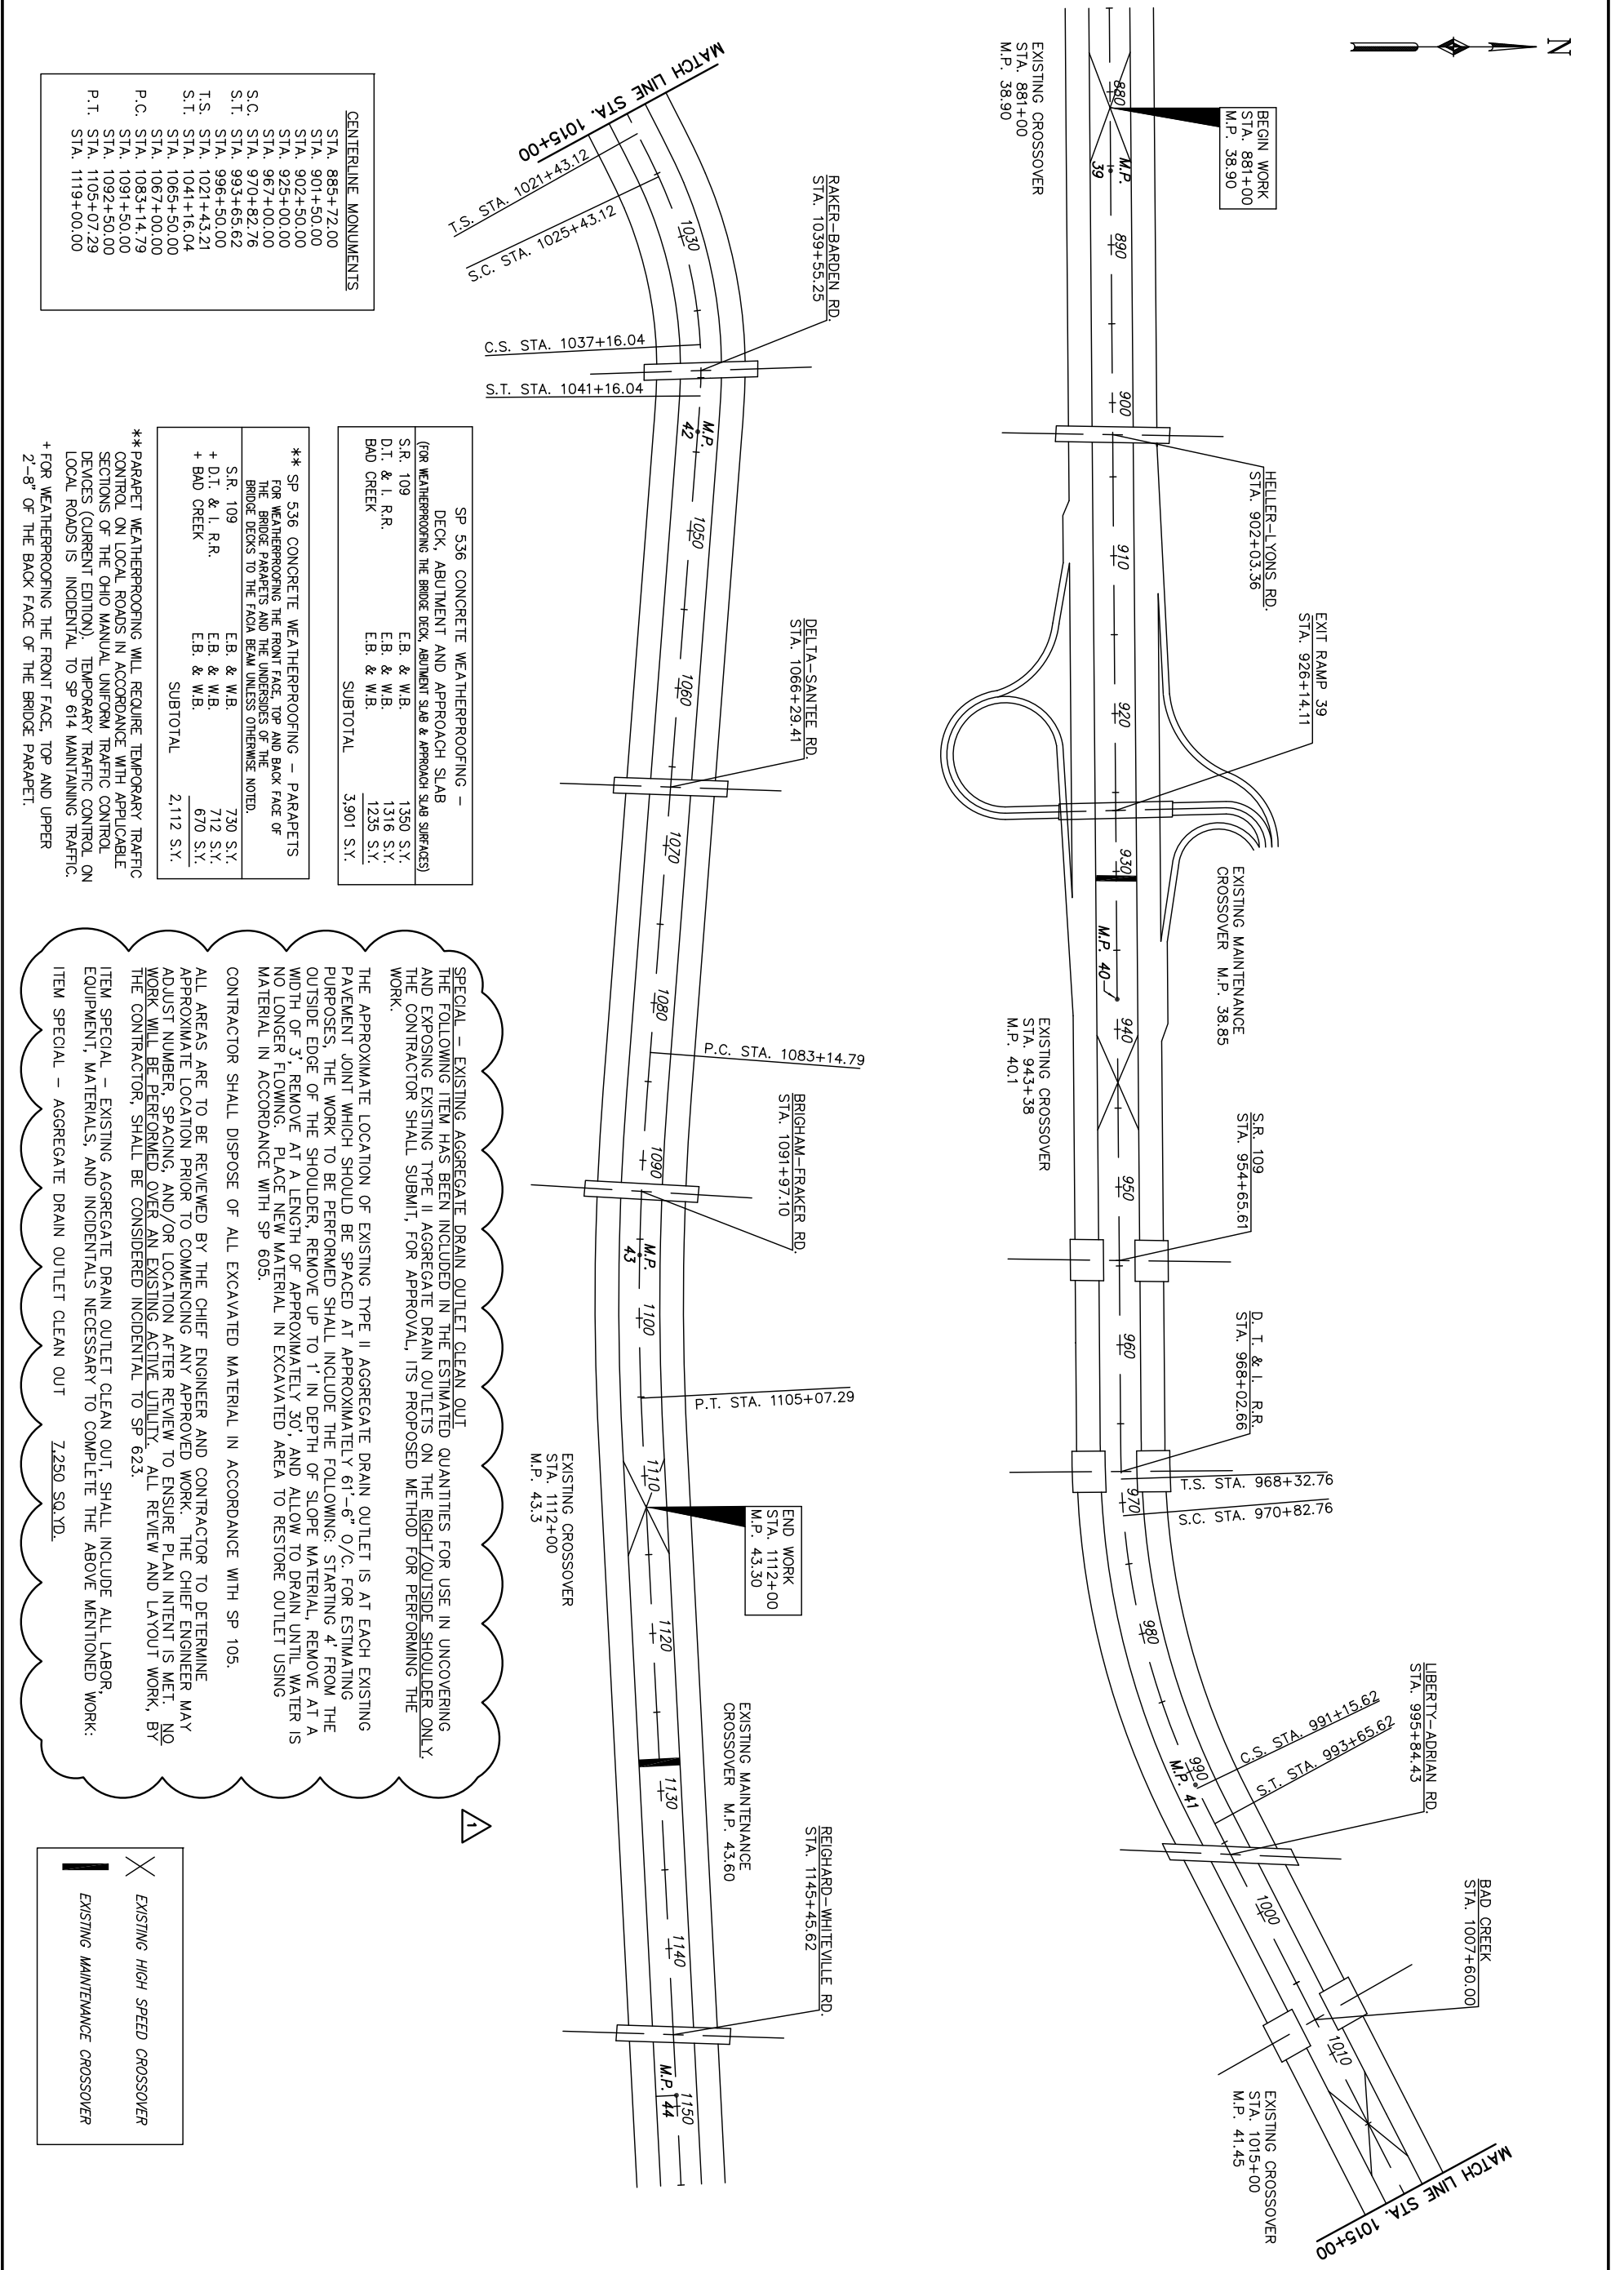

**CENTERLINE MONUMENTS**

STA. 885+72.00
STA. 901+50.00
STA. 902+50.00
STA. 923+00.00
STA. 967+00.00
STA. 970+82.76
STA. 993+65.62
STA. 996+50.00
STA. 1021+43.21
STA. 1041+16.04
STA. 1065+50.00
STA. 1067+00.00
STA. 1083+14.79
STA. 1091+50.00
STA. 1092+50.00
STA. 1105+07.29
STA. 1119+00.00

**SP 536 CONCRETE WEATHERPROOFING - DECK, ABUTMENT AND APPROACH SLAB (FOR WEATHERPROOFING THE BRIDGE DECK, ABUTMENT SLAB & APPROACH SLAB SURFACES)**

S.R. 109	E.B. & W.B.	1350 S.Y.
D.T. & I. R.R.	E.B. & W.B.	1316 S.Y.
BAD CREEK	E.B. & W.B.	1235 S.Y.
<b>SUBTOTAL</b>		<b>3,901 S.Y.</b>

**\*\* SP 536 CONCRETE WEATHERPROOFING - PARAPETS (FOR WEATHERPROOFING THE FRONT FACE, TOP AND BACK FACE OF THE BRIDGE PARAPETS AND THE UNDERSIDES OF THE BRIDGE DECKS TO THE FACE BEAM UNLESS OTHERWISE NOTED).**

S.R. 109	E.B. & W.B.	730 S.Y.
D.T. & I. R.R.	E.B. & W.B.	712 S.Y.
BAD CREEK	E.B. & W.B.	670 S.Y.
<b>SUBTOTAL</b>		<b>2,112 S.Y.</b>

\*\* PARAPET WEATHERPROOFING WILL REQUIRE TEMPORARY TRAFFIC CONTROL ON LOCAL ROADS IN ACCORDANCE WITH APPLICABLE SECTIONS OF THE OHIO MANUAL UNIFORM TRAFFIC CONTROL DEVICES (CURRENT EDITION). TEMPORARY TRAFFIC CONTROL ON LOCAL ROADS IS INCIDENTAL TO SP 614 MAINTAINING TRAFFIC. + FOR WEATHERPROOFING THE FRONT FACE, TOP AND UPPER 2'-8" OF THE BACK FACE OF THE BRIDGE PARAPET.

**SPECIAL - EXISTING AGGREGATE DRAIN OUTLET CLEAN OUT**  
 THE FOLLOWING ITEM HAS BEEN INCLUDED IN THE ESTIMATED QUANTITIES FOR USE IN UNCOVERING AND EXPOSING EXISTING TYPE II AGGREGATE DRAIN OUTLETS ON THE RIGHT/OUTSIDE SHOULDER ONLY. THE CONTRACTOR SHALL SUBMIT, FOR APPROVAL, ITS PROPOSED METHOD FOR PERFORMING THE WORK.


THE APPROXIMATE LOCATION OF EXISTING TYPE II AGGREGATE DRAIN OUTLET IS AT EACH EXISTING PAVEMENT JOINT WHICH SHOULD BE SPACED AT APPROXIMATELY 61'-6" O/C. FOR ESTIMATING PURPOSES, THE WORK TO BE PERFORMED SHALL INCLUDE THE FOLLOWING: STARTING 4' FROM THE OUTSIDE EDGE OF THE SHOULDER, REMOVE UP TO 1' IN DEPTH OF SLOPE MATERIAL, REMOVE AT A WIDTH OF 3', REMOVE AT A LENGTH OF APPROXIMATELY 30', AND ALLOW TO DRAIN UNTIL WATER IS NO LONGER FLOWING. PLACE NEW MATERIAL IN EXCAVATED AREA TO RESTORE OUTLET USING MATERIAL IN ACCORDANCE WITH SP 605.

CONTRACTOR SHALL DISPOSE OF ALL EXCAVATED MATERIAL IN ACCORDANCE WITH SP 105.


ALL AREAS ARE TO BE REVIEWED BY THE CHIEF ENGINEER AND CONTRACTOR TO DETERMINE APPROXIMATE LOCATION PRIOR TO COMMENCING ANY APPROVED WORK. THE CHIEF ENGINEER MAY ADJUST NUMBER, SPACING, AND/OR LOCATION AFTER REVIEW TO ENSURE PLAN INTENT IS MET. NO WORK WILL BE PERFORMED OVER AN EXISTING ACTIVE UTILITY. ALL REVIEW AND LAYOUT WORK, BY THE CONTRACTOR, SHALL BE CONSIDERED INCIDENTAL TO SP 623.

ITEM SPECIAL - EXISTING AGGREGATE DRAIN OUTLET CLEAN OUT, SHALL INCLUDE ALL LABOR, EQUIPMENT, MATERIALS, AND INCIDENTALS NECESSARY TO COMPLETE THE ABOVE MENTIONED WORK.


ITEM SPECIAL - AGGREGATE DRAIN OUTLET CLEAN OUT 2,250 SQ.YD.

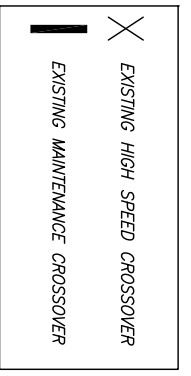


<table border="1"> <tr><td>2</td></tr> <tr><td>11</td></tr> </table>	2	11	PROJECT 59-16-01	RESURFACING PLAN STA. 881+00 TO STA. 1112+00	DESIGNED JJS	CHECKED TWB	NO. 1	REVISIONS ADDENDUM NO. 1	BY JJS	DATE 1/28/16	DESIGN AGENCY
	2										
11											
DRAWN JJS	IN CHARGE DCA	.	.	.	.	.	.				

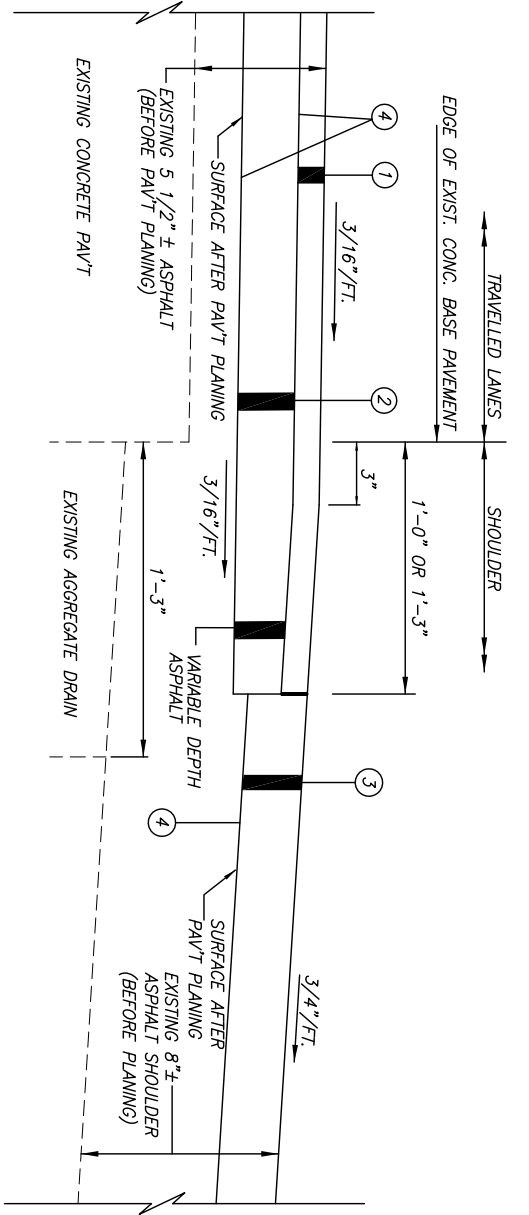


DETAIL 'A' - AT OUTSIDE EDGE OF PAVEMENT - NORMAL SECTION

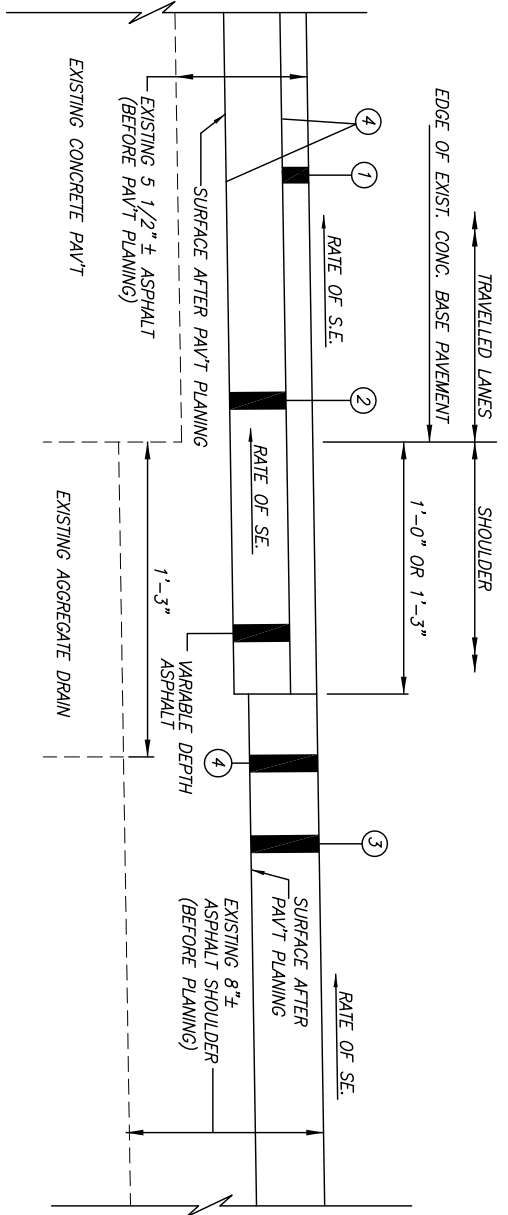

DETAIL 'B' - AT OUTSIDE EDGE OF PAVEMENT - HIGH SIDE - SUPERELEVATED SECTION FOR LOW SIDE SUPERELEVATED SECTION - SEE DETAIL 'C'

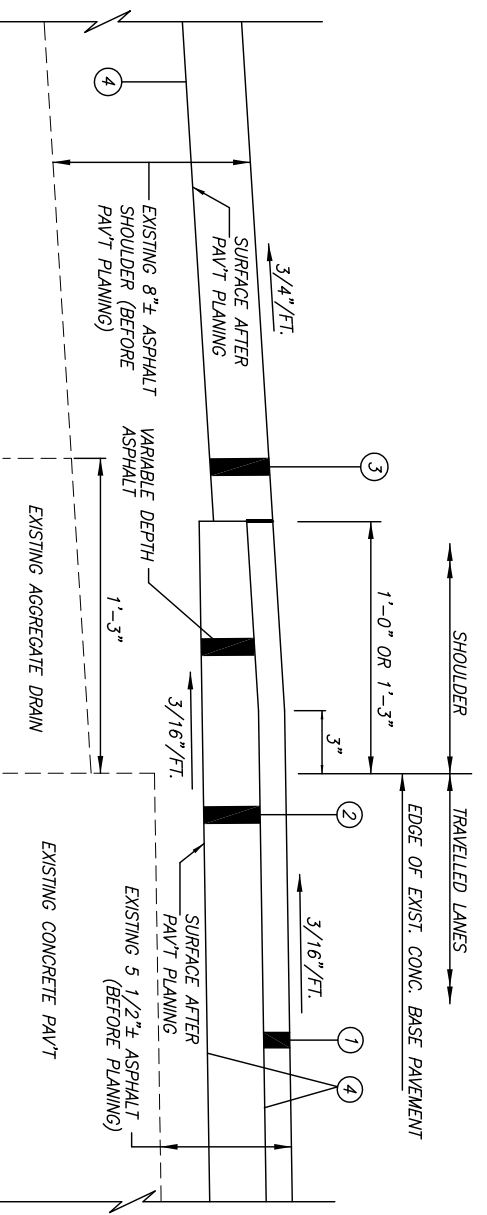


DETAIL 'C' - AT MEDIAN EDGE OF PAVEMENT - NORMAL SECTION

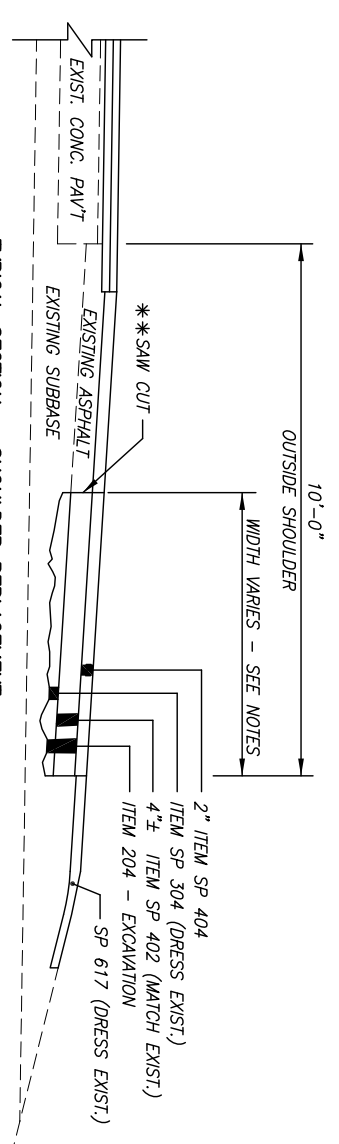

TYPICAL SECTION - SHOULDER REPLACEMENT

EXISTING PAVED SHOULDERS THAT HAVE DETERIORATED SHALL BE REMOVED AND REPLACED, AS DIRECTED BY THE ENGINEER, IN ACCORDANCE WITH THE ABOVE SECTION. DETERMINATION OF SHOULDER REPLACEMENT AREAS WILL BE MADE BY THE ENGINEER AFTER PAVEMENT PLANNING IS COMPLETE AND PRIOR TO RESURFACING. THE FOLLOWING **CONTINGENCY QUANTITIES** HAVE BEEN INCLUDED IN THE PROPOSAL TO BE USED AS DIRECTED BY THE ENGINEER.

- ITEM 204 - EXCAVATION OF SUBGRADE 333 C.Y.
- ITEM 204 - SUBGRADE COMPACTION 1000 S.Y.
- ITEM SP 304 - AGGREGATE BASE 167 C.Y.
- ITEM SP 402 - ASPHALT CONCRETE INTERMEDIATE COURSE, PG 64-22 500 C.Y.
- \*\* REMOVE TO A NEAT LINE BY SAW CUTTING OR OTHER APPROVED METHOD (INCIDENTAL TO THE PROJECT).

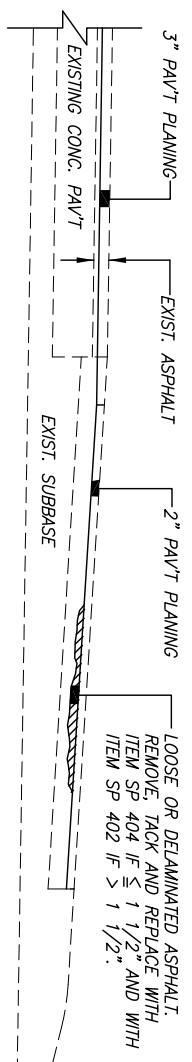


TYPICAL SECTION - SHOULDER SURFACE REPAIRS

LOOSE OR DELAMINATED ASPHALT THAT MAY BE PRESENT ON THE PAVED SHOULDER SURFACE, AFTER MILLING, SHALL BE REMOVED AND REPLACED AS DIRECTED BY THE ENGINEER AND IN ACCORDANCE WITH THE ABOVE SECTION PRIOR TO RESURFACING. THE FOLLOWING **CONTINGENCY QUANTITIES** PROPOSAL TO BE USED AS DIRECTED BY THE ENGINEER.

- ITEM 254 - PAVEMENT PLANNING, ASPHALT CONCRETE 11733 S.Y.
- \* ITEM SP 404 - ASPHALT CONCRETE SURFACE COURSE, USING 500 C.Y.
- ITEM SP 402 - ASPHALT CONCRETE INTERMEDIATE COURSE, PG 64-22 500 C.Y.
- SPECIAL - THICKNESS TACK 940 GAL.

\* THIS QUANTITY MAY ALSO BE USED FOR LEVELING LOW AREAS IN THE PAVED SHOULDERS INCLUDING TYPE II UNDERDRAINS THAT MAY HAVE SETTLED AND FOR LEVELING LOW AREAS ≤ 1" REMAINING OVER THE MAINLINE CONCRETE PAVEMENT AFTER COMPLETION OF THE MILLING OPERATION.

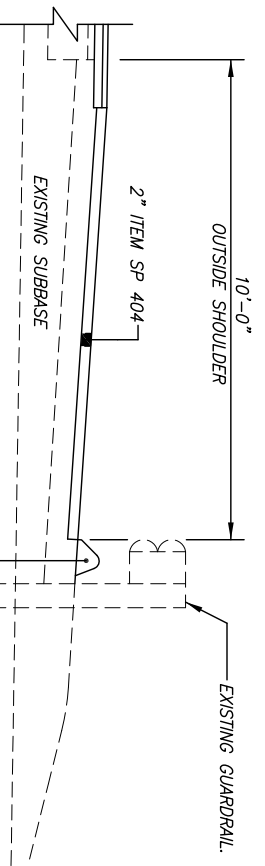

TYPICAL SECTION - CURB REPLACEMENT DETAIL

SEE PREVIOUS SHEET FOR LEGEND AND NOTES

DESIGNED JJS	CHECKED TWB	NO.	REVISIONS	BY	DATE	DESIGN AGENCY
			ADDENDUM NO. 1			
DRAWN JJS	IN CHARGE DCA	.	.	.	.	.

ESTIMATED QUANTITY		ITEM DESCRIPTION
ITEM	TOTAL	UNIT
IB. ART. 6	1	LUMP
SP 623	1	LUMP
202	1000	FOOT
202	3000	FOOT
202	123.33	SQ. YD.
SP 202B	20	CU YD.
SP 202B	2,000	GALLON
SP 202B	20	CU YD.
SP 202B	20	CU YD.
SP 202B	20	CU YD.
SP 202B	20	CU YD.
204	383	CU YD.
204	50	CU YD.
204	1300	SQ. YD.
254	154,610	SQ. YD.
254	103,429	SQ. YD.
254	740	SQ. YD.
SP 304	217	CU YD.
SP 402	1,000	CU YD.
SP 402	7,420	CU YD.
SP 404	5,300	CU YD.
SP 404	5,708	CU YD.
SP 404A	99,776	FOOT
SPECIAL	28,940	GALLON
SP 451	346.67	SQ. YD.
SP 526	123.33	SQ. YD.
SP 536	3,901	SQ. YD.
SP 536	2,112	SQ. YD.
604	5	EACH
604	5	EACH
SP 605	600	FOOT
606	3,000	FOOT
606	1,000	FOOT
606	3	EACH
606	3	EACH
609	200	FOOT
SP 614	1	LUMP
SP 614	2,112	HOURS
614	50	CU YD.
614	19	MILE
614	1,000	FOOT
617	21,800	SQ. YD.
SP 617	1,820	CU YD.
617	50	M. GAL.
619	1	LUMP
621	757	EACH
SP 621	757	EACH
624	1	LUMP
SP 626	200	EACH
SP 626	20	EACH
SP 627	700	CU YD.
SP 641C	30.00	MILE
642	11.40	MILE
642	11.40	MILE
642	11.40	MILE
642	2,000	FOOT
642	4,000	FOOT
SPECIAL	0.60	MILE
SPECIAL	18.40	MILE
SPECIAL	7,250	SQ. YD.
SPECIAL	1,200	GALLON

\* CONTINGENCY QUANTITY TO BE USED AS DIRECTED BY CHIEF ENGINEER (SEE GENERAL NOTES),  
 \*\* PORTION OF THIS ITEM IS CONTINGENCY QUANTITY (SEE GENERAL NOTES).

	<b>10</b> PROJECT 59-16-01	<b>ESTIMATED QUANTITIES</b>	DESIGNED JJS	CHECKED TWB	NO. 1	REVISIONS ADDENDUM NO. 1	BY JJS	DATE 1/28/16	DESIGN AGENCY
	<b>11</b>		DRAWN JJS	IN CHARGE DCA	.	.	.	.	

OHIO TURNPIKE AND INFRASTRUCTURE COMMISSION

APPROX MILEPOST	LANE		FULL DEPTH PAVEMENT REPAIRS (ASPHALT)	SP 451 S.Y.
	RIGHT	LEFT		
	X		13.33	
	X		26.67	
	X	X	53.33	
	X		13.33	
	X	X	53.33	
	X	X	53.33	
	X	X	53.33	
	X		26.67	
<b>EB</b>				
	X		26.67	
	X		26.67	
		<b>TOTAL</b>		346.67

FULL DEPTH REPAIR NOTE(S):

- 1.-ALL FULL DEPTH REPAIRS EXCAVATED DURING A WORK SHIFT SHALL BE FILLED TO THE MILLED SURFACE DURING THAT SAME WORK SHIFT. NO REPAIR SHALL BE LEFT OPEN BEYOND THE END OF THE SHIFT. THE CONTRACTOR SHALL PLAN ITS OPERATIONS ACCORDINGLY.
- 2.-ALL FULL DEPTH REPAIRS ARE APPROXIMATE AND MAY BE ADJUSTED BY THE CHIEF ENGINEER.

APPROX MILEPOST OF BRIDGE	APPROACH SLAB LOCATION IN DIRECTION OF TRAVEL		CLASS C CONCRETE, APPROACH SLAB, USING TYPE I CEMENT (12")	SP 526 S.Y.	APPROACH SLAB REMOVED	202 S.Y.
	LEAD	TRAIL				
	X		61.67		61.67	
	X		61.67		61.67	
		<b>TOTAL</b>		123.33		123.33

APPROACH SLAB REPAIR NOTE(S):

APPROACH SLAB REMOVAL AND REPLACEMENT PERFORMED DURING A WORK SHIFT SHALL BE COMPLETED DURING THAT SAME WORK SHIFT. NO REPAIR SHALL BE LEFT OPEN BEYOND END OF THE SHIFT. ALL PLANNING, LABOR, EQUIPMENT, MATERIALS AND INCIDENTALS NEEDED TO INSURE THE WORK IS COMPLETED DURING THE WORK SHIFT SHALL BE CONSIDERED INCIDENTAL TO THE ITEM.

**SPECIAL - TRACKLESS TACK**  
 DESCRIPTION: THIS WORK CONSISTS OF PREPARING AND TREATING A MILLED SURFACE WITH NTSS-1HM TRACKLESS TACK PRODUCED BY BLACKIDGE EMULSIONS, INC., AE-NT NO TRACK TACK PRODUCED BY K-TECH SPECIALTY COATINGS, INC., OR APPROVED EQUAL BY THE CHIEF ENGINEER. THE PRODUCT SHALL MEET ALL REQUIREMENTS OF ITEM 407 TACK COAT EXCEPT AS NOTED BELOW;

**MATERIAL:** CONFORM TO THE FOLLOWING TYPICAL PHYSICAL PROPERTIES:

PARAMETER	TEST METHOD	MIN.	MAX.
SAYBOLT FURUL VISCOSITY, SFS @ 25C	AASHTO T59	15	100
STORAGE STABILITY, 5 DAYS, %	AASHTO T59	--	5
RESIDUE BY DISTILLATION, %	AASHTO T59	50	--
OIL DISTILLATE, %	AASHTO T59	--	1
SIEVE TEST, %	AASHTO T59	--	0.30
TEST ON RESIDUE:			
PENETRATION, @ 25C	AASHTO T49	--	25
SOFTENING POINT RANGE DEG C	AASHTO T53	65	--
SOLUBILITY,%	AASHTO T44	97.5	--

NOTE: PRODUCT SHOULD NOT CONTAIN FILLER SUCH AS CLAY, ETC. KEEP FROM FREEZING. SUPPLY CERTIFIED TEST DATA FROM AN INDEPENDENT LAB TO THE ENGINEER SHOWING THE MATERIAL SUPPLIED WAS TESTED FOR AND MEETS THE ABOVE PROPERTIES.

EQUIPMENT: ALL REQUIREMENTS OF 407.03 APPLY. SEE MANUFACTURER'S REPRESENTATIVE FOR CORRECT DISTRIBUTOR SETTINGS. THOROUGHLY CLEAN ALL EQUIPMENT IF CATIONIC EMULSION WAS PREVIOUSLY USED.

**WEATHER LIMITATIONS:** ALL REQUIREMENTS OF 407.04 APPLY.

**PREPARATION OF SURFACE:** ALL REQUIREMENTS OF 407.05 APPLY.

**APPLICATION OF ASPHALT MATERIAL:** UNIFORMLY APPLY THE ASPHALT MATERIAL WITH A DISTRIBUTOR PER THE REQUIREMENTS OF 407.06 EXCEPT AS NOTED. IF PRODUCT IS STORED FOR AN EXTENDED PERIOD OF TIME, PRIOR TO APPLICATION, AGITATE OR GENTLY CIRCULATE THE MATERIAL. ALL NOZZLES AND SPRAY PATTERNS SHALL BE IDENTICAL TO ONE ANOTHER ALONG THE DISTRIBUTOR SPRAY BAR. THE ANGLE OF THE NOZZLE SHOULD BE A 15 TO 30 DEGREE ANGLE TO THE SPRAY BAR AXIS TO MAXIMIZE OVERLAP OR AS RECOMMENDED BY THE NOZZLE MANUFACTURER. CONTACT THE MANUFACTURER'S REPRESENTATIVE FOR REQUIRED SPRAY NOZZLE SIZE, AND DISTRIBUTOR AND NOZZLE SETTINGS. APPLY AT A RATE OF 0.075 GALLONS PER SQUARE YARD TO ALL MILLED SURFACES AND AT A RATE OF 0.06 GALLONS PER SQUARE YARD TO ALL SMOOTH PAVED SURFACES AND BETWEEN COURSES OF ASPHALT. RECOMMENDED APPLICATION TEMPERATURE IS 160 F. TO 180 F. DO NOT EXCEED 180 F. DILUTION IS NOT ALLOWED.

THE ENGINEER AND MANUFACTURER'S REPRESENTATIVE WILL APPROVE RATE OF APPLICATION, TEMPERATURE, DISTRIBUTOR SETTINGS, AND AREAS TO BE TREATED BEFORE APPLICATION OF THE TACK COAT. THE ENGINEER WILL DETERMINE THE ACTUAL APPLICATION IN GALLONS PER SQUARE YARD BY A CHECK ON THE PROJECT. THE APPLICATION IS CONSIDERED SATISFACTORY WHEN THE MATERIAL IS APPLIED UNIFORMLY WITH NO VISIBLE EVIDENCE OF STREAKING OR RIDGING AND THE APPLICATION RATE IS ±10% OF THE SPECIFIED RATE.

**METHOD OF MEASUREMENT:** ALL REQUIREMENTS OF 407.07 APPLY.

**BASIS OF PAYMENT:** ALL REQUIREMENTS OF 407.08 APPLY.

**ITEM 254 - PAVEMENT PLANNING, PORTLAND CEMENT CONCRETE, AS PER PLAN**  
 THIS CONTINGENCY ITEM CONSISTS OF PAVEMENT PLANNING OF CONCRETE APPROACH AND/OR ABUTMENT SLABS WITH DIAMOND BLADES ONLY. THIS QUANTITY IS INTENDED TO BE UTILIZED TO MEET PAVEMENT SMOOTHNESS. A QUANTITY OF 240 SQ.YD. IS INCLUDED IN THE ESTIMATED QUANTITIES TO BE USED AS DIRECTED BY THE CHIEF ENGINEER OR AS INDICATED IN THE PLANS.

PAYMENT FOR ALL LABOR, EQUIPMENT AND MATERIALS NECESSARY FOR THE ABOVE MENTIONED WORK SHALL BE DEPENDANT ON AND IN ACCORDANCE WITH EITHER ITEM 254-PAVEMENT PLANNING, PORTLAND CEMENT CONCRETE, AS PER PLAN.



**ITEM SPECIAL - LONGITUDINAL JOINT STABILIZER, POLYMER EMULSION**


THIS ITEM SHALL CONSIST OF SUPPLYING AND PLACING APPROXIMATELY 1,200 GALLON OF A POLYMERIZED EMULSION. THE POLYMERIZED EMULSION SHALL BE JOINTBOND AS MANUFACTURED BY D & D EMULSIONS OR APPROVED EQUAL BY THE CHIEF ENGINEER.

THE POLYMERIZED EMULSION SHALL BE APPLIED 36" WIDE AND CENTERED ON THE LONGITUDINAL JOINT BETWEEN THE RIGHT AND LEFT LANE (ORIGINAL CROWN LINE). THE POLYMERIZED EMULSION SHALL BE PLACED AFTER THE SP 404 SURFACE COURSE IS COMPLETE AND IN PLACE (BOTH LANES PAVED) AND SHALL BE APPLIED TO THE LONGITUDINAL JOINT IN ACCORDANCE WITH THE MANUFACTURERS RECOMMENDATIONS AND SPECIFICATIONS. THE APPROXIMATE APPLICATION RATE OF 0.08 GALLON/SQ.YD. SHALL BE USED UNLESS MODIFIED BY THE MANUFACTURER.


PAYMENT FOR THIS ITEM SHALL BE AT THE CONTRACT UNIT PRICE PER SQUARE YARD FURNISHED, INSTALLED AND ACCEPTED BY THE CHIEF ENGINEER, AND SHALL INCLUDE ALL LABOR, EQUIPMENT AND MATERIALS, TRAFFIC CONTROL, AND INCIDENTALS NECESSARY TO COMPLETE THIS ITEM.

DESIGNED JJS	CHECKED TWB	NO.	REVISIONS	BY	DATE	DESIGN AGENCY	PROJECT 59-16-01	SUB-SUMMARY AND MISCELLANEOUS NOTES	11
									11
DRAWN JJS	IN CHARGE DCA	1	ADDENDUM NO. 1	JJS	1/28/16				

### 3 LANE PLAN

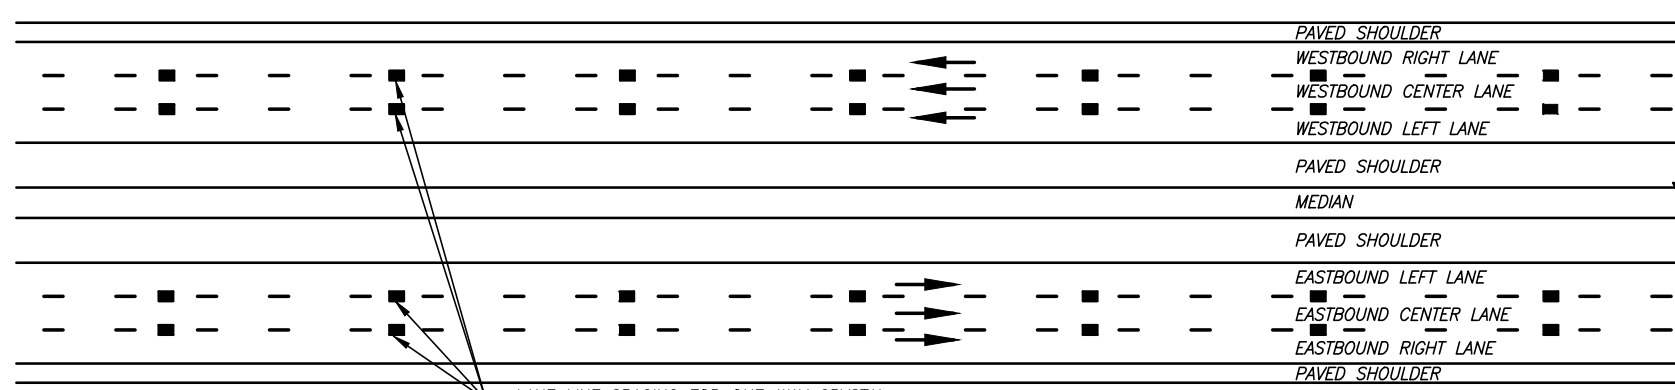


### 2 LANE PLAN

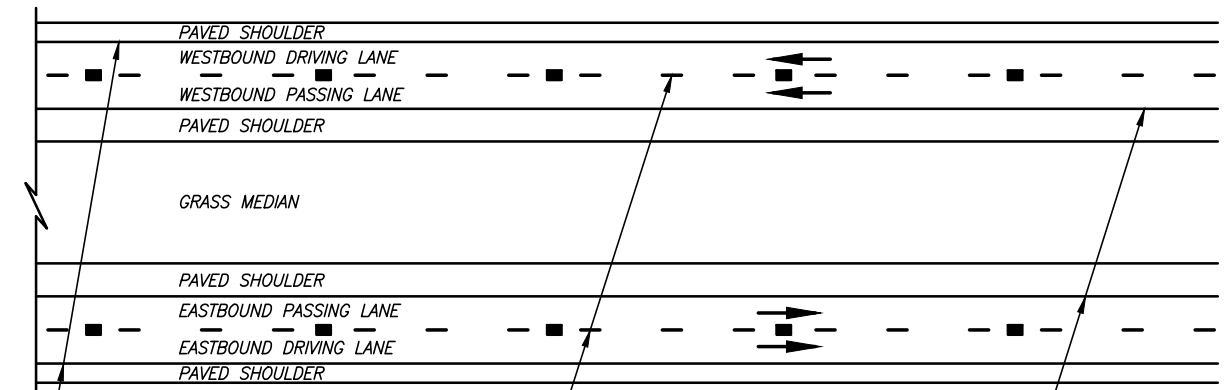


LANE LINE SPACING FOR ONE-WAY CRYSTAL (WHITE) RAISED PAVEMENT MARKERS AT 120' C/C IN TANGENT SECTIONS AND 80' C/C ON ALL CURVES. SEE BELOW FOR RPM PLACEMENT RELATIVE TO CENTERLINE AND BASE PAVEMENT OF ROADWAY.

### MAINLINE RAISED PAVEMENT MARKER AND LANE LINE LAYOUT


NOT TO SCALE

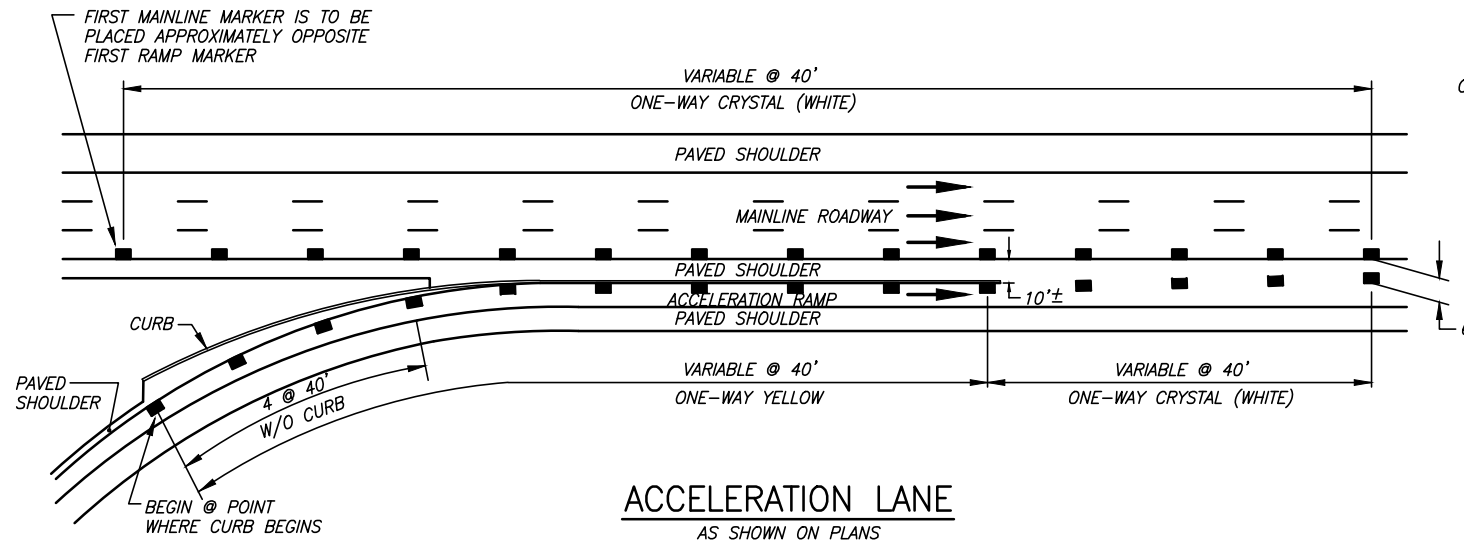


### ACCELERATION LANE AS SHOWN ON PLANS

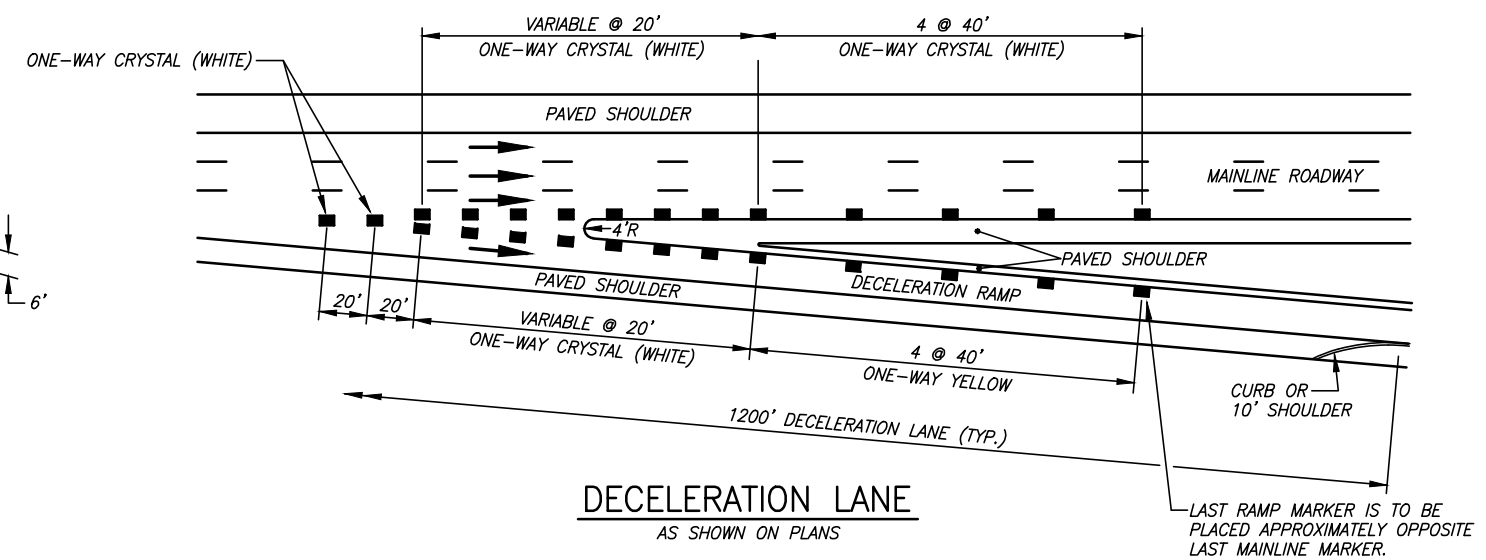

### DECELERATION LANE AS SHOWN ON PLANS

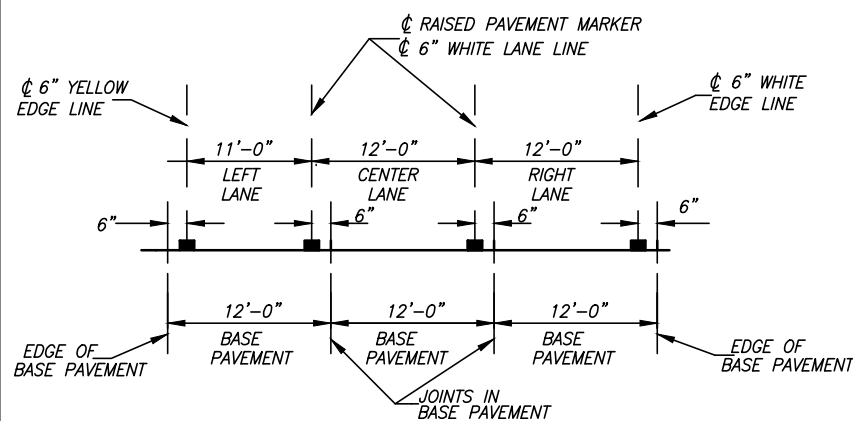

### 3 LANE STRIPING AND RPM PLACEMENT

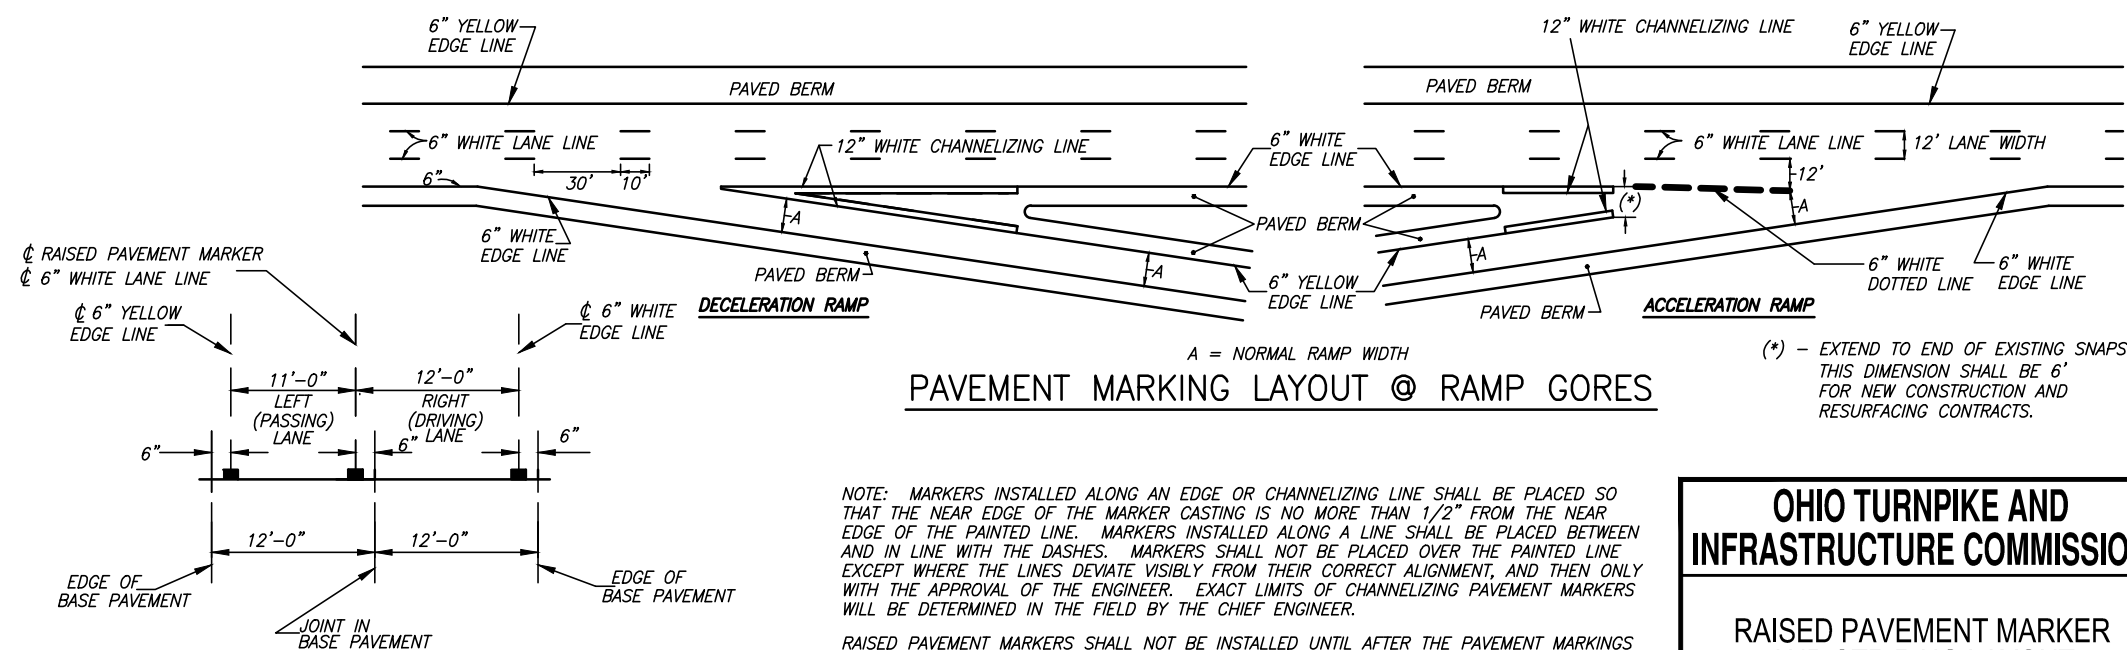

### 2 LANE STRIPING AND RPM PLACEMENT

### PAVEMENT MARKING LAYOUT @ RAMP GORES

NOTE: MARKERS INSTALLED ALONG AN EDGE OR CHANNELIZING LINE SHALL BE PLACED SO THAT THE NEAR EDGE OF THE MARKER CASTING IS NO MORE THAN 1/2" FROM THE NEAR EDGE OF THE PAINTED LINE. MARKERS INSTALLED ALONG A LINE SHALL BE PLACED BETWEEN AND IN LINE WITH THE DASHES. MARKERS SHALL NOT BE PLACED OVER THE PAINTED LINE EXCEPT WHERE THE LINES DEVIATE VISIBLY FROM THEIR CORRECT ALIGNMENT, AND THEN ONLY WITH THE APPROVAL OF THE ENGINEER. EXACT LIMITS OF CHANNELIZING PAVEMENT MARKERS WILL BE DETERMINED IN THE FIELD BY THE CHIEF ENGINEER.

RAISED PAVEMENT MARKERS SHALL NOT BE INSTALLED UNTIL AFTER THE PAVEMENT MARKINGS ARE IN PLACE, UNLESS APPROVED OTHERWISE BY THE CHIEF ENGINEER.

SEE SP 626 FOR RAISED PAVEMENT MARKERS SPECIFICATIONS.

## OHIO TURNPIKE AND INFRASTRUCTURE COMMISSION

### RAISED PAVEMENT MARKER AND STRIPING LAYOUT

DATE: DECEMBER 21, 2011 | SCALE: N.T.S.  
O.T.I.C. STANDARD DRAWING | RPM-1