
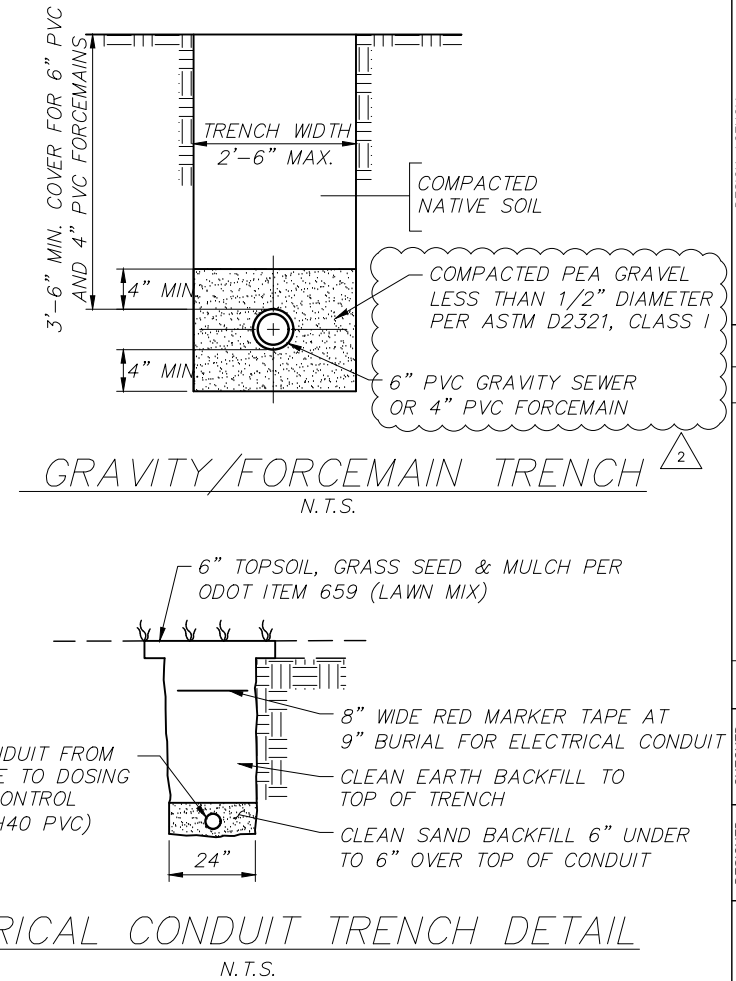
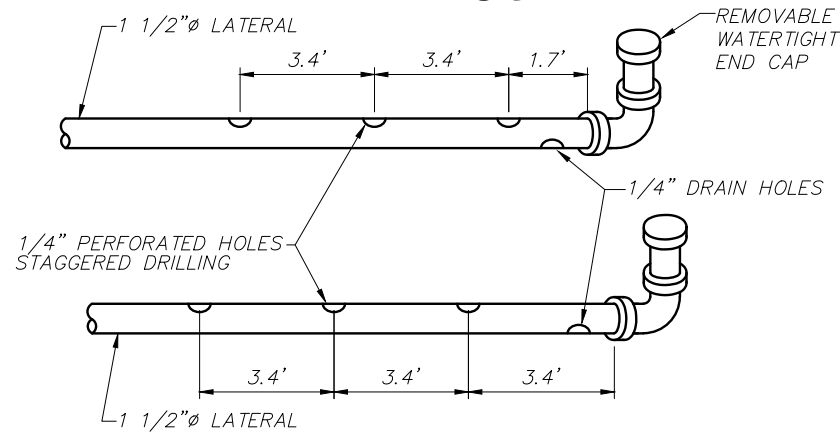
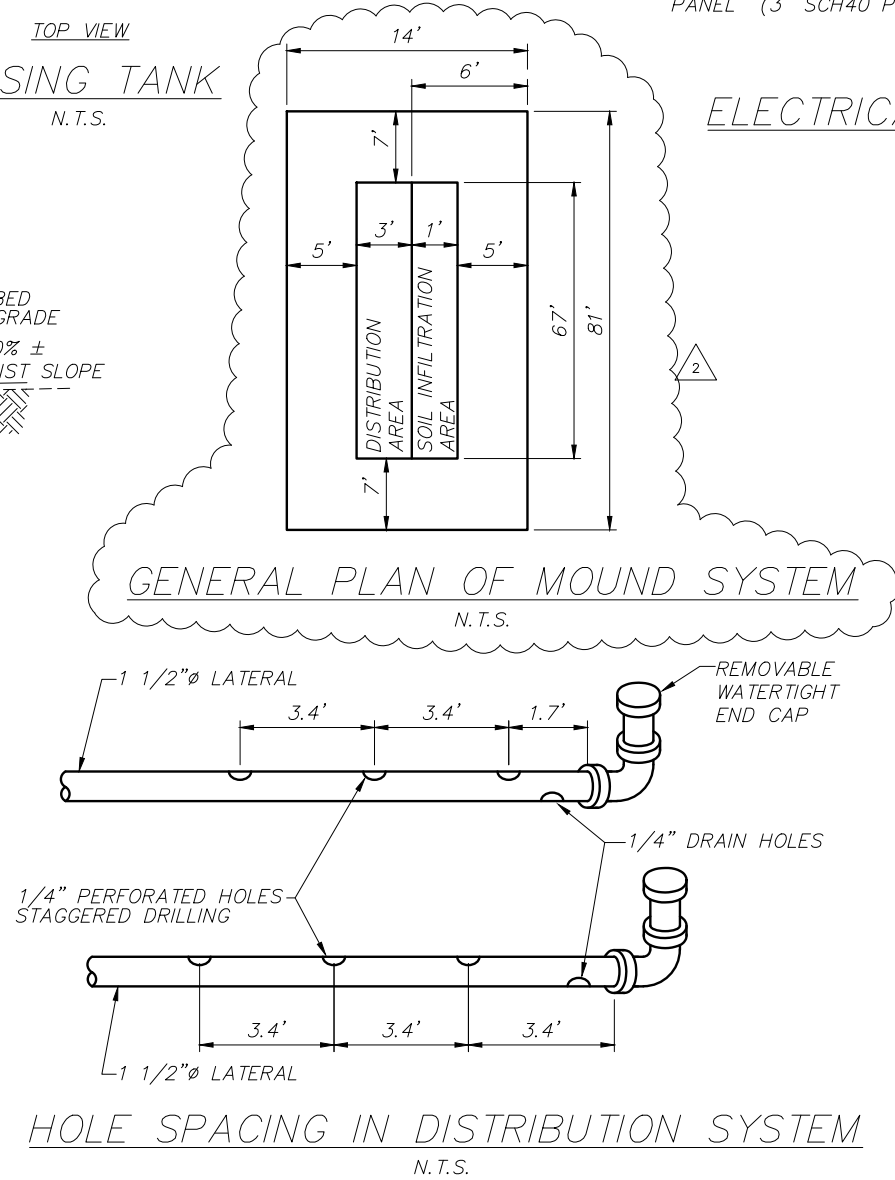
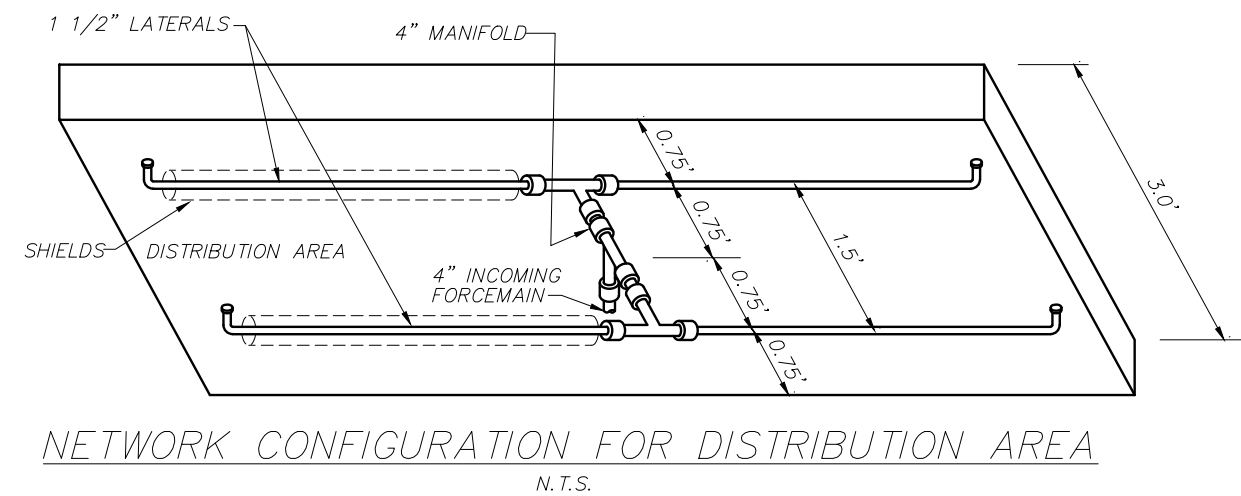
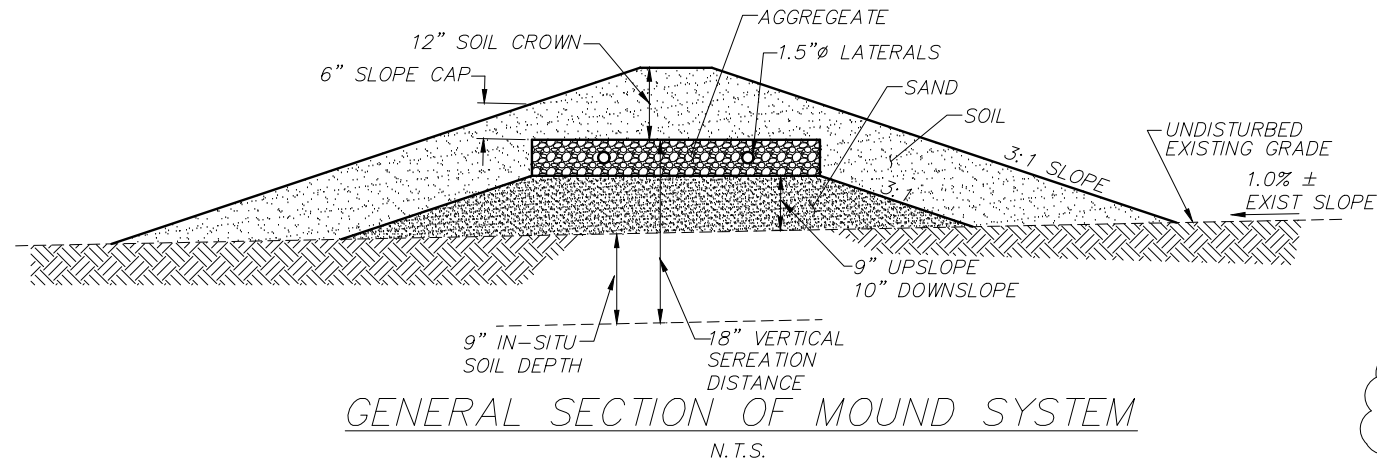
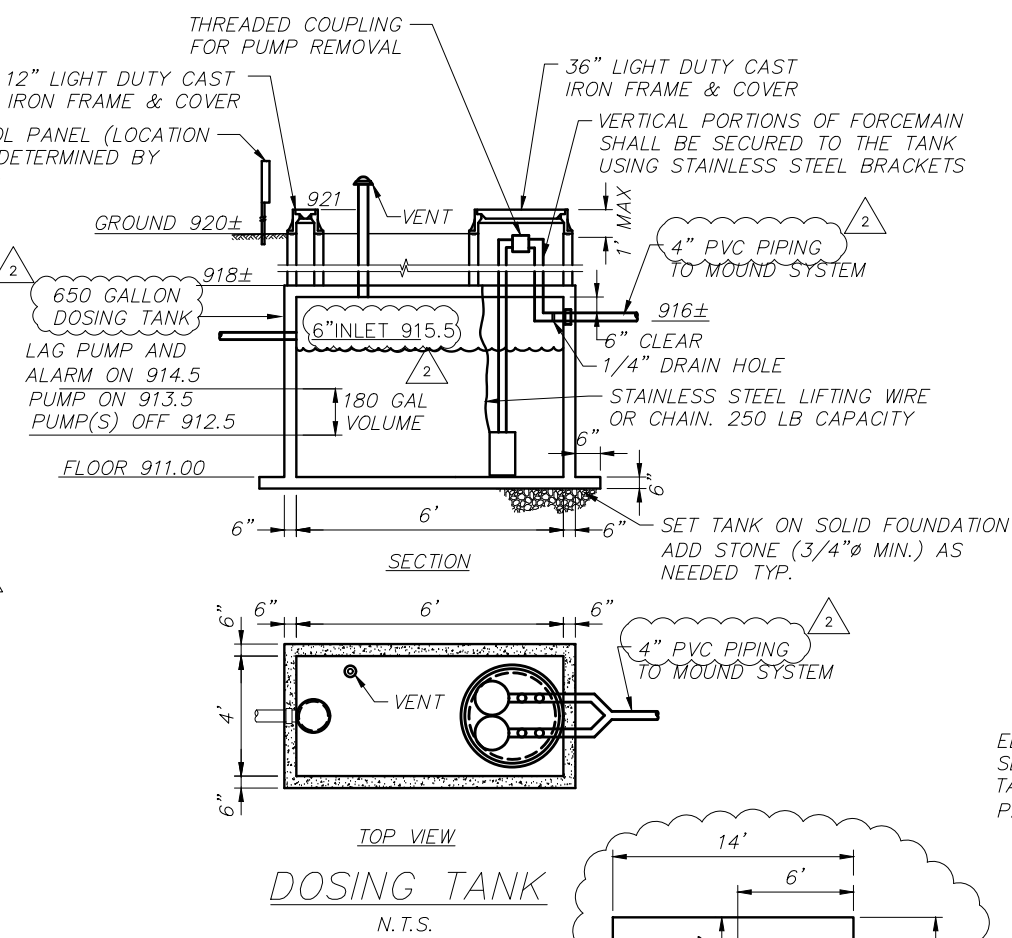


CHECKING PRINT

CHECKED: DATE: CORRECTED: DATE: BACKCHECKED: DATE: APPROVED: DATE:

X:\Projects\GFL\2016\1622\100703\Design\Utilities\Sheets\71-18-03UD001.dwg: septic details 1: 7/28/20 - 11:41am

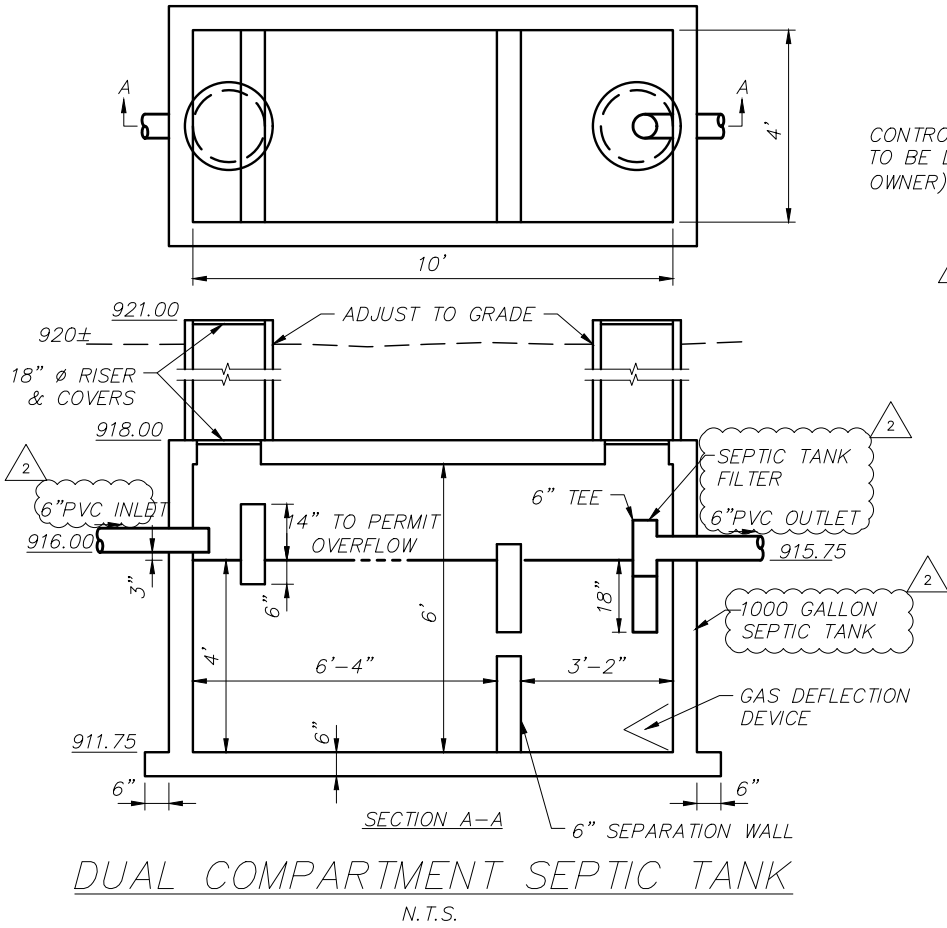

DESIGN AGENCY		EDLZ OHIO, INC.	
BY DATE	REVISIONS	NO.	CHECKED
LAA 7/16/20	ADDENDUM #1	1	GV
MLE 7/28/20	ADDENDUM #2	2	IN CHARGE
			DES
PROJECT 39-20-03A			
DATE: 5/22/2020			
WASTEWATER TREATMENT SYSTEM DETAILS			
OHIO TURNPIKE AND INFRASTRUCTURE COMMISSION			
362		472	