



**OHIO TURNPIKE AND
INFRASTRUCTURE COMMISSION**

ADDENDUM NO. 2
ISSUED JANUARY 16, 2020

PROJECT NO. 39-20-02 (PART A)
MAINLINE PAVEMENT RECONSTRUCTION
MILEPOST 46.50 TO MILEPOST 50.92
FULTON & LUCAS COUNTIES, OHIO
ISSUED DECEMBER 30, 2019

PROJECT NO. 39-20-02 (PART B)
TOLL PLAZA 49 SITE CONSTRUCTION
MILEPOST 48.8 TO MILEPOST 49.1
LUCAS COUNTY, OHIO
ISSUED DECEMBER 30, 2019

OPENING DATE *EXTENDED TO*: 2:00 P.M. (EASTERN TIME), ~~JANUARY 27~~ **FEBRUARY 4, 2020**

ATTENTION OF BIDDERS IS DIRECTED TO:
ANSWERS TO QUESTIONS RECEIVED THROUGH 2:00 PM ON JANUARY 16, 2020

MODIFICATIONS TO THE CONTRACT DOCUMENTS

Plan Sheets:

39-18-02A – 24, 42, 78, 109, 126, 169, 171, 174, 177, 178, 180, 181, 208, 320, 321, 472 and 474 of 505
39-18-02B – 3, 7, 13, 14, 15, 16, 17, 18 and 30 through 53 of 59 Dated 1-15-2020

-AND-

Bid Schedule of Items and Estimated Quantities Worksheet
Ref. Nos. 7, 11, 20, 105, 114, 267, 268, 271, 272 and 290 of 315

-AND-

EXTENSION OF THE BID OPENING TO 2:00 PM ON FEBRUARY 4, 2020

-AND-

“Subgrade/Base Improvement Report”, Rii Project No. N-14-020(11) February 2019,

“Geohazard Exploration Report”, Rii Project No. N-14-020(11) July 2019,

58-20-01 Draft Report of Structure Foundation Exploration TP 49 by DLZ 5-22-19,
Environmental Documentation

Issued by the Ohio Turnpike and Infrastructure Commission through Jennifer L. Stueber, Esq., General Counsel.

Jennifer L. Stueber, Esq.,
General Counsel

1-16-2020
Date

ANSWERS TO QUESTIONS RECEIVED THROUGH 2:00 P.M. ON JANUARY 16, 2020:

Q#6 Please see Plan Sheet 18 of 59 Subsummary, Pavement Calculations. Please review the quantity given for CAD Generated Surface Area for the Eastbound Shoulders/Parking Areas. The area of 36,155 sq ft seems to be overstated.

A#6 The CAD generated surface area of 36,155 sq. ft for the Eastbound Shoulders/Parking Areas is confirmed.

Q#11 Bid item 102- there are two runs on the WB side (sheet 208, runs D-41 and D-42) which are to be core-drill connected to an existing 30" concrete pipe. Given the size of cores needed to accommodate the 15" RCP connections, these will most likely damage or destroy the existing 30" pipe. Please consider adding a new manhole at this junction of the new and existing pipes.

A#11 This Addendum No. 2 revises General Summary Sheet Nos. 169 and 171 of 505, Drainage Sub Summary Sheet Nos. 177 and 178 of 505, Plan and Profile Sheet No. 208 of 505 and Cross Section Sheet Nos. 320 and 321 of 505, and revises Reference Nos. 7, 105 and 114 on the Bid Schedule of Items and the Estimated Quantities Worksheet. The quantity for Pipe Removed, Over 24" was revised on Plan Sheet Nos. 169, 177, and 178 of 505. The quantities for 30" Conduit, Type B, 706.02 and Manhole, No. 3 were revised on Plan Sheet Nos. 171, 177, and 178 of 505. Plan Sheet Nos. 208, 320 and 321 of 505 added a manhole, removed and added 30" Conduit, Type B and eliminated the core drilled holes in the existing 30" storm sewer.

Q#12 Please identify and indicate the existing pavement type and pavement thickness for Ramps A, B, C, and D at the old service plazas.

A#12 The existing pavement type for Ramps A, B, C, and D (Part A) at the old service plazas is believed to be similar to the composition of the existing mainline pavement with 10" +/- concrete and 5" +/- asphalt and shoulders with 9" +/- asphalt as shown in the existing typical sections.

Q#13 Please identify and indicate the existing pavement type and pavement thickness for the 2 drive aprons at the Maintenance Building on the WB side of the Turnpike @ stations 1379 and 1382.

A#13 The existing pavement type for the two drive aprons at the Maintenance Building on the WB side of the Turnpike at STA 1379 and STA 1382 is believed to be full depth asphalt. The depth is assumed to be 8" +/-.

Q#14 Please verify that the excavation required for the 2 drive aprons at the Maintenance Building on the WB side of the Turnpike @ stations 1379 and 1382 has been accounted for as it appears that 21.25" inches of pavement is to be placed in this area.

A#14 This Addendum No. 2 revises the Pavement Removed, As Per Plan and Excavation quantities on the General Summary Sheet No. 169 of 505, the Pavement Sub Summary Sheet Nos. 180 and 181 of 505, and Reference Nos. 11 and 20 on the Bid Schedule of Items and the Estimated Quantities Worksheet. An excavation quantity was added to account for the 13.25" +/- under the pavement removed area for the driveway areas. The Pavement Removed, As Per Plan area was shown incorrectly and has also been revised.

Q#15 Please identify and indicate the existing pavement type and pavement thickness for the drive apron EB side of the Turnpike @ station 1383.

A#15 The existing pavement type for the drive apron EB side of the Turnpike at STA 1383 is believed to be full depth asphalt. The depth is assumed to be 8" +/-.

Q#16 Please verify that the excavation required for the 2 drive aprons at the Maintenance Building on the EB side of the Turnpike @ station 1383 82 has been accounted for as it appears that 21.25" inches of pavement is to be placed in this area.

A#16 This Addendum No. 2 revises the Pavement Removed, As Per Plan and Excavation quantities on the General Summary Sheet No. 169 of 505, the Pavement Sub Summary Sheet No. 181 of 505, and revises Reference Nos. 11 and 20 on the Bid Schedule of Items and the Estimated Quantities Worksheet. An excavation quantity was added to account for the 13.25" +/- under the pavement removed area for the driveway areas. The Pavement Removed, As Per Plan area was incorrectly shown and has also been revised.

Q#17 Please consider delaying the bid 1 day to avoid submitting the bid on a Monday. This will allow additional time for material suppliers and subcontractors to provide quotes to Prime bidders on Monday afternoon and evening as opposed to a Sunday. This will tremendously aid Prime bidders in preparing and submitting their best and lowest bids.

A#17 This Addendum No. 2 extends the Bid Opening Date to 2:00 P.M. (Eastern Time), Tuesday, February 4, 2020.

Q#18 Will the contractor be allowed to utilize the drives at MP 48.36 and 48.41 on the north side of the turnpike, and the drive at MP 48.43 on the south side of the turnpike as a means of ingress and/or egress for construction traffic? If the answer is yes where is this to be factored into the bid? Would this be factored in the base bid, in the temporary access deduct alternate, or a new alternate would be established?

A#18 No.

Q#19 Bid item 17- Removal Misc.: Temporary Sheeting Removed - Plan sheet 397 notes that there are a total of 26 panels of PZC-18 sheeting which are to be removed. Please clarify if the sheets need to be removed full depth and if so, how deep the sheets are.

A#19 The General Note on Sheet 22 of 505 states that the PZC-18 sheeting shall be removed, not partially removed. The note further states that the maximum length of each panel is 32 feet.

Q#20 Has the commission conducted a sub-surface geotechnical investigation on the site? If so, could that be provided to the contractors for review of the sub-surface conditions?

A#20 A copy of "Subgrade/Base Improvement Report", Rii Project No. N-14-020(11) prepared by Resource International, Inc., February 2019 has been included in this Addendum No. 2.

Q#22 Will the commission allow the contractor to place and utilize a Portable Asphalt Batch plant within the Commission Right-of Way. If so, please provide the location.

A#22 Yes, this Addendum No. 2 provides the requirements and the location in the General Notes on Sheet No. 24 of 505.

Q#23 Is the use of an MTD (Material Transfer Device) required for paving the lanes into & out of the toll plaza (PART B ONLY, Sta 118+70 to 133+70)?

A#23 Yes.

Q#24 SP103, Paragraph F states that all westbound asphalt paving shall be complete by 10/16/20. Does this exclude the asphalt paving within 39-20-02B Westbound Toll Plaza with the exception of the Pedestrian Bridge Staging Area, Laydown Areas, Parking Areas and Drives as depicted on Plan Sheet 9 of 59?

A#24 Yes, it is anticipated that the 39-20-02B asphalt paving up to the toll plaza concrete and the toll plaza curbs will be performed during the summer of the 2021 Construction Season. This asphalt paving work shall be coordinated with Project 58-20-01, Building and Site Work.

Q#25 SP400.III.E.3.(h) states that the SP404 shall be placed either full width or in 2 parallel lanes. Please describe how you would like the SP404 to be placed in the areas into & out of the toll booths where the pavement is up to 92' wide.

A#25 In addition to the requirements of SP 400, the Contractor shall propose and submit for approval a method by which the number of longitudinal and transverse joints are minimized in all lifts.

Longitudinal joints are to be spaced such that they are not in the wheel path of traffic from the asphalt tapered area to the toll plaza concrete pavement.

Q#26 Our 2018 audited financial statement is dated in 2019. We have an unaudited 2019 financial statement. Will the Ohio Turnpike Commission accept both the 2018 audited and 2019 non audited in lieu of the Contractor's Financial Statement?

A#26 Yes.

Q#27 Ref. Item #58, CONCRETE BARRIER, END ANCORAGE, REINFORCED, TYPE B-50, AS PER PLAN, defines a bid quantity of 4 each. Reviewing plan sheet 174 of 505, Roadway Sub-summary, defines a quantity of 2 each on plan sheet 207 and reflects a total of 4 each for the sub-summary, which is carried forward to the general summary. The bid quantity appears to be overstated, will OTC please confirm the bid quantity for item #58?

A#27 This Addendum No. 2 revises Roadway Sub Summary Sheet No. 174 of 505 to change the quantity of CONCRETE BARRIER, END ANCORAGE, REINFORCED, TYPE B-50, AS PER PLAN for Plan Reference BR-9 to 4 each. There is no change in total quantity for this item of work as a result of this Addendum No. 2.

Q#28 Bid item 24- Borrow: by specification 203.02 this is to be material obtained from approved sources outside the construction limits. Will the contractor be able to use onsite excess material from roadway, toll plaza, and detention pond excavation or does this have to be more costly material obtained from outside OTIC right of way?

A#28 Yes, the Contractor is expected to use material from within the Ohio Turnpike Property, such as onsite excess material from the roadway, proposed toll plaza area, the detention pond excavation or below the waste areas as defined on Waste Site Detail Sheets 495 thru 497 of 505.

Q#29 Plan sheet PIS-1 on the slope repair typical says that geotechnical report is available for review in Berea. Can this geotechnical report be made available to contractors online through an addendum?

A#29 A copy of "Geohazard Exploration Report", Rii Project No. N-14-020(11) prepared by Resource International, Inc., July 2019 has been included in this Addendum No. 2.

Q#30 Bid Item 266- Pump Station Removed- can OTIC please provide a detail of the existing pump station?

A#30 This Addendum No. 2 revises the General Note for ITEM 202 – PUMP STATION DEMOLISHED on Sheet No. 7 of 59 to include dimensions of existing concrete structure, 14.3' deep by 6' diameter. The minimum removal limits have also been revised to a minimum of 4' below proposed ditch and break up bottom of structure prior to backfill with clean fill in accordance with ODOT 203.

Q#31 Part B, sheet 13 shows EB toll plaza pavement work to be performed being built up through the SP302 prior to September 30, 2020. Assuming that these limits are from 118+69 through 133+70 (Part B- sheets 19 and 20), then there is a conflict with the Part A maintenance of traffic plan sheet 78 which shows the portable barrier in phase 1 starting at 21+70. Should this PCB taper in phase 1 be extended to the west so that pavement construction on the EB plaza can begin accordingly? Please review the part A MOT plan as it relates to EB part B construction and revise the MOT sheets as required in an addendum.

A#31 This Addendum No. 2 revises Part A Maintenance of Traffic Sub Summary Sheet No. 42 and Maintenance of Traffic Plan Sheet Nos. 78, 109 and 126 of 505 to extend the portable barrier to STA 20+20, 67' RT to avoid conflict with the Contract 58-20-01 staging areas to be constructed in this Contract prior to September 1, 2020 as shown on Part B Sheet 9 of 59. A note was modified on the Contract Coordination Plans, Sheet 13 of 59 to further describe what portion of SP 302 is to be performed on the Eastbound Toll Plaza prior to the September 1, 2020.

Q#32 Bid item 268- Pavement Removed, As Per Plan- where is the as per plan note?

A#32 This Addendum No. 2 removes "As per plan" from Item Description for Pavement Removed on the Demolition Plan South Site Sheet No. 14 of 59, the Demolition Plan North Site Sheet No. 15 of 59, the General Summary Sheet No. 16 of 59, and Reference No. 268 on the Bid Schedule of Items and the Estimated Quantities Worksheet.

Q#33 Bid item 271- Excavation- please verify that asphalt removal in part B is incidental to this item (sheets 14 and 15) and not bid item 268. Part A has asphalt removal incidental to pavement removed and we wanted to verify this is how part B will be handled.

A#33 Ref. No. 271 for Item No. 203 – Excavation includes all asphalt pavement excavation as incidental in Part B. The quantity for excavation on Sheet No.'s 14 and 15 of 59 were derived from 3D models of existing ground and proposed grade outside of cross section coverage. The quantity shown on Sheet No. 7 of 59 under General Note "Item 203 – Asphalt Pavement Removed" of 8,163 CY is additional excavation of pavement below the limit of proposed grading from 3D models and is included in Ref. No. 271 for Item 203 - Excavation. There is no change in total quantity for this item of Work as a result of this Addendum No. 2.

Q#34 Bid item 290 - 15" Conduit, Type B, 706.02: plan quantity is 24', cross-sectional sheet 48 calls this out at 32'. Which is correct?

A#34 This Addendum No. 2 revises the quantity for SP611 – 15" CONDUIT, TYPE B, 706.02 to 32' on the General Summary Sheet No. 16 of 59, the Sub Summary Sheet No. 17 of 59, and Reference No. 290 on the Bid Schedule of Items and the Estimated Quantities Worksheet. The conduit call-out for SP611 – 15" CONDUIT, TYPE B, 706.02 was revised to add "706.02" on the Cross-Section Sheet No. 48 of 59.

Q#35 On plan sheet 20/505 there are notes pertaining to Item 203 Embankment, As Per Plan, and Item 203 Roadway Excavation and Embankment in the first two columns relating to Sulfate content in the In-Situ soils and specifically excludes A-7-6 and A-7-5 soils from use within the project limits. Without a subsurface geotechnical report, which identifies these soils it is impossible for the contractors to determine if and where these soils are present. Will the Commission provide the geotechnical report for the project? If a Geotechnical report is not available, how are the contractors to proceed with pricing these items?

A#35 A copy of the Draft Report of Structure Foundation Exploration TP 49 by DLZ dated 5-22-19 for of Project 58-20-01 has been included in this Addendum No. 2. Four soil borings were drilled on the existing Service Plaza Properties, two on the north side and two on the south side. The Contractor should assume that the Soils are representative of the entire Service Plaza Properties. Also refer to Responses Q#20 and Q#29.

Q#36 Bid item 267- Concrete Curb Removed: subsummary in Part B calls out 235' in north lot. North lot plan demolition plan sheet shows much more than 235' being removed. Please review and revise quantity as necessary.

A#36 This Addendum No. 2 revises the length of Item 202 - CONCRETE CURB REMOVED on General Summary Sheet No. 16 of 59 and revises Reference No. 267 on the Bid Schedule of Items and the Estimated Quantities Worksheet.

Q#37 On Plan Sheet 3 of 59 in Part B, the Item Legend calls out items #31 thru #36 for various thicknesses of asphalt paving and pavement planing. These items do not appear in any of the provided typical. What are they for?

A#37 This Addendum No. 2 revises Typical Section Legend Nos. 31 thru 36 on Toll Plaza Sheet No. 3 of 59 to read "Not Used".

Q#38 Bid Ref No 17 "Removal Misc., Temporary Sheeting Removed" what is the approximate depth the sheeting is below grade?

A#38 See Response to Q#19.

Q#39 Has the OTC performed a Jurisdictional Determination to identify any jurisdictional streams and or wetlands on or adjacent to the referenced project? If so, will the Commission identify all jurisdictional streams and or wetlands on or adjacent to this project? Additionally, has the Commission obtained any 401/404 Water Quality Certification / Permits associated with this project? If so, can these be provided to the Bidders?

A#39 Yes, the Environmental Documentation is provided with this Addendum No. 2. The two streams that there identified as waters of the US were Murbach and Beecher Ditches. The Nationwide Permit was obtained for the impacts to Beecher Ditch.

Q#40 Part B Bid Items 271 (Excavation) and 272 (Embankment): the subsummary references quantities on sheet 54, which in turn summarizes cross-sectional volumes from plan sheets 30-54. There are numerous mistakes in the cross-section plan sheets 30-36, most in the omission of volumes between stations from consecutive plan sheets and a one in the calculating of end areas into volumes. Please review these plan sheets and revise excavation and embankment items accordingly.

A#40 This Addendum No. 2 revises the Excavation and Embankment quantities on the Cross-Section Sheet Nos. 30 through 53 of 59 and the General Summary Sheet No. 16 of 59, and revises Reference Nos. 271 and 272 on the Bid Schedule of Items and the Estimated Quantities Worksheet. An Excavation and Embankment Sub Summary Table totaling the quantities by sheet was added to Sub Summary Sheet No. 18 of 59.

Q#41 On plan sheet 472/505, MP 48.95 diagram states 22' Min from top of pavement to bottom of overhead sign support, but the MP 48.96 diagram on same sheet states 17' Min, which is also noted as 17' Min on plan sheet 474/505. Which is correct?

A#41 This Addendum No. 2 revises Plan Sheets 472 and 474 of 505 to clarify 22' Minimum is required.

Q#42 Bid item 280- Seeding and Mulching, 73433 sy: Please provide a breakdown of how this quantity was derived as the cross-sections per Part B plan sheets 29-54 show only part of the quantity, and also verify if the seeding in waste areas in each lot as well as affected shoulders outside of reclamation-constructed roadways (sheet 6) get paid under this bid item.

A#42 In addition to the seeding areas that are provided on the Cross Sections, the remaining seeding quantities were calculated using AutoCAD. The additional seeding quantities extend from the edge of the cross sections to the Construction limits shown on the side and backside of the property. The Construction limits for both sites are shown on Plan Sheets 27 and 28 of 59. These quantities also include 8 feet outside of the pavement reclamation work. If the Contractor elects to use the waste sites as provided in the Part A plans, all requirement of Sheets 495

through 497 of 505 apply. Therefore, all earthwork and seeding quantities will not be paid under the final footprint of the waste areas.

Q#43 Bid item 298- Linear Grading: there are no plan notes in part B for this bid item. Do the same plan notes as the part A Linear Grading, APP item (bid item 41) apply to the part B bid item such as incidental seeding and mulching?

A#43 No, this pay item is not “as per plan”. This work item is to follow the CMS 209.

Q#44 Part B plan sheet 9 has notes calling for the contractor to place temporary asphalt wedges over the SP302 at the staging areas adjacent to the staging area. There is no Asphalt for Maintaining Traffic bid item in part B. Will the temporary wedges be paid for under bid item 138 in Part A Asphalt for Maintaining Traffic or will there be similar item added to part B?

A#44 The Commission will respond to this question in Addendum No. 3.

Receipt of Addendum No. 2

Project No. 39-20-02 (Part A & B) is hereby acknowledged:

(Firm Name) _____

(Signature) _____

(Printed Name) _____

(Date) _____

**BIDDERS MUST RETURN THE ABOVE ACKNOWLEDGEMENT
OF RECEIPT OF ADDENDUM NO. 2 WITH THEIR BID.**

DRAINAGE (CONTINUED)

ITEM SPECIAL - PIPE CLEANOUT, SIZE

THIS ITEM SHALL CONSIST OF REMOVING ALL SEDIMENTS, DEBRIS, AND OTHER FOREIGN MATERIALS FROM INSIDE EXISTING CULVERT. THE REMOVAL OPERATION SHALL NOT BE DESTRUCTIVE TO THE INTEGRITY OF THE PIPE OR CULVERT. THE CONTRACTOR SHALL REVIEW HIS CLEANOUT PROCEDURE WITH THE CHIEF ENGINEER AND OBTAIN THE CHIEF ENGINEER'S APPROVAL PRIOR TO PERFORMING THE WORK. ALL REMOVAL MATERIALS SHALL BE REMOVED OFFSITE IN ACCORDANCE WITH ITEM SP 105. ANY DEWATERING WORK REQUIRED TO COMPLETE THIS WORK SHALL BE INCLUDED UNDER THIS PAY ITEM.

CULVERT OR PIPE CLEANOUT WILL BE MEASURED ON A LINEAR FOOT BASIS. PAYMENT WILL BE MADE AT THE CONTRACT PRICE PER LINEAR FOOT FOR ITEM SPECIAL - PIPE CLEANOUT, SIZE.

THE FOLLOWING LIST IS THE LOCATION, CONDUIT SIZE AND DEBRIS OBSERVED IN THE SPRING OF 2018.

- D-3 M.P. 46.45 WB - 48" RCP CULVERT UNDER BRAILEY ROAD NORTH EMBANKMENT, 8" TO 14" DEEP SILT
- D-4 M.P. 46.45 EB - 24" RCP CULVERT UNDER BRAILEY ROAD SOUTH EMBANKMENT, 6" TO 9" DEEP SILT
- D-24 M.P. 48.3 WB - 48" RCP CULVERT UNDER WEST MAINTENANCE BUILDING DRIVE, 1" TO 6" DEEP SILT
- D-25 M.P. 48.4 WB - 48" RCP CULVERT UNDER EAST MAINTENANCE BUILDING DRIVE, 4" DEEP SILT
- D-26 M.P. 48.45 WB - 48" RCP CULVERT UNDER FULTON/LUCAS ROAD NORTH EMBANKMENT, 1" TO 4" DEEP SILT.
- D-27 M.P. 48.4 EB - 30" RCP CULVERT UNDER ACCESS DRIVE, SILT DEPTH UNKNOWN
- D-28 M.P. 48.45 WB - 30" RCP CULVERT UNDER FULTON/LUCAS ROAD SOUTH EMBANKMENT, SILT DEPTH UNKNOWN
- M.P. 48.7 - 12' (SPAN) X 6'-3" (RISE) CONCRETE BOX CULVERT, 6" TO 12" DEEP SILT

EXCAVATION IN CHANNEL / DITCH AREAS

MATERIAL WHICH IS EXCAVATED FROM THE CHANNEL / DITCH AREA TO INSTALL NEW CULVERT PIPES AND PRECAST FLARED END SECTIONS, AND WHICH IS NOT SUITABLE FOR USE AS BEDDING, BACKFILL OR EMBANKMENT SHALL BE DISPOSED OF IN ACCORDANCE WITH SP 105 OR IN A WASTE SITES AREA, IF BEING UTILIZED BY THE CONTRACTOR. EXCESS MATERIAL SHALL NOT BE DUMPED INTO OR ADJACENT TO THE CHANNEL / DITCH AREAS.

EXTENDED DETENTION BASIN

THIS PLAN UTILIZES EXTENDED DETENTION BASINS FOR POST CONSTRUCTION STORM WATER TREATMENT. DETENTION BASINS MAY BE USED AS SEDIMENT CONTROL DEVICES DURING CONSTRUCTION. FOLLOWING STABILIZATION OF THE TRIBUTARY AREA, FINAL GRADING OF THE DETENTION BASIN MUST MATCH THE PLANS. THE DETENTION BASIN OUTLET STRUCTURE FOR CONSTRUCTION SEDIMENT CONTROL MUST BE REMOVED AND THE OUTLET STRUCTURE MUST BE MADE TO MATCH THE DESIGN SHOWN IN THE PLANS.

PAVEMENT

SP 302 - BITUMINOUS AGGREGATE BASE, PG 64-22 (2 EQUAL LIFTS)

THE CONTRACTOR SHALL BE REQUIRED TO CONSTRUCT SP 302 ITEM IN TWO (2) EQUAL LIFTS WHEN SPECIFIED. THE CONTRACTOR SHALL ALSO BE REQUIRED TO APPLY ITEM 407 - NON-TRACKING TACK COAT (APPLIED @ 0.075 GAL./SQ. YD.) PRIOR TO CONSTRUCTING THE SECOND LIFT.

ITEM 252 - FULL DEPTH PAVEMENT SAWING

THE FOLLOWING ITEM HAS BEEN CARRIED TO THE GENERAL SUMMARY FOR USE BY THE CHIEF ENGINEER TO MAKE TRANSVERSE SAW CUTS WHERE PROPOSED FULL DEPTH PAVEMENT WILL MEET EXISTING PAVEMENT AT THE PROJECT LIMITS, RAMPS AND EXISTING BRIDGES.

ITEM 252 - FULL DEPTH PAVEMENT SAWING 1,000 FT

RESURFACING AT LIMITS OF FULL WIDTH REPLACEMENT

THE FOLLOWING QUANTITIES HAVE BEEN PROVIDED TO MAKE MINOR GRADE ADJUSTMENTS IN THE EXISTING PAVEMENT AT THE FULL WIDTH PAVEMENT REPLACEMENT LIMITS AS DIRECTED BY THE CHIEF ENGINEER.

ITEM 254 - PAVEMENT PLANING, ASPHALT CONCRETE (VARIABLE DEPTH) 530 SY
 SP 404 - ASPHALT CONCRETE SURFACE COURSE, USING CRUSHED SLAG, PG 76-22 (FR) (T=1-1/2") 16 CY
 SP 404 - ASPHALT CONCRETE SURFACE COURSE, USING CRUSHED STONE, PG 64-22 (T=1-1/2") 6 CY
 ITEM 407 - NON-TRACKING TACK COAT (APPLIED @ 0.075 GAL /SY) 40 GAL

PAVEMENT PLANING FOR INSTALLATION OF CONCRETE BARRIER, SINGLE SLOPE, TYPE B-50, AS PER PLAN AND CONCRETE BARRIER MEDIAN OVERHEAD SIGN SUPPORT FOUNDATION

THE FOLLOWING QUANTITY HAS BEEN PROVIDED FOR VARIABLE DEPTH PLANING FOR THE INSTALLATION OF CONCRETE BARRIER, SINGLE SLOPE, TYPE B-50, AS PER PLAN AND CONCRETE BARRIER MEDIAN OVERHEAD SIGN SUPPORT FOUNDATIONS IN THE MEDIAN FROM STA 24+86.7 TO STA 27+53.3. THE PLANING DEPTH WILL VARY FROM 3-1/4" TO 9" AND THE PLANING WIDTH WILL VARY FROM 2'-7" TO 5'-7". THIS WORK SHALL BE PERFORMED AS DIRECTED BY THE CHIEF ENGINEER.

ITEM 254 - PAVEMENT PLANING, ASPHALT CONCRETE (VARIABLE DEPTH) 140 SY

ITEM 452 - NON-REINFORCED PORTLAND CEMENT CONCRETE PAVEMENT, AS PER PLAN

IN ADDITION TO THE REQUIREMENTS OF ITEM 452, CONSTRUCT THE NON-REINFORCED PORTLAND CEMENT CONCRETE PAVEMENT FOR THE ORT SLABS IN ACCORDANCE WITH THE DETAILS SHOWN ON SHEETS 395 & 396.

PORTABLE ASPHALT BATCH PLANT

IN ACCORDANCE WITH ALL APPLICABLE PORTIONS OF ODOT CMS 107.11, THE USE OF PORTABLE ASPHALT PLANTS WITHIN COMMISSION RIGHT-OF-WAY WILL BE PERMITTED.

THE COMMISSION WILL MAKE AVAILABLE THE INFIELD AREA AT INTERCHANGE 39 OR AT THE EXISTING NORTH OR SOUTH SERVICE PLAZAS (MP 49) AS POSSIBLE LOCATIONS FOR A PORTABLE ASPHALT PLANT. CONTRACTOR IS RESPONSIBLE FOR ANY UTILITIES NEED TO OPERATE THE PORTABLE ASPHALT BATCH PLANT. IN ACCORDANCE WITH ODOT CMS 107.11.C, THE CONTRACTOR IS TO SUBMIT A TRAFFIC CONTROL PLAN TO THE CHIEF ENGINEER FOR APPROVAL WHICH INDICATES THE METHOD OF INGRESS AND EGRESS FROM THE PORTABLE PLANT SITE. ALL INGRESS AND EGRESS POINTS WILL REQUIRE FLAGGERS, WHEN THE SITE IS ACTIVE, TO ENSURE THE SAFETY OF THE TRAVELING PUBLIC AND ENSURE THE SAFE FLOW OF CONSTRUCTION TRAFFIC TO AND FROM THE SITE. ALL PROVISIONS OF SP614 SHALL APPLY.

H:\2018\180192\DWG\SHEETS-5 MILES.C - 180192 - GENERAL NOTES-5 MILE.DWG - G.N5 - 1/15/2020 3:12:35 PM - JIM COBB

PROJECT 39-20-02A	DATE: 12/3/19	REVISIONS	NO.	BY	DATE
6	6	ADDENDUM NO. 2	1	JMP	1/15/2020
GENERAL NOTES		DESIGNED	CHECKED	DESIGN AGENCY	
		J.M.P.	W.D.B.	OHIO TURNPIKE	
		DRAWN	IN CHARGE	OHIO TURNPIKE	
		K.P.A.	W.D.B.	OHIO TURNPIKE	
24		OHIO TURNPIKE AND INFRASTRUCTURE COMMISSION			
505		OHIO TURNPIKE			

0

0

H:\2018\180192\DWG\SHEETS-5 MILES.C - 180192 - MOT SUMMARIES-5 MILES.DWG - MTO02 - 1/14/2020 2:12:18 PM - JIM COBB






SHEET NO.	REFERENCE ITEM	LOCATION	STATION		SIDE	614	614	614	614	614	614	614	614	614	SP 614B	SP 614B	SP 614B	SP 614B	SP 614C	SP 622	SP 622	SP 626A	SP 626A	SPECIAL		
			FROM	TO		EACH	FT	FT	FT	FT	FT	FT	FT	FT	FT	FT	FT	FT	FT	FT	FT	FT	FT	EACH	EACH	LUMP
		PHASE 1																								
		EASTBOUND																								
66 - 71	REL	I-80/90	1250+45	1315+50	RT																				6,505	
66 - 71	REL	I-80/90	1251+45	1315+50	RT																				6,405	
66 - 71	*RLL	I-80/90	1251+45	1315+50	RT																				6,405	
66	ELY6	I-80/90	1250+45	1251+45	RT								100												100	
		EB LANE SHIFT #1																								
66 - 67	ELY8	I-80/90	1251+45	1260+00	RT																				855	
66 - 67	CZMY	I-80/90	1251+45	1260+00	RT																				855	
66 - 67	CHW	I-80/90	1251+45	1260+00	RT																				855	
66 - 67	CZMW	I-80/90	1251+45	1260+00	RT																				855	
66 - 67	ELW8	I-80/90	1251+45	1260+00	RT					855															855	
66 - 67	CZMW	I-80/90	1251+45	1260+00	RT																				855	
		EASTBOUND																								
67 - 68	PB	I-80/90	1264+50	1268+50	RT	1																				
67 - 87	PB	I-80/90	1266+50	138+20	RT																					25,557
67 - 71	ELY6	I-80/90	1260+00	1306+95	RT																				4,695	
67 - 71	LLW	I-80/90	1260+00	1306+95	RT								4,695												4,695	
67 - 71	ELW	I-80/90	1260+00	1306+95	RT																				4,695	
68 - 71	ELW	I-80/90	1272+06	1306+90	RT																				3,484	
68 - 71	ELY	I-80/90	1272+06	1306+90	RT								3,484												3,484	
		EB LANE SHIFT #2																								
71	ELY8	I-80/90	1306+95	1315+50	RT																				855	
71	CZMY	I-80/90	1306+95	1315+50	RT																				855	
71	CHW	I-80/90	1306+95	1315+50	RT																				855	
71	CZMW	I-80/90	1306+95	1315+50	RT																				855	
71	ELW8	I-80/90	1306+95	1315+50	RT																				855	
71	CZMW	I-80/90	1306+95	1315+50	RT																				855	
71	ELW8	I-80/90	1306+90	1316+50	RT																				960	
71	CZMW	I-80/90	1306+90	1316+50	RT																				960	
71	ELY8	I-80/90	1306+90	1316+50	RT																				960	
71	CZMY	I-80/90	1306+90	1316+50	RT																				960	
		EASTBOUND																								
71 - 72	ELW	I-80/90	1316+50	1328+51	RT																				1,201	
71 - 72	ELY	I-80/90	1316+50	1328+57	RT																				1,207	
72	*ELW	I-80/90 - AI CREEK	1328+51	1330+51	RT																				200	
72	*ELY	I-80/90 - AI CREEK	1328+57	1330+57	RT																				200	
72 - 73	ELW	I-80/90	1330+51	1335+50	RT																				499	
72 - 73	ELY	I-80/90	1330+57	1335+58	RT																				501	
73	*ELW	I-80/90 - SR 64	1335+50	1337+50	RT																				200	
73	*ELY	I-80/90 - SR 64	1335+58	1337+58	RT																				200	
73 - 86	ELW	I-80/90	1337+50	121+06	RT																				16,743	
73 - 86	ELY	I-80/90	1337+58	121+06	RT																				16,735	
78 - 80	PB	I-80/90	20+20	43+60	RT	1																			2,340	
		SHEET SUB-TOTALS				2	4,695	26,622		2,670	21,927	4,795	2,670	1,710		400	400		84,404	25,557	2,740	612	268			
		TOTALS CARRIED TO MAINTENANCE OF TRAFFIC GENERAL SUMMARY				2	0.89 MI	5.05 MI		0.51 MI	4.16 MI	0.91 MI	0.51 MI	1,710		0.08 MI	0.08 MI		15.99 MI			612	268			

DESIGN AGENCY	BY DATE	REVISIONS	CHECKED	NO.	DESIGNED	NO.
DESIGN AGENCY	JMP 1/15/2020	ADDENDUM NO. 2	T.J.H.	1	W.D.B.	1
			J.D.C.		J.D.C.	
MAINTENANCE OF TRAFFIC SUB SUMMARY						
PROJECT 39-20-02A	DATE: 12/3/19					
2 / 10	42					
505						

PROJECT 39-20-02A
DATE: 12/3/19

MAINTENANCE OF TRAFFIC PLAN - PHASE 1
STA. 12+50 TO STA. 25+50

DESIGNED	CHECKED	NO.	REVISIONS	BY	DATE
W.D.B.	T.J.H.	1	ADDENDUM NO. 2	JMP	11/15/2020
J.D.C.	W.D.B.				

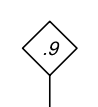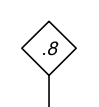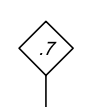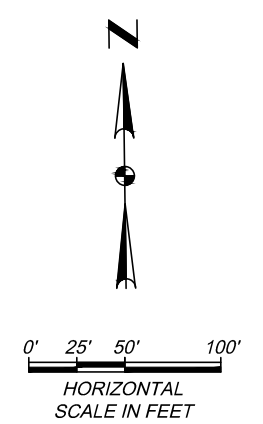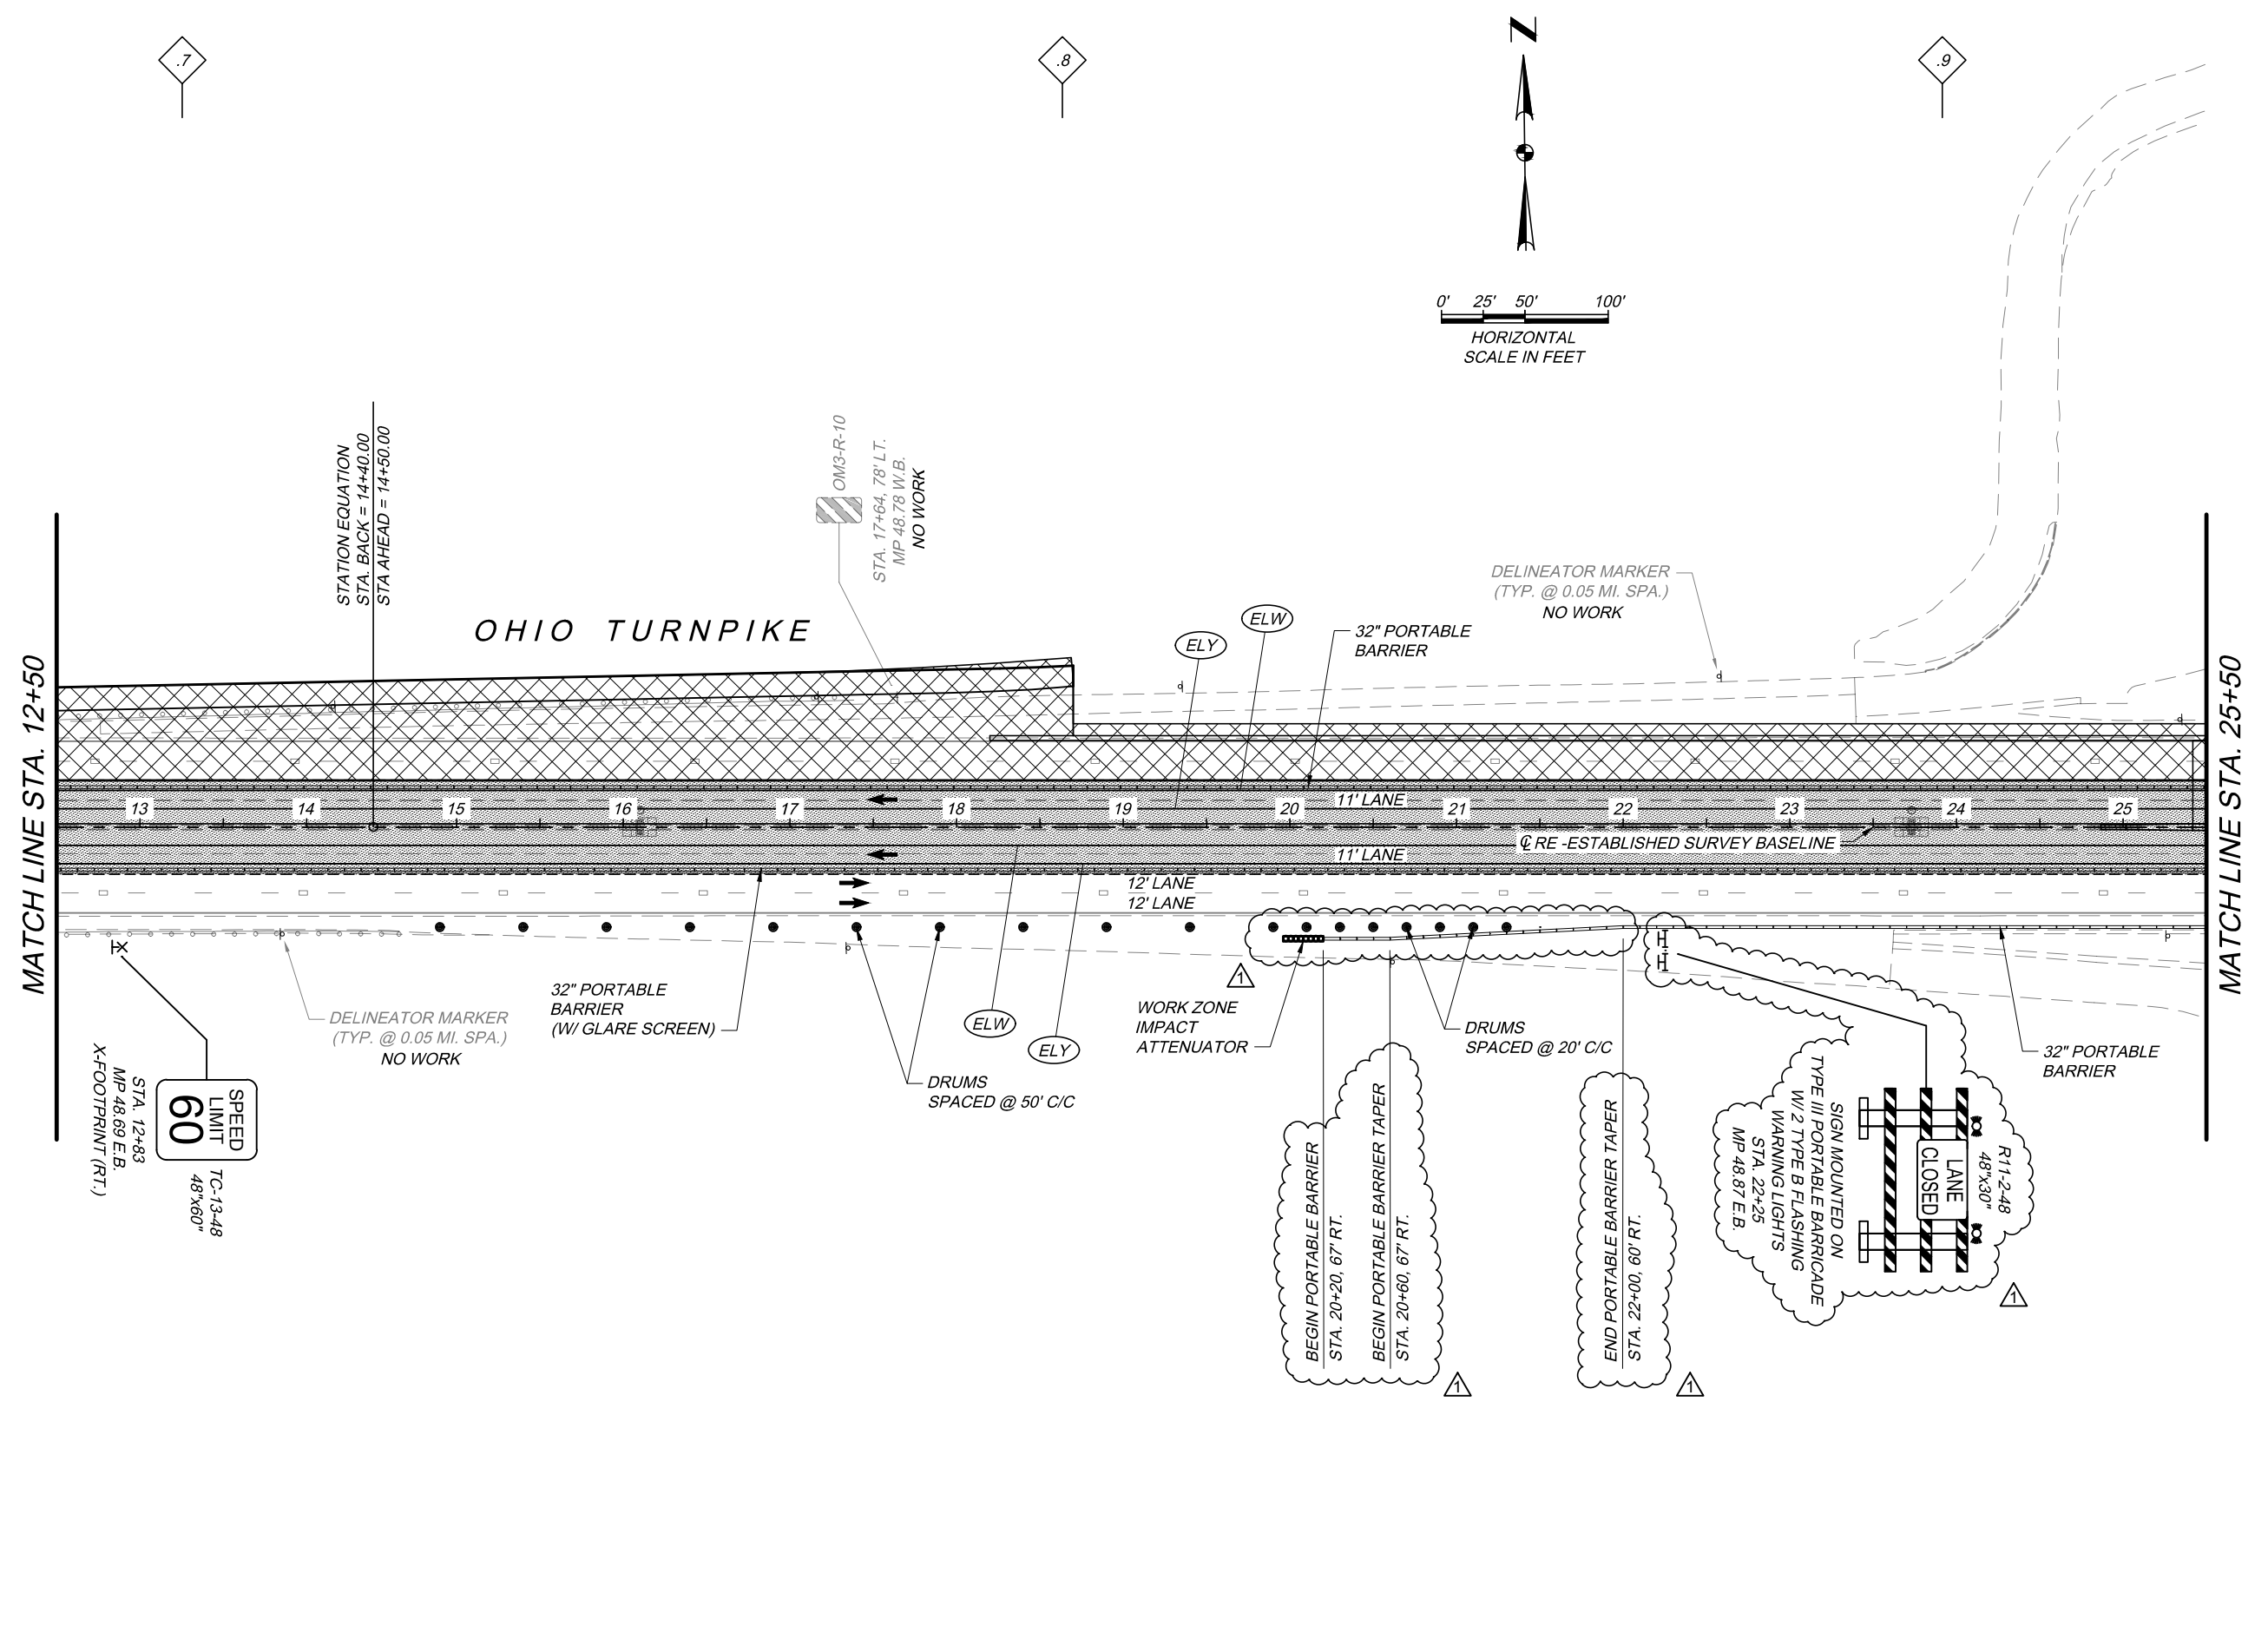

STATION EQUATION
STA. BACK = 14+40.00
STA. AHEAD = 14+50.00

OM3-R-10
STA. 17+64, 78' LT.
MP 48.78 W.B.
NO WORK

DELINEATOR MARKER
(TYP. @ 0.05 MI. SPA.)
NO WORK

STA. 12+83
MP 48.69 E.B.
X-FOOTPRINT (RT.)
60 SPEED LIMIT
TC-13-48
48'x60'

DELINEATOR MARKER
(TYP. @ 0.05 MI. SPA.)
NO WORK

32" PORTABLE BARRIER
(W/ GLARE SCREEN)

DRUMS
SPACED @ 50' C/C

WORK ZONE
IMPACT
ATTENUATOR

DRUMS
SPACED @ 20' C/C

BEGIN PORTABLE BARRIER
STA. 20+20, 67' RT.

BEGIN PORTABLE BARRIER TAPER
STA. 20+60, 67' RT.

END PORTABLE BARRIER TAPER
STA. 22+00, 60' RT.



SIGN MOUNTED ON
TYPE III PORTABLE BARRICADE
W/ 2 TYPE B FLASHING
WARNING LIGHTS
STA. 22+25
MP 48.87 E.B.
R11-2-48
48'x30'

32" PORTABLE BARRIER

H:\2018\180192\DWG\SHEETS-5 MILES.C - 180192 - MOT PH1+5 MILES.DWG - MT-P17 - 1/14/2020 2:53:17 PM - JIM COBB

H:\2018\180192\DWG\SHEETS-5 MILES.C - 180192 - MOT PHVS-5 MILES.DWG - MT-P23 - 1/14/2020 2:55:46 PM - JIM COBB

MATCH LINE STA. 19+50

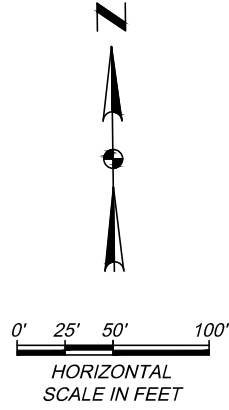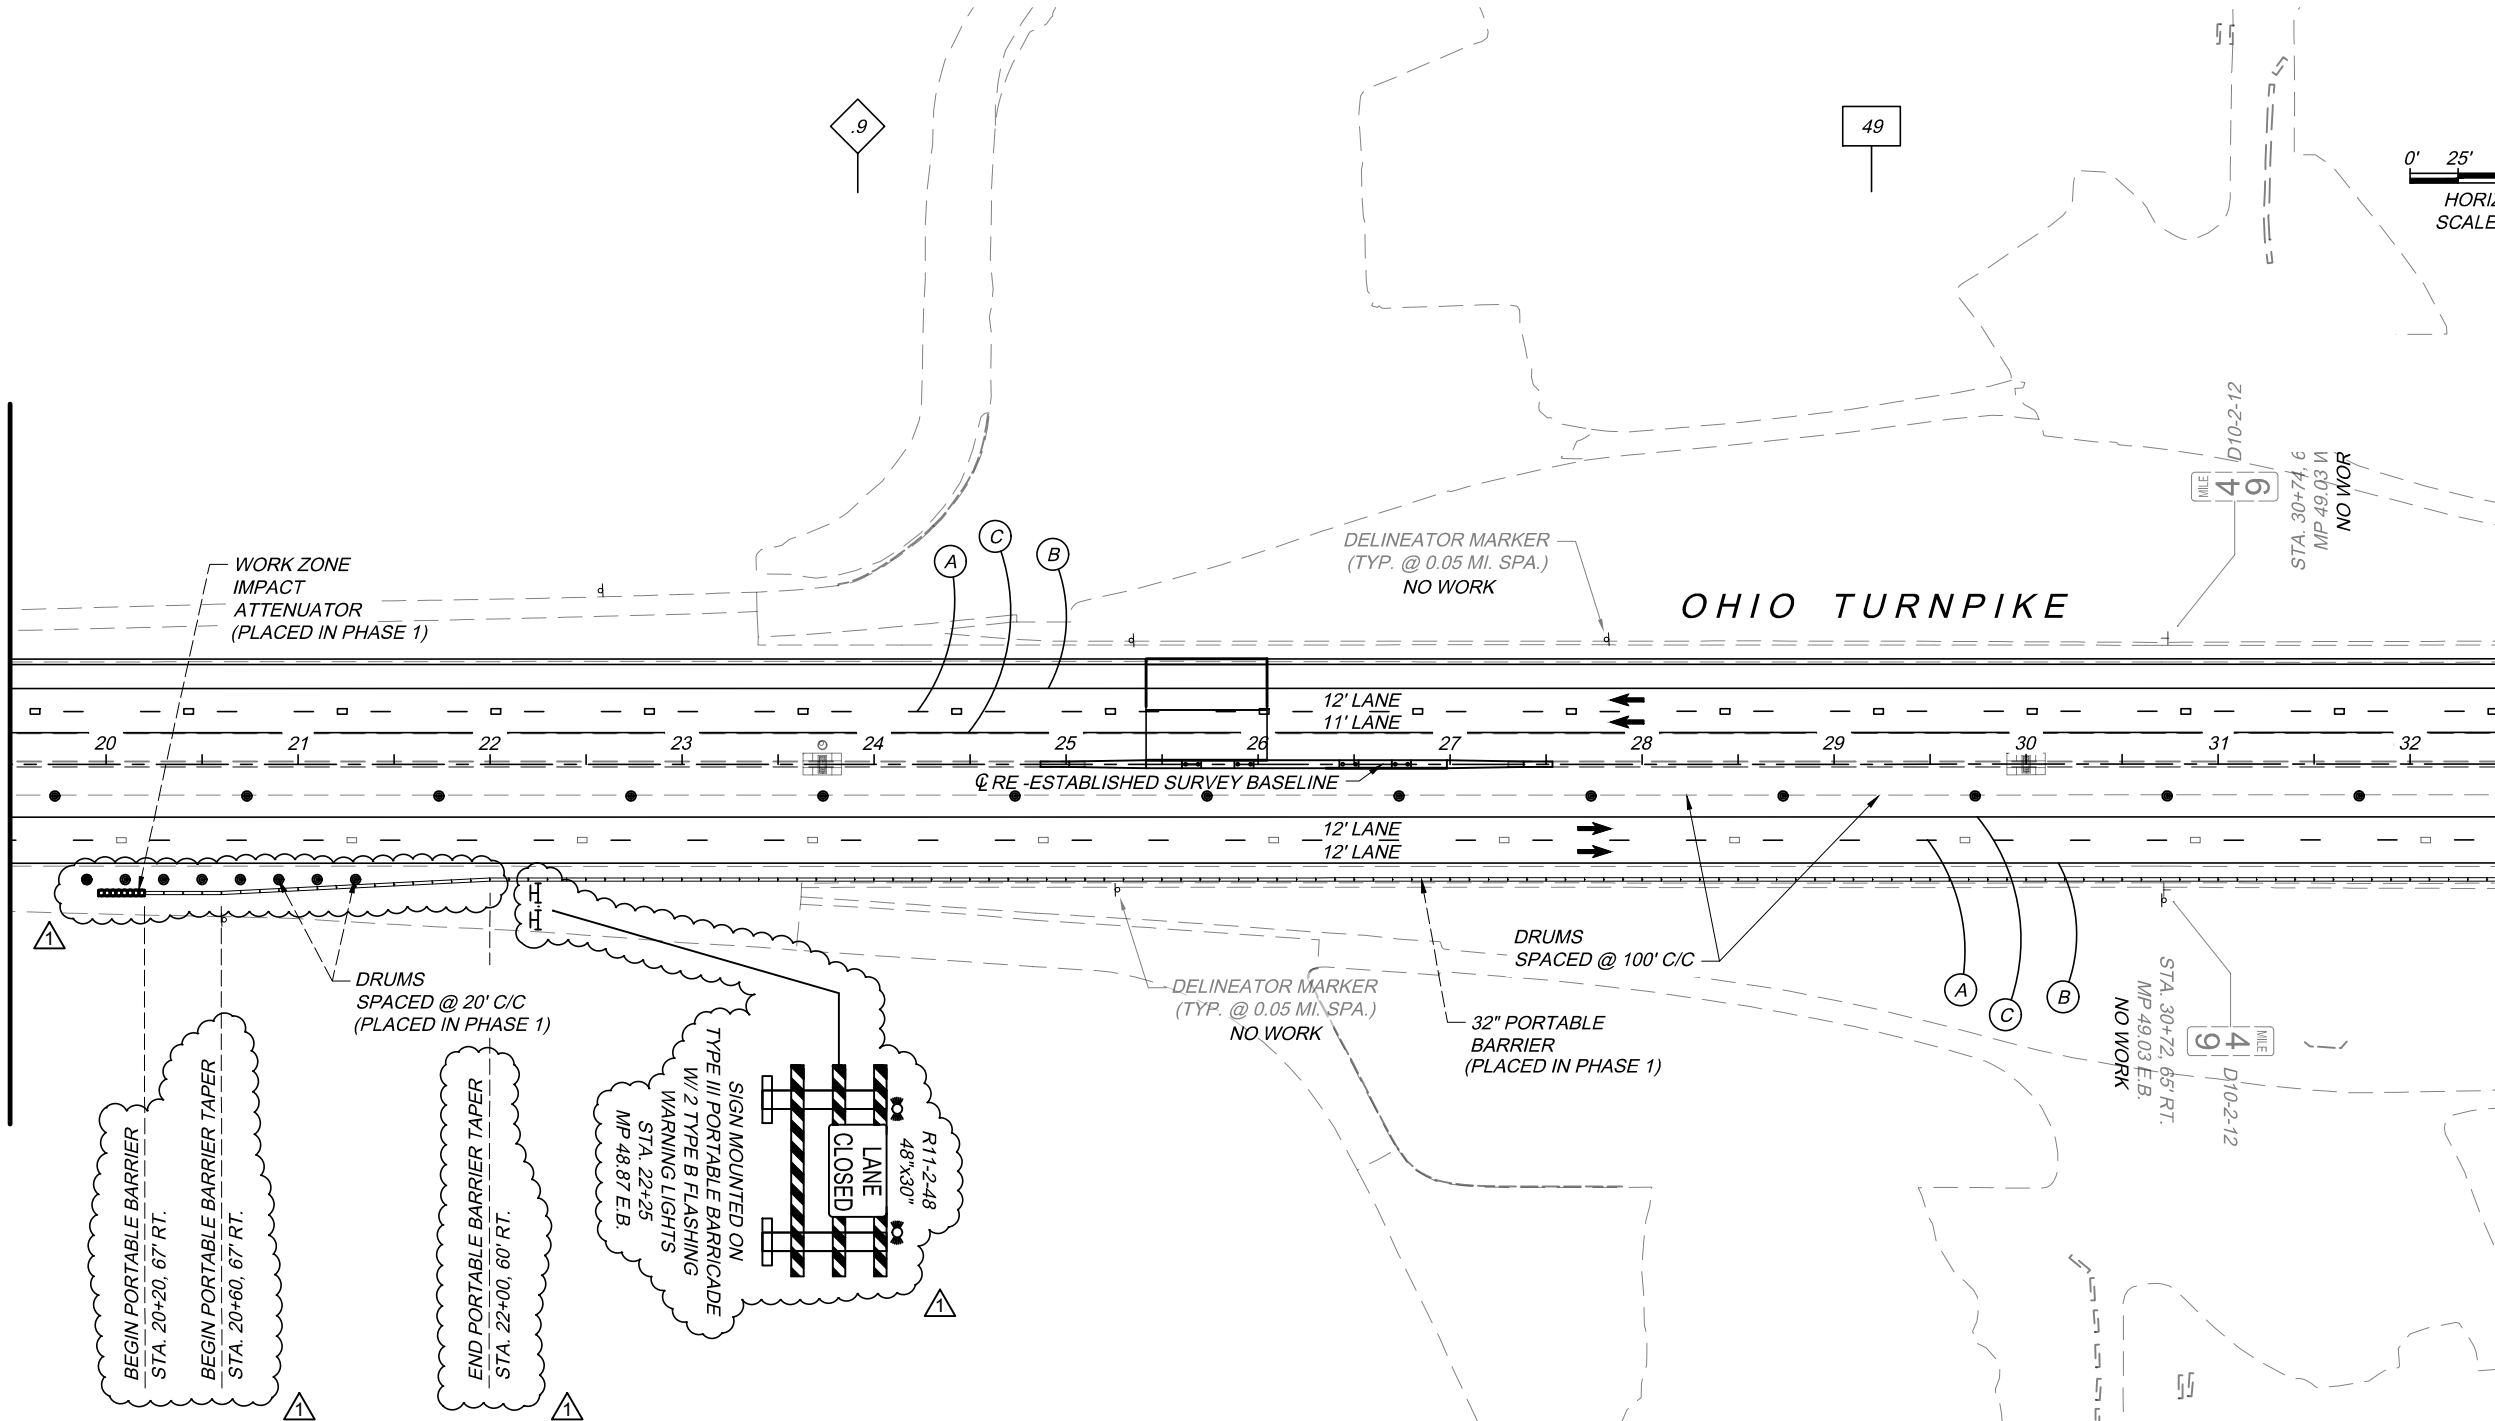

MATCH LINE STA. 32+50

MP 49

PROJECT 39-20-02A	MAINTENANCE OF TRAFFIC PLAN WINTER SHUTDOWN PHASE STA. 19+50 TO STA. 32+50	DESIGNED W.D.B. DRAWN J.D.C.	CHECKED T.J.H. IN CHARGE W.D.B.	NO. 1	REVISIONS ADDENDUM NO. 2	BY JMP	DATE 1/15/2020
-------------------	--	---------------------------------------	--	-------	-----------------------------	-----------	-------------------

11/21

109
505

FOR ADDITIONAL MOT NOTES, EXISTING AND PROPOSED MOT LEGEND, SEE SHEET 51.
FOR ADDITIONAL TC NOTES, EXISTING AND PROPOSED TC LEGEND, SEE SHEET 421.

OHIO TURNPIKE AND INFRASTRUCTURE COMMISSION



BY	DATE
JMP	11/15/2020

NO.	REVISIONS
1	ADDENDUM NO. 2

DESIGNED	CHECKED	DATE
W.D.B.	T.J.H.	
DRAWN	IN CHARGE	
J.D.C.	W.D.B.	



MAINTENANCE OF TRAFFIC PLAN
PRE-PHASE 2
STA. 19+50 TO STA. 32+50

PROJECT 39-20-02A
DATE: 12/3/19

7 / 9

126
505

OHIO TURNPIKE AND INFRASTRUCTURE COMMISSION

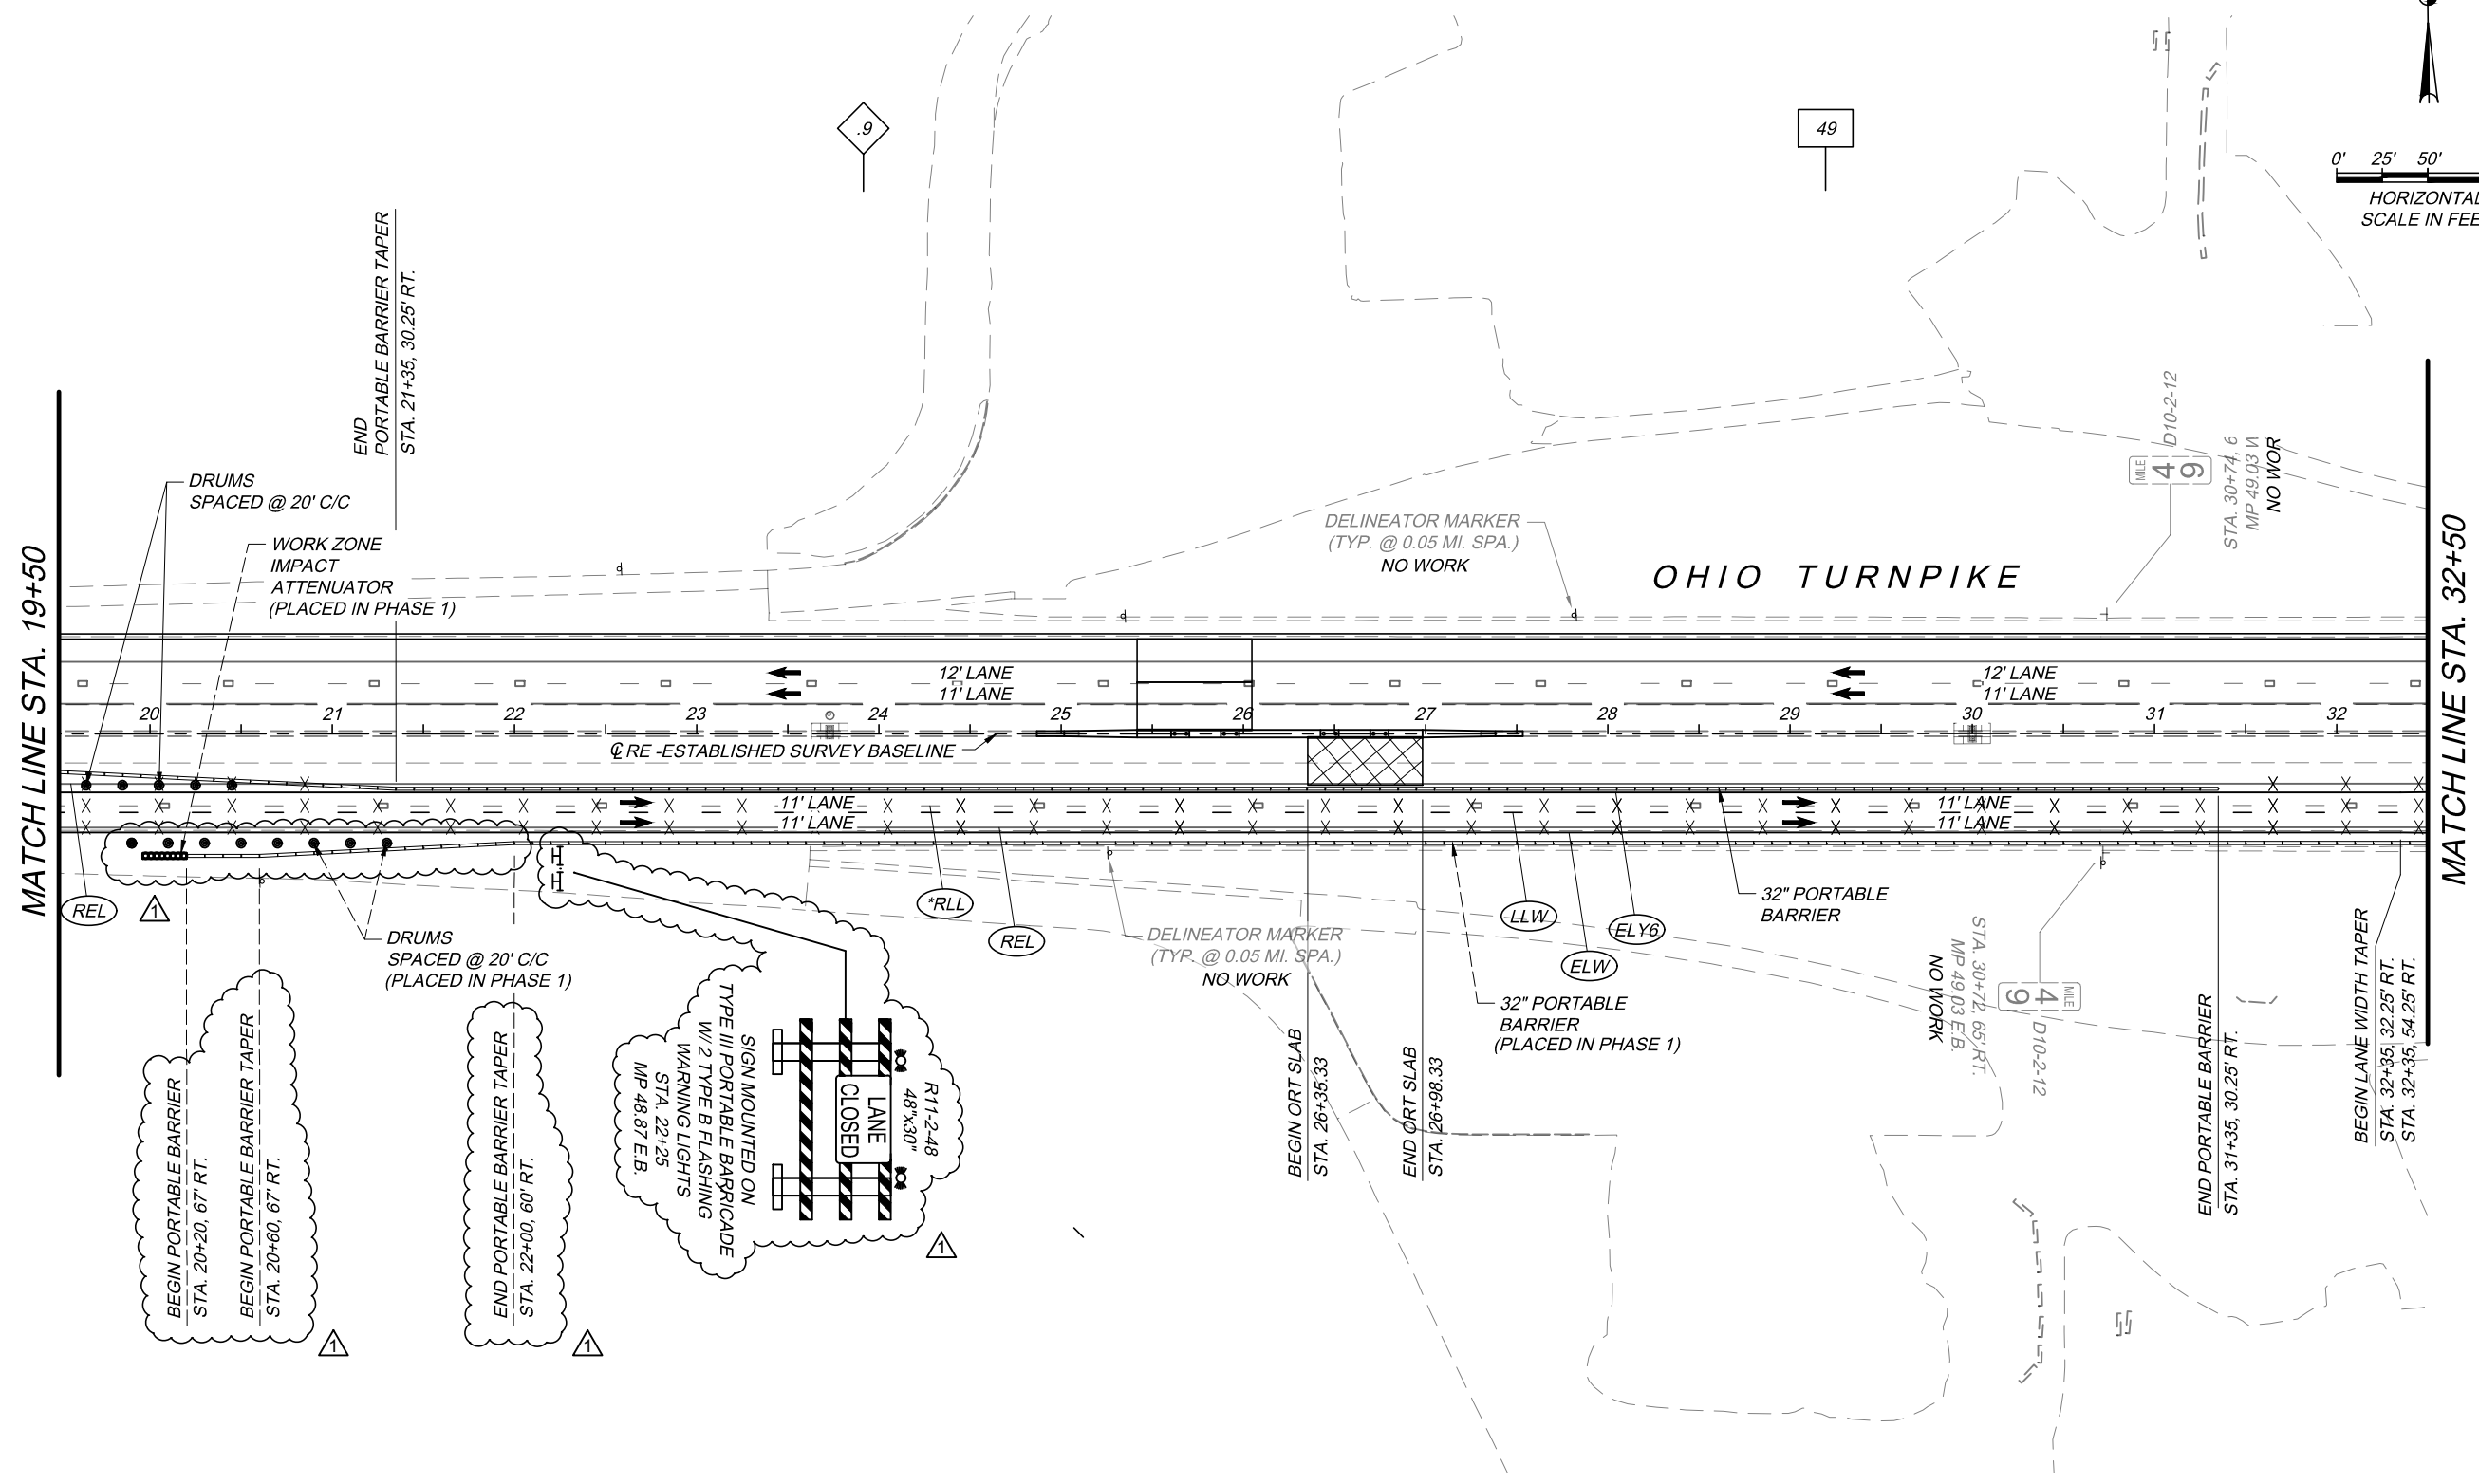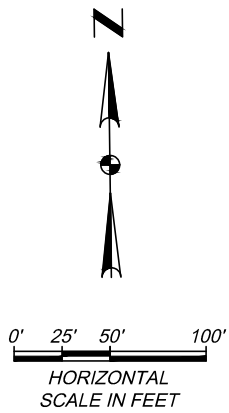

FOR ADDITIONAL MOT NOTES, EXISTING AND PROPOSED MOT LEGEND, SEE SHEET 51.
FOR ADDITIONAL TC NOTES, EXISTING AND PROPOSED TC LEGEND, SEE SHEET 421.

H:\2018\180192\DWG\SHEETS-5 MILES.C - 180192 - MOT PRE-PHASE 2-5 MILES.DWG - 1/14/2020 3:12:06 PM - JIM COBB

H:\2018\180192\DWG\SHEETS-5 MILES.C - 1 - 1/14/2020 8:57:05 AM - KEVIN ABRAMS

SHEET NUMBER													ITEM	GRAND TOTAL	UNIT	DESCRIPTION	SEE SHEET NO.	
19	20	22	173	174	175	176	178	181	183	396	397	PIS-1						
ROADWAY																		
1														201	1	LS	CLEARING AND GRUBBING, AS PER PLAN	19
	119													201	119	EACH	TREE REMOVED, 18" SIZE	
	58													201	58	EACH	TREE REMOVED, 30" SIZE	
	6													201	6	EACH	TREE REMOVED, 48" SIZE	
							44							202	44	EACH	HEADWALL REMOVED	
							2,104							202	2,104	FT	PIPE REMOVED, 24" AND UNDER	
							(135)▲				145			202	(280)▲	FT	PIPE REMOVED, OVER 24"	
							26							202	26	EACH	CATCH BASIN OR INLET REMOVED	
					49,266									202	49,266	FT	FENCE REMOVED	
		13,057												202	13,057	FT	GUARDRAIL REMOVED, AS PER PLAN	20
								(176,957)▲		752				202	(177,709)▲	SY	PAVEMENT REMOVED, AS PER PLAN	20
			386											202	386	FT	CONCRETE BARRIER REMOVED	
											2			202	2	EACH	STRUCTURE REMOVED	
10														202	10	CY	PORTIONS OF STRUCTURES REMOVED, AS PER PLAN	20
		200												202	200	SY	REMOVAL MISC.: CONCRETE CHANNEL REMOVED	22
							1							202	1	EACH	REMOVAL MISC.: STEEL PLATE REMOVED	22
												1		202	1	LS	REMOVAL MISC.: TEMPORARY SHEETING REMOVED	22
							124							SPECIAL	124	FT	PIPE CLEANOUT, 24" DIA AND UNDER	24
							662							SPECIAL	662	FT	PIPE CLEANOUT, 27" TO 48"	24
								(141)▲						203	(84,108)▲	CY	EXCAVATION	
					83,967									203	16,539	CY	EMBANKMENT, AS PER PLAN	20
		1,800			16,539									203	1,800	CY	ROADWAY EXCAVATION AND EMBANKMENT	20
														203	19,812	CY	EXCAVATION INCLUDING EMBANKMENT CONSTRUCTION, AS PER PLAN	PIS-1
														203	9,906	CY	BORROW	
														203	145	CY	GRANULAR MATERIAL, TYPE C	
														203	1,873	CY	GRANULAR EMBANKMENT, AS PER PLAN (SHEAR KEY)	PIS-1
														203	60	CY	GRANULAR EMBANKMENT, AS PER PLAN (NO. 8 AGGREGATE)	PIS-1
		227												204	227	SY	SUBGRADE COMPACTION	
		178												204	178	CY	EXCAVATION	
														204	600	SY	GEOTEXTILE FABRIC, 712.09, TYPE A	
														204	4,795	SY	GEOTEXTILE FABRIC, TYPE B	
		227												204	227	SY	GEOTEXTILE FABRIC, 712.09, TYPE D	
		216,545												206	216,545	SY	CEMENT STABILIZED SUBGRADE, 14 INCHES DEEP, AS PER PLAN	21
		12,000												206	12,000	SY	CEMENT STABILIZED SUBGRADE, 16 INCHES DEEP	
		10,280												206	10,280	TON	CEMENT	
		13,470												206	13,470	GAL	CURING COAT, AS PER PLAN	21
		140												206	140	HOUR	TEST ROLLING	
		6,785												206	6,785	SY	PRE-PULVERIZATION, 10 INCHES DEEP, AS PER PLAN	21
		6,785												206	6,785	SY	FULL-DEPTH RECLAMATION, 12 INCHES, AS PER PLAN	21
		2,040												206	2,040	GAL	FULL DEPTH RECLAMATION CURING COAT, AS PER PLAN	21
									42,608					209	42,608	FT	LINER GRADING, AS PER PLAN	20
	2,000													209	2,000	FT	DITCH CLEANOUT, AS PER PLAN	20
		178												SP 304	178	CY	GRANULAR MATERIAL	
			10,135											606	10,135	FT	GUARDRAIL, TYPE MGS, WITH LONG STEEL POSTS	
			15											606	15	EACH	ANCHOR ASSEMBLY, MGS TYPE T	
			1											606	1	EACH	ANCHOR ASSEMBLY, MGS TYPE A	
			11											606	11	EACH	MGS BRIDGE TERMINAL ASSEMBLY, TYPE 1, WITH LONG STEEL POSTS	
			7											606	7	EACH	MGS BRIDGE TERMINAL ASSEMBLY, TYPE 2	
			15											SP 606A	15	EACH	ANCHOR ASSEMBLY, MGS TYPE E	
			2											SP 606B	2	EACH	IMPACT ATTENUATOR, TYPE 2 (BI-DIRECTIONAL)	

GENERAL SUMMARY

DESIGNED	CHECKED	NO.	REVISED	BY	DATE
J.M.P.	W.D.B.	1		J.M.P.	11/20/20
DRAWN	IN CHARGE		ADDENDUM NO. 2		
K.P.A.	W.D.B.				

PROJECT 39-20-02A DATE: 12/3/19

1 / 4

169
505

H:\2018\180192\DWG\SHEETS-5 MILES.C - GENERAL SUMMARY-5 MILES.DWG - 3 - 1/14/2020 8:57:06 AM - KEVIN ABRAMS

SHEET NUMBER										ITEM	GRAND TOTAL	UNIT	DESCRIPTION	SEE SHEET NO.	
23	24	178	179	181	183	396	397	PIS-1							
		3.4								602	3.4	CY	CONCRETE MASONRY		
			42,536							SP 605	42,536	FT	6" BASE PIPE UNDERDRAIN, WITH FABRIC WRAP (18")		
			1,707							SP 605	1,707	FT	6" SHALLOW PIPE UNDERDRAIN, WITH FABRIC WRAP (24")		
			48,269							SP 605	48,269	FT	6" SHALLOW PIPE UNDERDRAIN, WITH FABRIC WRAP (30")		
										SP 605	2,425	FT	6" UNDERDRAIN OUTLET PIPE		
200										SP 605	200	FT	AGGREGATE DRAIN, TYPE 1, WITH FABRIC WRAP		
200										SP 605	200	FT	AGGREGATE DRAIN, TYPE 2, WITH FABRIC WRAP		
								255		SP 611	255	FT	4" CONDUIT, TYPE E, 707.31 (TYPE CP)		
								120		SP 611	120	FT	4" CONDUIT, TYPE F, 707.33		
		1,112								SP 611	1,112	FT	12" CONDUIT, TYPE F, 707.33		
		523								SP 611	523	FT	15" CONDUIT, TYPE B, 706.02		
		80								SP 611	80	FT	18" CONDUIT, TYPE B, 706.02		
		126								SP 611	126	FT	24" CONDUIT, TYPE B, 706.02		
		(217) Δ								SP 611	(217) Δ	FT	30" CONDUIT, TYPE B, 706.02		
							136			SP 611	136	FT	48" CONDUIT, TYPE A, 706.02, AS PER PLAN	22	
			75					6		SP 611	81	EACH	PRECAST REINFORCED CONCRETE OUTLET		
		7								SP 611	7	EACH	CATCH BASIN, NO. CB-1	22	
		17								SP 611	17	EACH	CATCH BASIN, NO. CB-1, AS PER PLAN	22	
		2								SP 611	2	EACH	CATCH BASIN, NO. 6 Δ		
		1								SP 611	1	EACH	CATCH BASIN, AS PER PLAN	22	
		4								SP 611	4	EACH	INLET, NO. I-3C (ODOT)		
		2								SP 611	2	EACH	WATER QUALITY BASIN		
		(2) Δ								SP 611	(2) Δ	EACH	MANHOLE, NO. 3		
		25								SPECIAL	25	EACH	12" PRECAST CONCRETE END SECTION	22	
		18								SPECIAL	18	EACH	15" PRECAST CONCRETE END SECTION	22	
		8								SPECIAL	8	EACH	18" PRECAST CONCRETE END SECTION	22	
		3								SPECIAL	3	EACH	30" PRECAST CONCRETE END SECTION	22	
							2			SPECIAL	2	EACH	48" PRECAST CONCRETE END SECTION	22	
													PAVEMENT		
	1,000			45,932		468				252	47,400	FT	FULL DEPTH PAVEMENT SAWING		
	670									254	670	SY	PAVEMENT PLANING, ASPHALT CONCRETE (VARIABLE DEPTH)		
			9,975	364						SP 302	10,339	CY	ASPHALT CONCRETE BASE, PG64-22 (SHOULDER)		
			46,100							SP 302	46,100	CY	ASPHALT CONCRETE BASE, PG64-22		
			12,460	4,453						SP 304	16,913	CY	AGGREGATE BASE (SHOULDER)		
			23,883		126					SP 304	24,009	CY	AGGREGATE BASE		
				2,439						SP 304	2,439	CY	AGGREGATE BASE (VARIABLE THICKNESS)		
			2,797	14						SP 402	2,811	CY	ASPHALT CONCRETE INTERMEDIATE COURSE OR RECYCLED ASPHALT CONCRETE INTERMEDIATE COURSE, PG64-22		
			6,064							SP 402	6,064	CY	ASPHALT CONCRETE INTERMEDIATE COURSE OR RECYCLED ASPHALT CONCRETE INTERMEDIATE COURSE, PG76-22 (FR)		
	6		2,403	12						SP 404	2,421	CY	ASPHALT CONCRETE SURFACE COURSE, USING CRUSHED STONE, PG64-22		
	16		5,201							SP 404	5,217	CY	ASPHALT CONCRETE SURFACE COURSE, USING CRUSHED SLAG, PG76-22 (FR)		
			112,944							SP 404A	112,944	FT	JOINT SEALER		
	40		36,217	313						407	36,570	GAL	NON-TRACKING TACK COAT		
						752				452	752	SY	15-1/4" NON-REINFORCED PORTLAND CEMENT CONCRETE PAVEMENT, CLASS QC 1, AS PER PLAN	24	
					356					SP 627	356	CY	STONE SHOULDER PROTECTION		
					18.35					SPECIAL	18.35	MILE	SONIC NAP ALERT PATTERN		

DESIGN AGENCY		BY DATE	
		JMP	1/15/2020
REVISIONS		ADDENDUM NO. 1	
NO.	1	ADDENDUM NO. 2	1
DESIGNED		CHECKED	
J.M.P.	W.D.B.	W.D.B.	W.D.B.
DRAWN	K.P.A.	IN CHARGE	W.D.B.
GENERAL SUMMARY			
PROJECT 39-20-02A		DATE: 12/3/19	
3 / 4		171	
505		OHIO TURNPIKE	

H:\2018\180192\DWG\SHEETS-5 MILES.C - ROADWAY SUBSUMMARY-5 MILES.DWG - DR-1 - 1/14/2020 8:57:17 AM - KEVIN ABRAMS

Main data table with columns: REF NO., SHEET NO., STATION TO STATION, SIDE, and various material descriptions (e.g., HEADWALL REMOVED, PIPE REMOVED, CONCRETE MASONRY, CONDUIT, CATCH BASIN, etc.) with associated quantities in different units (EACH, FT, CY).

Summary table for 'DRAINAGE SUB SUMMARY' showing totals for each material type. Includes subtotals for 'SUBTOTALS CARRIED TO SHEET 178'.

PROJECT 39-20-02A DATE: 12/31/19 5/11 177/505

DESIGN AGENCY logo and contact information.

Checklist table with columns: CHECKED, NO., W.D.B., IN CHARGE, W.D.B. Includes rows for J.M.P. and K.P.A.

REVISIONS table with columns: NO., ADDENDUM NO. 1, ADDENDUM NO. 2.

H:\2018\180192\DWG\SHEETS-5 MILES.C - ROADWAY SUBSUMMARY-5 MILES.DWG - DR-2 - 1/14/2020 8:57:18 AM - KEVIN ABRAMS


REF NO.	SHEET NO.	STATION TO STATION	SIDE																					SPECIAL	SPECIAL		601	602	SP 611	SP 611	SP 611	SP 611	SP 611	SP 611	SP 611	SP 611	SP 611	SP 611	SP 611	SPECIAL	SPECIAL	SPECIAL	SPECIAL
				202	202	202	202	202	SPECIAL	SPECIAL		601	602	SP 611	SP 611	SP 611	SP 611	SP 611	SP 611	SP 611	SP 611	SP 611	SP 611																				
				EACH	FT	FT	EACH	EACH	FT	FT		CY	CY	FT	FT	FT	FT	FT	FT	EACH	EACH	EACH	EACH	EACH	EACH	EACH	EACH	EACH	EACH	EACH	EACH	EACH	EACH	EACH									
D-55	204	1381+75.0	R	1	8							1.33			8																												
D-56	200	1330+35.0	L	1	60		1					1.33		63						1																							
D-57	200	1331+00.0	R	1	4																																						
D-58	200	1330+84.0	R	1	70		1					1.33		66						1																							
D-59	200	1331+25.0	R	1	45																																						
D-60	200	1333+00.0	L	1	57		1					1.33		57						1																							
D-61	200	1333+28.0	R	1	70		1					1.33		64						1																							
D-62	200	1334+93.0	L	1	92		1							54						1																							
D-63	201	1335+53.0	R	1	100		1					1.33		58						1																							
D-64	201	1337+28.0	L	1	90		1					1.33		52						1																							
D-65	201	1337+91.0	R	1	92		1					1.33		52						1																							
D-66	201	1339+00.0	L	1	49		1					1.33		49						1																							
D-67	201	1340+27.0	R	1	50		1					1.33		50						1																							
D-68	201	1341+00.0	L	1	45		1					1.33		41						1																							
D-69	201	1342+20.0	R	1	4							1.33																															
D-70	201	1342+51.0	R	1	45		1					1.33		47						1																							
D-71	201	1342+98.0	L	1	45		1					1.33		40						1																							
D-72	201	1345+17.0	L	1	38		1													1																							
D-73	201	1345+40.0	L									1.33		34						1																							
D-74	201	1345+40.0	R									1.33		44						1																							
D-75	201	1346+90.0	R	1	54		1																																				
D-76	200	1328+00.0	L									1.33		53						1																							
D-77	200	1328+09.0	L	1	65		1																																				
D-78	398	131+60.0	L		130																																						
D-79	398	132+10.0	L		130																																						
SUBTOTALS THIS SHEET				20	1,343		16					23		824	8																												
SUBTOTALS FROM SHEET 177				24	761		10	1	124	662		50	3.4	288	515	80	126		7		2	4	2	1		2	8	15	8	3													
TOTALS CARRIED TO GENERAL SUMMARY				44	2,104		26	1	124	662		73	3.4	1,112	523	80	126		7	17	2	4	2	1		2	25	18	8	3													

DESIGN AGENCY			
BY	DATE	REVISIONS	
JMP	1/15/2020	ADDENDUM NO. 1	
JMP	1/15/2020	ADDENDUM NO. 2	
DESIGNED	CHECKED	NO.	
J.M.P.	W.D.B.	1	
DRAWN	IN CHARGE	2	
K.P.A.	W.D.B.		
DRAINAGE SUB SUMMARY			
PROJECT 39-20-02A		DATE: 12/3/19	
6 / 11			
178		505	

H:\2018\180192\DWG\SHEETS-5 MILES.C - ROADWAY SUBSUMMARY-5 MILES.DWG - PC-A2 - 1/14/2020 8:57:22 AM - KEVIN ABRAMS

MAINLINE STATION TO STATION		SIDE	LENGTH	PAVEMENT WIDTH (AVG)	SHOULDER WIDTH (AVG)	SURFACE AREA	APPROACH SLAB AREA	AREA BY COMPUTER	202	203	252	SP 302	SP 302	SP 304	SP 304	SP 402	SP 402	SP 404	SP 404	SP 404A	407	
			FT	FT	FT	SF	SF	SF	SY	CY	FT	CY	CY	CY	CY	CY	CY	CY	FT	FT	GAL	GAL
RIGHT SIDE (EASTBOUND)																						
1281+00.00	1312+50.00	R	3150.00	19.00		59850			6,650													
1281+00.00	1312+50.00	R	3150.00	9.00		28350			3,150													
1312+50.00	1328+67.61	R	1617.61	24.75		40036			4,449		1,618											
1312+50.00	1328+67.61	R	1617.61	9.00		14559			1,618													
AI CREEK BRIDGE																						
1330+67.97	1335+70.29	R	502.32	24.75		12433			1,382													
1330+67.97	1335+70.29	R	502.32	9.00		4521			503													
SR 64 BRIDGE																						
1337+70.07	1377+50.00	R	3979.93	24.75		98504			10,945													
1337+70.07	1377+50.00	R	3979.93	9.00		35820			3,980													
1377+50.00	1378+00.00	R	50.00	24.75		1238			138													
1377+50.00	1378+00.00	R	50.00	9.50		475			53													
1378+00.00	1383+27.50	R	527.50	24.75		13056			1,451													
1378+00.00	1383+27.50	R	527.50	10.00		5275			587													
1383+27.50	1383+82.00	R	54.50	24.75		1349			150													
1383+27.50	1383+82.00	R	54.50	9.50		518			58													
1383+82.00	1384+16.60	R	34.60	24.75		857			96													
1383+82.00	1384+16.60	R	34.60	9.00		312			35													
STATION EQATION																						
00+30.00	01+00.00	R	70.00	24.75		1733			193													
00+30.00	01+00.00	R	70.00	9.00		630			70													
01+00.00	06+98.49	R	598.49	31.86			19070		2,392													
06+98.49	14+40.00	R	741.51	12.75		9455			1,051													
STATION EQATION																						
14+50.00	16+50.00	R	200.00	12.75		2550			284													
16+50.00	34+20.00	R	1770.00	12.75		22568			2,508													
16+50.00	34+20.00	R	1770.00	14.00		24780			2,754													
34+20.00	46+70.12	R	1250.12	12.75		15940			1,772													
46+70.12	48+70.00	R	199.88	41.68			8331		1,357													
48+70.00	118+40.00	R	6970.00	24.75		172508			19,168													
48+70.00	50+70.00	R	200.00	11.00		2200			245													
50+70.00	118+40.00	R	6770.00	9.00		60930			6,770													
STATION EQATION																						
119+00.00	125+00.00	R	600.00	24.75		14850			1,650													
119+00.00	125+00.00	R	600.00	9.00		5400			600													
125+00.00	130+96.93	R	596.93	19.00		11342			1,261													
125+00.00	130+96.93	R	596.93	9.00		5373			597													
RAMP D																						
01+00.00	16+00.85	R	1500.85	9.00		13508																
06+98.49	16+00.85	R	902.36	26.00		23462			2,095													
06+98.49	16+00.85	R	902.36	15.17			13693															
116+10.25	118+70.00	R	259.75	26.00		6754			734													
116+10.25	118+70.00	R	259.75	12.00		3117																
116+10.25	118+70.00	R	259.75	9.00		2338																
RAMP C																						
133+70.00	134+20.00	R	50.00	18.00		900			70													
133+70.00	134+20.00	R	50.00	9.00		450																
133+70.00	134+20.00	R	50.00	13.00		650																
34+19.71	46+70.12	R	1250.41	18.00		22508			7,800													
34+19.71	46+70.12	R	1250.41	10.57			13221															
34+19.71	48+70.00	R	1450.29	13.00		18854																
DRIVE APRON																						
1382+45.5	1383+25.5	R	80.00	30.00					987													
									110	41												
SUBTOTALS THIS SHEET									88,726	41	22,938	4,964	23,050	6,201	11,940	1,393	3,033	1,197	2,601	56,424	5,218	12,727
SUBTOTALS FROM SHEET 180									88,231	100	22,994	5,011	23,050	6,259	11,943	1,404	3,031	1,206	2,600	56,520	5,229	13,043
TOTALS CARRIED TO GENERAL SUMMARY									176,957	141	45,932	9,975	46,100	12,460	23,883	2,797	6,064	2,403	5,201	112,944	36,217	


DESIGNED	J.M.P.	IN CHARGE	K.P.A.
CHECKED	W.D.B.	IN CHARGE	W.D.B.
NO.	1	ADDENDUM NO. 2	
BY	JMP	DATE	12/3/19
PROJECT 39-20-02A			
DATE: 12/3/19			
PAVEMENT SUB SUMMARY			
9/11			
181			
505			

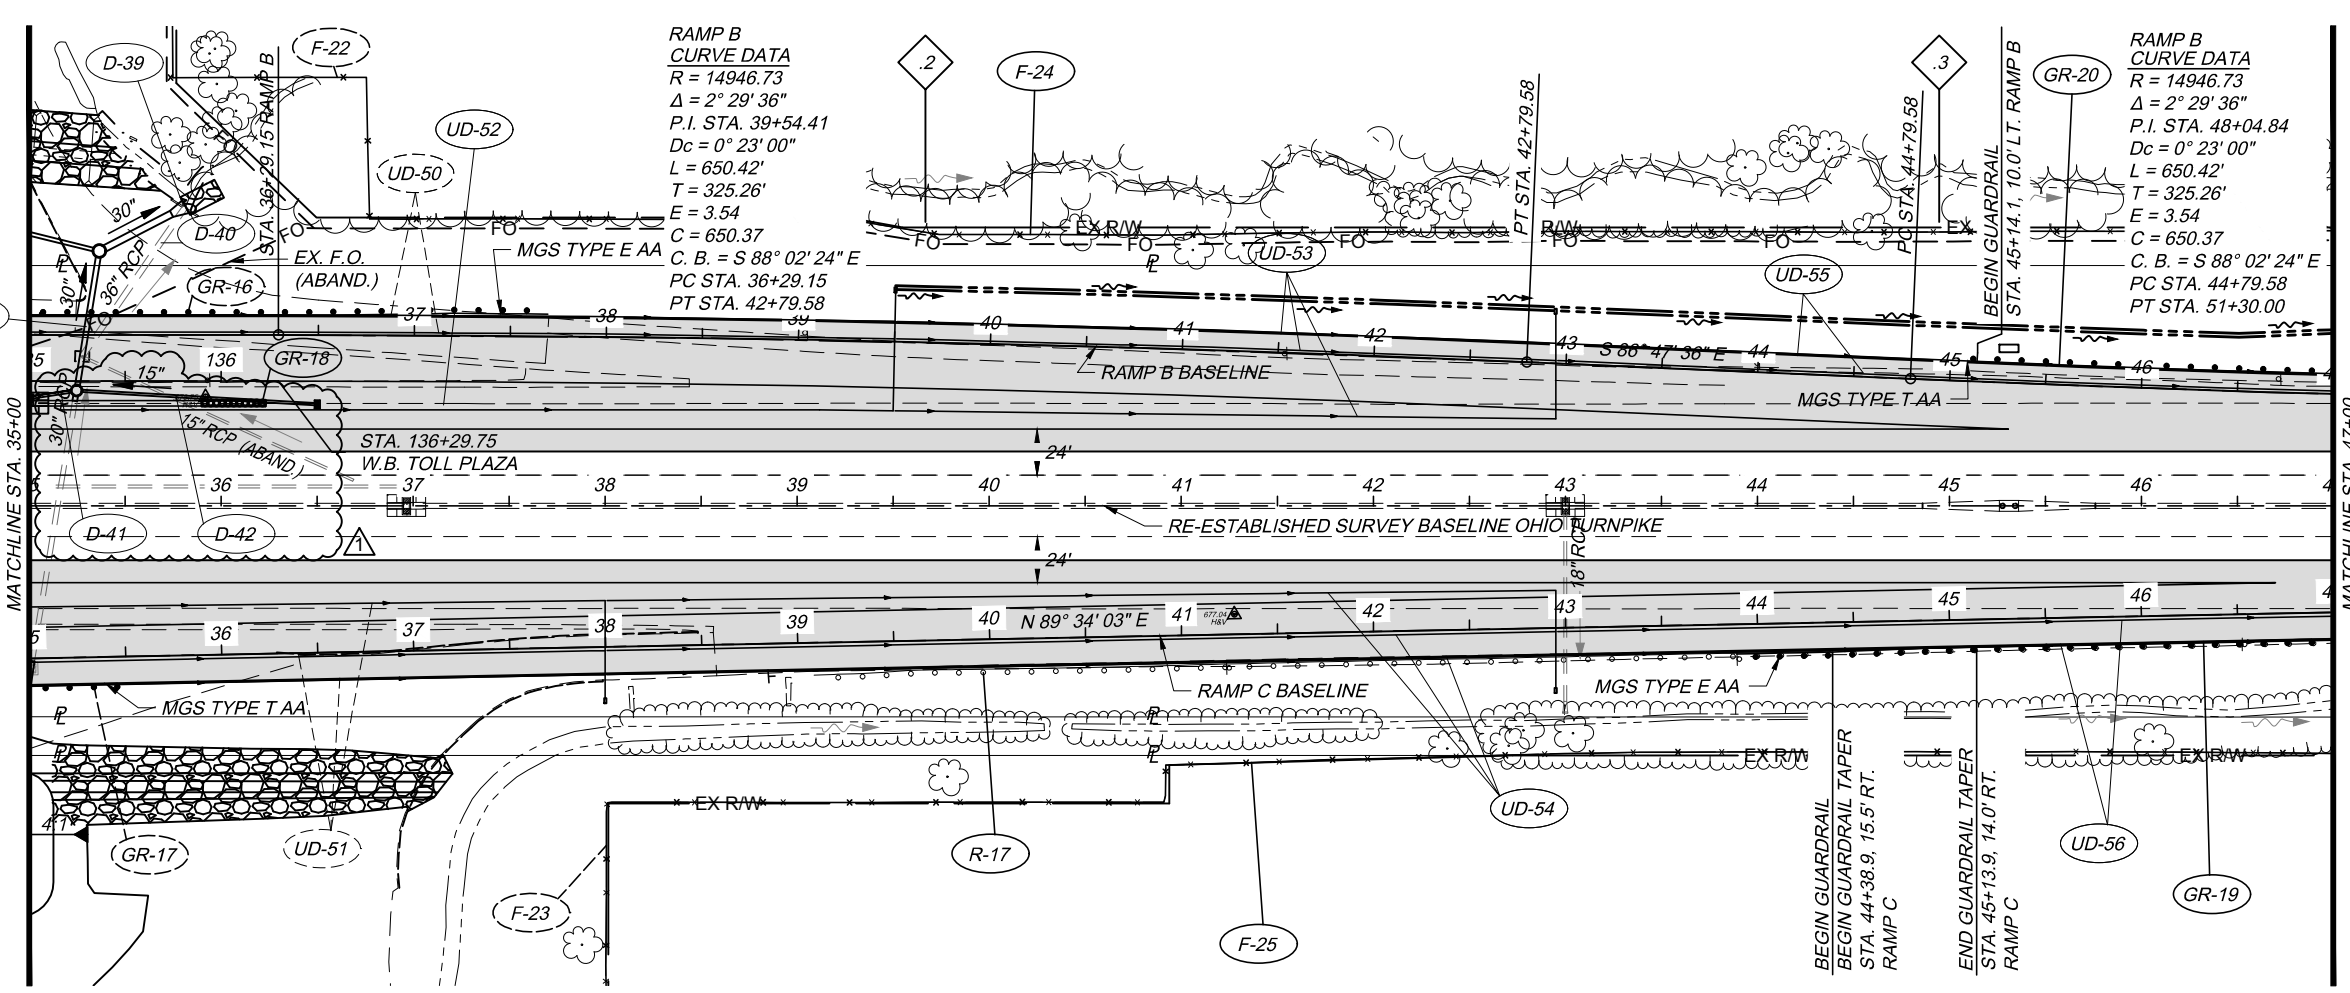

0' 25' 50' 100'
HORIZONTAL SCALE IN FEET

LEGEND

- 49 MILEPOST REFERENCE
- .2 TENTH OF MILEPOST REFERENCE
- PAVEMENT REPLACEMENT

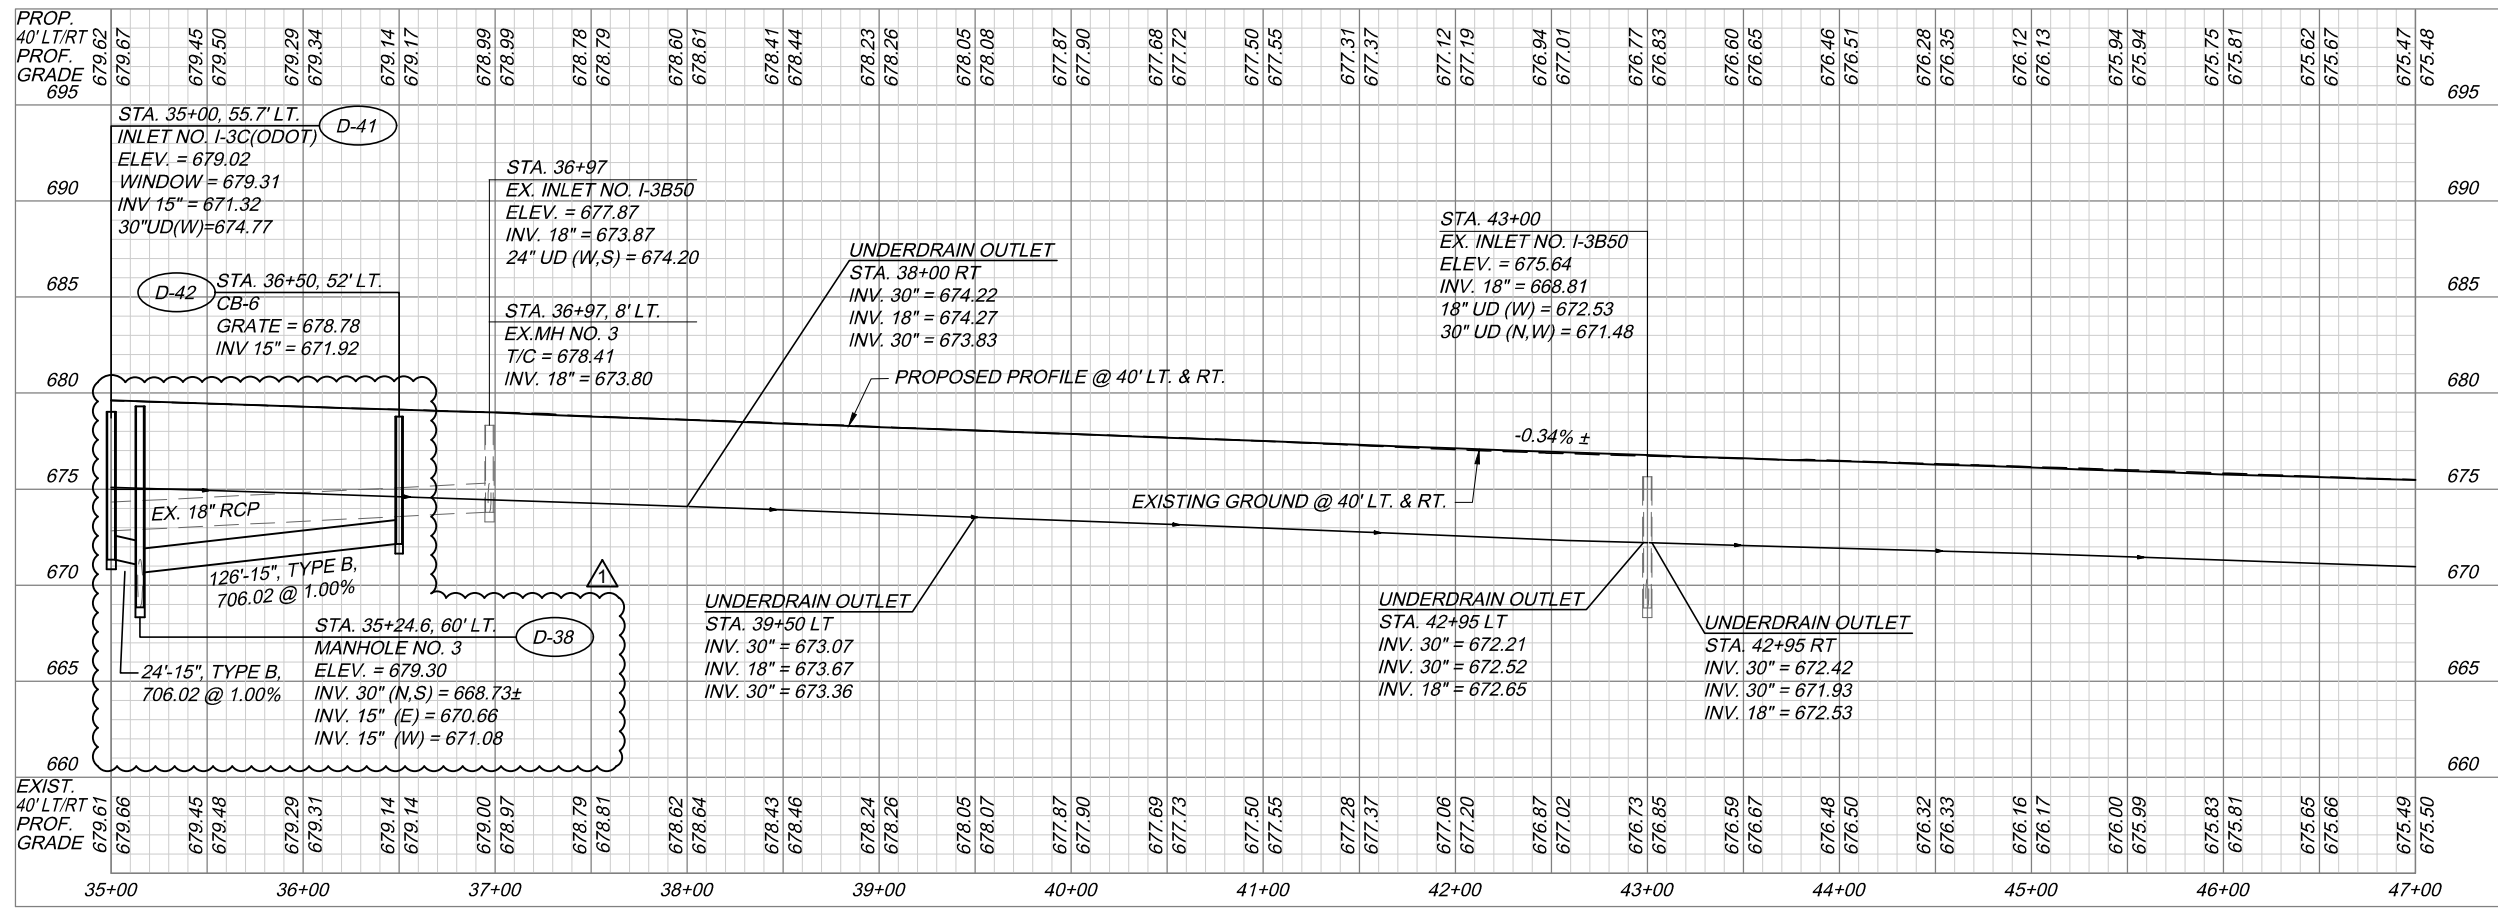


DESIGNED BY: J.M.P. / W.D.B. / K.P.A.
CHECKED BY: J.M.P. / W.D.B. / K.P.A.
DATE: 12/31/19

PROJECT 39-20-02A
PLAN AND PROFILE
STA. 35+00 TO STA. 47+00

14 / 22
208 / 505

OHIO TURNPIKE AND INFRASTRUCTURE COMMISSION

H:\2018\180192\DWG\SHEETS-5 MILES.C - 180192 - XSEC TOLL PLAZA WB-5 MILES.DWG - WBTP2 - 1/14/2020 9:03:21 AM - KEVIN ABRAMS

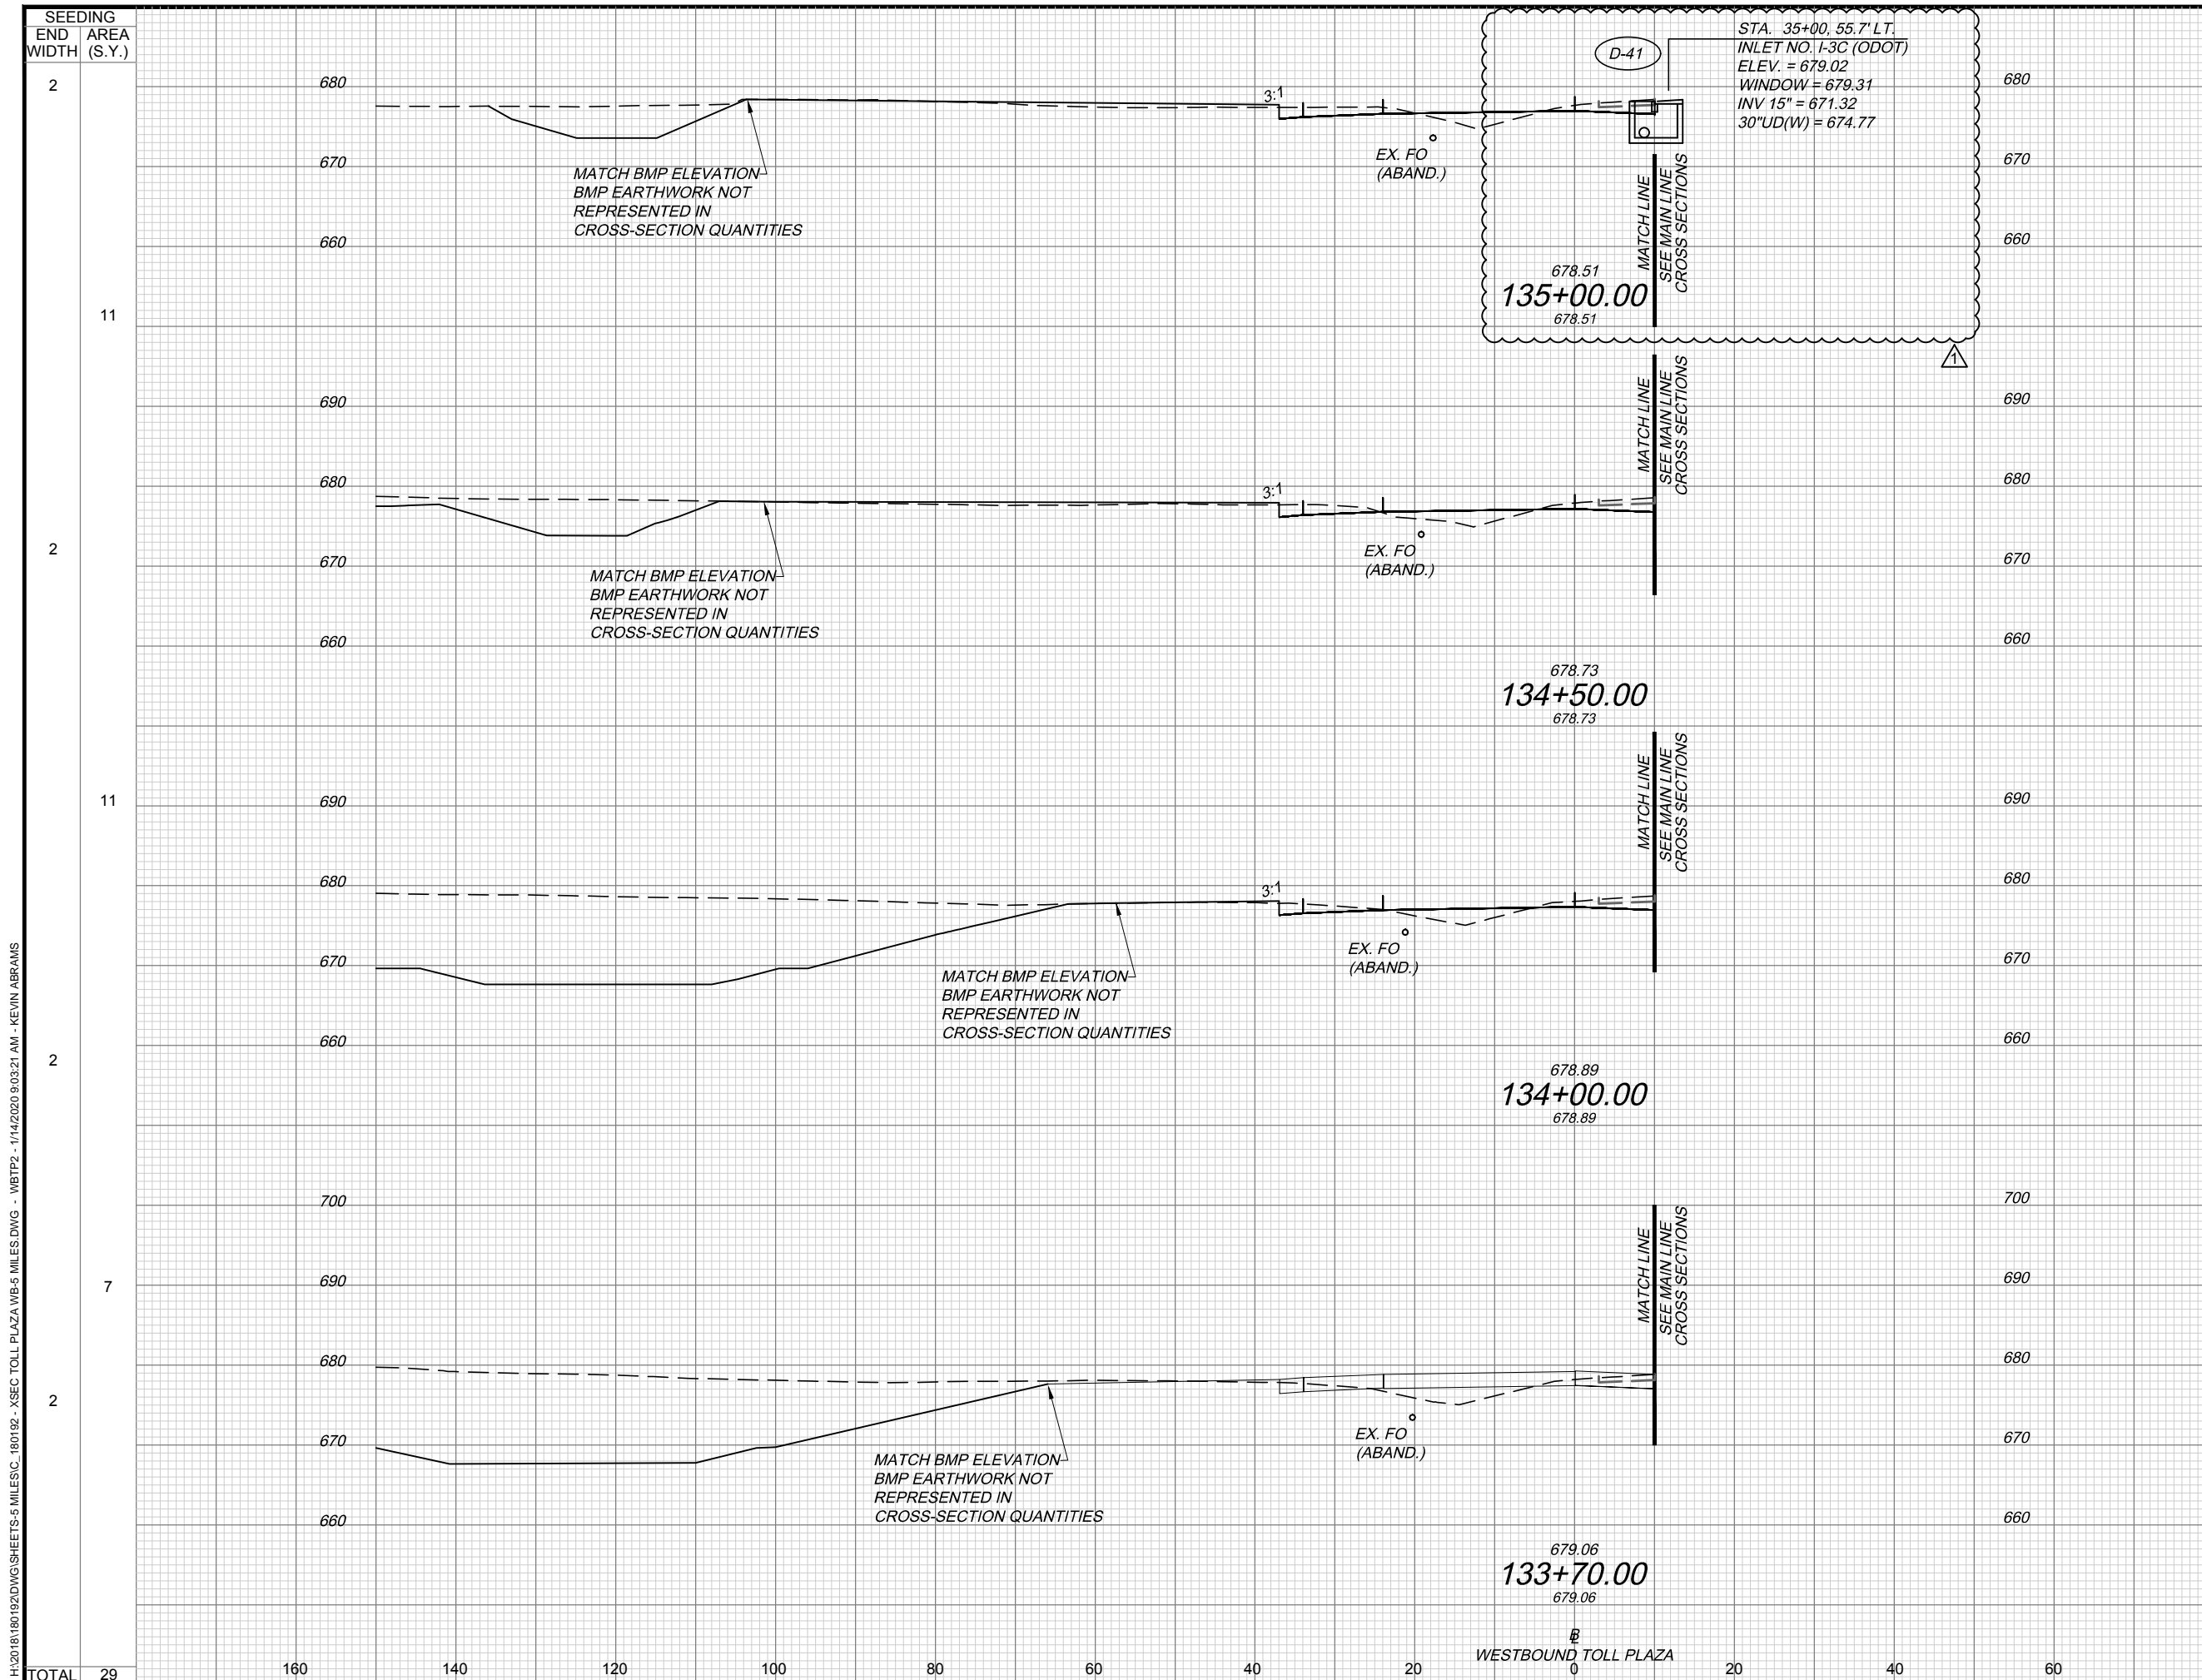

EARTHWORK			
END AREA	VOLUME		
(S.F.)	(C.Y.)	CUT	FILL
23	18		
		56	37
38	22		
		51	40
17	21		
		19	23
18	20		
TOTAL	126	100	

DESIGN AGENCY
CDM

BY DATE
JMP 1/15/2020

REVISIONS
ADDENDUM NO. 2

CHECKED NO. 1
W.D.B. IN CHARGE
K.P.A.

DESIGNED
J.M.P.
DRAWN
K.P.A.

PROJECT 39-20-02A
CROSS SECTIONS - WESTBOUND TOLL PLAZA
134+00 TO 135+00


DATE: 12/3/19

2 / 3

320
505

OHIO TURNPIKE AND INFRASTRUCTURE COMMISSION

H:\2018\180192\DWG\SHEETS-5 MILES.C - 180192 - XSEC TOLL PLAZA WB-5 MILES.DWG - WBTP3 - 1/14/2020 9:07:48 AM - KEVIN ABRAMS

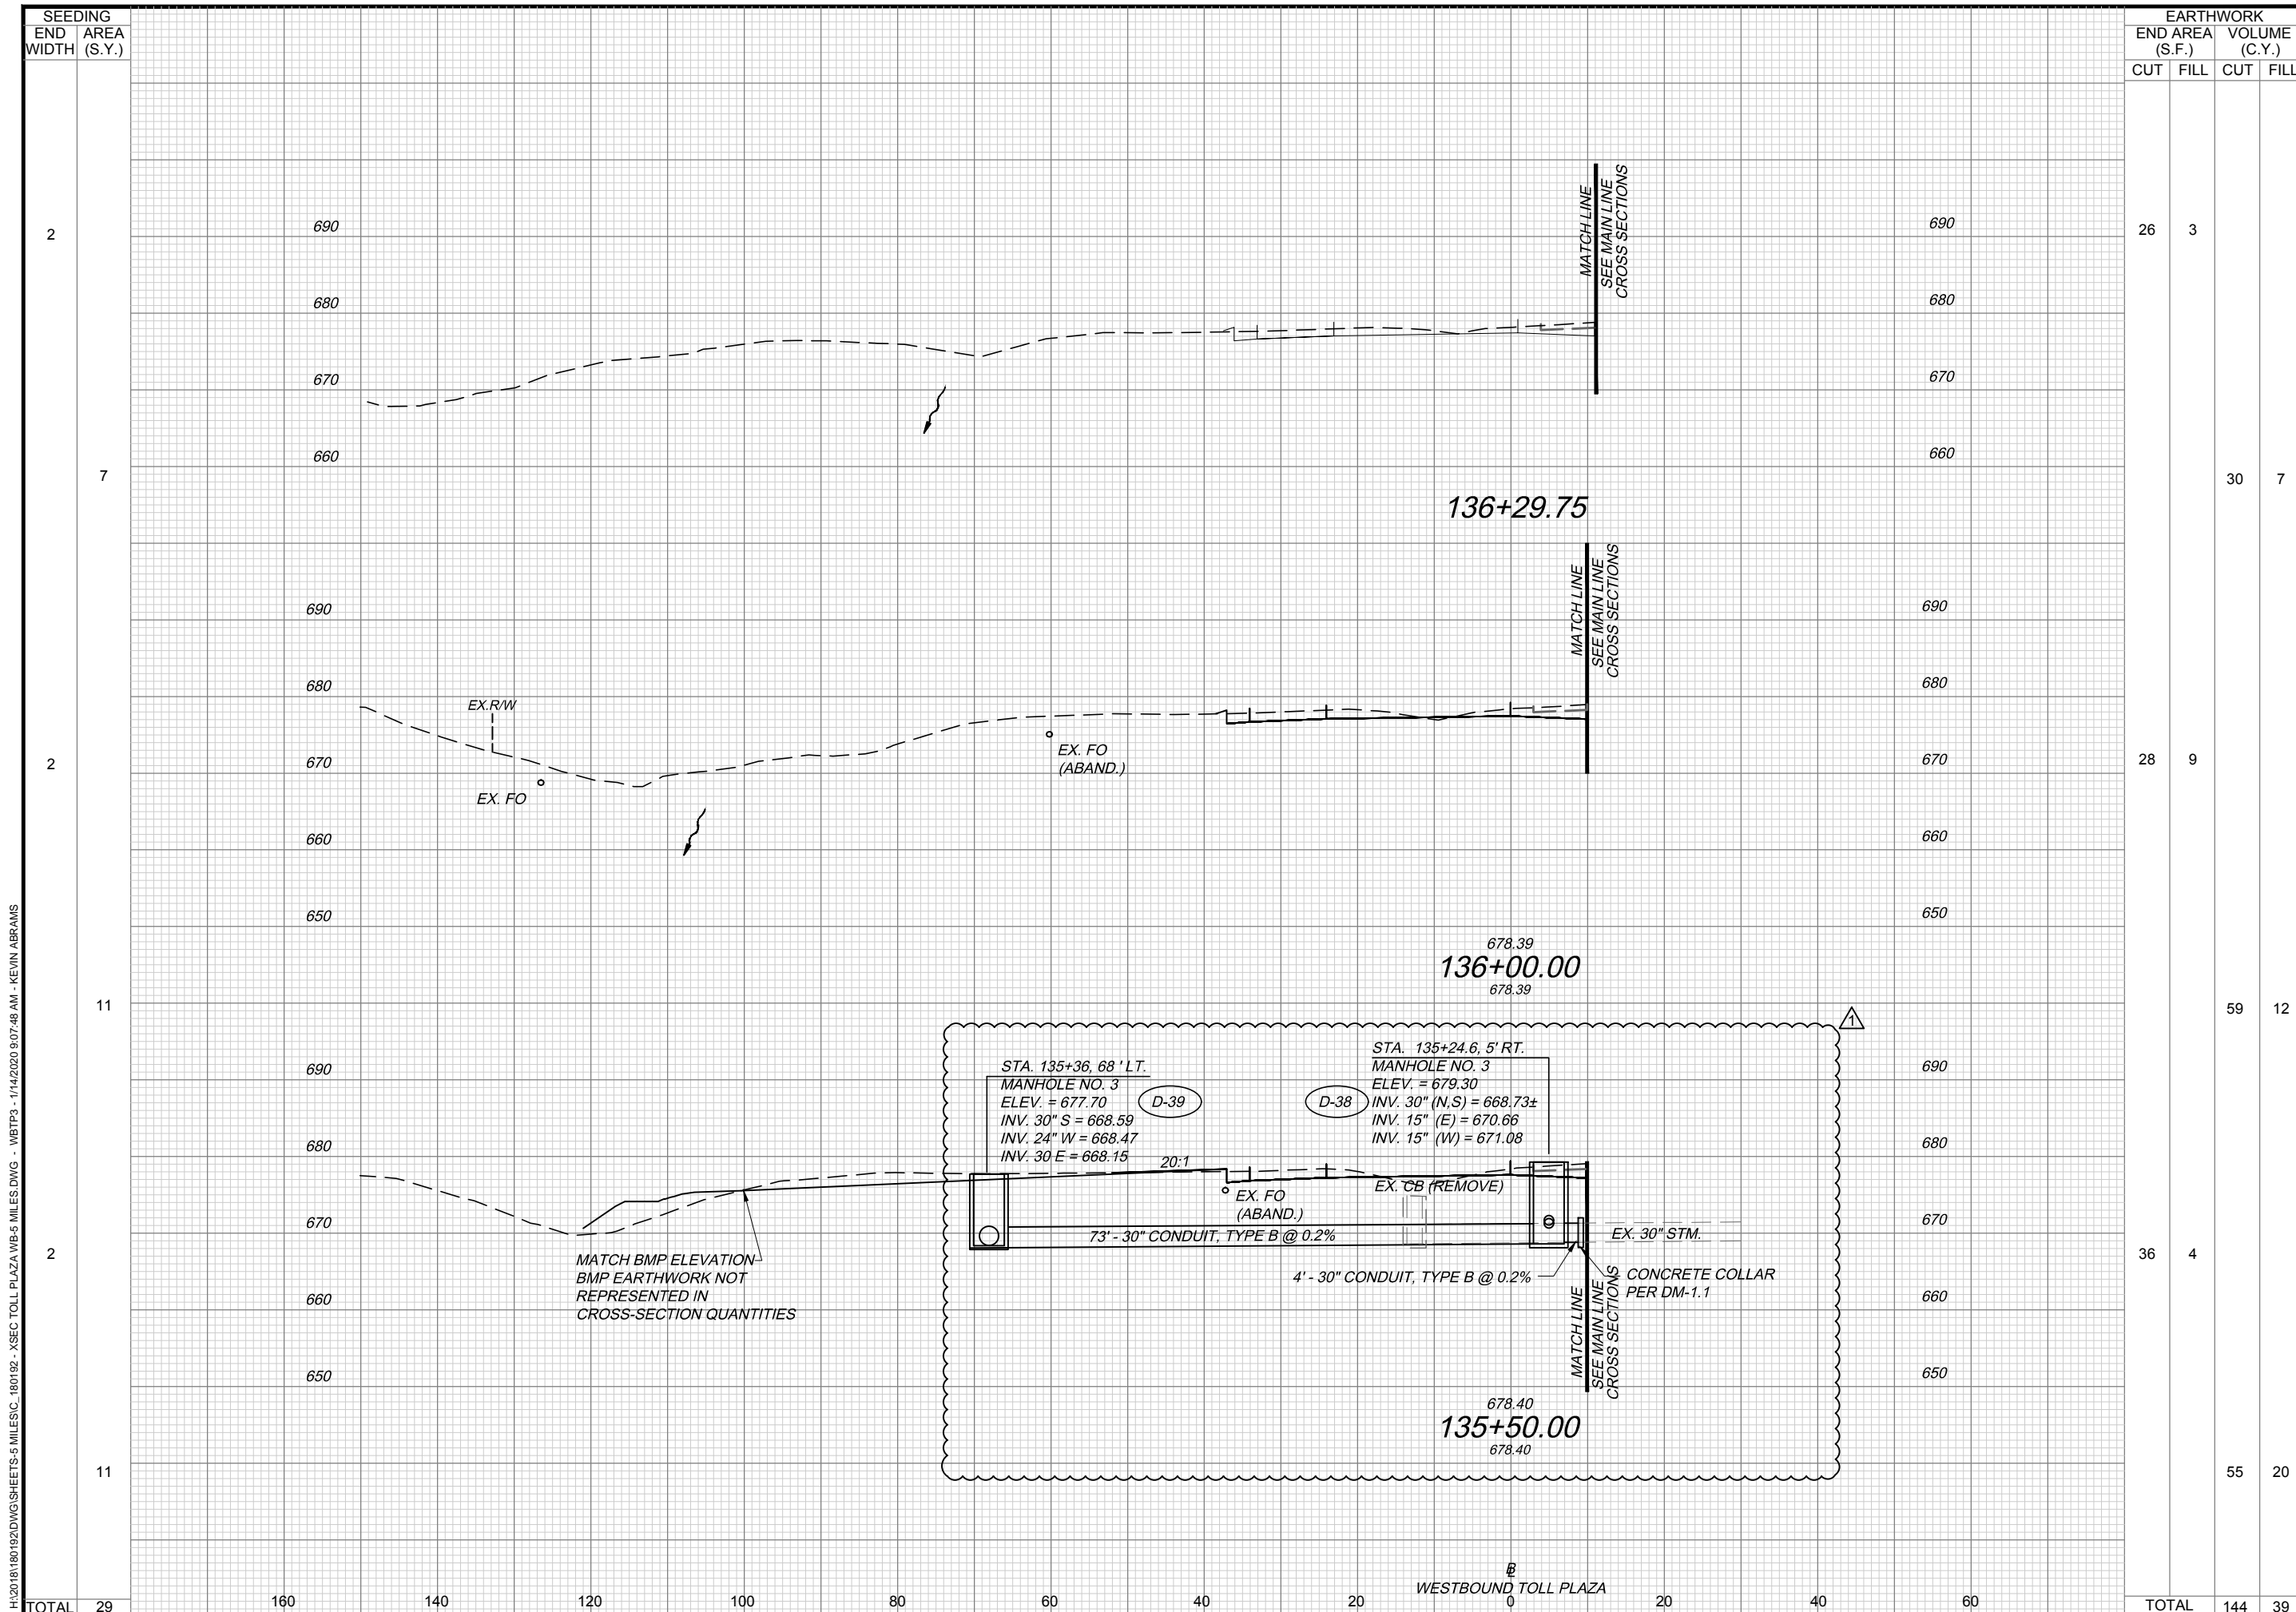

SEEDING	SEEDING	
	END WIDTH	AREA (S.Y.)
2		
7		
2		
11		
2		
11		
TOTAL	29	

EARTHWORK			
END	AREA	VOLUME	
CUT	FILL	CUT	FILL
(S.F.)	(S.F.)	(C.Y.)	(C.Y.)
26	3		
		30	7
28	9		
		59	12
36	4		
		55	20
TOTAL	144	39	

DESIGN AGENCY:

PROJECT 39-20-02A
DATE: 12/3/19

CROSS SECTIONS - WESTBOUND TOLL PLAZA
135+50 TO 136+00

DESIGNED BY: J.M.P.
DRAWN BY: K.P.A.

CHECKED BY: W.D.B.
IN CHARGE BY: W.D.B.

NO. 1
ADDENDUM NO. 2


BY: J.M.P.
DATE: 1/15/2020

OHIO TURNPIKE AND INFRASTRUCTURE COMMISSION


OHIO TURNPIKE

321
505

H:\2018\180192\DWG\SHEETS-5 MILES.C - TC ELEVATION VIEWS-5 MILES.DWG - TCE03 (2) - 1/14/2020 12:01:24 PM - JIM COBB

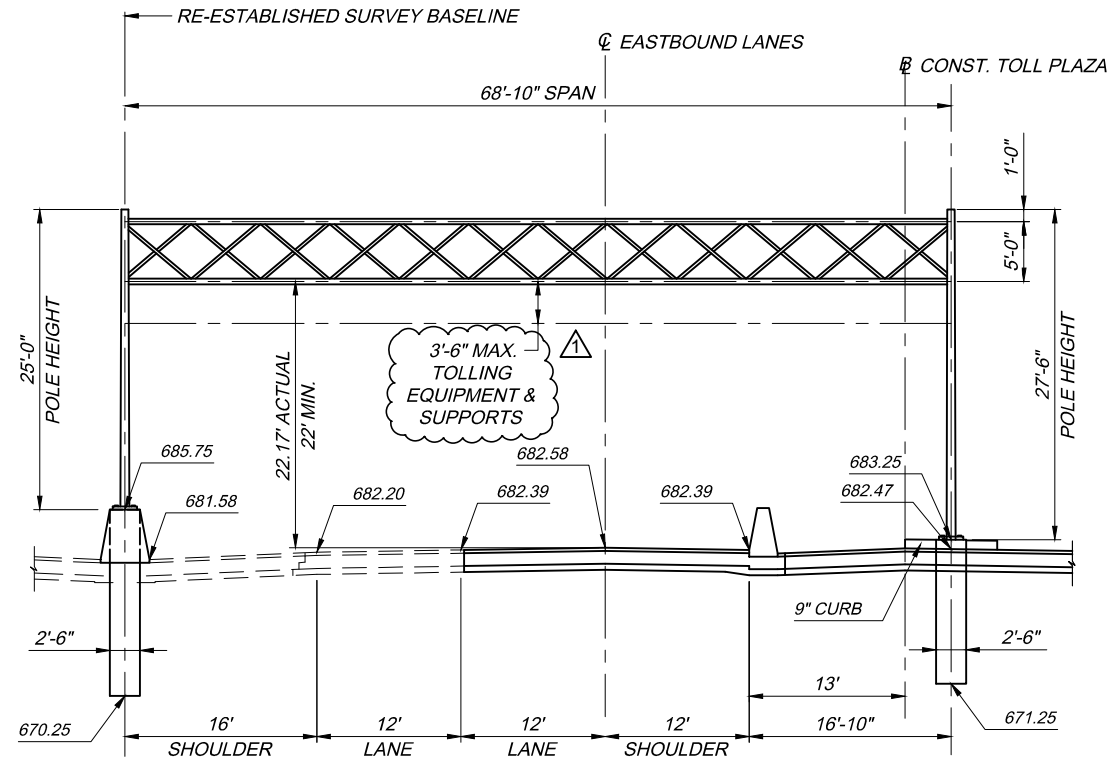


STA. 26+47.33, CL.
 STA. 26+47.33, 68'-10" RT.
 MP 48.95, I-80/90 E.B.
 OVERHEAD SIGN SUPPORT
 TC-7.65, DESIGN 8

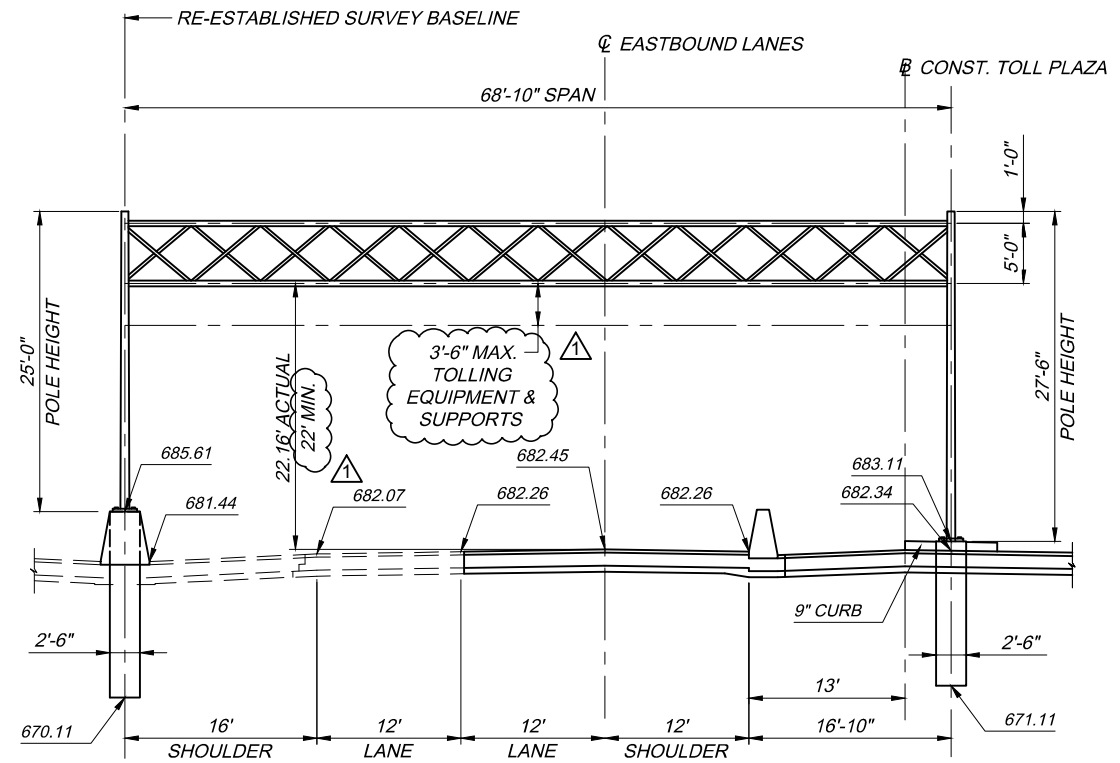


STA. 26+74.58, CL.
 STA. 26+74.58, 68'-10" RT.
 MP 48.96, I-80/90 E.B.
 OVERHEAD SIGN SUPPORT
 TC-7.65, DESIGN 8

	OHIO TURNPIKE AND INFRASTRUCTURE COMMISSION		REVISIONS ADDENDUM NO. 2	BY JMP	DATE 11/25/2020
			NO. 1	CHECKED T.J.H. IN CHARGE	DESIGNED W.D.B. DRAWN
PROJECT 39-20-02A		TRAFFIC CONTROL OVERHEAD TOLL EQUIPMENT - ELEVATION VIEWS			
DATE: 12/3/19		51 / 55			
472 / 505					

H:\2018\180192\DWG\SHEETS-5 MILES.C - TC ELEVATION VIEWS-5 MILES.DWG - TCE04 (2) - 1/14/2020 12:05:41 PM - JIM COBB

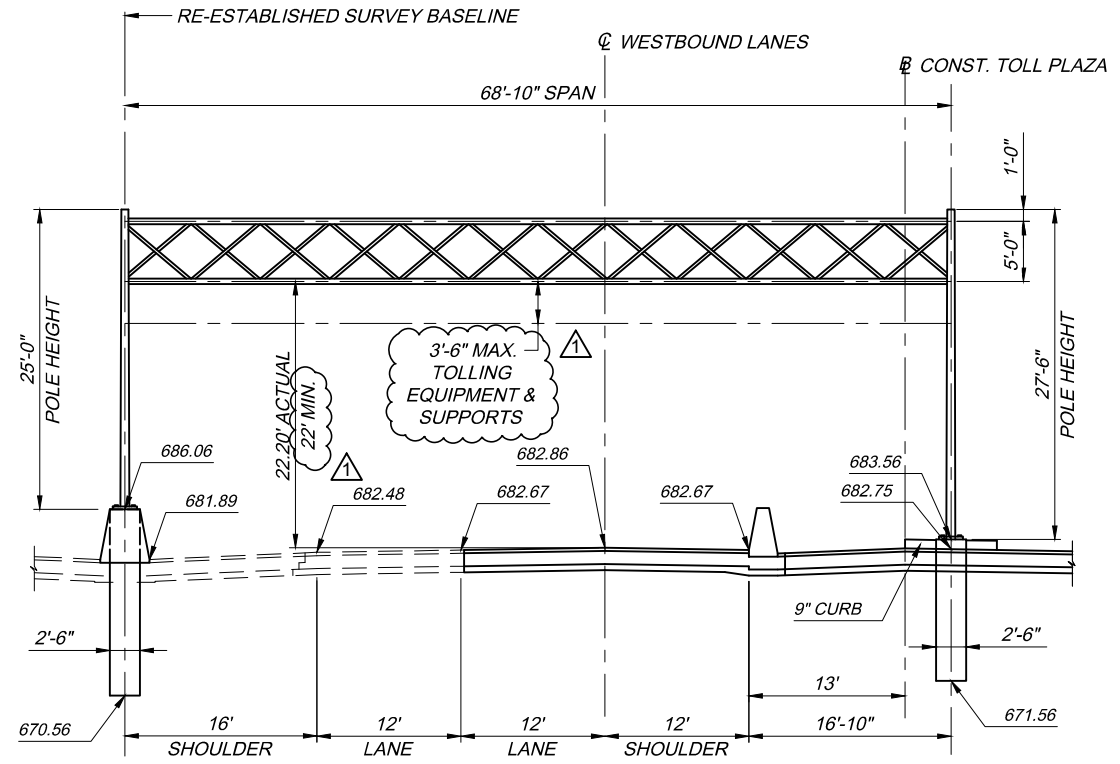

STA. 25+65.42, CL.
 STA. 25+65.42, 68'-10" LT.
 MP 48.93, I-80/90 W.B.
 OVERHEAD SIGN SUPPORT
 TC-7.65, DESIGN 8

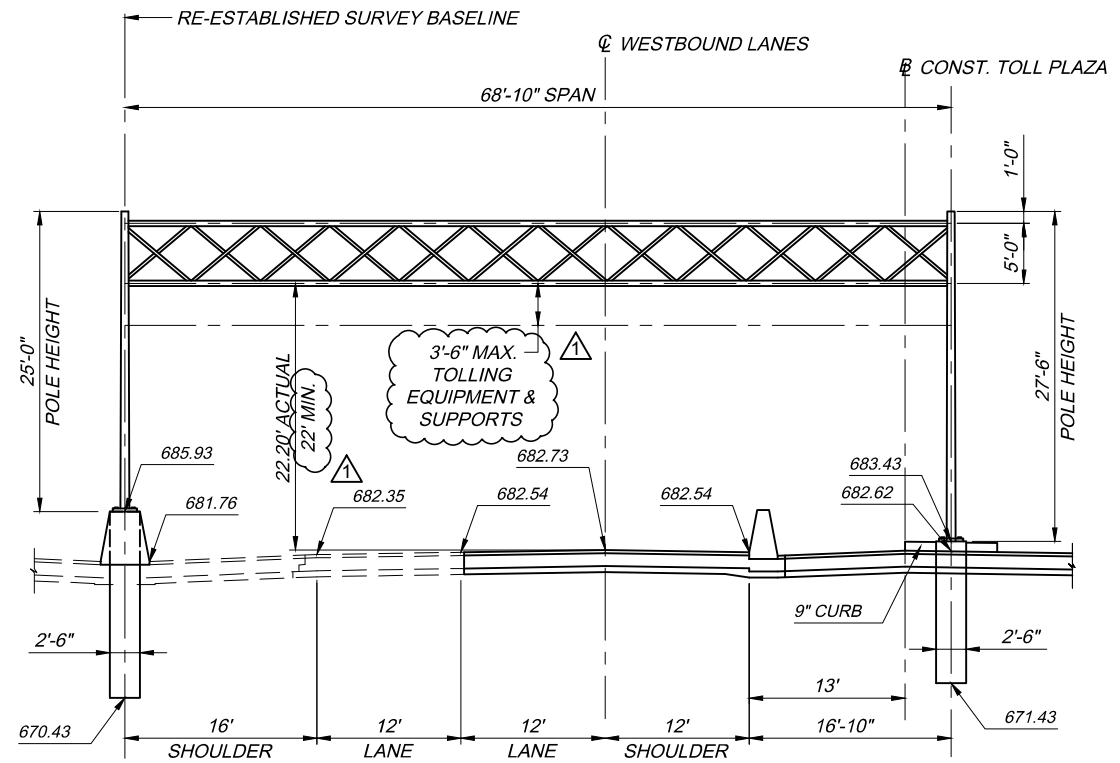


STA. 25+92.67, CL.
 STA. 25+92.67, 68'-10" LT.
 MP 48.94, I-80/90 W.B.
 OVERHEAD SIGN SUPPORT
 TC-7.65, DESIGN 8

	PROJECT 39-20-02A DATE: 12/3/19	TRAFFIC CONTROL OVERHEAD TOLL EQUIPMENT - ELEVATION VIEWS
52 / 55	CHECKED T.J.H. IN CHARGE	NO. 1 REVISIONS ADDENDUM NO. 2
	DESIGNED W.D.B. DRAWN J.D.C.	BY J.M.P. DATE 11/25/2020
	OHIO TURNPIKE AND INFRASTRUCTURE COMMISSION	

CHECKING PRINT

CHECKED: DATE: CORRECTED: DATE: APPROVED: DATE: BACKCHECKED: DATE: APPROVED: DATE:

nmnmGY001.dwg: 1/14/20 - 5:47pm

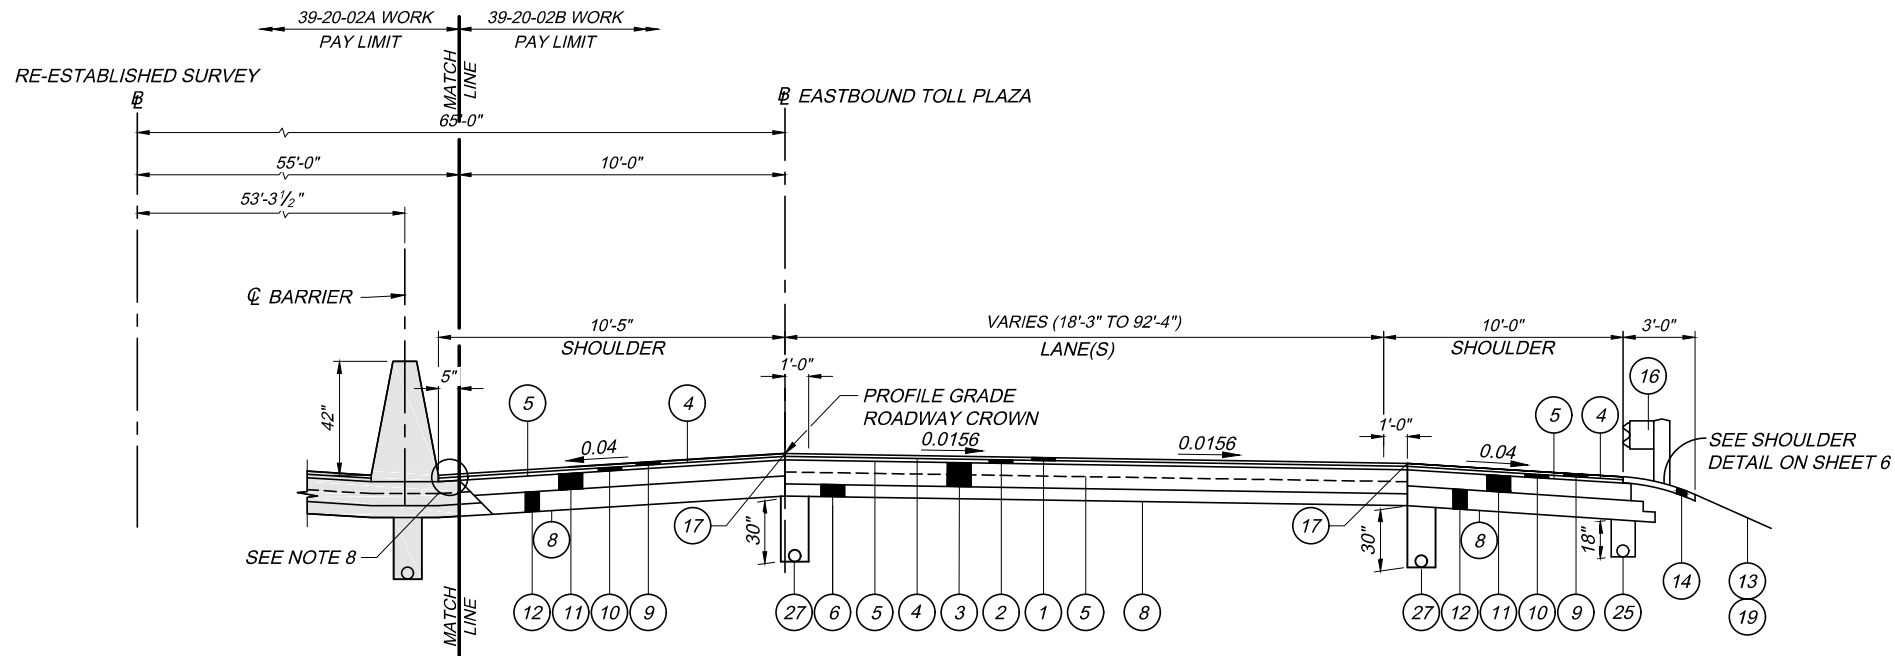

TOLL PLAZA APPROACH & DEPARTURE-NORMAL SECTION
 EASTBOUND SHOWN. WESTBOUND SYMMETRICAL ABOUT RE-ESTABLISHED SURVEY BASELINE

WESTBOUND
 STA. 118+70.00 TO STA. 123+70.00 = 500.00 LF
 STA. 128+70.00 TO STA. 133+70.00 = 500.00 LF

EASTBOUND
 STA. 118+70.00 TO STA. 123+70.00 = 500.00 LF
 STA. 128+70.00 TO STA. 133+70.00 = 500.00 LF

ITEM LEGEND

- | | |
|---|---|
| 1 ITEM SP 404 ASPHALT CONCRETE SURFACE COURSE, USING CRUSHED SLAG, PG 76-22 (FR) (T=1-1/2") | 25 ITEM SP 605 6" BASE PIPE UNDERDRAIN, WITH FABRIC WRAP (18") |
| 2 ITEM SP 402 ASPHALT CONCRETE INTERMEDIATE COURSE OR RECYCLED ASPHALT CONCRETE INTERMEDIATE COURSE, PG 76-22 (FR) (T=1-3/4") | 26 NOT USED |
| 3 ITEM SP 302 ASPHALT CONCRETE BASE, PG 64-22 (T=12") (2 EQUAL LIFTS) (SEE NOTE 1) | 27 ITEM SP 605 6" SHALLOW PIPE UNDERDRAIN, WITH FABRIC WRAP (30") |
| 4 ITEM 407 NON-TRACKING TACK COAT (APPLIED @ 0.06 GAL./S.Y.) | ++ 28 ITEM 609 CONCRETE CURB, TYPE 6, AS PER PLAN |
| 5 ITEM 407 NON-TRACKING TACK COAT (APPLIED @ 0.075 GAL./S.Y.) | ++ 29 ITEM 608 CONCRETE WALK WITH INTEGRAL CURB, AS PER PLAN |
| 6 ITEM SP 304 AGGREGATE BASE (T=6") | ++ 30 ITEM 608 CONCRETE WALK, AS PER PLAN |
| 7 ITEM 302 ASPHALT CONCRETE BASE, PG 64-22 (T=4") | 31 ITEM SP 404 NOT USED |
| 8 ITEM 206 CHEMICALLY STABILIZED SUBGRADE, AS PER PLAN (SEE NOTE 7) | 32 ITEM SP 403 NOT USED |
| 9 ITEM SP 404 ASPHALT CONCRETE SURFACE COURSE, USING CRUSHED STONE, PG 64-22 (T=1-1/2") | 33 ITEM 254 NOT USED |
| 10 ITEM SP 402 ASPHALT CONCRETE INTERMEDIATE COURSE OR RECYCLED ASPHALT CONCRETE INTERMEDIATE COURSE, PG 64-22 (T=1-3/4") | 34 ITEM SP 404 NOT USED |
| 11 ITEM SP 302 ASPHALT CONCRETE BASE, PG 64-22 (SHOULDER) (T=8") | 35 ITEM 254 NOT USED |
| 12 ITEM SP 304 AGGREGATE BASE (SHOULDER) (T=10") (2 EQUAL LIFTS) | 36 ITEM SP 404 NOT USED |
| 13 ITEM 659 SEEDING AND MULCHING | |
| 14 ITEM SP 627 STONE SHOULDER PROTECTION (WITH GUARDRAIL) (T=3") | |
| 15 ITEM SPECIAL SONIC NAP ALERT PATTERN (SNAP) | |
| 16 ITEM 606 GUARDRAIL, TYPE MGS WITH LONG STEEL POSTS | |
| 17 ITEM SP 404A JOINT SEALER (APPLIED TO VERTICAL FACE, SP 402 AND SP 404) (SEE NOTE 6) | |
| 18 ITEM SP 404 ASPHALT CONCRETE SURFACE COURSE, USING CRUSHED STONE, PG 64-22 (T=2") | |
| 19 ITEM 659 TOPSOIL (T=3") | |
| ++ 20 ITEM 206 FULL DEPTH RECLAMATION, 12" (SEE NOTE 7) | |
| 21 ITEM SP 304 AGGREGATE BASE (VARIABLE THICKNESS) (WITHOUT GUARDRAIL) | |
| 22 NOT USED | |
| 23 ITEM 204 SUBGRADE COMPACTION | |
| 24 ITEM 209 LINEAR GRADING | |

COMMON NOTES

- NOTE 1: ITEM 407 - NON-TRACKING TACK COAT SHALL BE PLACED ON SURFACE OF SP 302 AND SHALL BE PLACED BETWEEN THE LIFTS OF SP 302.
- NOTE 2: THE TRAVELED LANE PAVEMENT COMPOSITION WILL EXTEND 1 FOOT INTO THE SHOULDER.
- NOTE 3: ASPHALT OR CONCRETE CURB SHALL BE SEALED PER THE REQUIREMENTS OF SP 400.
- NOTE 4: ALL EXPOSED SUBGRADE WILL HAVE SUBGRADE STABILIZATION PERFORMED USING ITEM 206 - CHEMICALLY STABILIZED SUBGRADE, AS PER PLAN, PAID UNDER CONTRACT 39-20-02A.
- NOTE 5: FOR PAVEMENT AND SHOULDER WIDTHS AND CROSS SLOPES, SEE PAVEMENT DETAILS ON SHEETS 55 - 58.
- NOTE 6: JOINT SEALER APPLIED TO ALL CONSTRUCTION JOINTS.
- NOTE 7: THIS ITEM OF WORK IS DEFINED AND PAID FOR UNDER CONTRACT 39-20-02A.
- NOTE 8: THE 5" WIDTH OF SP 404 AND SP 402 SHALL BE PAID FOR UNDER CONTRACT 39-20-02B.

* SLOPE VARIES. SEE PAVEMENT DETAILS ON SHEETS 55 - 58 FOR SLOPES. (7% MAXIMUM ROLLOVER FOR SHOULDERS)

** MATCH RATE OF SUPER IF GREATER THAN 0.04

*** ROUNDING OCCURS IF PAVEMENT CROSS SLOPE EXCEED 0.06

++ NOT FOR PAYMENT IN CONTRACT 39-20-02B, SEE CONTRACT 58-20-01 FOR PAYMENT.

DESIGN AGENCY: **JACOBS**
 101 ST. JAMES SQUARE, 9 FLOOR
 BOSTON, MASS 02116
 OFFICE 617.261.8222

PROJECT 39-20-02B
 DATE: 12/20/2019
 TP-49

TYPICAL SECTIONS-TOLL PLAZA
 NORMAL SECTION
 LUCAS COUNTY

1/4
 3/59

OHIO TURNPIKE AND INFRASTRUCTURE COMMISSION
 OHIO TURNPIKE

CHECKING PRINT

CHECKED: DATE: CORRECTED: DATE: APPROVED: DATE: BACKCHECKED: DATE:

CONSTRUCTION SPECIFICATIONS:

THE STATE OF OHIO DEPARTMENT OF TRANSPORTATION CONSTRUCTION AND MATERIALS SPECIFICATIONS, DATED JANUARY 1, 2016, WITH LATEST REVISIONS AND THE OHIO TURNPIKE AND INFRASTRUCTURE COMMISSION (OTIC) SPECIAL PROVISIONS CONTAINED IN THE CONTRACT DOCUMENTS SHALL GOVERN THIS PROJECT.

ODOT ITEM REFERENCES:

ALL REFERENCES TO ODOT ITEMS REFER TO THE OHIO DEPARTMENT OF TRANSPORTATION CONSTRUCTION AND MATERIALS SPECIFICATIONS, 2016 EDITION. ALL SPECIFICATIONS NOTED IN THESE PLANS SHALL REFER TO THE ODOT CMS UNLESS NOTED OTHERWISE OR THE SPECIFICATION IS PREFIXED BY 'SP' WHICH SHALL REFER TO OHIO TURNPIKE AND INFRASTRUCTURE COMMISSION SPECIAL PROVISIONS.

WORK LIMITS:

THE WORK LIMITS SHOWN ON THESE PLANS ARE FOR PHYSICAL CONSTRUCTION ONLY AND SHALL BE RESTRICTED TO WITHIN THE OTIC PROPERTY AND THE CONTRACTOR SHALL MINIMIZE ALL DISTURBANCES TO THE SPECIFIC CONSTRUCTION OF THE ITEMS DESCRIBED IN THESE PLANS. WITH APPROVAL OF THE CHIEF ENGINEER, THE CONTRACTOR SHALL DESIGNATE SITE STORAGE AND EQUIPMENT AREAS AND THE OTIC ENGINEERING AND MAINTENANCE DEPARTMENTS. THE INSTALLATION AND OPERATION OF ALL TEMPORARY TRAFFIC CONTROL AND TEMPORARY TRAFFIC CONTROL DEVICES REQUIRED BY THESE PLANS SHALL BE PROVIDED BY THE CONTRACTOR WHETHER INSIDE OR OUTSIDE THESE WORK LIMITS.

COOPERATION BETWEEN CONTRACTORS:

THE CONTRACTOR SHALL COOPERATE AND COORDINATE HIS/HER OPERATION WITH THE CONTRACTORS ON OTHER PROJECTS THAT MAY BE IN FORCE DURING THE LIFE OF THE CONTRACT. NO WAIVER OF ANY PROVISIONS OF SP 107 IS INTENDED.

ORIGINAL CONSTRUCTION PLANS:

THE ORIGINAL CONSTRUCTION PLANS, SHOWING THE ORIGINAL ALIGNMENT, PROFILE, AND DETAILS OF THE SERVICE PLAZA ARE AVAILABLE ON BID EXPRESS, WITH THE OTHER CONTRACT DOCUMENTS.

CONTINGENCY QUANTITIES:

THE CONTRACTOR SHALL NOT ORDER MATERIALS OR PERFORM WORK FOR ITEMS DESIGNATED BY PLAN NOTE TO BE USED "AS DIRECTED BY THE ENGINEER" UNLESS AUTHORIZED BY THE ENGINEER. THE ACTUAL WORK LOCATIONS AND QUANTITIES USED FOR SUCH ITEMS SHALL BE INCORPORATED INTO THE FINAL CHANGE ORDER GOVERNING COMPLETION OF THIS PROJECT.

ROUNDING:

THE ROUNDING AT SLOPE BREAKPOINTS SHOWN ON THE TYPICAL SECTION APPLY TO ALL CROSS-SECTIONS UNLESS OTHERWISE SHOWN.

PROJECT CONTROL/OTIC PERMANENT MONUMENT POSITIONAL PARAMETERS:

PRIMARY PROJECT CONTROL MONUMENTS GOVERN ALL POSITIONING ON THIS PROJECT. SEE SHEET 2 FOR PROJECT CONTROL INFORMATION. COORDINATES SHOWN ARE GRID COORDINATES.

POINT: PERMON 49.43 SECTION 71-18-02 MILEPOST: 49.43 SURVEY DATE: 05/08/18

VERTICAL POSITIONING:

ORTHOMETRIC HEIGHT DATUM: NAVD 88 GEOID: 2012B

HORIZONTAL POSITIONING:

REFERENCE FRAME: NAD 83 (CORS2011) ELLIPSOID: GRS80 MAP PROJECTION: LAMBERT CONFORMAL CONIC COORDINATE SYSTEM: OHIO NORTH ZONE (3401) COMBINED SCALE FACTOR: 0.99995577 ORIGIN OF SCALE (X,Y) - EASTING (X): 0, NORTHING (Y): 0

UNITS:

FURNISHED UNITS ARE IN U.S. SURVEY FEET. FOR METRIC USE THE FOLLOWING CONVERSION FACTOR: 1 METER = 3.28083333333 U.S. SURVEY FEET.

CONTRACTOR STAGING AREA:

THE EXISTING SERVICE PLAZA SP - 2 (MILEPOST 49), NORTH AND SOUTH, IS AVAILABLE FOR A CONTRACTOR STAGING AREA. CURRENTLY, THERE IS ELECTRIC SERVICE ON BOTH THE NORTH AND SOUTH SIDE. IF A CONTRACTOR CHOOSES A STAGING AREA WITHIN THE TURNPIKE RIGHT OF WAY OTHER THAN WHAT IS INDICATED IN THE PLANS, IT MUST BE SUBMITTED TO THE CHIEF ENGINEER FOR APPROVAL PRIOR TO USE. AN EXISTING OFFICE TRAILER AREA IS PROVIDED ON THE NORTH SIDE AS SHOWN ON THE CONTRACT COORDINATION DRAWINGS (39-20-02B).

THE STAGING AREA SHALL BE MAINTAINED BY THE CONTRACTOR AND RESTORED TO ITS ORIGINAL CONDITION AND APPROVED BY THE CHIEF ENGINEER PRIOR TO COMPLETION OF ALL WORK.

ENDANGERED SPECIES - INDIANA BAT:

THIS PROJECT IS WITHIN THE RANGE OF THE FEDERALLY OF THE FEDERALLY ENDANGERED INDIANA BAT (MYOTIS SODALIS). THE ROOSTING HABITAT FOR THE INDIANA BAT CONSISTS OF LIVING OR DEAD TREES OR SNAGS WITH EXFOLIATING, PEELING OR LOOSE BARK, SPLIT TRUNKS AND/OR BRANCHES OR CAVITIES. THEREFORE, ANY UNAVOIDABLE CUTTING OF SUCH TREES OR SNAGS WILL BE PERFORMED ONLY AFTER SEPTEMBER 30 AND BEFORE APRIL 1. PRIOR TO ANY REHABILITATION/REMOVAL, THE UNDERSIDE OF THE EXISTING BRIDGE SHALL BE CAREFULLY EXAMINED FOR THE PRESENCE OF BATS, ESPECIALLY FROM APRIL 1 TO SEPTEMBER 30. IF ANY BATS ARE FOUND ROOSTING, ON THE UNDERSIDE OF A BRIDGE, THE UNITED STATES FISH AND WILDLIFE SERVICE, ECOLOGICAL SERVICES DIVISION, THE ODOT OFFICE OF ENVIRONMENTAL SERVICES AND ODOT DISTRICT 3 ENVIRONMENTAL SECTION SHALL BE CONTACTED OR PROVIDED WITH INFORMATION.

ITEM 201 - CLEARING AND GRUBBING:

ALL TREES, BRUSH AND STUMPS SHALL BE REMOVED WITHIN THE CONSTRUCTION LIMITS AS SHOWN IN THE CONSTRUCTION PLANS OR AS SHOWN IN THE TABLE BELOW. THIS WORK SHALL BE COMPLETED UNDER THE LUMP SUM BID FOR ITEM 201, CLEARING AND GRUBBING. TREES WILL BE REMOVED BY OTHERS, EXCEPT THOSE OTHERWISE DESIGNATED BY THE CHIEF ENGINEER SHALL NOT BE REMOVED.

UTILITIES

LISTED BELOW ARE ALL UTILITIES LOCATED WITHIN THE PROJECT CONSTRUCTION LIMITS TOGETHER WITH THEIR RESPECTIVE OWNERS.

OHIO TURNPIKE AND INFRASTRUCTURE COMMISSION 682 PROSPECT STREET BEREA, OH 44017 MAIN OFFICE: (440) 234-2081 WESTERN TRADES SUPERVISOR, MP 0 - MP 126.4 MOBILE: (440) 821-3359 EASTERN TRADES SUPERVISOR, MP 126.4 - MP 241.26 MOBILE: (440) 821-3368

TOLEDO EDISON 6099 ANGOLA RD. HOLLAND, OH 43528 RANDALL SWOPE: (419) 249-5218 RRSWOPE@FIRSTENERGYCORP.COM

CENTURY LINK (LCI FIBER OPTIC CABLE) DOUG HOLLOWAY; OFFICE: (216) 426-6010 MOBILE: (216) 906-6284 DOUG.HOLLOWAY@CENTURYLINK.COM

THE LOCATION OF THE UNDERGROUND UTILITIES SHOWN ON THE PLANS ARE AS OBTAINED FROM THE OWNERS AS REQUIRED BY SECTION 153.64 O.R.C.

AT LEAST TWO WORKING DAYS PRIOR TO COMMENCING CONSTRUCTION OPERATIONS, THE CONTRACTOR SHALL CONTACT THE OHIO UTILITIES PROTECTION SERVICE AND THE OWNERS OF ANY UNDERGROUND UTILITY FACILITY IN THE AREA FOR APPROPRIATE MARKING. THE CONTRACTOR SHALL BE AWARE THAT WITHIN THE PROJECT LIMITS, CENTURYLINK AND THE OHIO TURNPIKE HAVE FIBER OPTIC CABLES RUNNING ALONG THE NORTH FENCE LINE OF THE TURNPIKE.

CENTURY LINK FIBER OPTIC CABLE (LCI), OTIC FIBER OPTIC CABLE AND/OR MCI FIBER OPTIC CABLE THE CONTRACTOR SHALL HAVE THE FIBER OPTIC CABLE MARKED IN THE FIELD PRIOR TO ANY CONSTRUCTION ACTIVITIES.

EXTREME CARE MUST BE TAKEN BY THE CONTRACTOR TO PRESERVE AND PROTECT THE FIBER OPTIC CABLE DURING EXISTING STRUCTURE REMOVAL, NEW STRUCTURE CONSTRUCTION, WHEN EXCAVATING FOR DRAINAGE OUTLETS, EXCAVATING TO FORM THE PROPOSED OUTSIDE ROADWAY DITCHES, CLEANING OUT EXISTING DITCHES AND STREAMS, PERFORMING SLOPE EROSION REPAIRS, REPLACING THE EXISTING FENCE, ETC. THE GENERAL LOCATION OF THE FIBER OPTIC CABLE IS DEPICTED ON THE PLAN AND PROFILE SHEETS. ANY EXCAVATION ADJACENT TO THE CABLE FOR ANY REASON SHALL NOT BE PERFORMED WITHOUT THE FIBER OPTIC UTILITY COMPANY FIRST LOCATING AND VERIFYING THE DEPTH OF THE CABLE. AFTER THE CABLE HAS BEEN LOCATED BY THE FIBER OPTIC UTILITY COMPANY, THE CONTRACTOR SHALL EXCAVATE TO WITHIN 12" OF THE CABLE DEPTH AS PROVIDED. FIBER OPTIC COPMANY REPRESENTATIVE WILL THEN HAND DIG TO EXPOSE THE CABLE.

THE CONTRACTOR SHALL CONTACT THE FIBER OPTIC UTILITY COMPANY FOR LOCATION AND DEPTH VERIFICATION PRIOR TO ANY EXCAVATION WORK, ESPECIALLY IN NON-ANTICIPATED WORK AREAS. NO ADDITIONAL PAYMENT WILL BE MADE TO THE CONTRACTOR FOR TIME DELAY WAITING FOR DEPTH VERIFICATION FROM FIBER OPTIC UTILITY COMPANIES.

EXISTING / AS-BUILT PLANS

THE EXISTING / AS-BUILT PLANS FROM THE ORIGINAL 1953 CONSTRUCTION, 3RD LANE WIDENING, DECK REPLACEMENT AND OTHER MODIFICATIONS, INCLUDING CROSS-SECTIONS, STANDARD DRAWINGS AND TURNPIKE SPECIFIC STANDARD DRAWINGS MAY BE INSPECTED AT THE OHIO TURNPIKE AND INFRASTRUCTURE COMMISSION ADMINISTRATION OFFICE LOCATED AT 682 PROSPECT STREET, BEREA, OHIO 44017, TELEPHONE (440) 234-2081.

EXISTING UTILITIES TO BE ABANDONED

ALL EXISTING CABLES, CONDUIT OR OTHER EXISTING UTILITIES WHICH ARE NOT A PIPE SHOWN TO BE ABANDONED ON THE PLANS SHALL BE LEFT IN PLACE AND PROPERLY ABANDONED IN ACCORDANCE WITH ALL LOCAL, STATE AND FEDERAL LAWS AND REGULATIONS. PAYMENT FOR THIS SHALL BE INCIDENTAL TO THE PROPOSED ITEM OF WORK.

EXISTING FIBER OPTIC CABLE NOTE

ALL EXISTING FIBER OPTIC CABLES SHALL BE PROTECTED DURING CONSTRUCTION UNLESS THEY ARE MARKED "ABANDONED" OR SPECIFICALLY INDICATED TO BE REMOVED IN THIS WORK. PRIOR TO STARTING THE SITE WORK, THE CONTRACTOR SHALL NOTIFY OHIO TURNPIKE COMMISSION OF THE PROPOSED CONSTRUCTION ACTIVITIES AND COORDINATE THESE ACTIVITIES WITH OHIO TURNPIKE COMMISSION TO INSURE THAT THE EXISTING COMMUNICATION CABLE IS UNDISTURBED BY THE CONTRACTOR'S WORK.

THE FOLLOWING ESTIMATED QUANTITIES FOR ABANDONED FIBER OPTIC REMOVAL HAVE BEEN INCLUDED IN THE GENERAL SUMMARY:

ITEM 202 - PIPE REMOVED, 4" AND UNDER, AS PER PLAN 1,480 FT

ITEM 202 - PUMP STATION DEMOLISHED

THE CONTRACTOR SHALL DEMOLISH AND DISPOSE OF ALL DEBRIS RESULTING FROM THE DEMOLITION OF THE EXISTING PUMP STATION AND ALL APPURTENANCES LOCATED WITHIN THE EXISTING CONCRETE STRUCTURE AS SHOWN ON SHEET 14 OF 59 IN ACCORDANCE WITH SP105 AND ALL FEDERAL, STATE AND LOCAL LAWS. THIS WORK SHALL INCLUDE BUT IS NOT LIMITED TO THE REMOVAL OF THE 14.3' X 6' DIAMETER CONCRETE STRUCTURE TO A MINIMUM OF 2' BELOW PROPOSED DITCH AND BREAK UP



BOTTOM OF STRUCTURE, ALL ASSOCIATED ELECTRICAL AND SEWAGE. ALL SANITARY LINES SHALL BE PLUGGED. THE ENTIRE EXCAVATION SHALL BE BACKFILLED WITH CLEAN FILL IN ACCORDANCE WITH ODOT 203. THIS ITEM WILL INCLUDE ALL NECESSARY LABOR, MATERIAL AND EQUIPMENT TO REMOVE THE PUMP STATION AND ALL APPURTENANCES AND BACKFILL. THIS ITEM SHALL BE PAID ON A LUMP SUM BASIS.

ITEM 202 - REMOVAL MISCELLANEOUS

REMOVAL OF ALL ITEMS NOT INCLUDED ON GENERAL SUMMARY SHEET AND NOTED ON DEMOLITION PLANS FOR REMOVAL SHALL BE INCLUDED IN THIS LUMP SUM ITEM.

ITEM 203 - ASPHALT PAVEMENT REMOVED

THE TOTAL AREA OF ASPHALT TO BE REMOVED IS 46,030 SY (21,580 SY ON WESTBOUND (NORTH SIDE) AND 24,450 SY ON EASTBOUND (SOUTH SIDE). AREA OF EXISTING PAVEMENT SHOWN AS EXCAVATION IN CROSS SECTIONS IS INCLUDED IN ITEM 203 - EXCAVATION IN CROSS SECTION EARTHWORK QUANTITIES. THE FOLLOWING ESTIMATED QUANTITIES FOR ADDITIONAL ASPHALT PAVEMENT EXCAVATION OUTSIDE OF CROSS SECTIONS IS NOTED BELOW:

EASTBOUND (SOUTH) SITE: 5,675 CU. YD. (AREA = 19,187 SY) WESTBOUND (NORTH) SITE: 2,488 CU. YD. (AREA = 10,116 SY)

ITEM 203 - EXCAVATION 8,163 CU. YD.

EMBANKMENT REQUIRED TO REPLACE PAVEMENT EXCAVATED ABOVE:

ITEM 203 - EMBANKMENT 8,163 CU. YD.

CONTRACTOR COORDINATION

EACH PRIME CONTRACTOR FOR CONTRACTS 39-20-02 AND 58-20-01 AND THEIR SUBCONTRACTORS SHALL PERFORM THEIR WORK CONCURRENTLY AND IN COORDINATION WITH OTHER CONSTRUCTION ACTIVITIES PERFORMED ON THIS PROJECT WITH THE INTENT OF DELIVERING A COMPLETE AND OPERATIONAL FACILITY AND ROADWAY BY THE CONTRACT COMPLETION DATES. PRIME CONTRACTORS SHALL COORDINATE THEIR ACTIVITIES IN ACCORDANCE WITH THE 39-20-02B "CONTRACT COORDINATION PLANS" AS SHOWN ON SHEETS 9-13 OF 59 AND THE APPROVED PROJECT SCHEDULES.

FARM DRAINS

ALL FARM DRAINS, WHICH ARE ENCOUNTERED DURING CONSTRUCTION, SHALL BE PROVIDED WITH UNOBSTRUCTED OUTLETS. EXISTING COLLECTORS WHICH ARE LOCATED BELOW THE ROADWAY DITCH ELEVATIONS, AND WHICH CROSS THE ROADWAY, SHALL BE REPLACED WITHIN THE (RIGHT OF WAY) (CONSTRUCTION) LIMITS BY ITEM SP 611 CONDUIT, TYPE B, ONE COMMERCIAL SIZE LARGER THAN THE EXISTING CONDUIT. EXISTING COLLECTORS AND ISOLATED FARM DRAINS, WHICH ARE ENCOUNTERED ABOVE THE ELEVATION OF ROADWAY DITCHES, SHALL BE OUTLETTED INTO THE ROADWAY DITCH BY SP 611 TYPE F CONDUIT. THE OPTIMUM OUTLET ELEVATION SHALL BE ONE FOOT ABOVE THE FLOWLINE ELEVATION OF THE DITCH. LATERAL FIELD TILES WHICH CROSS THE ROADWAY SHALL BE INTERCEPTED BY SP 611, TYPE E CONDUIT, AND CARRIED IN A LONGITUDINAL DIRECTION TO AN ADEQUATE OUTLET OR ROADWAY CROSSING. THE LOCATION, TYPE, SIZE AND GRADE OF REPLACEMENTS SHALL BE DETERMINED BY THE ENGINEER AND PAYMENT SHALL BE MADE ON FINAL MEASUREMENTS. EROSION CONTROL PADS AND ANIMAL GUARDS SHALL BE PROVIDED AT THE OUTLET END OF ALL FARM DRAINS AS PER ODOT STANDARD CONSTRUCTION DRAWING DM-1.1, EXCEPT WHEN THEY OUTLET INTO A DRAINAGE STRUCTURE. PAYMENT FOR THE EROSION CONTROL PADS AND ANIMAL GUARDS AND ANY NECESSARY BENDS OR BRANCHES SHALL BE INCLUDED FOR PAYMENT IN THE PERTINENT CONDUIT ITEMS.

THE FOLLOWING ESTIMATED QUANTITIES HAVE BEEN INCLUDED IN THE GENERAL SUMMARY FOR THE WORK NOTED ABOVE:

SP 611 - 6" CONDUIT, TYPE B 200 FT SP 611 - 6" CONDUIT, TYPE E 200 FT SP 611 - 6" CONDUIT, TYPE F 200 FT ITEM 601 - ROCK CHANNEL PROTECTION TYPE C WITH FILTER 10 CU. YD



nnnnnGN001.dwg: 1/14/20 - 4:19pm

Project information sidebar including: PROJECT 39-20-02B, DATE: 12/20/2019, TP 49, GENERAL NOTES, LUCAS COUNTY, OHIO TURNPIKE AND INFRASTRUCTURE COMMISSION, JACOBS logo, and revision table.


CHECKING PRINT

CHECKED: _____ DATE: _____ CORRECTED: _____ DATE: _____
 BACKCHECKED: _____ DATE: _____ APPROVED: _____ DATE: _____


nmmnGM003.dwg; 1/15/20 - 8:50am

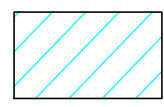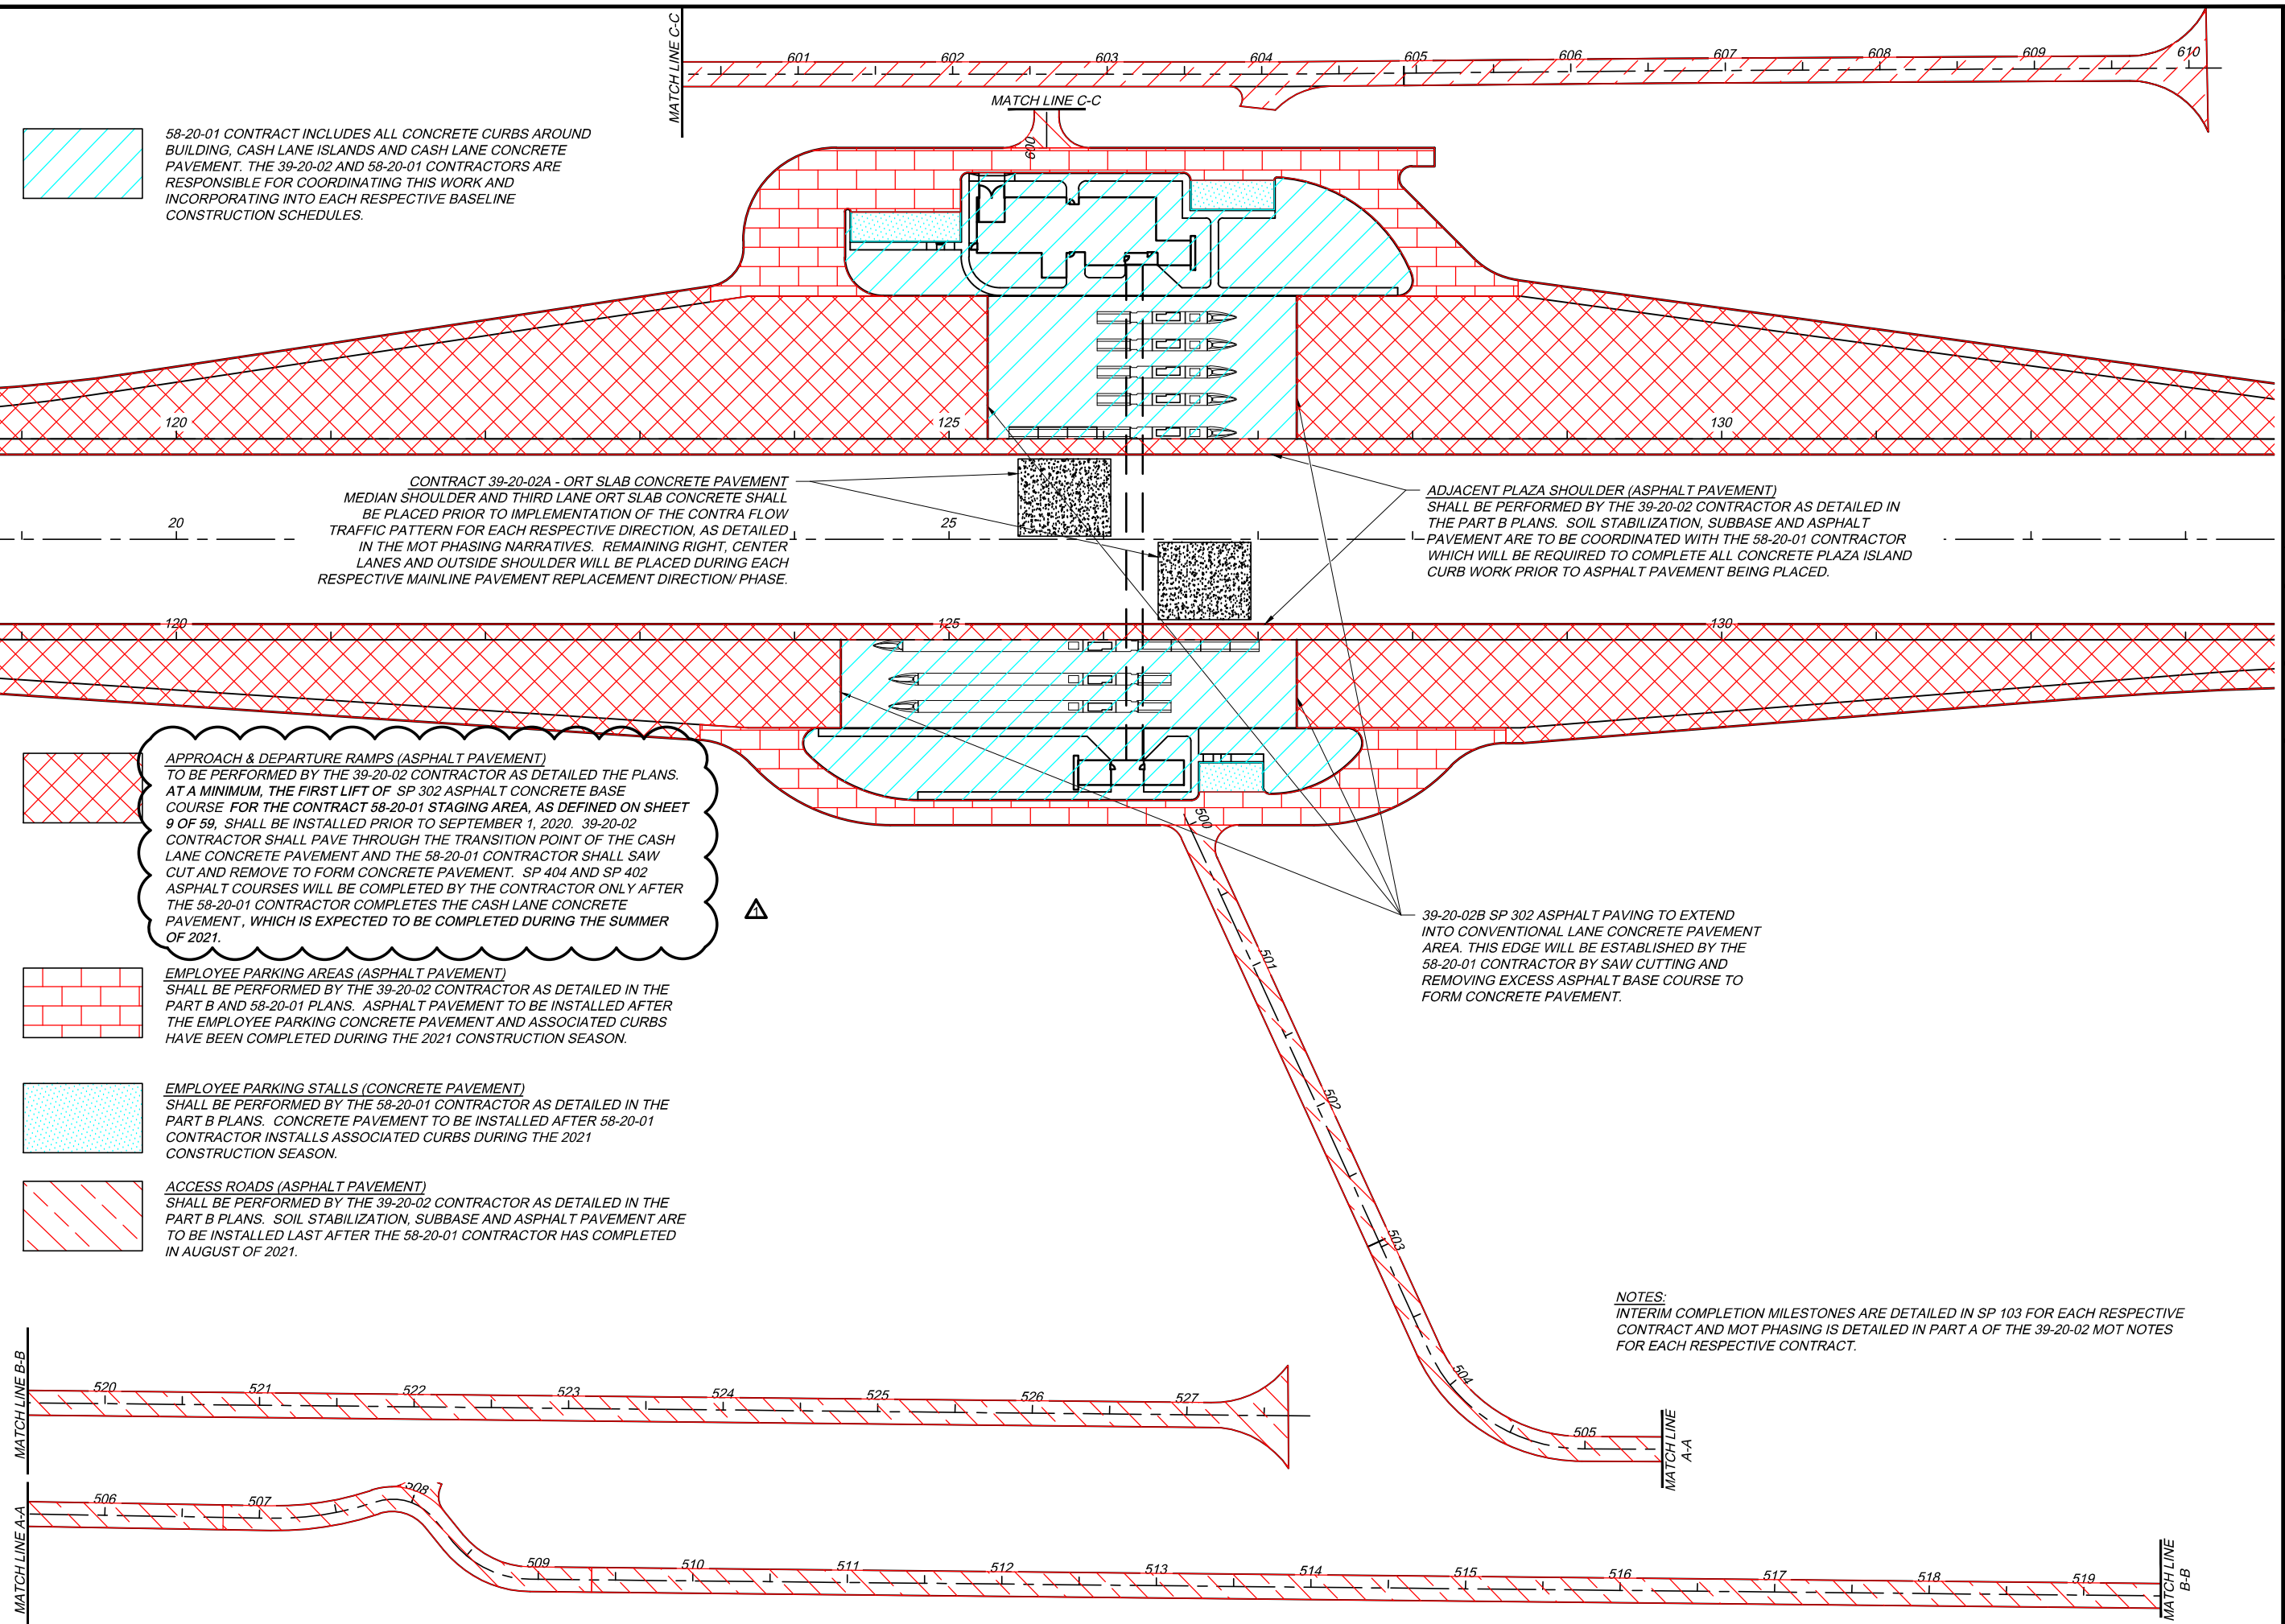


58-20-01 CONTRACT INCLUDES ALL CONCRETE CURBS AROUND BUILDING, CASH LANE ISLANDS AND CASH LANE CONCRETE PAVEMENT. THE 39-20-02 AND 58-20-01 CONTRACTORS ARE RESPONSIBLE FOR COORDINATING THIS WORK AND INCORPORATING INTO EACH RESPECTIVE BASELINE CONSTRUCTION SCHEDULES.

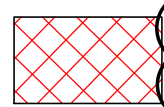


APPROACH & DEPARTURE RAMPS (ASPHALT PAVEMENT) TO BE PERFORMED BY THE 39-20-02 CONTRACTOR AS DETAILED THE PLANS. AT A MINIMUM, THE FIRST LIFT OF SP 302 ASPHALT CONCRETE BASE COURSE FOR THE CONTRACT 58-20-01 STAGING AREA, AS DEFINED ON SHEET 9 OF 59, SHALL BE INSTALLED PRIOR TO SEPTEMBER 1, 2020. 39-20-02 CONTRACTOR SHALL PAVE THROUGH THE TRANSITION POINT OF THE CASH LANE CONCRETE PAVEMENT AND THE 58-20-01 CONTRACTOR SHALL SAW CUT AND REMOVE TO FORM CONCRETE PAVEMENT. SP 404 AND SP 402 ASPHALT COURSES WILL BE COMPLETED BY THE CONTRACTOR ONLY AFTER THE 58-20-01 CONTRACTOR COMPLETES THE CASH LANE CONCRETE PAVEMENT, WHICH IS EXPECTED TO BE COMPLETED DURING THE SUMMER OF 2021.

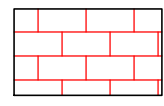

EMPLOYEE PARKING AREAS (ASPHALT PAVEMENT) SHALL BE PERFORMED BY THE 39-20-02 CONTRACTOR AS DETAILED IN THE PART B AND 58-20-01 PLANS. ASPHALT PAVEMENT TO BE INSTALLED AFTER THE EMPLOYEE PARKING CONCRETE PAVEMENT AND ASSOCIATED CURBS HAVE BEEN COMPLETED DURING THE 2021 CONSTRUCTION SEASON.

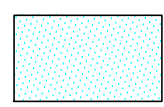

EMPLOYEE PARKING STALLS (CONCRETE PAVEMENT) SHALL BE PERFORMED BY THE 58-20-01 CONTRACTOR AS DETAILED IN THE PART B PLANS. CONCRETE PAVEMENT TO BE INSTALLED AFTER 58-20-01 CONTRACTOR INSTALLS ASSOCIATED CURBS DURING THE 2021 CONSTRUCTION SEASON.

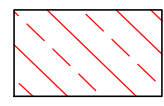

ACCESS ROADS (ASPHALT PAVEMENT) SHALL BE PERFORMED BY THE 39-20-02 CONTRACTOR AS DETAILED IN THE PART B PLANS. SOIL STABILIZATION, SUBBASE AND ASPHALT PAVEMENT ARE TO BE INSTALLED LAST AFTER THE 58-20-01 CONTRACTOR HAS COMPLETED IN AUGUST OF 2021.

CONTRACT 39-20-02A - ORT SLAB CONCRETE PAVEMENT MEDIAN SHOULDER AND THIRD LANE ORT SLAB CONCRETE SHALL BE PLACED PRIOR TO IMPLEMENTATION OF THE CONTRA FLOW TRAFFIC PATTERN FOR EACH RESPECTIVE DIRECTION, AS DETAILED IN THE MOT PHASING NARRATIVES. REMAINING RIGHT, CENTER LANES AND OUTSIDE SHOULDER WILL BE PLACED DURING EACH RESPECTIVE MAINLINE PAVEMENT REPLACEMENT DIRECTION/PHASE.

ADJACENT PLAZA SHOULDER (ASPHALT PAVEMENT) SHALL BE PERFORMED BY THE 39-20-02 CONTRACTOR AS DETAILED IN THE PART B PLANS. SOIL STABILIZATION, SUBBASE AND ASPHALT PAVEMENT ARE TO BE COORDINATED WITH THE 58-20-01 CONTRACTOR WHICH WILL BE REQUIRED TO COMPLETE ALL CONCRETE PLAZA ISLAND CURB WORK PRIOR TO ASPHALT PAVEMENT BEING PLACED.

39-20-02B SP 302 ASPHALT PAVING TO EXTEND INTO CONVENTIONAL LANE CONCRETE PAVEMENT AREA. THIS EDGE WILL BE ESTABLISHED BY THE 58-20-01 CONTRACTOR BY SAW CUTTING AND REMOVING EXCESS ASPHALT BASE COURSE TO FORM CONCRETE PAVEMENT.


NOTES:
 INTERIM COMPLETION MILESTONES ARE DETAILED IN SP 103 FOR EACH RESPECTIVE CONTRACT AND MOT PHASING IS DETAILED IN PART A OF THE 39-20-02 MOT NOTES FOR EACH RESPECTIVE CONTRACT.

PROJECT 39-20-02B		CONTRACT COORDINATION PLANS		DESIGNED BY AMS		CHECKED BY CSM		REVISIONS		BY DATE		DESIGN AGENCY	
DATE: 12/20/2019		SITE PAVEMENT PLAN		DRAWN BY AMS		IN CHARGE CSM		ADDENDUM NO. 2		AMS 11-15-20		JACOBS	
TP-49		LUCAS COUNTY		AMS		CSM		NO.		AMS		101 ST. JAMES SQUARE, 8 FLOOR BOSTON, MASS 02116 OFFICE 617.452.8222	
5/5		13/59		5/5		13/59						OHIO TURNPIKE AND INFRASTRUCTURE COMMISSION	

CHECKING PRINT

CHECKED: DATE: CORRECTED: DATE: APPROVED: DATE: BACKCHECKED: DATE:

nnnnnRE01.dwg: 1/15/20 - 12:04pm

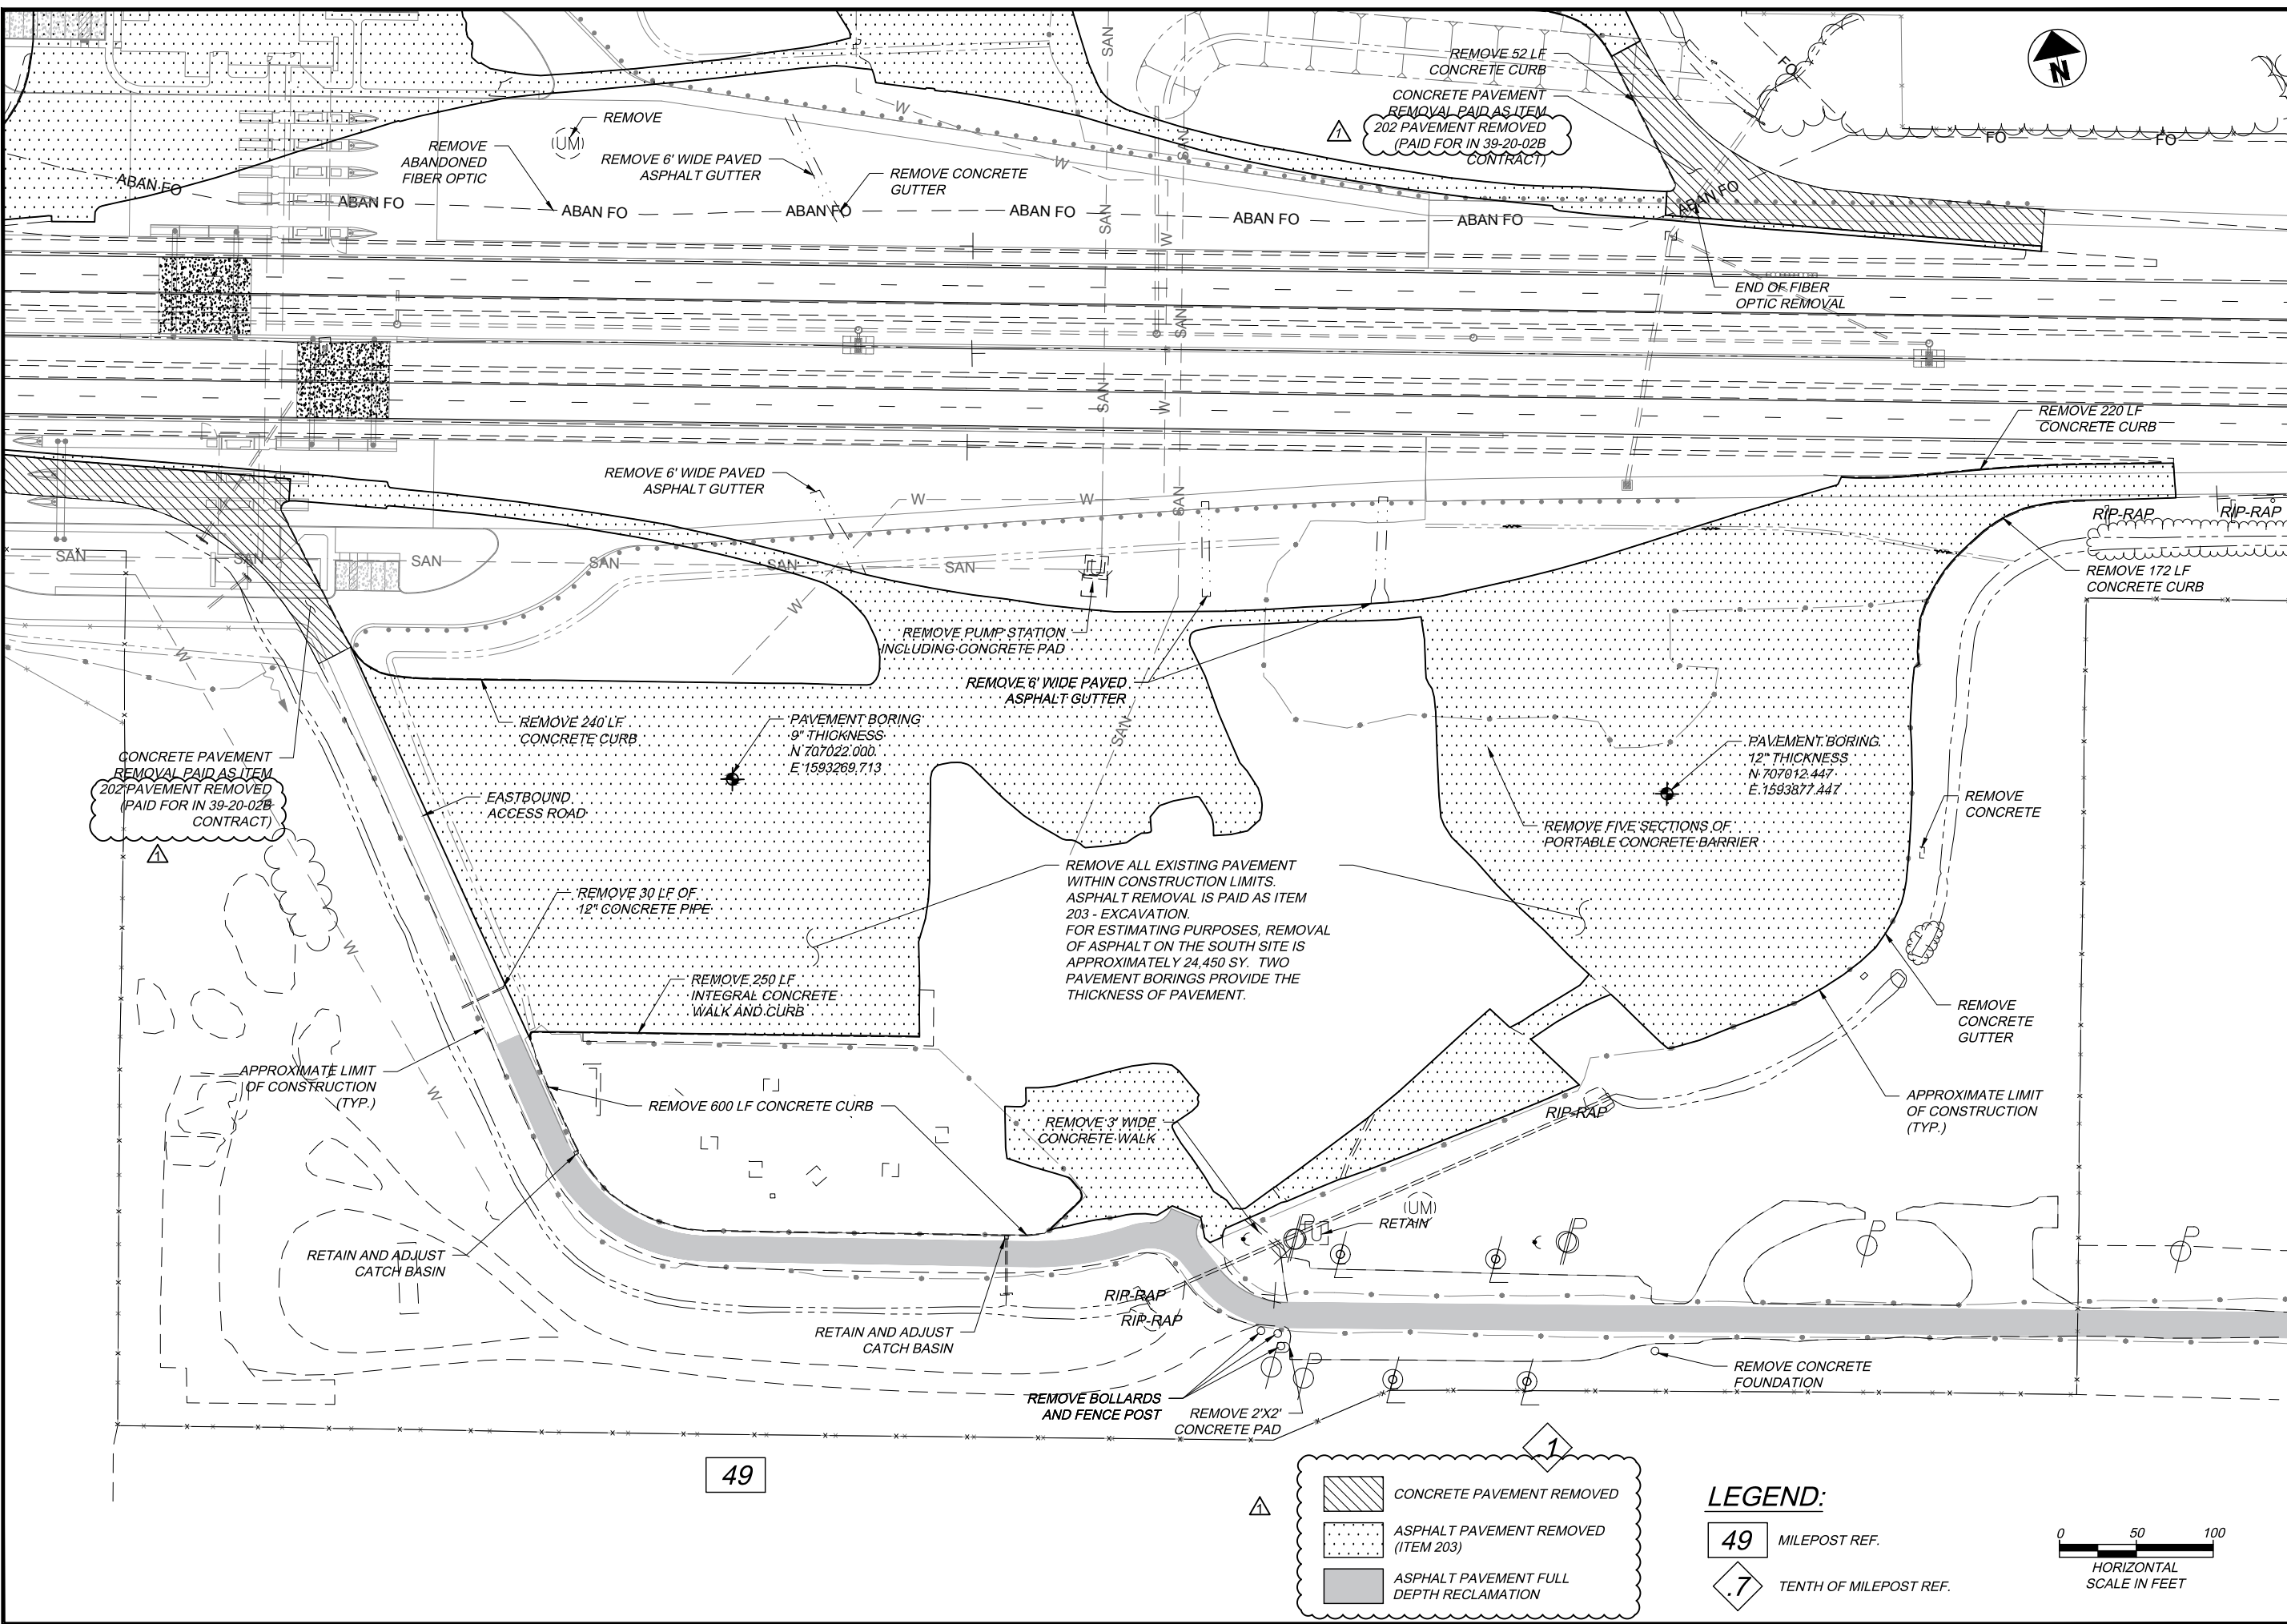


LEGEND:

- CONCRETE PAVEMENT REMOVED
- ASPHALT PAVEMENT REMOVED (ITEM 203)
- ASPHALT PAVEMENT FULL DEPTH RECLAMATION

49 MILEPOST REF.


.7 TENTH OF MILEPOST REF.

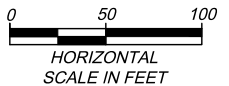

DESIGN AGENCY	JACOBS
BY DATE	AMS 11/15/20
REVISIONS	ADDENDUM NO. 2
CHECKED	AMS CSM
DESIGNED	AMS DRAWN
NO.	1
PROJECT	39-20-02B
DATE	12/20/2019
TP	49
DEMOLITION PLAN	SOUTH SITE
LUCAS COUNTY	
1	2
14	59

CHECKING PRINT


CHECKED: _____ DATE: _____
 BACKCHECKED: _____ DATE: _____
 CORRECTED: _____ DATE: _____
 APPROVED: _____ DATE: _____

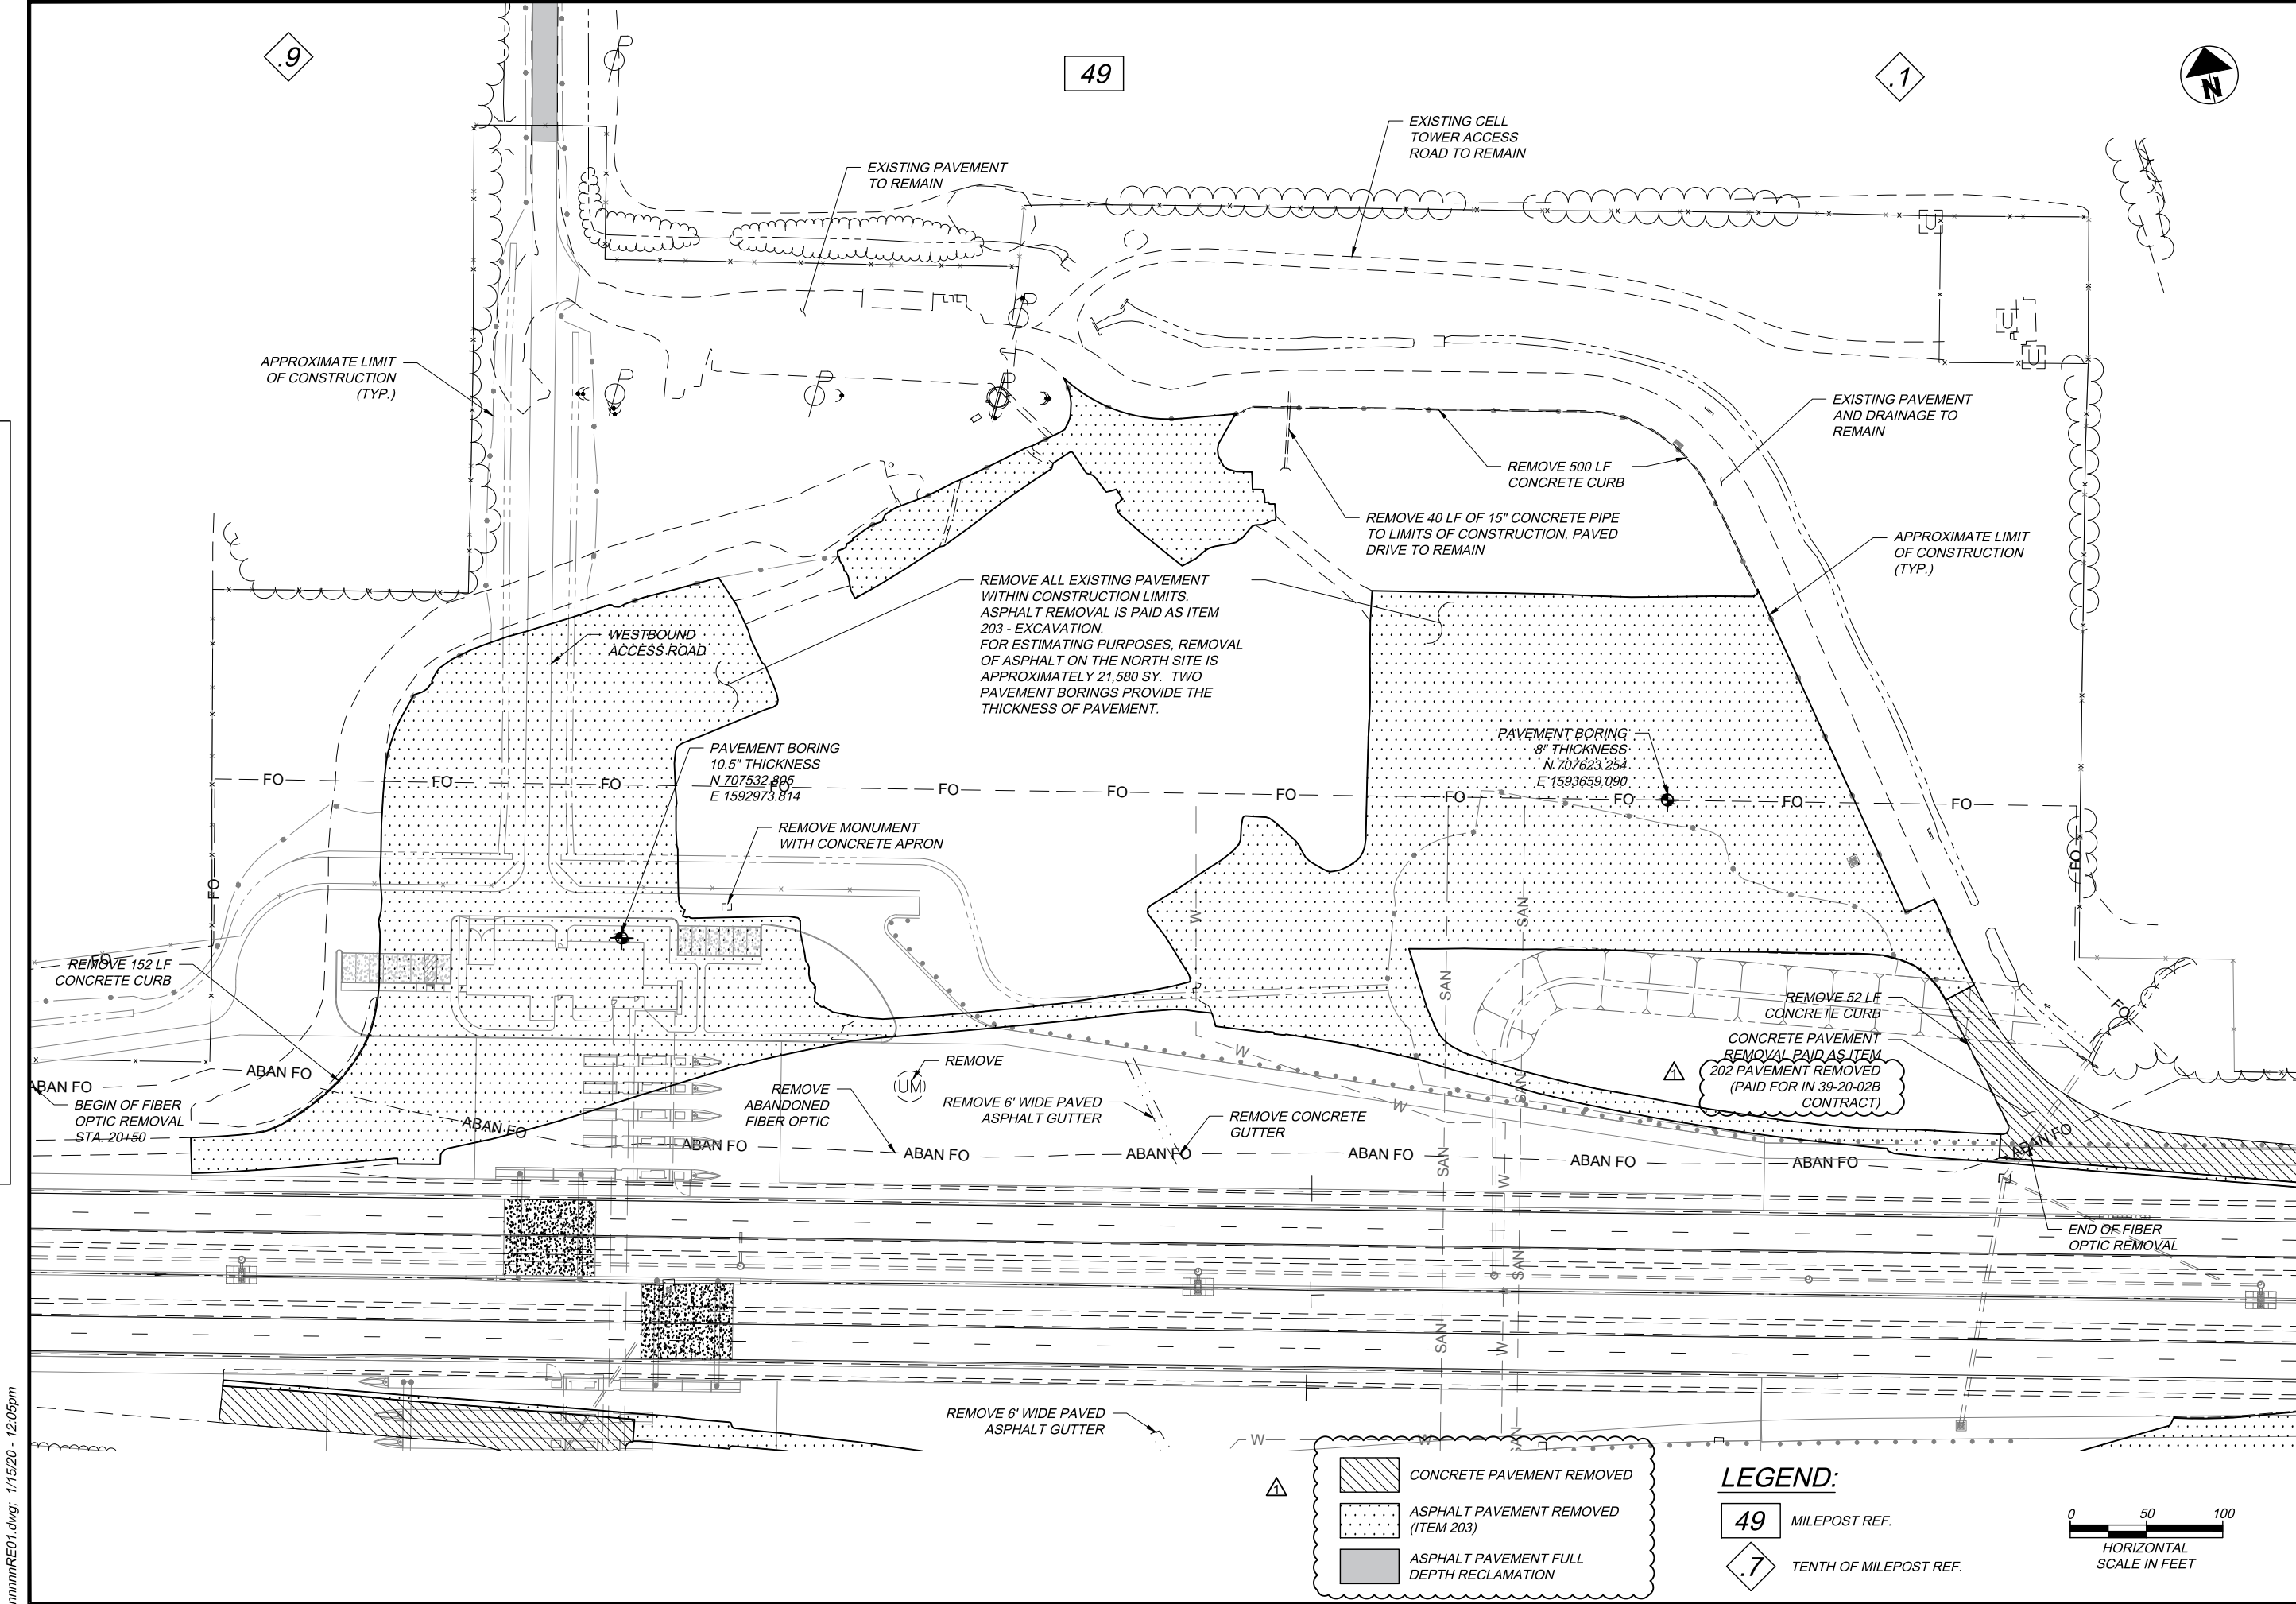

LEGEND:

- CONCRETE PAVEMENT REMOVED
- ASPHALT PAVEMENT REMOVED (ITEM 203)
- ASPHALT PAVEMENT FULL DEPTH RECLAMATION

49 MILEPOST REF.
 TENTH OF MILEPOST REF.

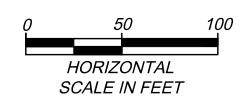

PROJECT 39-20-02B DATE: 12/20/2019 TP 49

NO.	REVISIONS	BY	DATE
1	ADDENDUM NO. 2	AMS	11/15/20

DESIGNED: AMS DRAWN: AMS CHECKED: CSM IN CHARGE: CSM

DEMOLITION PLAN NORTH SITE LUCAS COUNTY

mmmmRE01.dwg; 1/15/20 - 12:05pm

CHECKING PRINT

CHECKED: _____ DATE: _____ CORRECTED: _____ DATE: _____
 BACKCHECKED: _____ DATE: _____ APPROVED: _____ DATE: _____

nmnmSM001.dwg: 1/16/20 - 1:53pm

SHEET NUMBER							ITEM	GRAND TOTAL	UNIT	DESCRIPTION	SEE SHEET NO.
7	8	13	14	17	18	27					
ROADWAY											
1			1				201	1	LUMP	CLEARING AND GRUBBING	
1480							202	1	EACH	HEADWALL REMOVED	
							202	1480	FOOT	PIPE REMOVED, 4" AND UNDER, AS PER PLAN	
		30	40				202	70	FOOT	PIPE REMOVED, 24" AND UNDER	
1							202	1	LUMP	PUMP STATION DEMOLISHED	
		1232	704				202	1936	FOOT	CONCRETE CURB REMOVED	
		1145	1031				202	2176	SY	PAVEMENT REMOVED	
		60	50				202	110	SY	REMOVAL MISC. CONCRETE CHANNEL REMOVED	
							202	1	LUMP	REMOVAL MISC.	
8163					32634		203	40797	CU. YD.	EXCAVATION	7
8163					15956		203	24119	CU. YD.	EMBANKMENT	
							606	1313.25	FOOT	GUARDRAIL, TYPE MGS, WITH LONG STEEL POSTS	
					2		606	2	EACH	ANCHOR ASSEMBLY, MGS TYPE T	
					491		607	491	FOOT	FENCE, TYPE 47, AS PER PLAN	
					16		SP 626	16	EACH	BARRIER REFLECTOR, TYPE A	
					38		SP 627	38	CU. YD.	STONE SHOULDER PROTECTION (T=3")	
EROSION CONTROL											
	4663						651	4663	CU. YD.	TOPSOIL STOCKPILED	
	4256						652	4256	CU. YD.	PLACING STOCKPILED TOPSOIL	
							659	73433	SQ. YD.	SEEDING AND MULCHING	
							659	3672	SQ. YD.	REPAIR SEEDING AND MULCHING	
							659	5000	SQ. YD.	INTER SEEDING	
							659	6.6	TON	COMMERCIAL FERTILIZER	
							659	15.2	ACRE	LIME	
							659	398	M. GAL.	WATER	
DRAINAGE											
10							601	10	CU. YD.	ROCK CHANNEL PROTECTION TYPE C WITH FILTER	
					3127		SP 605	3127	FOOT	6" BASE PIPE UNDERDRAIN WITH FABRIC WRAP (18")	
					5804		SP 605	5804	FOOT	6" SHALLOW PIPE UNDERDRAIN WITH FABRIC WRAP (30")	
					6		SP 611	6	EACH	PRECAST REINFORCED CONCRETE OUTLET, AS PER PLAN	8
					32		SP 611	32	FOOT	15" CONDUIT, TYPE B, 706.02	
					145		SP 611	145	FOOT	12" CONDUIT, TYPE C, 707.33	
200							SP 611	200	FOOT	6" CONDUIT, TYPE B	
200							SP 611	200	FOOT	6" CONDUIT, TYPE E	
200							SP 611	200	FOOT	6" CONDUIT, TYPE F	
						2	611	2	EACH	MANHOLE, CATCH BASIN OR INLET ADJUST TO GRADE	
					1		SPECIAL	1	EACH	12" PRECAST CONCRETE END SECTION	7,8
					2		SPECIAL	2	EACH	15" PRECAST CONCRETE END SECTION	7,8
PAVEMENT											
					5981		209	5981	FOOT	LINEAR GRADING	
					787		SP 302	787	CU. YD.	ASPHALT CONCRETE BASE, PG 44-22	
					5100		SP 302	5100	CU. YD.	ASPHALT CONCRETE BASE, PG 64-22	
					1955		SP 302	1955	CU. YD.	ASPHALT CONCRETE BASE, PG 64-22 (SHOULDER)	
					2550		SP 304	2550	CU. YD.	AGGREGATE BASE	
					2674		SP 304	2674	CU. YD.	AGGREGATE BASE (SHOULDER)	
					744		SP 402	744	CU. YD.	ASPHALT CONCRETE INTERMEDIATE COURSE OR RECYCLED ASPHALT CONCRETE IN INTERMEDIATE COURSE, PG 76-22 (FR)	
					423		SP 402	423	CU. YD.	ASPHALT CONCRETE INTERMEDIATE COURSE OR RECYCLED ASPHALT CONCRETE IN INTERMEDIATE COURSE, PG 64-22	
					637		SP 404	637	CU. YD.	ASPHALT CONCRETE SURFACE COURSE, USING CRUSHED SLAG, PG 76-22 (FR)	
					658		SP 404	658	CU. YD.	ASPHALT CONCRETE SURFACE COURSE, USING CRUSHED STONE, PG 64-22	
					5026		SP 404A	5026	FOOT	JOINT SEALER	
					4813		407	4813	GAL.	NON-TRACKING TACK COAT	
TRAFFIC CONTROL											
					1.12		SP 642	1.12	MILE	6" EDGE LINE, TYPE 1	

PROJECT 39-20-02B	DATE: 12/20/2019	TP-49	GENERAL SUMMARY
1 / 1	16	59	LUCAS COUNTY
DESIGN AGENCY		BY DATE	
JACOBS		CSM 11/15/20	
DESIGNED		CHECKED	
AMS		JRB	
DRAWN		IN CHARGE	
AMS		CSM	
REVISIONS		NO.	
ADDENDUM NO. 2		1	

OHIO TURNPIKE AND INFRASTRUCTURE COMMISSION


CHECKING PRINT

CHECKED: _____ DATE: _____ CORRECTED: _____ DATE: _____
 BACKCHECKED: _____ DATE: _____ APPROVED: _____ DATE: _____

nmmnSM001.dwg; 1/14/20 - 5:00pm

REFERENCE	SHEET	STATION TO STATION		SIDE	OFFSET	LENGTH	ROADWAY				
		FROM	TO				606	606	607	SP 626	SP 627
							GUARDRAIL, TYPE MGS, WITH LONG POSTS	ANCHOR ASSEMBLY, MGS TYPE T	FENCE, TYPE 47, AS PER PLAN	BARRIER REFLECTOR, TYPE A	STONE SHOULDER PROTECTION (T=3')
		FEET	FEET	FOOT	EACH	FOOT	EACH	CU. YD.			
GUARDRAIL											
G-1	20	27+93.5	33+70	EB	VARIES	725	700	1	8	20	
G-2	22	26+74.3	33+70	WB	VARIES	631.25	613.25	1	8	18	
TYPE 47 FENCE											
F-1	19-20	24+00	26+55.5	EB	VARIES	270			270		
F-2	21-22	23+50	25+50	WB	VARIES	221			221		
F-3	22	25+75	28+14	WB	VARIES	246			246		
TOTALS CARRIED TO GENERAL SUMMARY							1313.25	2	491	16	38

REFERENCE	SHEET	STATION TO STATION		SIDE	OFFSET	DRAINAGE			
		FROM	TO OR AT			SP 611		SPECIAL	SPECIAL
						12" CONDUIT, TYPE C, 707.33	15" CONDUIT, TYPE B, 706.02	12" PRECAST CONCRETE END SECTION	15" PRECAST CONCRETE END SECTION
		FEET	FOOT	FOOT	EACH	EACH			
DR-1	20	25+85	25+52.7	RT	191.5	145		1	
DR-2	22		600+23	LT & RT	12		32		2
TOTALS CARRIED TO GENERAL SUMMARY						145	32	1	2

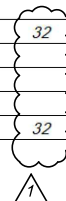

REFERENCE	SHEET	STATION TO STATION		SIDE	NUMBER OF PARALLEL UNDERDRAIN RUNS	LENGTH	SP 605			INFO. ONLY	SP 605
		FROM	TO				6" SHALLOW PIPE UNDERDRAIN WITH FABRIC WRAP (30')	6" BASE PIPE UNDERDRAIN WITH FABRIC WRAP (18')	CROSSES, BENDS, TEES & ELBOWS		
							FEET	FOOT			
UD-1	19	18+70	23+35	EB-LT	N/A	540	540		2	1	
UD-2	19	18+70	23+35	EB-RT	N/A	466	466				
UD-3	19	18+70	23+35	EB-RT	N/A	466		466			
UD-4	20	23+35	28+50	EB-LT	N/A	600	600		2	1	
UD-5	20	23+35	28+50	EB-RT	N/A	545		545			
UD-6	20	23+35	28+50	EB-RT	N/A	82	82				
UD-7	20	28+50	33+70	EB-LT	N/A	572	572		2	1	
UD-8	20	28+50	33+70	EB-RT	N/A	522	522				
UD-9	20	28+50	33+70	EB-RT	N/A	522		522			
UD-10	21	18+70	22+50	WB-RT	N/A	474	474		2	1	
UD-11	21	18+70	22+50	WB-LT	N/A	384	384				
UD-12	21	18+70	22+50	WB-LT	N/A	384		384			
UD-13	22	22+50	29+00	WB-RT	N/A	765	765		2	1	
UD-14	22	22+50	29+00	WB-LT	N/A	276	276				
UD-15	22	22+50	29+00	WB-LT	N/A	736		736			
UD-16	22	28+00	29+00	WB-LT	N/A	100	100				
UD-17	22	29+00	33+70	WB-RT	N/A	549	549		2	1	
UD-18	22	29+00	33+70	WB-LT	N/A	474	474				
UD-19	22	29+00	33+70	WB-LT	N/A	474		474			
TOTALS CARRIED TO GENERAL SUMMARY							5804	3127	12	6	

TRAFFIC CONTROL						
STATION TO STATION	SIDE	LENGTH	SP 642		PERMANENT TRAFFIC CONTROL	GENERAL QUANTITIES
			6" EDGE LINE, TYPE 1 (WHITE)	6" EDGE LINE, TYPE 1 (YELLOW)		
		FEET	MILE	MILE		
18+70	TO	33+70	EB	1500	0.28	
18+70	TO	33+70	EB	1500		0.28
18+70	TO	33+70	WB	1500	0.28	
18+70	TO	33+70	WB	1500		0.28
TOTALS CARRIED TO GENERAL SUMMARY				0.56	0.56	
COMBINED TOTALS CARRIED TO GENERAL SUMMARY				1.12		

PROJECT 39-20-02B	SUBSUMMARY	DESIGNED	CHECKED	NO.	BY DATE	DESIGN AGENCY
DATE: 12/20/2019	ESTIMATED QUANTITIES	AMS	JRB	1	CSM 1/15/20	JACOBS
TP-49	LUCAS COUNTY	DRAWN	IN CHARGE	ADDENDUM NO. 2	-	10101 JAMES ARBARE, P. E. FLOOR BOSTON, MASSACHUSETTS OFFICE 617.262.8222
17	59	AMS	CSM	-	-	OHIO TURNPIKE
OHIO TURNPIKE AND INFRASTRUCTURE COMMISSION						

CHECKING PRINT

CHECKED: _____ DATE: _____ CORRECTED: _____ DATE: _____
 BACKCHECKED: _____ DATE: _____ APPROVED: _____ DATE: _____

nmmsM0001.dwg: 1/16/20 - 1:53pm

STATION TO STATION				SIDE	LENGTH L	AVERAGE WIDTH W	SURFACE AREA, A A=L x W (NOT USED IN CALCS)	CAD GENERATED SURFACE AREA	209	SP 302	SP 302	SP 302	SP 304	SP 304	SP 402	SP 402	SP 404	SP 404	SP 407	SP 407	SP 404A
					FEET	FEET	SQ. FT.	SQ. FT.	FOOT	CU. YD.	CU. YD.	CU. YD.	CU. YD.	CU. YD.	CU. YD.	CU. YD.	CU. YD.	CU. YD.	GAL.	GAL.	FOOT
FULL DEPTH PAVEMENT																					
18+70	TO	24+32	EB	562	-	-	24370				903		451		132		113		162	406	1124
27+23	TO	33+70	EB	647	-	-	27561				1021		510		149		128		184	459	1294
18+70	TO	25+27	WB	657	-	-	42482				1573		787		229		197		283	708	1314
27+23	TO	33+70	WB	647	-	-	43280				1603		801		234		200		289	721	1294
SHOULDERS/PARKING AREAS																					
18+70	TO	33+70	EB	-	-	-	36155				902		1234				195		167	241	301
18+70	TO	33+70	WB	-	-	-	42220				1053		1440				228		195	281	352
ACCESS ROADS																					
500+00	TO	502+96	EB	296	-	-	4877			60									23	33	
502+96	TO	527+65.59	EB	2469.59	-	-	40251	4939	497										186	268	
600+00	TO	604+92	WB	492	-	-	8528			105									39	57	
604+92	TO	610+11.73	WB	520.8	-	-	10089	1042	125										47	67	
TOTALS CARRIED TO GENERAL SUMMARY									5981	787	5100	1955	2550	2674	744	423	637	658	1865	2948	5026




EARTHWORK				
SHEET	DESCRIPTION	203	203	659
		EXCAVATION	EMBANKMENT	SEEDING AND MULCHING
		CU. YD.	CU. YD.	SQ. YD.
27	GRADING PLAN - SOUTH SITE	4508	4787	33124
28	GRADING PLAN - NORTH SITE	2878	3165	24045
30	EASTBOUND TOLL PLAZA SECTIONS	561	1003	801
31	EASTBOUND TOLL PLAZA SECTIONS	926	963	894
32	EASTBOUND TOLL PLAZA SECTIONS	984	475	560
33	EASTBOUND TOLL PLAZA SECTIONS	1068	1432	740
34	EASTBOUND TOLL PLAZA SECTIONS	782	943	1086
35	EASTBOUND TOLL PLAZA SECTIONS	650	647	1000
36	EASTBOUND TOLL PLAZA SECTIONS	38	156	87
37	WESTBOUND TOLL PLAZA SECTIONS	629	547	784
38	WESTBOUND TOLL PLAZA SECTIONS	1030	508	828
39	WESTBOUND TOLL PLAZA SECTIONS	4095	92	1166
40	WESTBOUND TOLL PLAZA SECTIONS	6874	311	1658
41	WESTBOUND TOLL PLAZA SECTIONS	4040	337	2239
42	WESTBOUND TOLL PLAZA SECTIONS	1471	312	1300
43	WESTBOUND TOLL PLAZA SECTIONS	56	74	31
44	EASTBOUND ACCESS ROAD SECTIONS	79	44	231
45	EASTBOUND ACCESS ROAD SECTIONS	102	6	254
46	EASTBOUND ACCESS ROAD SECTIONS	103	3	243
47	EASTBOUND ACCESS ROAD SECTIONS	91	3	210
48	WESTBOUND ACCESS ROAD SECTIONS	282	75	302
49	WESTBOUND ACCESS ROAD SECTIONS	470	15	448
50	WESTBOUND ACCESS ROAD SECTIONS	279	15	393
51	WESTBOUND ACCESS ROAD SECTIONS	364	15	438
52	WESTBOUND ACCESS ROAD SECTIONS	201	14	352
53	WESTBOUND ACCESS ROAD SECTIONS	63	10	187
54	WESTBOUND ACCESS ROAD SECTIONS	10	4	32
TOTALS CARRIED TO GENERAL SUMMARY		32634	15956	73433

PROJECT 39-20-02B	DATE: 12/20/2019	SUBSUMMARY PAVEMENT CALCULATIONS	LUCAS COUNTY	DESIGNED	CHECKED	NO.	REVISIONS	BY	DATE
				AMS	JRB	1	ADDENDUM NO. 2	AMS	1/15/20
1	1	TP-49		DRAWN	IN CHARGE				
18	59			AMS	CSM				

CHECKING PRINT

CHECKED: _____ DATE: _____
 BACKCHECKED: _____ DATE: _____
 CORRECTED: _____ DATE: _____
 APPROVED: _____ DATE: _____

nnnnXS01.dwg; 1/16/20 - 2.29pm

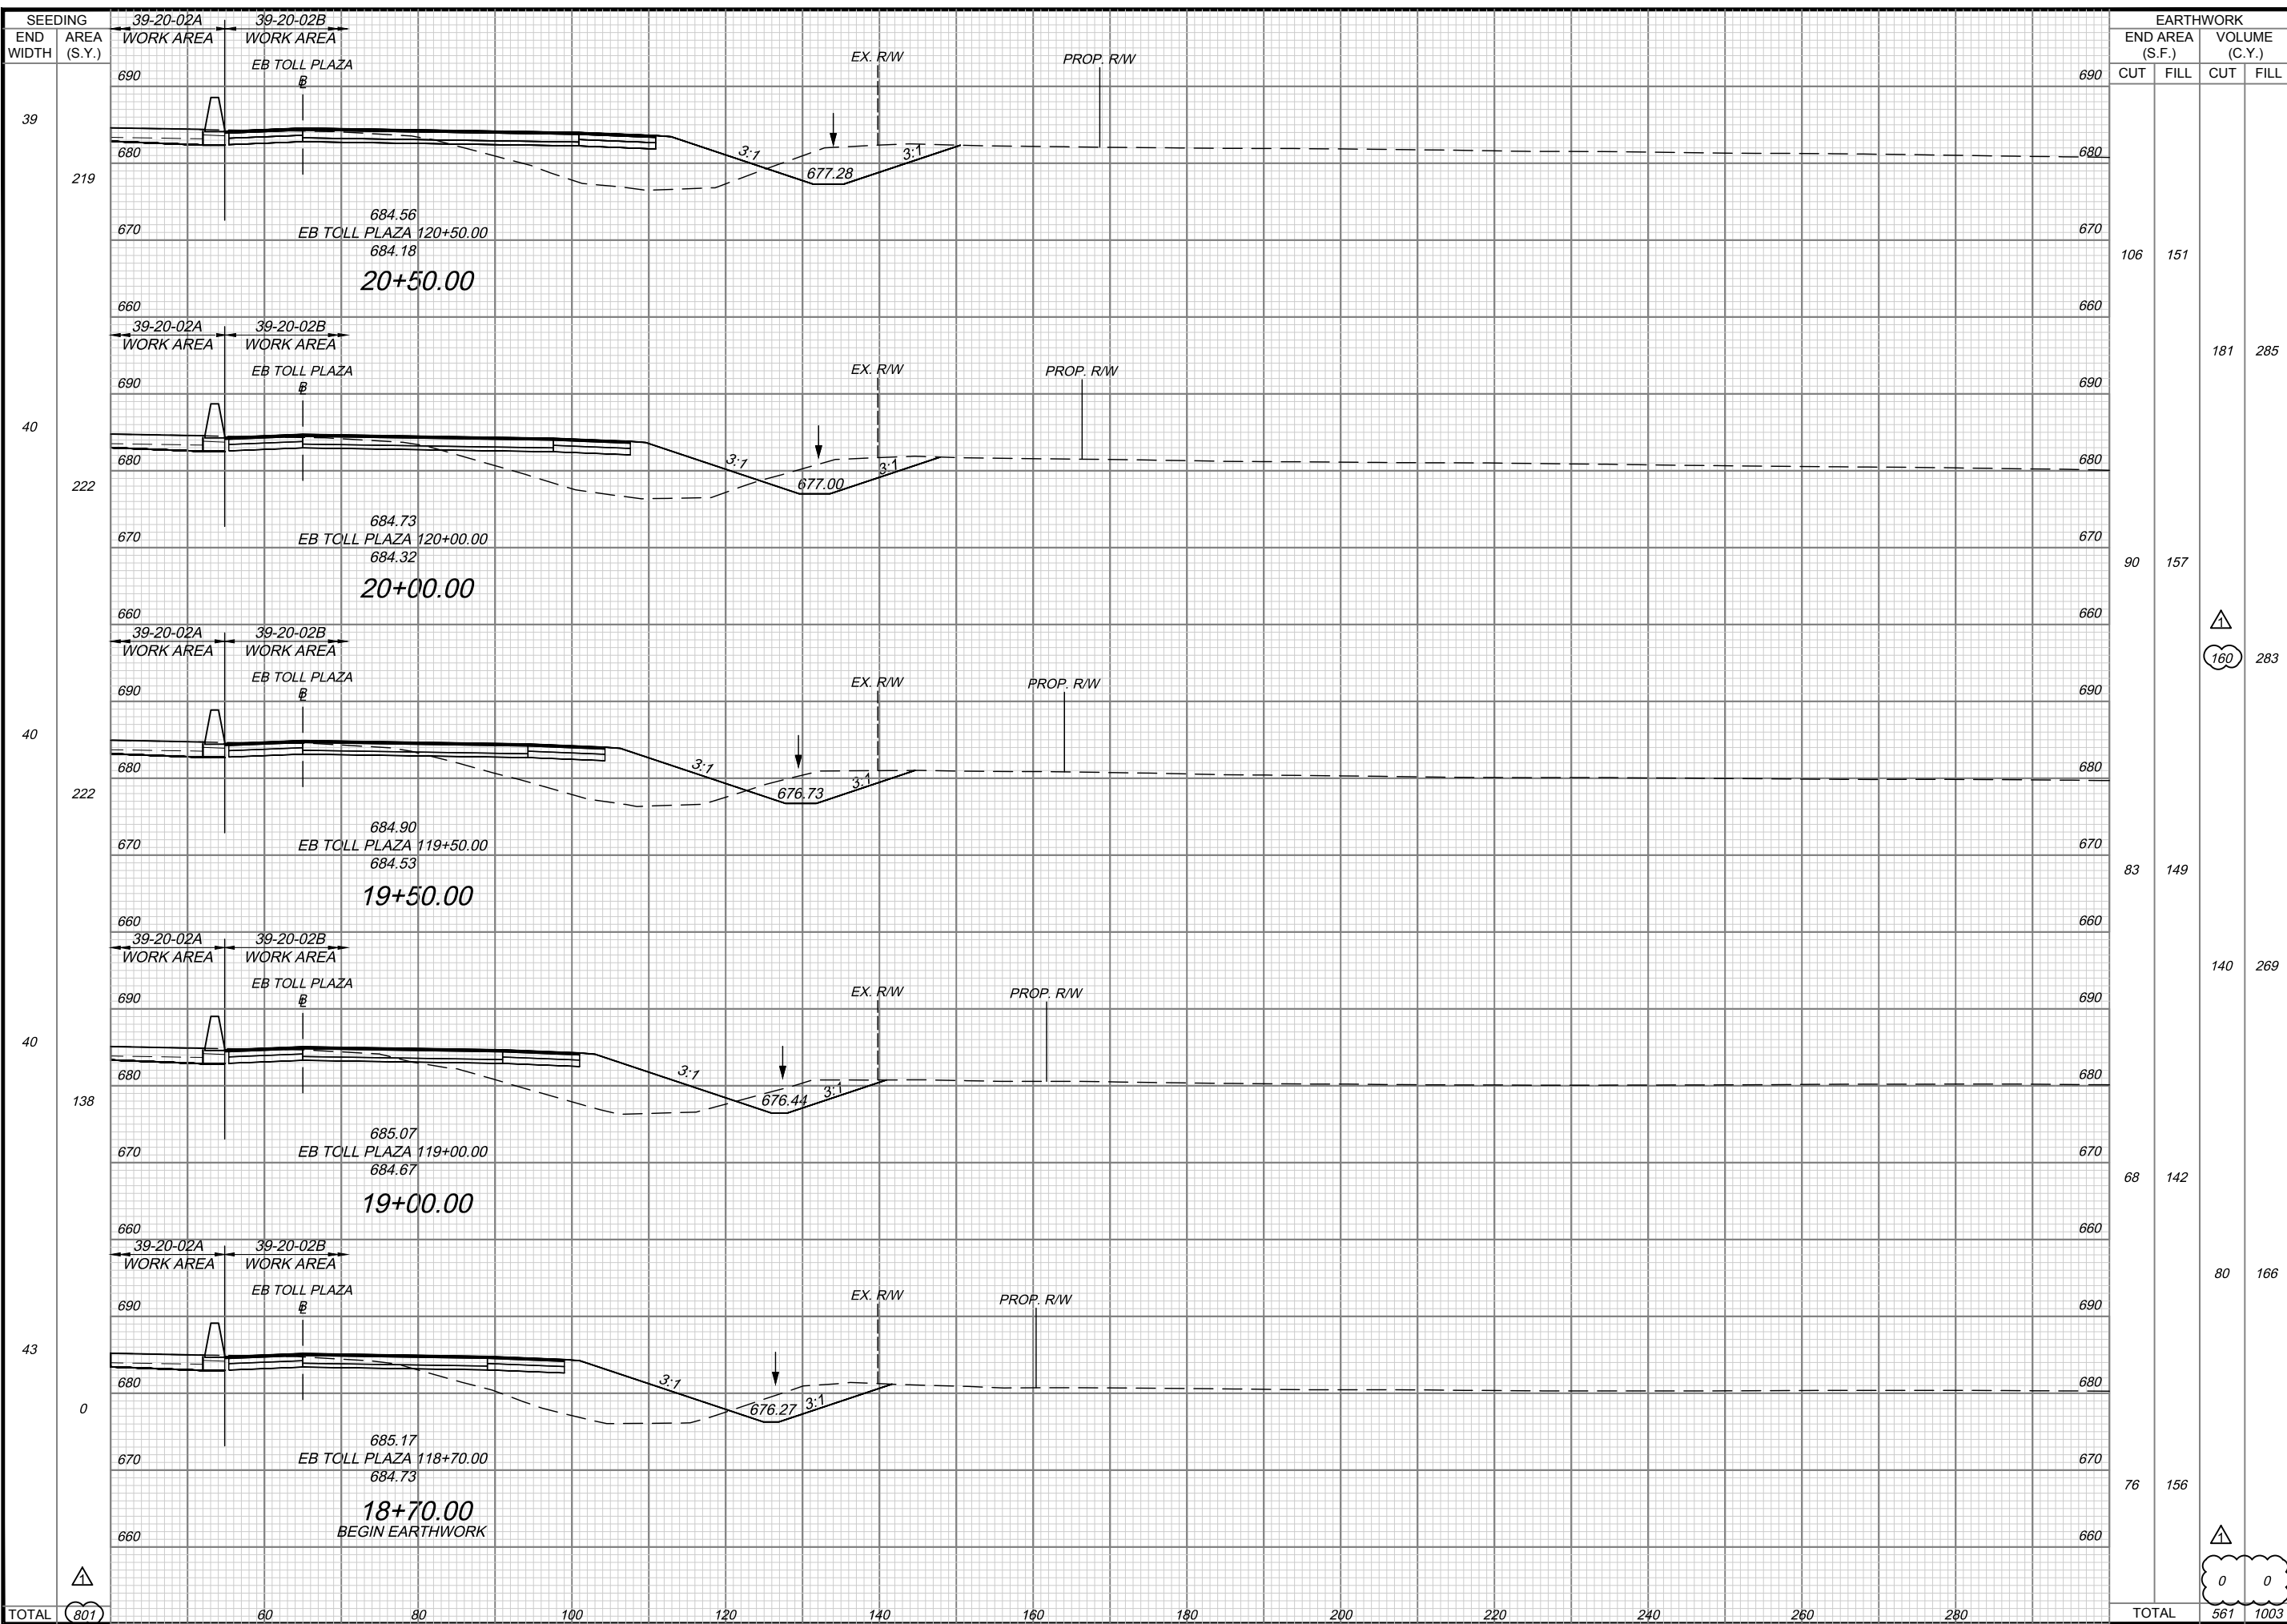

SEEDING END WIDTH	AREA (S.Y.)	EARTHWORK			
		END AREA (S.F.)		VOLUME (C.Y.)	
39	690				
219	680				
670	670	106	151		
660	660			181	285
40	690				
222	680				
670	670	90	157		
660	660				
40	690				
222	680				
670	670	83	149		
660	660				
40	690				
138	680				
670	670	68	142		
660	660				
43	690				
0	680				
670	670	76	156		
660	660				
TOTAL	(801)			561	1003

DESIGN AGENCY: **JACOBS**
 1231 JAMES ARNOLD BLVD
 OFFICE #1303222


NO.	BY	DATE	REVISIONS
1	AMS	11/15/20	ADDENDUM NO. 2

CHECKED: AMS
 DESIGNED: AMS
 DRAWN: AMS
 IN CHARGE: CSM
 PROJECT 39-20-02B
 DATE: 12/20/2019
 TP 49
 EASTBOUND TOLL PLAZA CROSS SECTIONS
 STA. 18+70 TO STA. 20+50
 LUCAS COUNTY

CHECKING PRINT

CHECKED: DATE: CORRECTED: DATE: BACKCHECKED: DATE: APPROVED: DATE:

nnnnXS01.dwg: 1/16/20 - 2:30pm

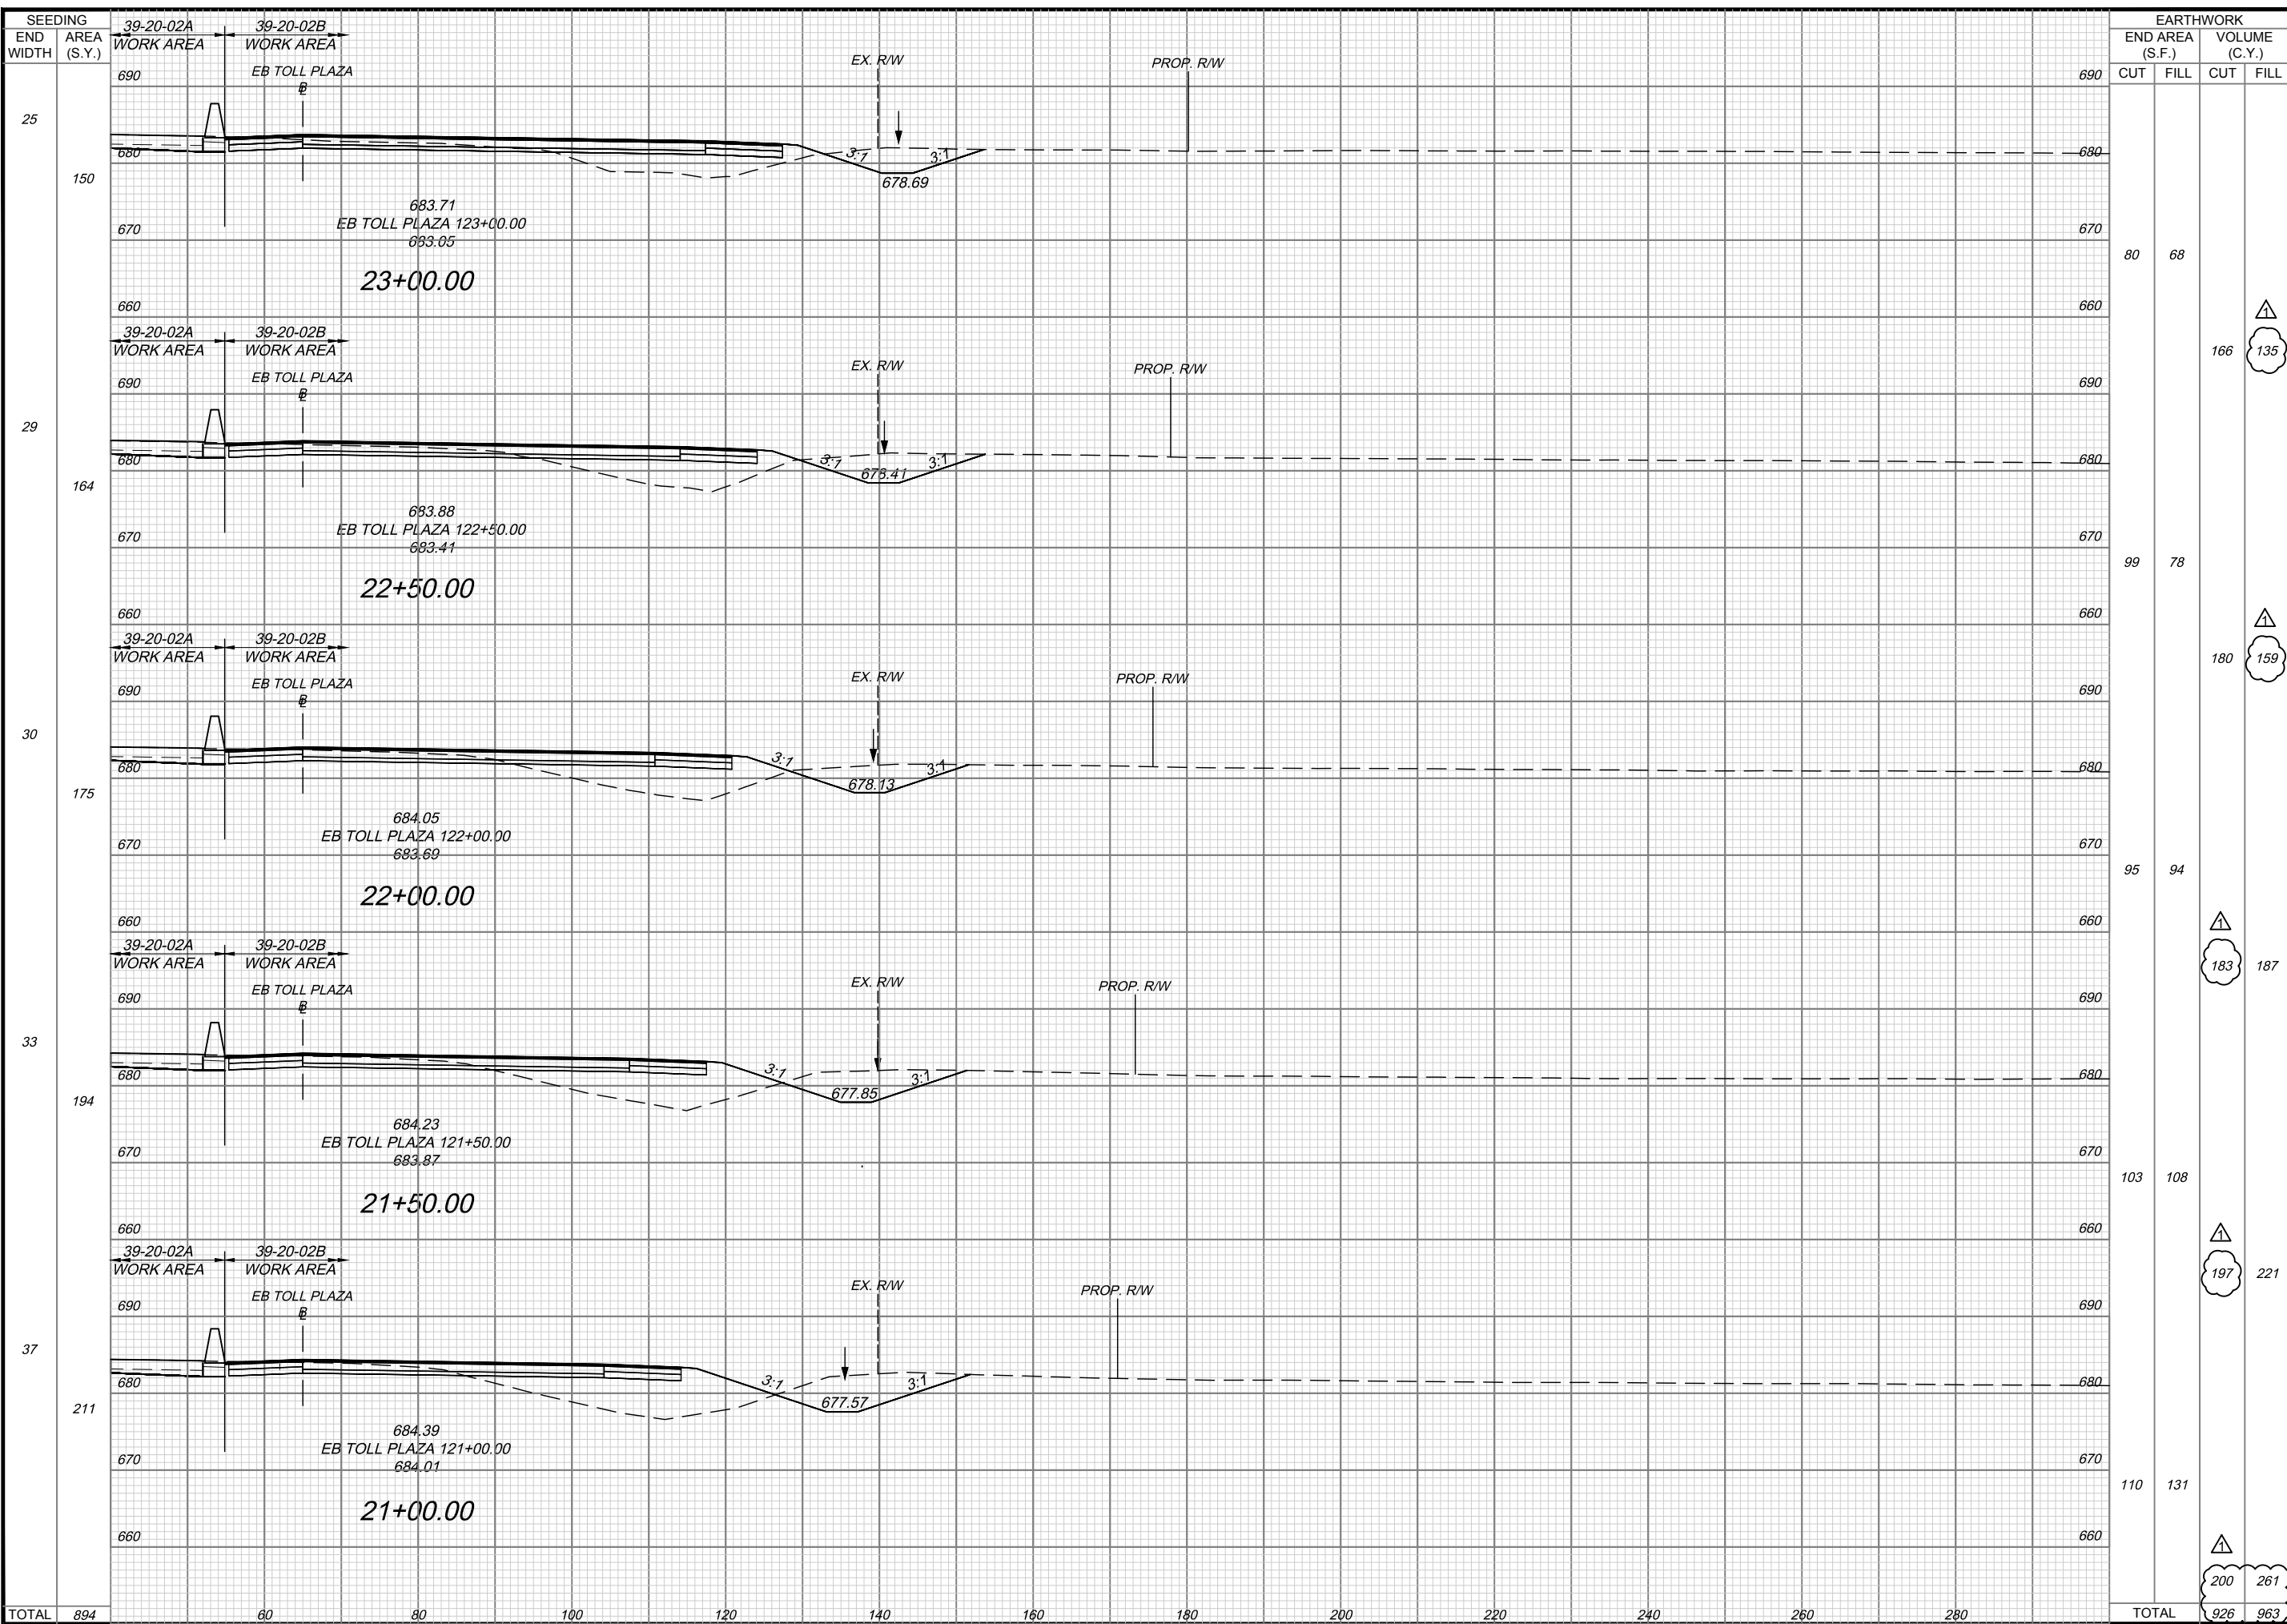

SEEDING		EARTHWORK	
END WIDTH	AREA (S.Y.)	END AREA (S.F.)	VOLUME (C.Y.)
		CUT	FILL
25	690	690	680
29	690	690	680
30	690	690	680
33	690	690	680
37	690	690	680
TOTAL	894	926	963

DESIGN AGENCY: **JACOBS**

PROJECT: 39-20-02B
 DATE: 12/20/2019
 TP 49

REVISIONS:

NO.	DATE	BY	REVISIONS
1	1/15/20	AMS	ADDENDUM NO. 2


CHECKED: AMS
 DESIGNED: AMS
 DRAWN: AMS
 IN CHARGE: CSM

LUCAS COUNTY

CHECKING PRINT

CHECKED: DATE: CORRECTED: DATE: BACKCHECKED: DATE: APPROVED: DATE:

nnnnXS01.dwg; 1/16/20 - 2:30pm

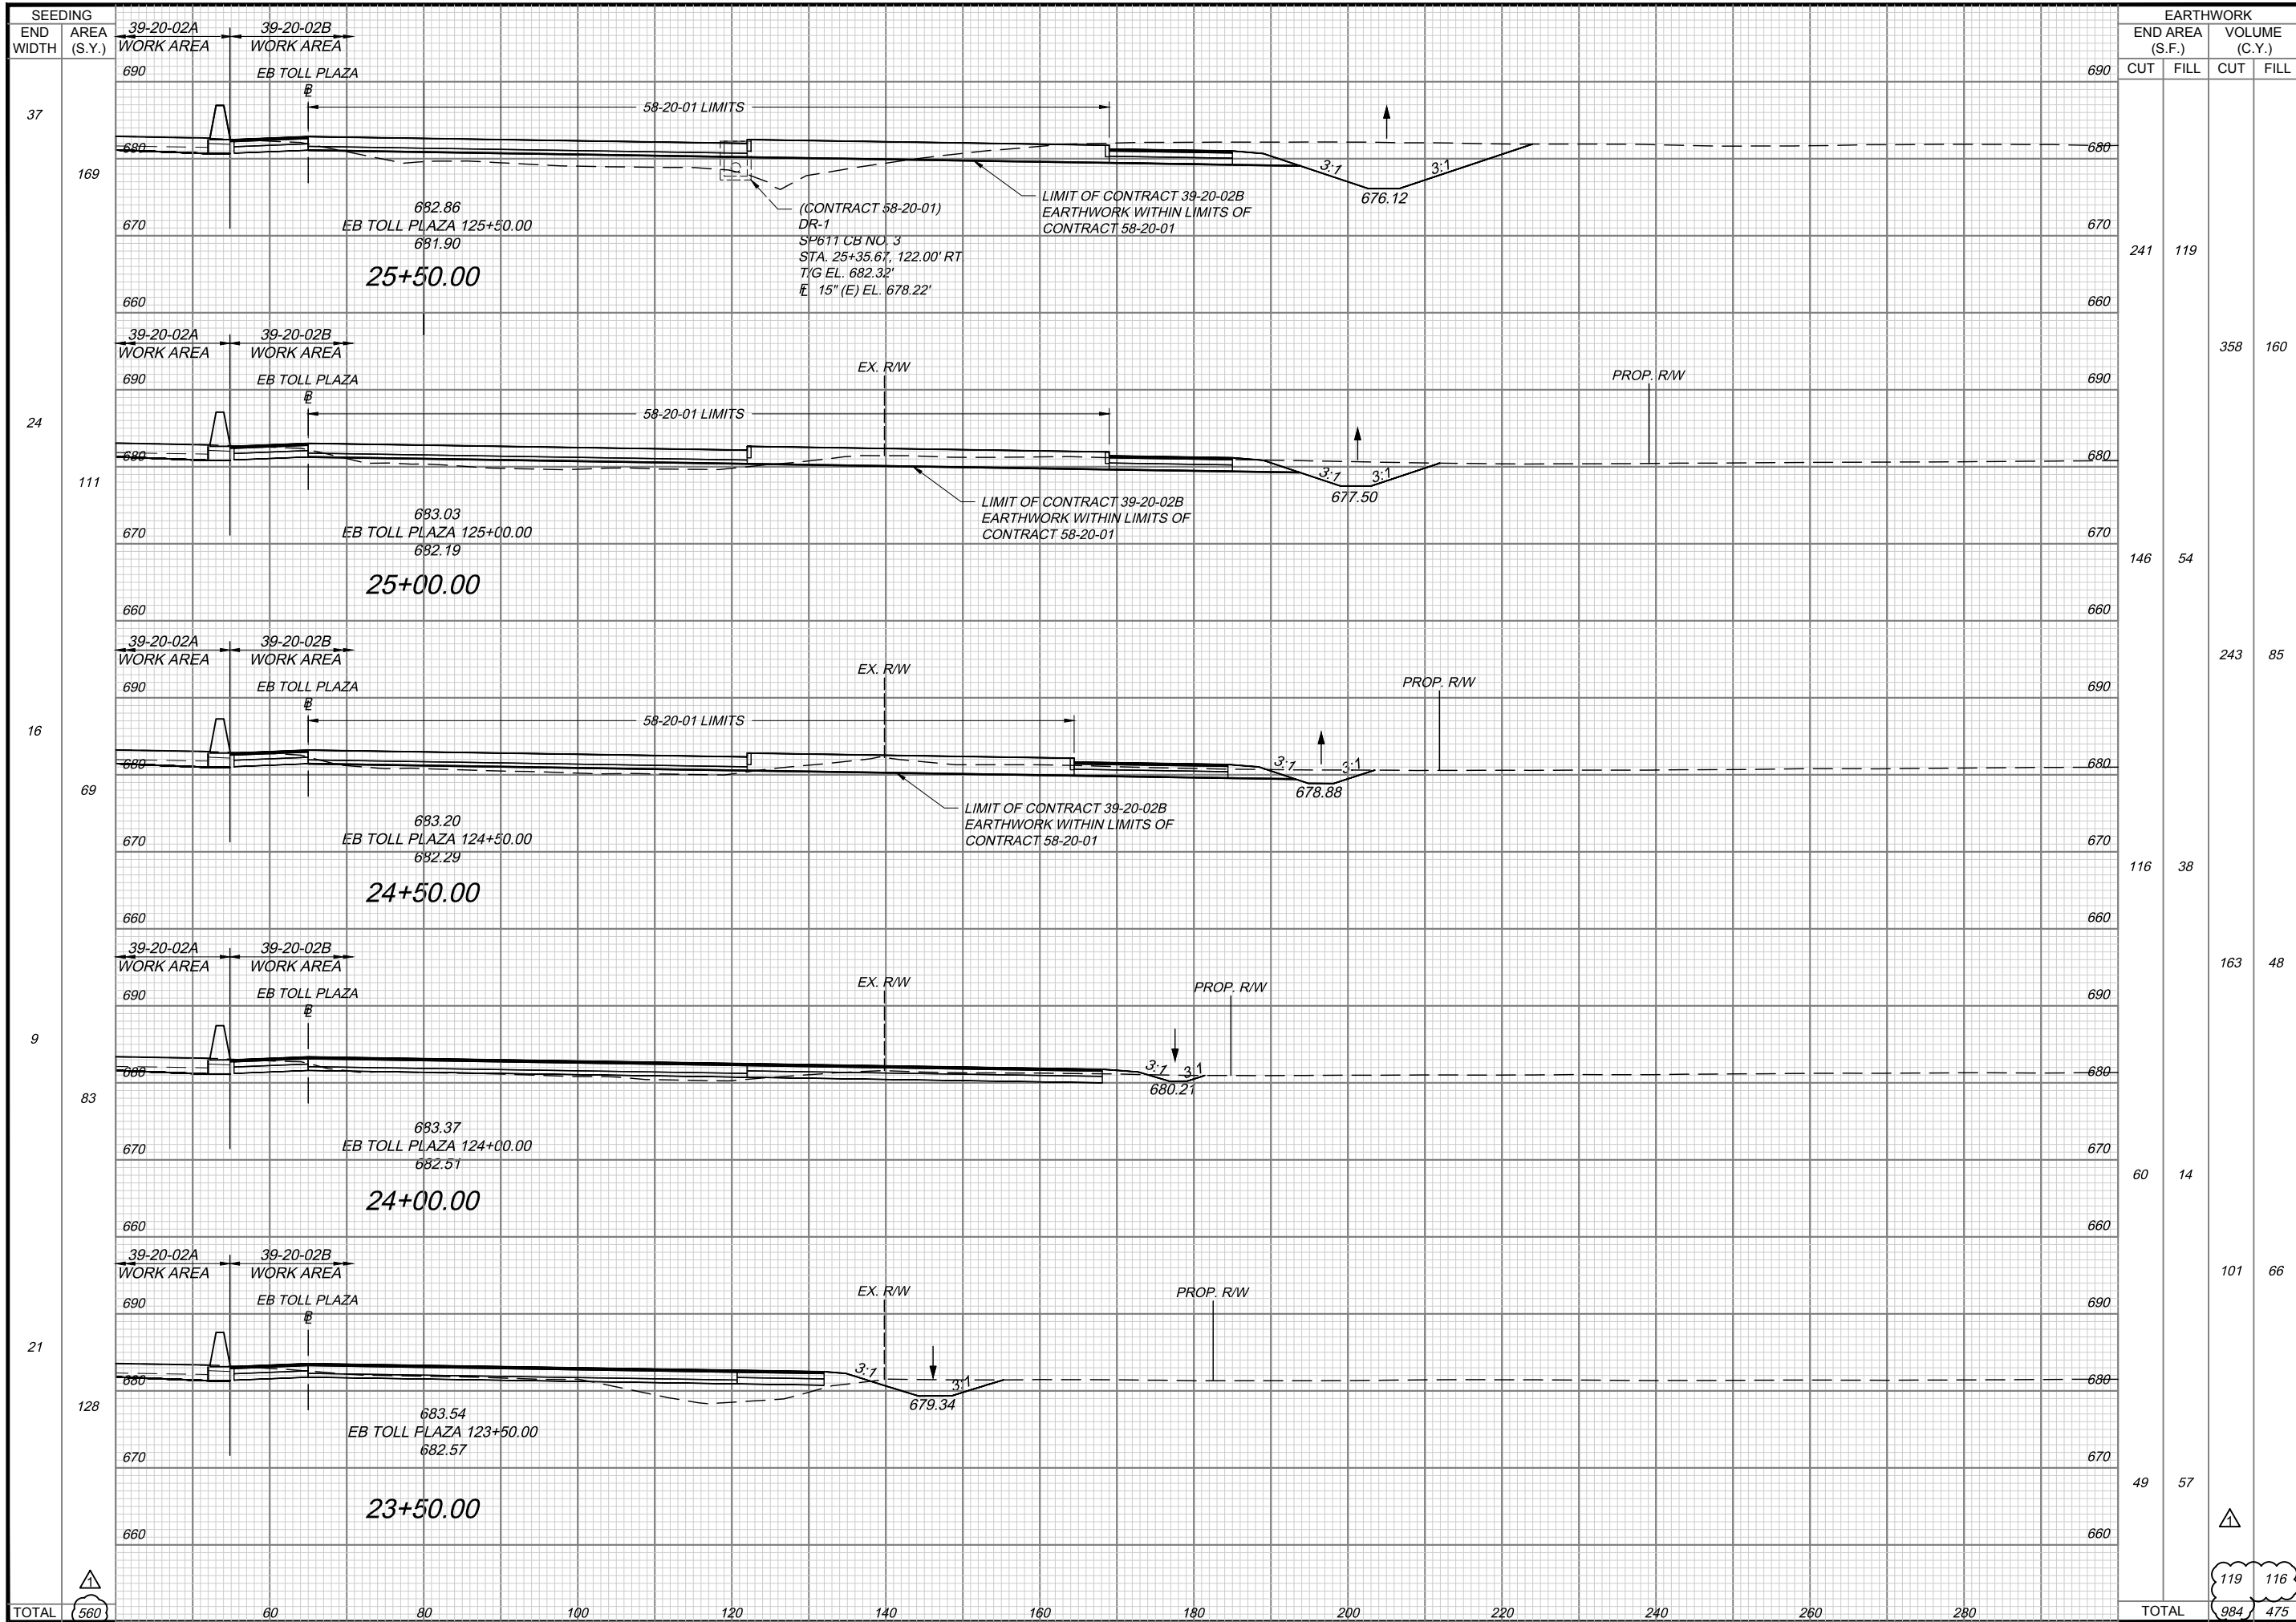

SEEDING		EARTHWORK			
END WIDTH	AREA (S.Y.)	END AREA (S.F.)		VOLUME (C.Y.)	
		CUT	FILL	CUT	FILL
37	690				
169	680				
670	682.86 EB TOLL PLAZA 125+50.00 681.90	241	119		
660	25+50.00			358	160
24	690				
111	680				
670	683.03 EB TOLL PLAZA 125+00.00 682.19	146	54		
660	25+00.00			243	85
16	690				
69	680				
670	683.20 EB TOLL PLAZA 124+50.00 682.29	116	38		
660	24+50.00			163	48
9	690				
83	680				
670	683.37 EB TOLL PLAZA 124+00.00 682.51	60	14		
660	24+00.00			101	66
21	690				
128	680				
670	683.54 EB TOLL PLAZA 123+50.00 682.57	49	57		
660	23+50.00				
TOTAL	560	984	475		


DESIGN AGENCY: **JACOBS**
 PROJECT: 39-20-02B
 DATE: 12/20/2019
 TP 49
 EASTBOUND TOLL PLAZA CROSS SECTIONS
 STA. 23+50 TO STA. 25+50
 LUCAS COUNTY

NO.	BY	DATE	REVISIONS
1	AMS	1/15/20	ADDENDUM NO. 2

CHECKED: AMS
 DESIGNED: AMS
 DRAWN: AMS
 IN CHARGE: CSM

CHECKING PRINT

CHECKED: _____ DATE: _____
 BACKCHECKED: _____ DATE: _____
 CORRECTED: _____ DATE: _____
 APPROVED: _____ DATE: _____

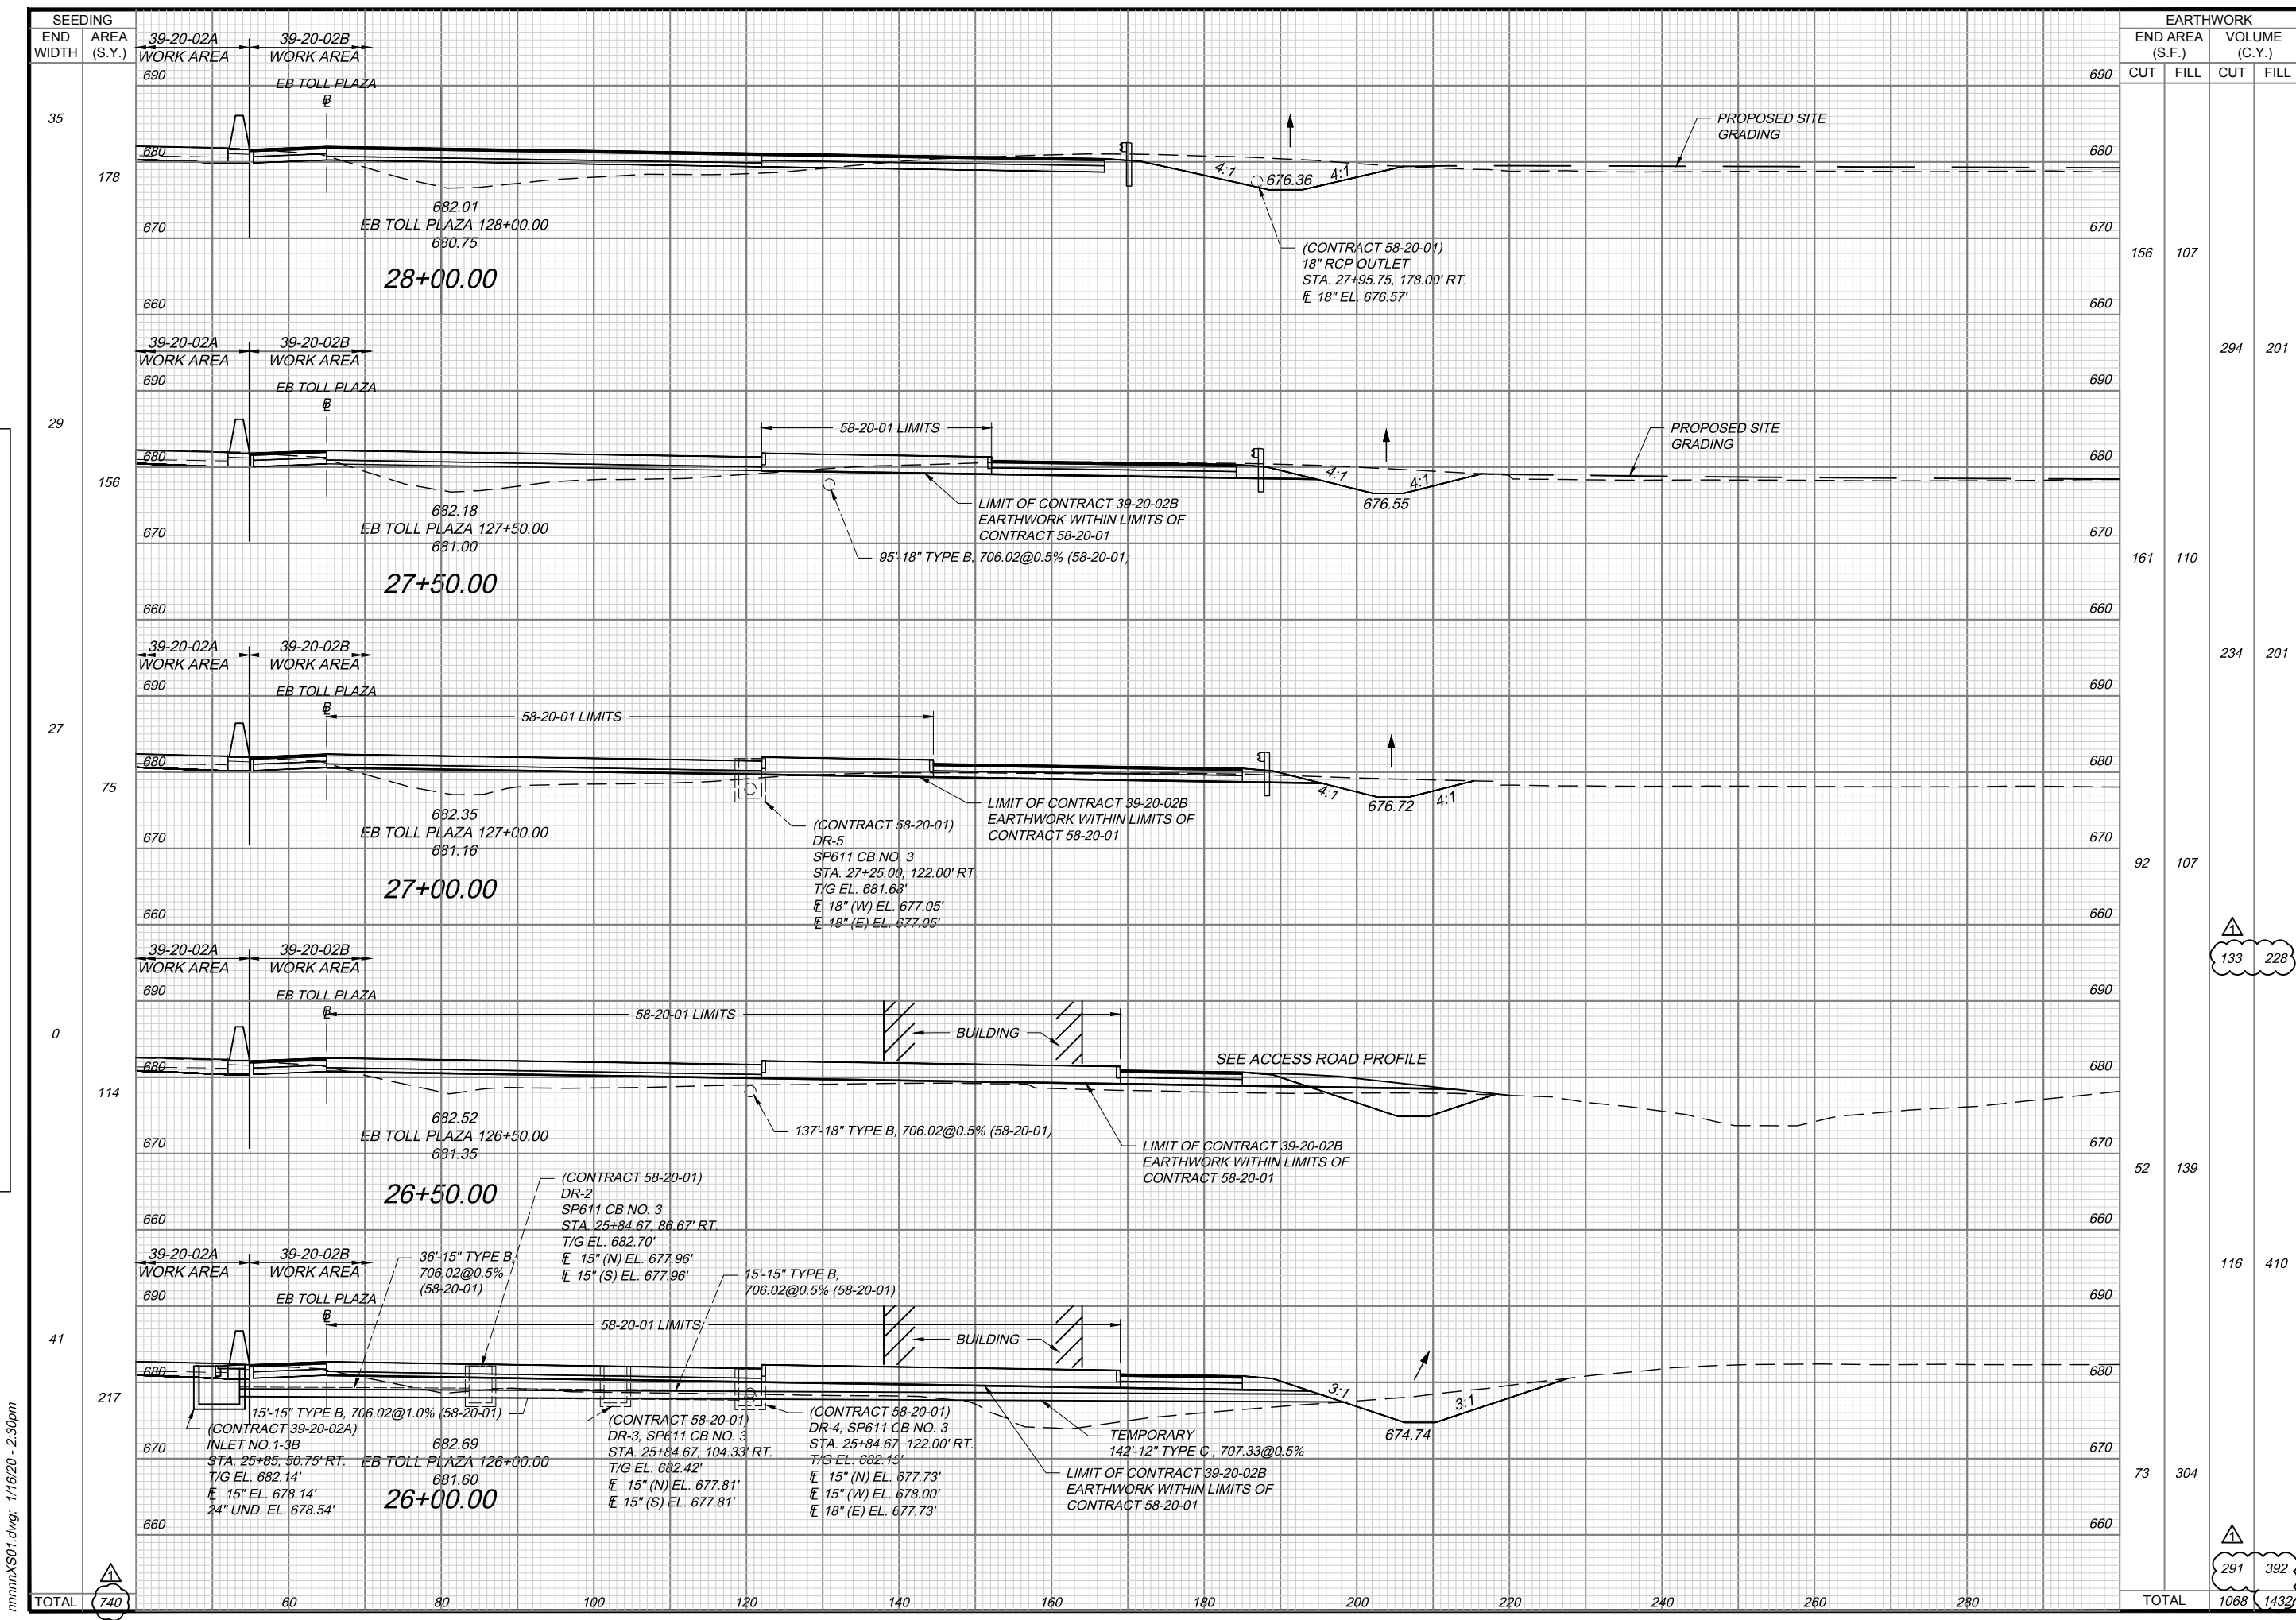

SEEDING		EARTHWORK			
END WIDTH	AREA (S.Y.)	END AREA (S.F.)	VOLUME (C.Y.)		
		CUT	FILL	CUT	FILL
35	690				
178					
670		156	107		
660					
29	690			294	201
156					
670		161	110		
660					
27	690			234	201
75					
670		92	107		
660					
0	690				
114					
670		52	139		
660					
41	690			116	410
217					
670		73	304		
660					
TOTAL	740			1068	1432

DESIGN AGENCY: **JACOBS**
 PROJECT: PROJECT 39-20-02B
 DATE: 12/20/2019
 TP 49
 EASTBOUND TOLL PLAZA CROSS SECTIONS
 STA. 26+00 TO STA. 28+00
 LUCAS COUNTY


33
59

nmnmXS01.dwg; 1/16/20 - 2:30pm

CHECKING PRINT

CHECKED: _____ DATE: _____
 BACKCHECKED: _____ DATE: _____
 CORRECTED: _____ DATE: _____
 APPROVED: _____ DATE: _____

nnnnXS01.dwg; 1/16/20 - 2:30pm

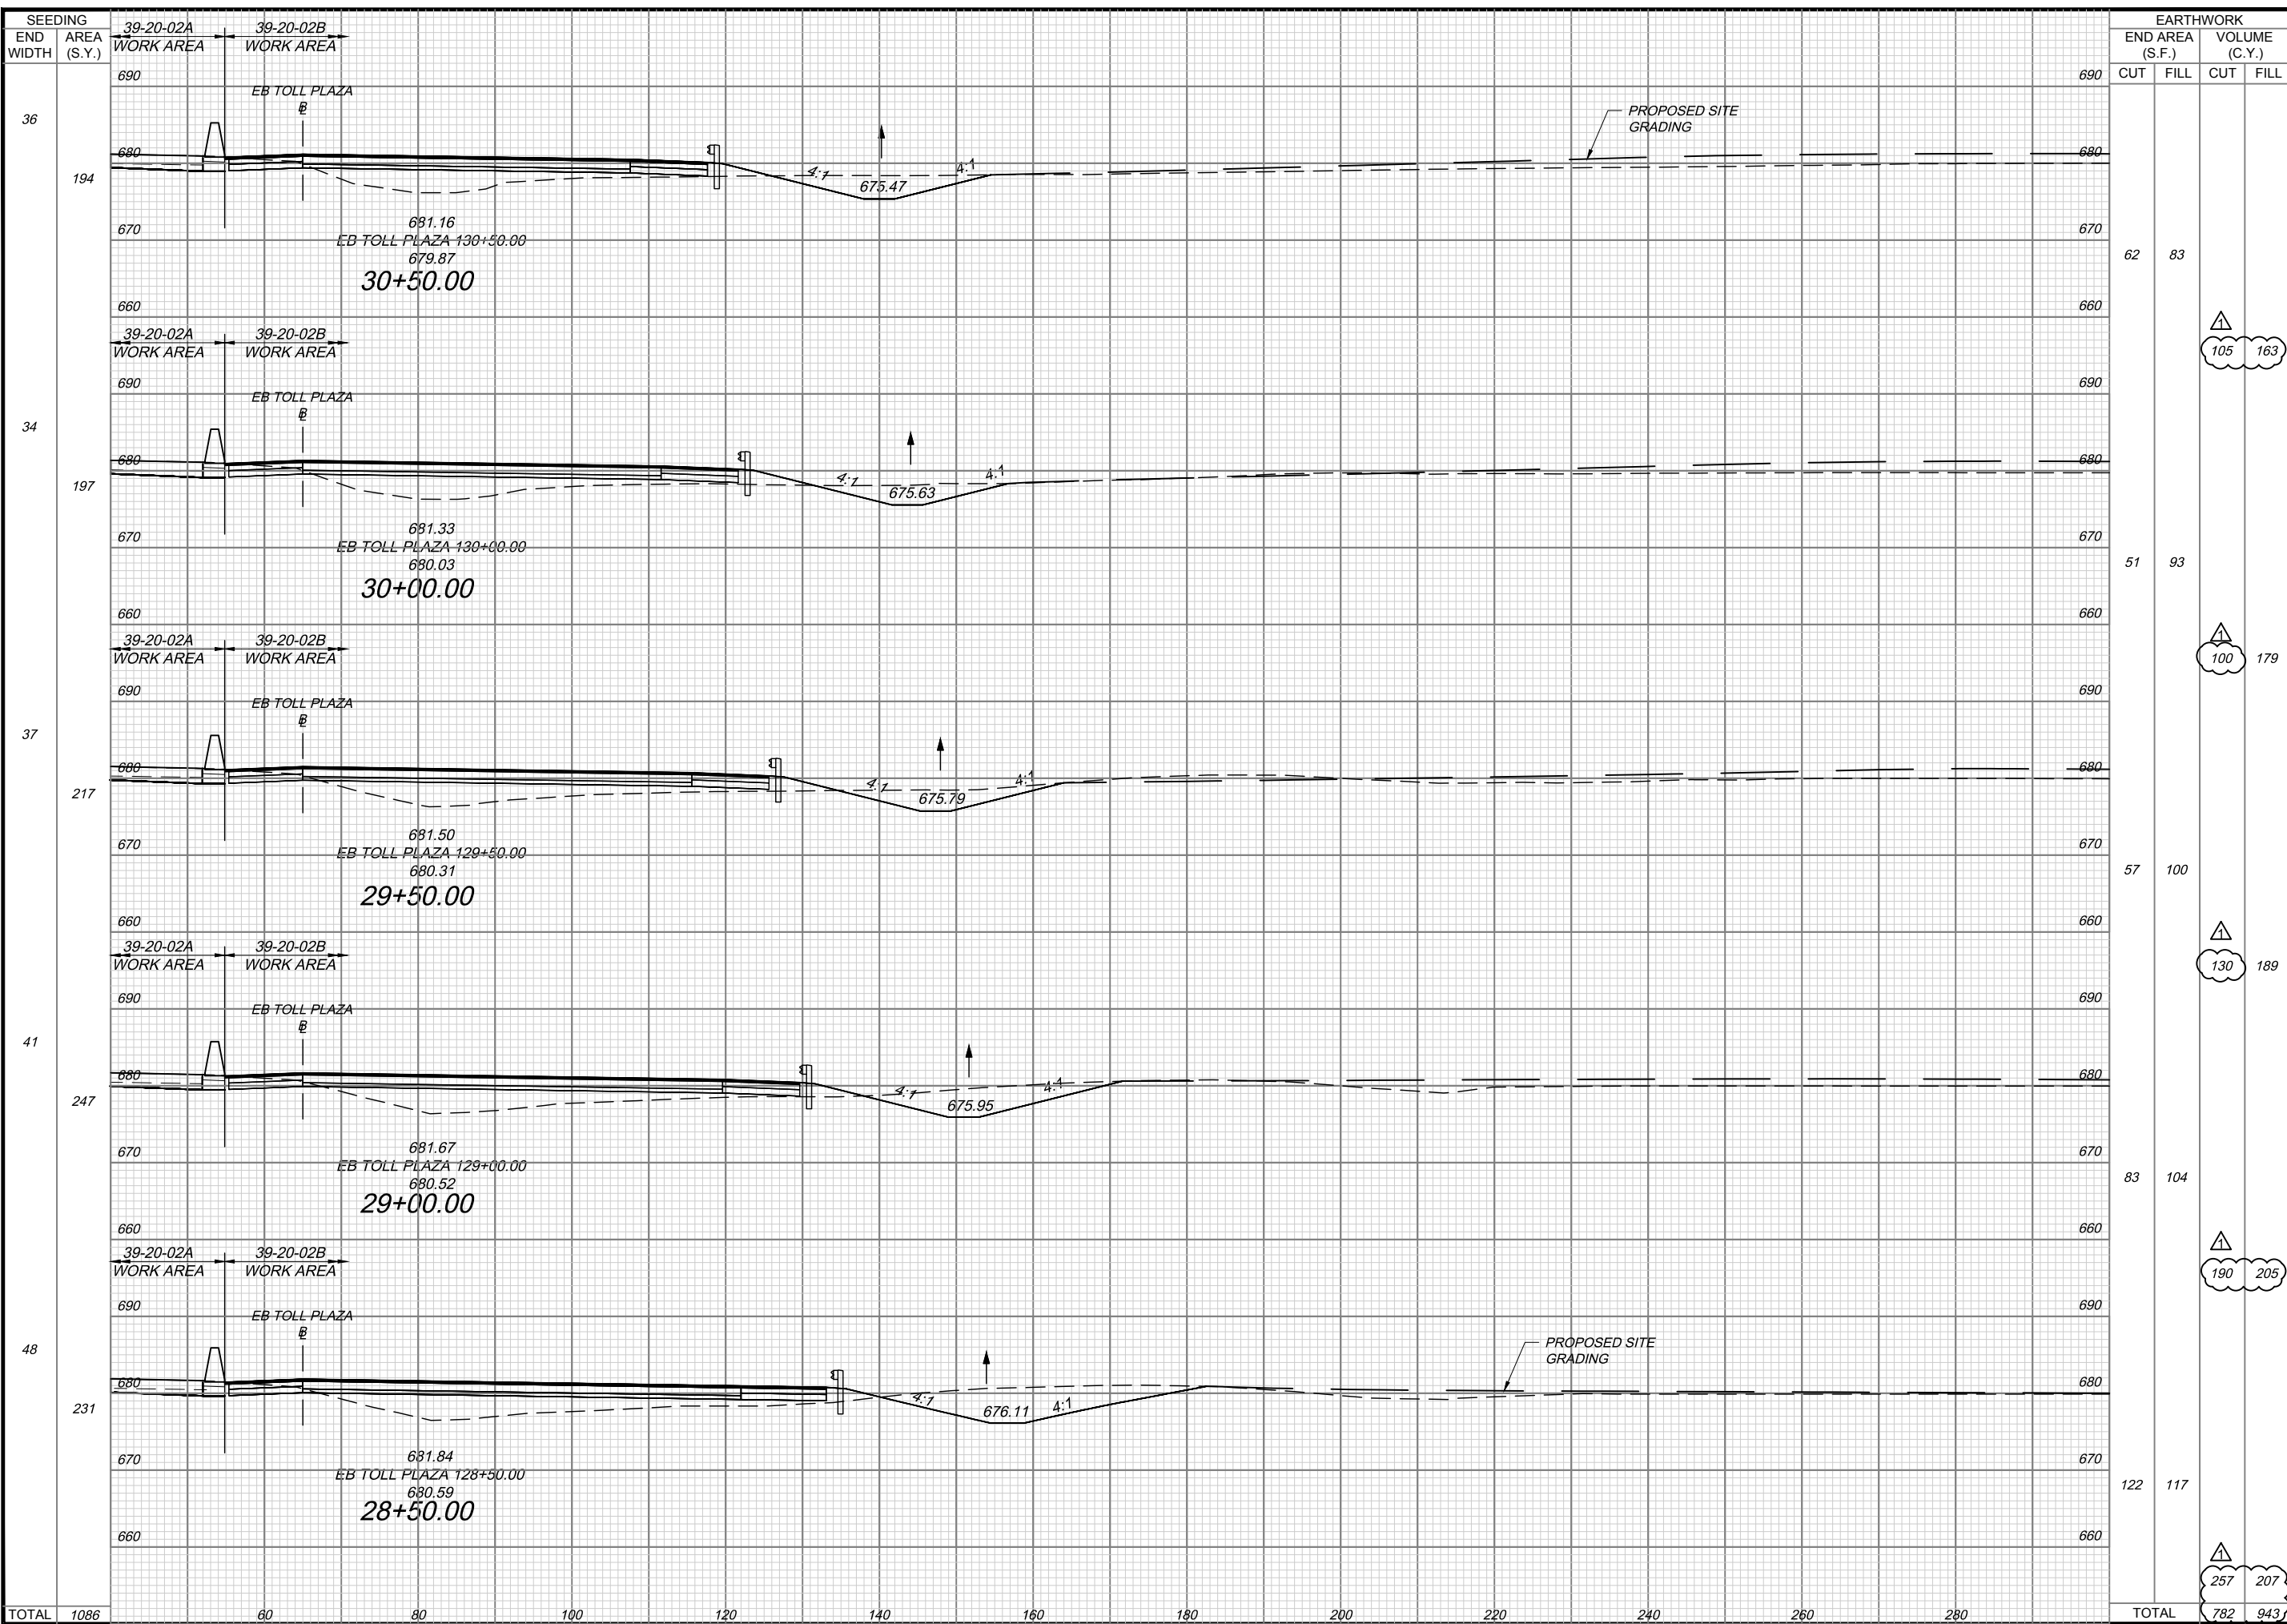

SEEDING		EARTHWORK	
END WIDTH	AREA (S.Y.)	END AREA (S.F.)	VOLUME (C.Y.)
		CUT	FILL
36	690	690	
34	690	680	
37	690	680	
41	690	680	
48	690	680	
TOTAL	1086	782	943

DESIGN AGENCY: **JACOBS**
 PROJECT: 39-20-02B
 DATE: 12/20/2019
 TP 49
 EASTBOUND TOLL PLAZA CROSS SECTIONS
 STA. 28+50 TO STA. 30+50
 LUCAS COUNTY
 REVISIONS: 1
 CHECKED: AMS
 DESIGNED: AMS
 DRAWN: AMS
 IN CHARGE: CSM
 ADDENDUM NO. 2
 BY DATE: AMS 1/15/20

OHIO TURNPIKE
 OHIO TURNPIKE
 OHIO TURNPIKE

105 163

100 179

130 189

190 205


257 207

34
59

CHECKING PRINT

CHECKED: DATE: CORRECTED: DATE: BACKCHECKED: DATE: APPROVED: DATE:

nnnnXS01.dwg; 1/16/20 - 2:30pm

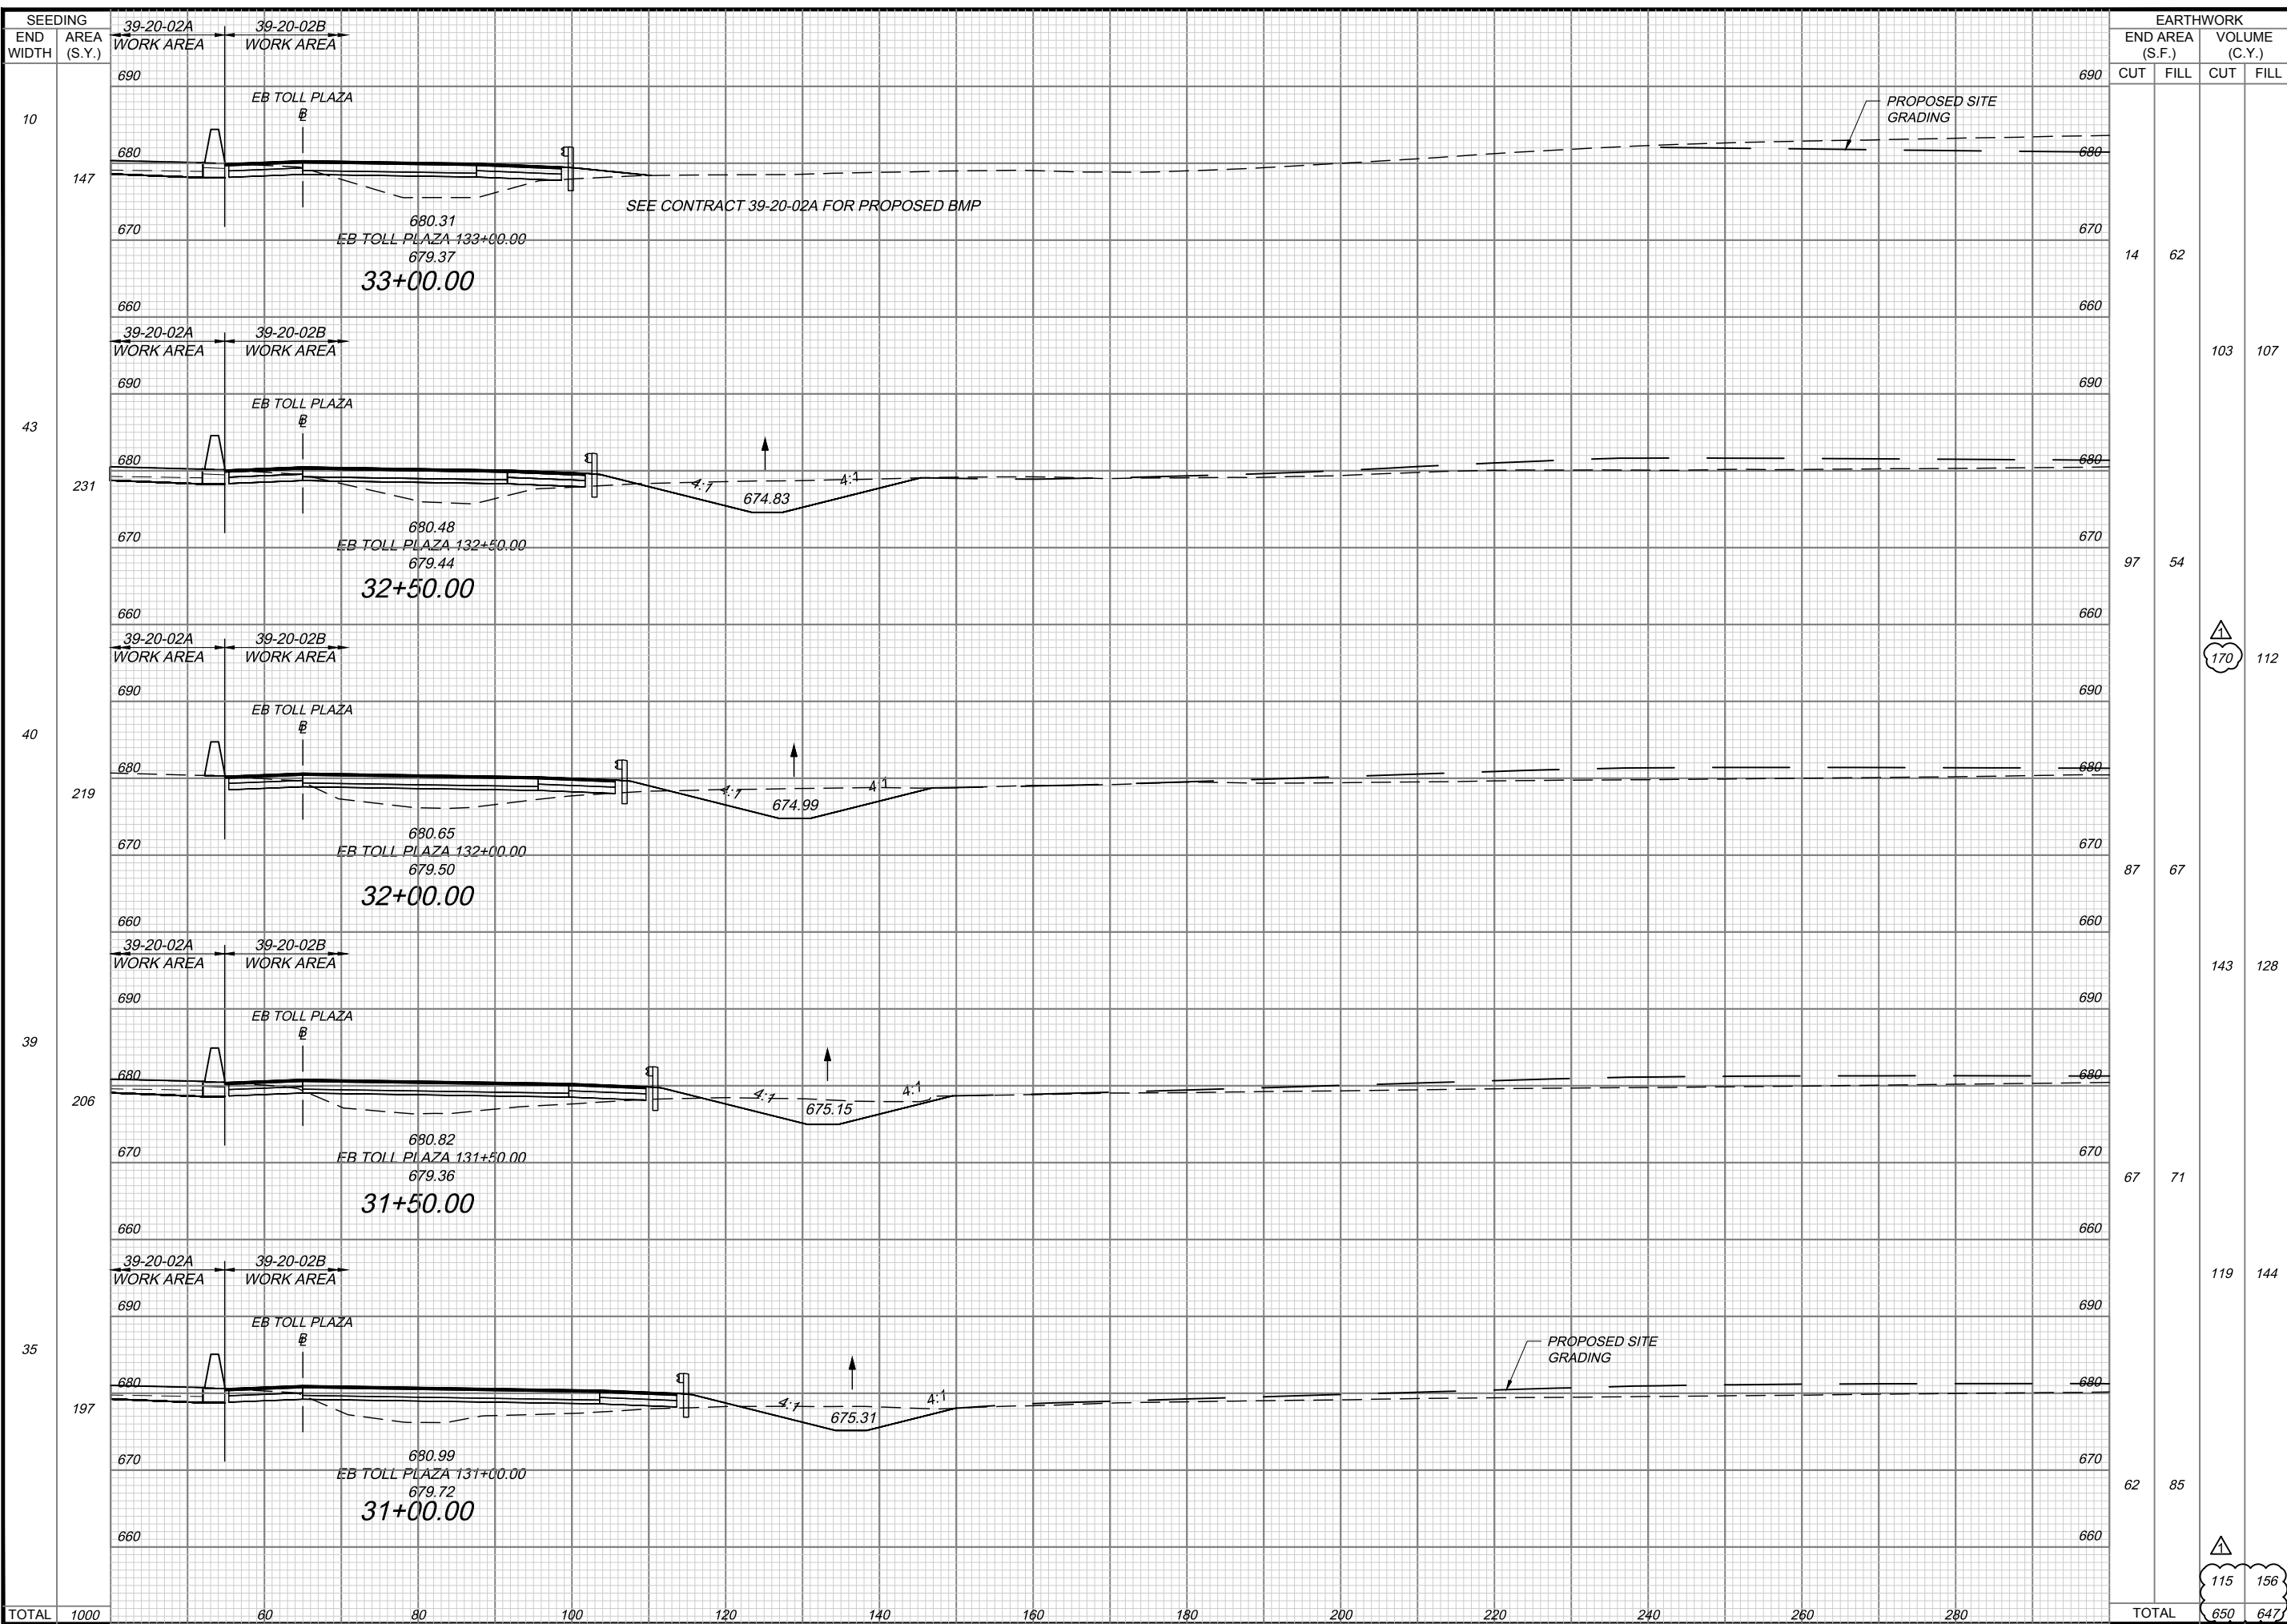

SEEDING		EARTHWORK	
END WIDTH	AREA (S.Y.)	END AREA (S.F.)	VOLUME (C.Y.)
		CUT	FILL
10	690		
147	680	14	62
670	670		
660	660		
43	690		103
231	680	97	54
670	670		
660	660		
40	690		112
219	680	87	67
670	670		
660	660		
39	690		143
206	680	67	71
670	670		
660	660		
35	690		119
197	680	62	85
670	670		
660	660		
TOTAL	1000	650	647

DESIGN AGENCY: JACOBS

PROJECT 39-20-02B DATE: 12/20/2019

EASTBOUND TOLL PLAZA CROSS SECTIONS STA. 31+00 TO STA. 33+00

LUCAS COUNTY TP 49

REVISIONS: NO. 1 DATE 1/15/20

ADDENDUM NO. 2

CHECKED BY: AMS

DESIGNED BY: AMS

DRAWN BY: AMS

IN CHARGE: CSM

BY DATE: AMS 1/15/20

OHIO TURNPIKE AND INFRASTRUCTURE COMMISSION

OHIO TURNPIKE

115 156


35 59

6/7

CHECKING PRINT

CHECKED: _____ DATE: _____ CORRECTED: _____ DATE: _____
BACKCHECKED: _____ DATE: _____ APPROVED: _____ DATE: _____

nmmnx01.dwg; 1/16/20 - 2:30pm

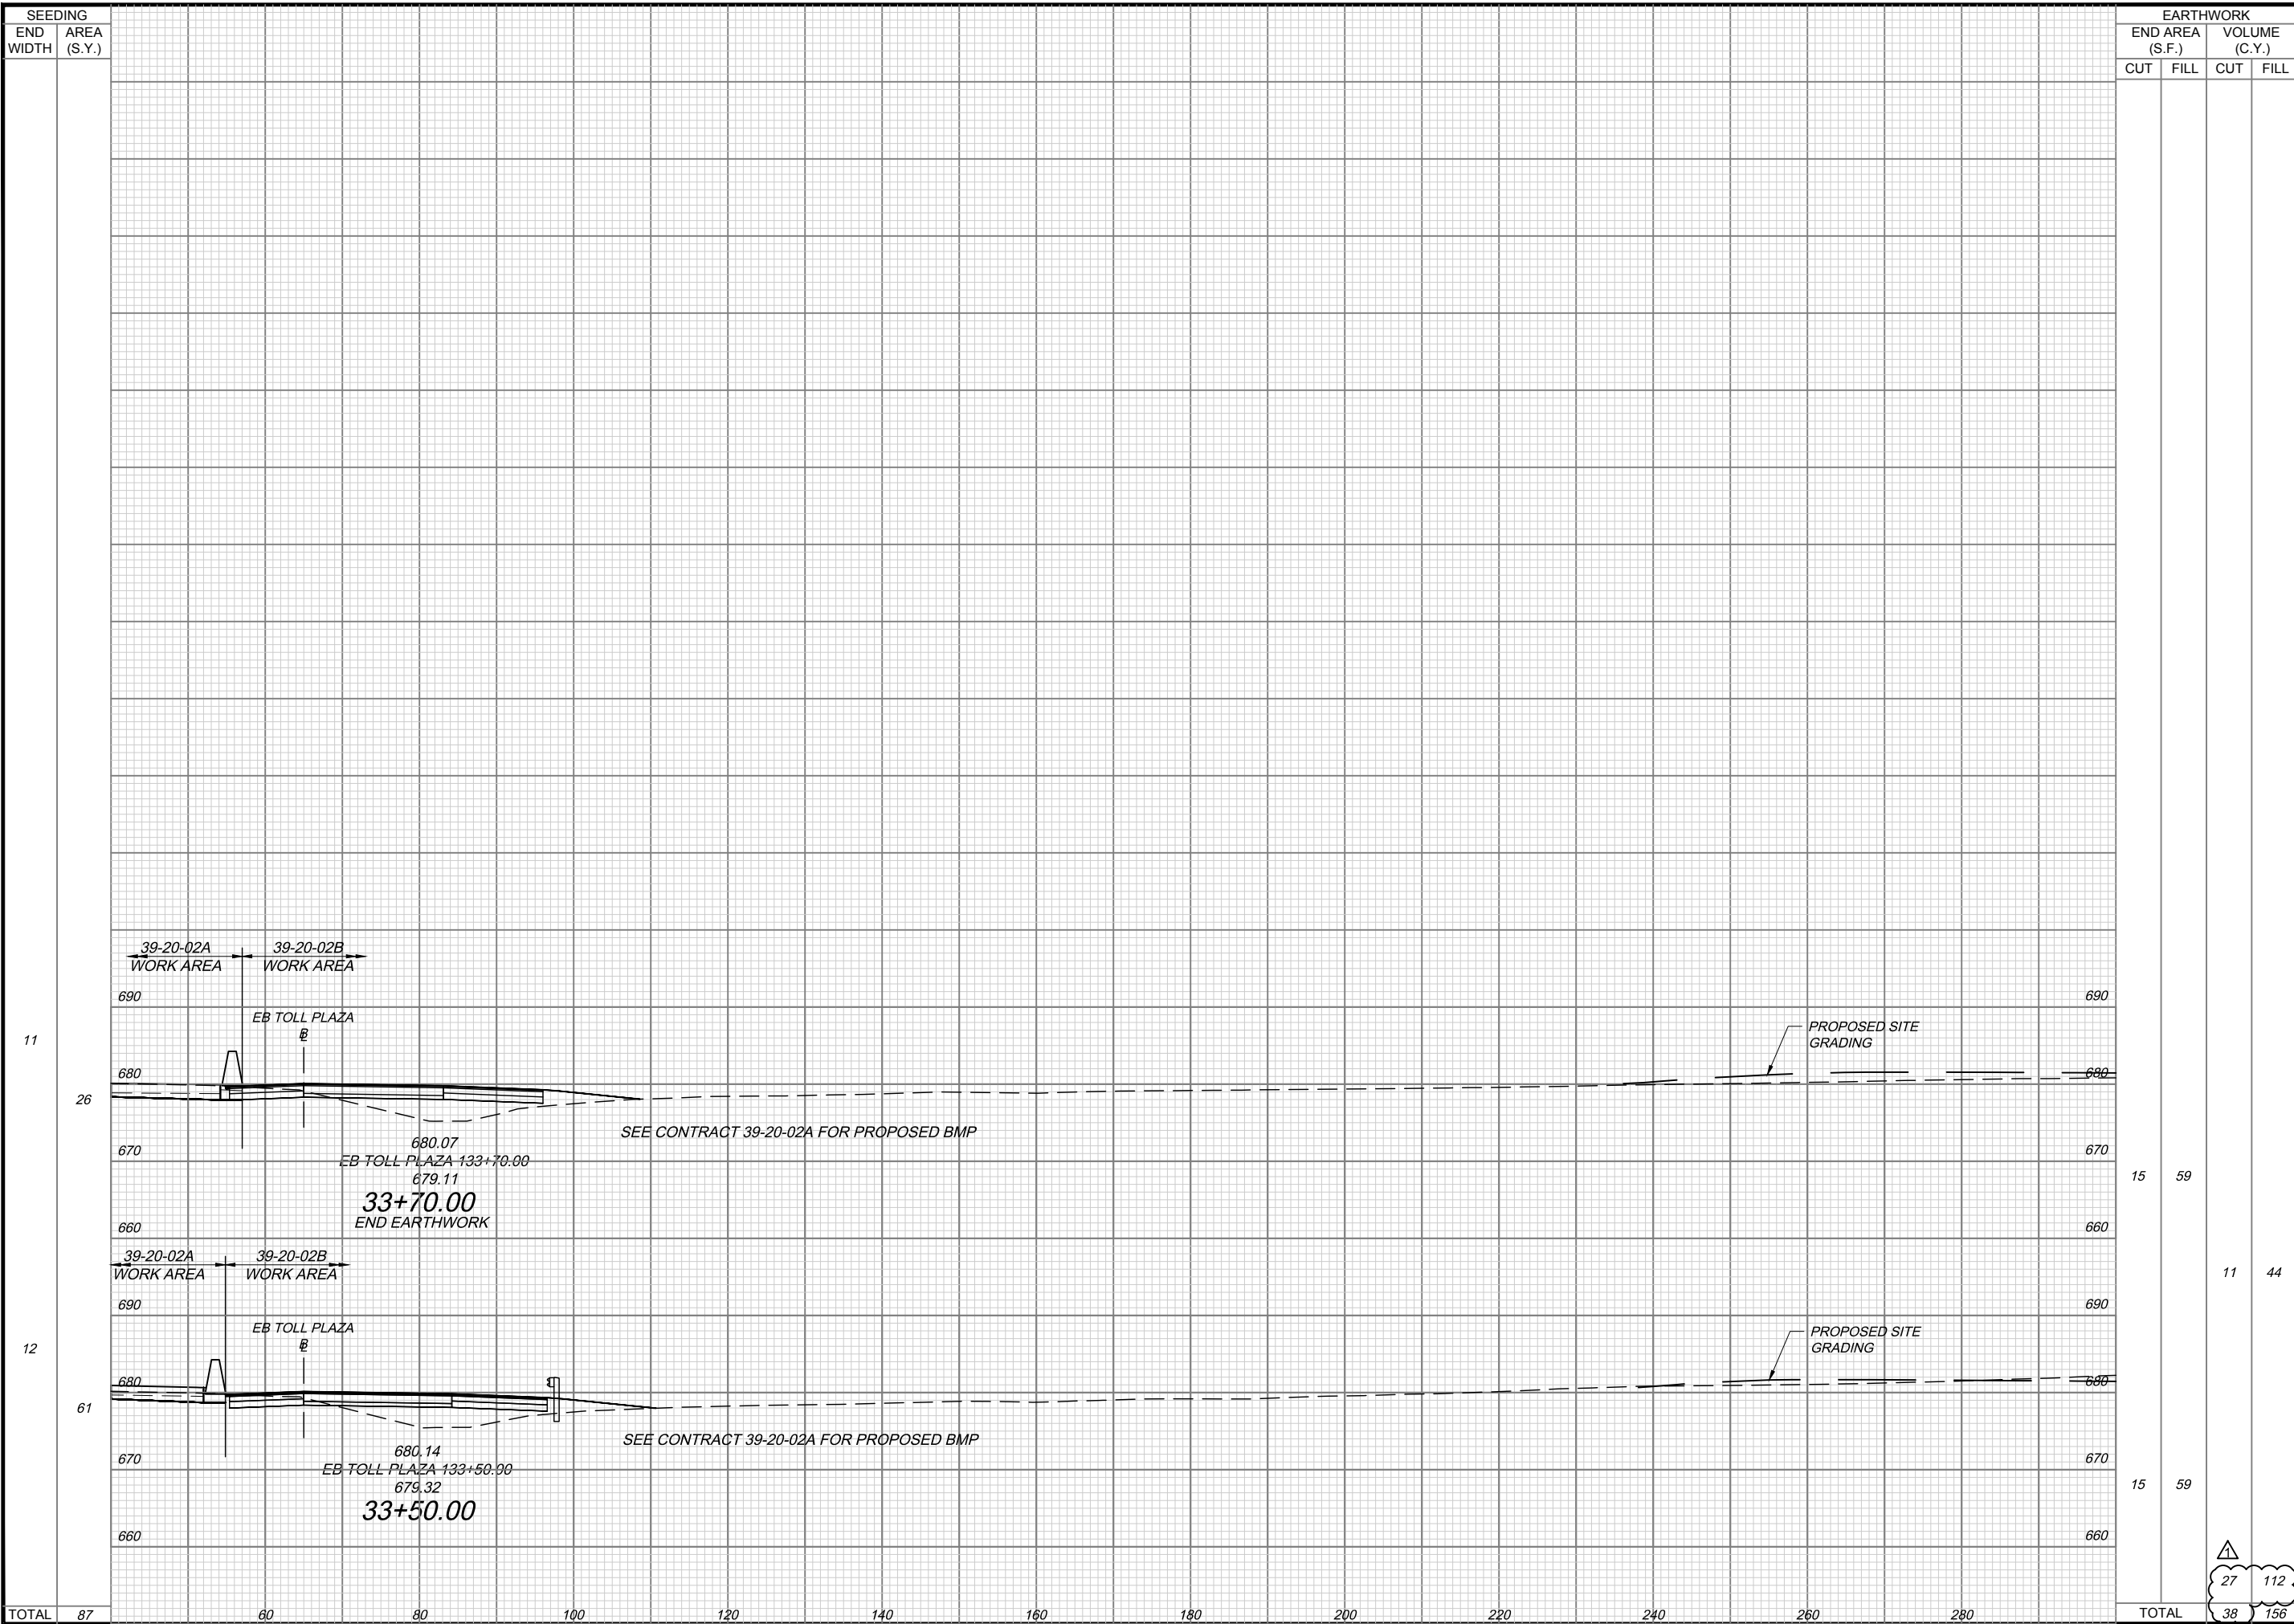

SEEDING		EARTHWORK	
END WIDTH	AREA (S.Y.)	END AREA (S.F.)	VOLUME (C.Y.)
CUT	FILL	CUT	FILL
11	26	15	59
12	61	15	59
TOTAL	87	30	118

27	112
36	59

DESIGN AGENCY: **JACOBS**
BY DATE: AMS 1/15/20
REVISIONS: ADDENDUM NO. 2
CHECKED: AMS
DESIGNED: AMS
DRAWN: AMS
PROJECT: 39-20-02B
DATE: 12/20/2019
TP 49


EASTBOUND TOLL PLAZA CROSS SECTIONS
STA. 33+50 TO STA. 33+70
LUCAS COUNTY
OHIO TURNPIKE AND INFRASTRUCTURE COMMISSION



CHECKING PRINT

CHECKED: _____ DATE: _____ CORRECTED: _____ DATE: _____
 BACKCHECKED: _____ DATE: _____ APPROVED: _____ DATE: _____

nnnnXS02.dwg: 1/16/20 - 1:35pm

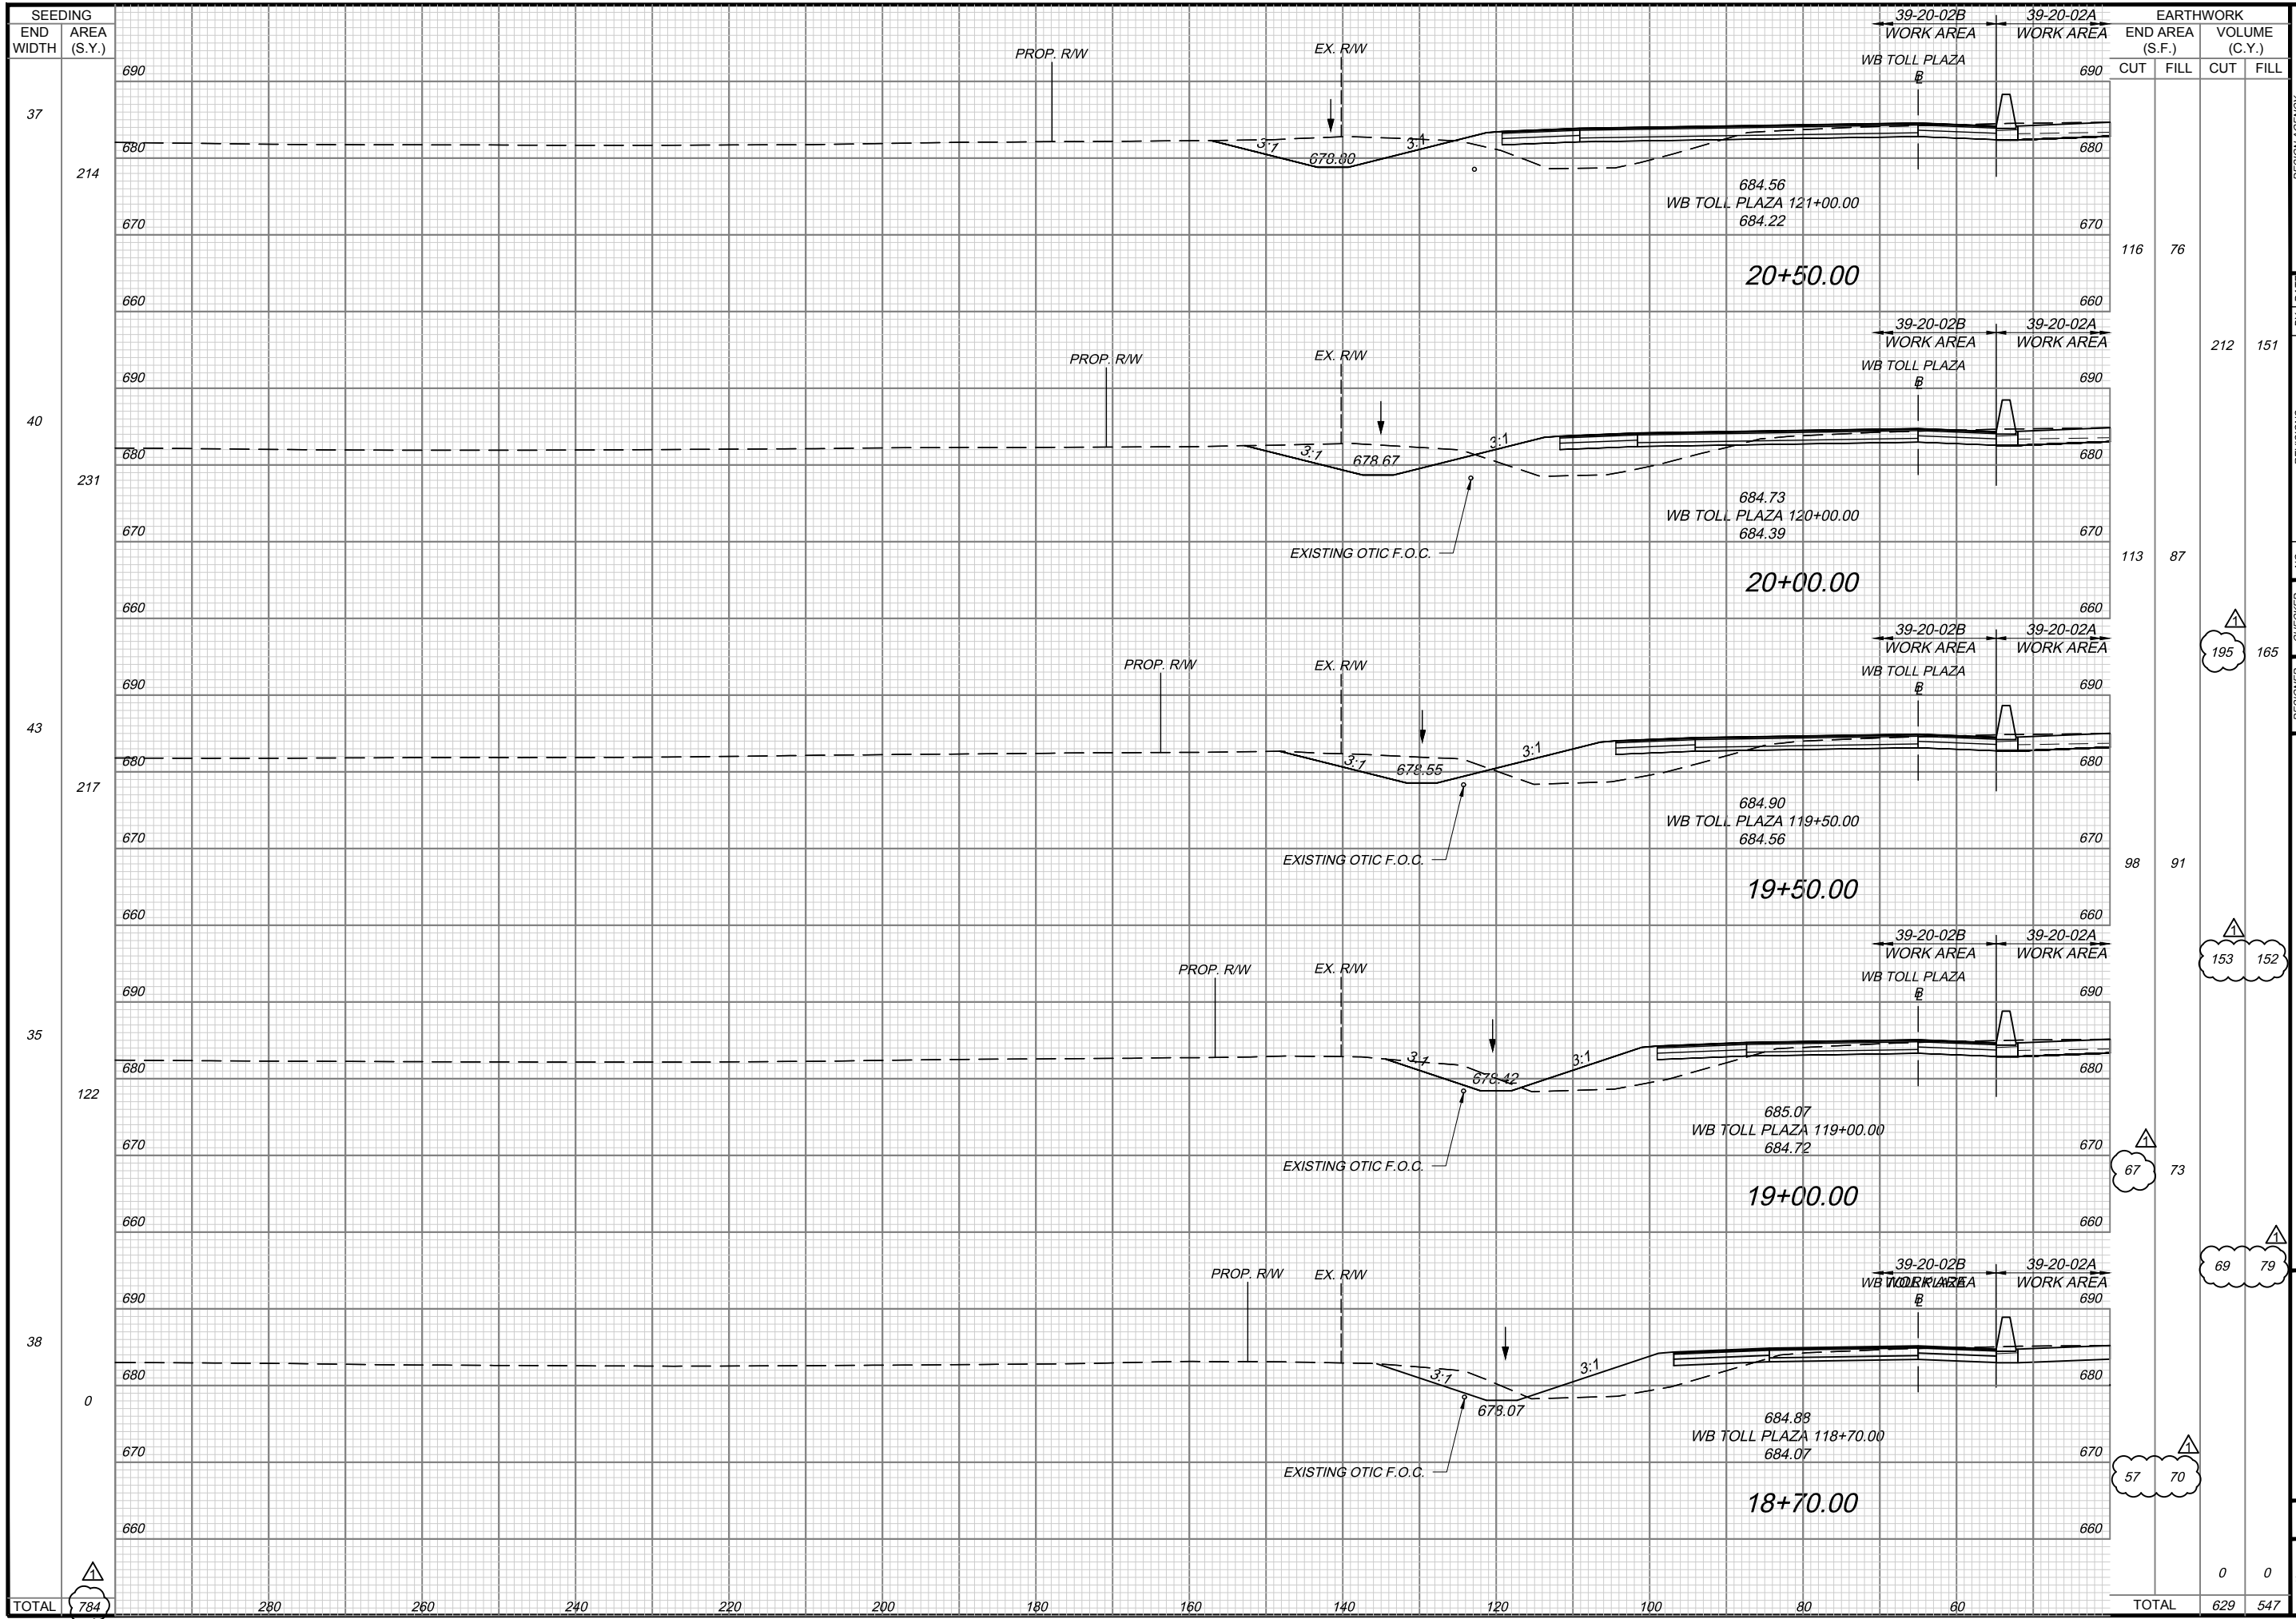


SEEDING	END WIDTH	AREA (S.Y.)	EARTHWORK			
			CUT	FILL	CUT	FILL
37	690	214				
40	690	231				
43	690	217				
35	690	122				
38	690	0				
TOTAL	784		0	0	629	547

DESIGN AGENCY: **JACOBS**
 PROJECT: 39-20-02B
 DATE: 12/20/2019
 WESTBOUND TOLL PLAZA CROSS SECTIONS
 STA. 18+70 TO STA. 20+50
 LUCAS COUNTY
 TP 49
 1/7
 37/59

CHECKING PRINT

CHECKED: _____ DATE: _____
 BACKCHECKED: _____ DATE: _____
 CORRECTED: _____ DATE: _____
 APPROVED: _____ DATE: _____

nnnnXS02.dwg; 1/16/20 - 1:35pm

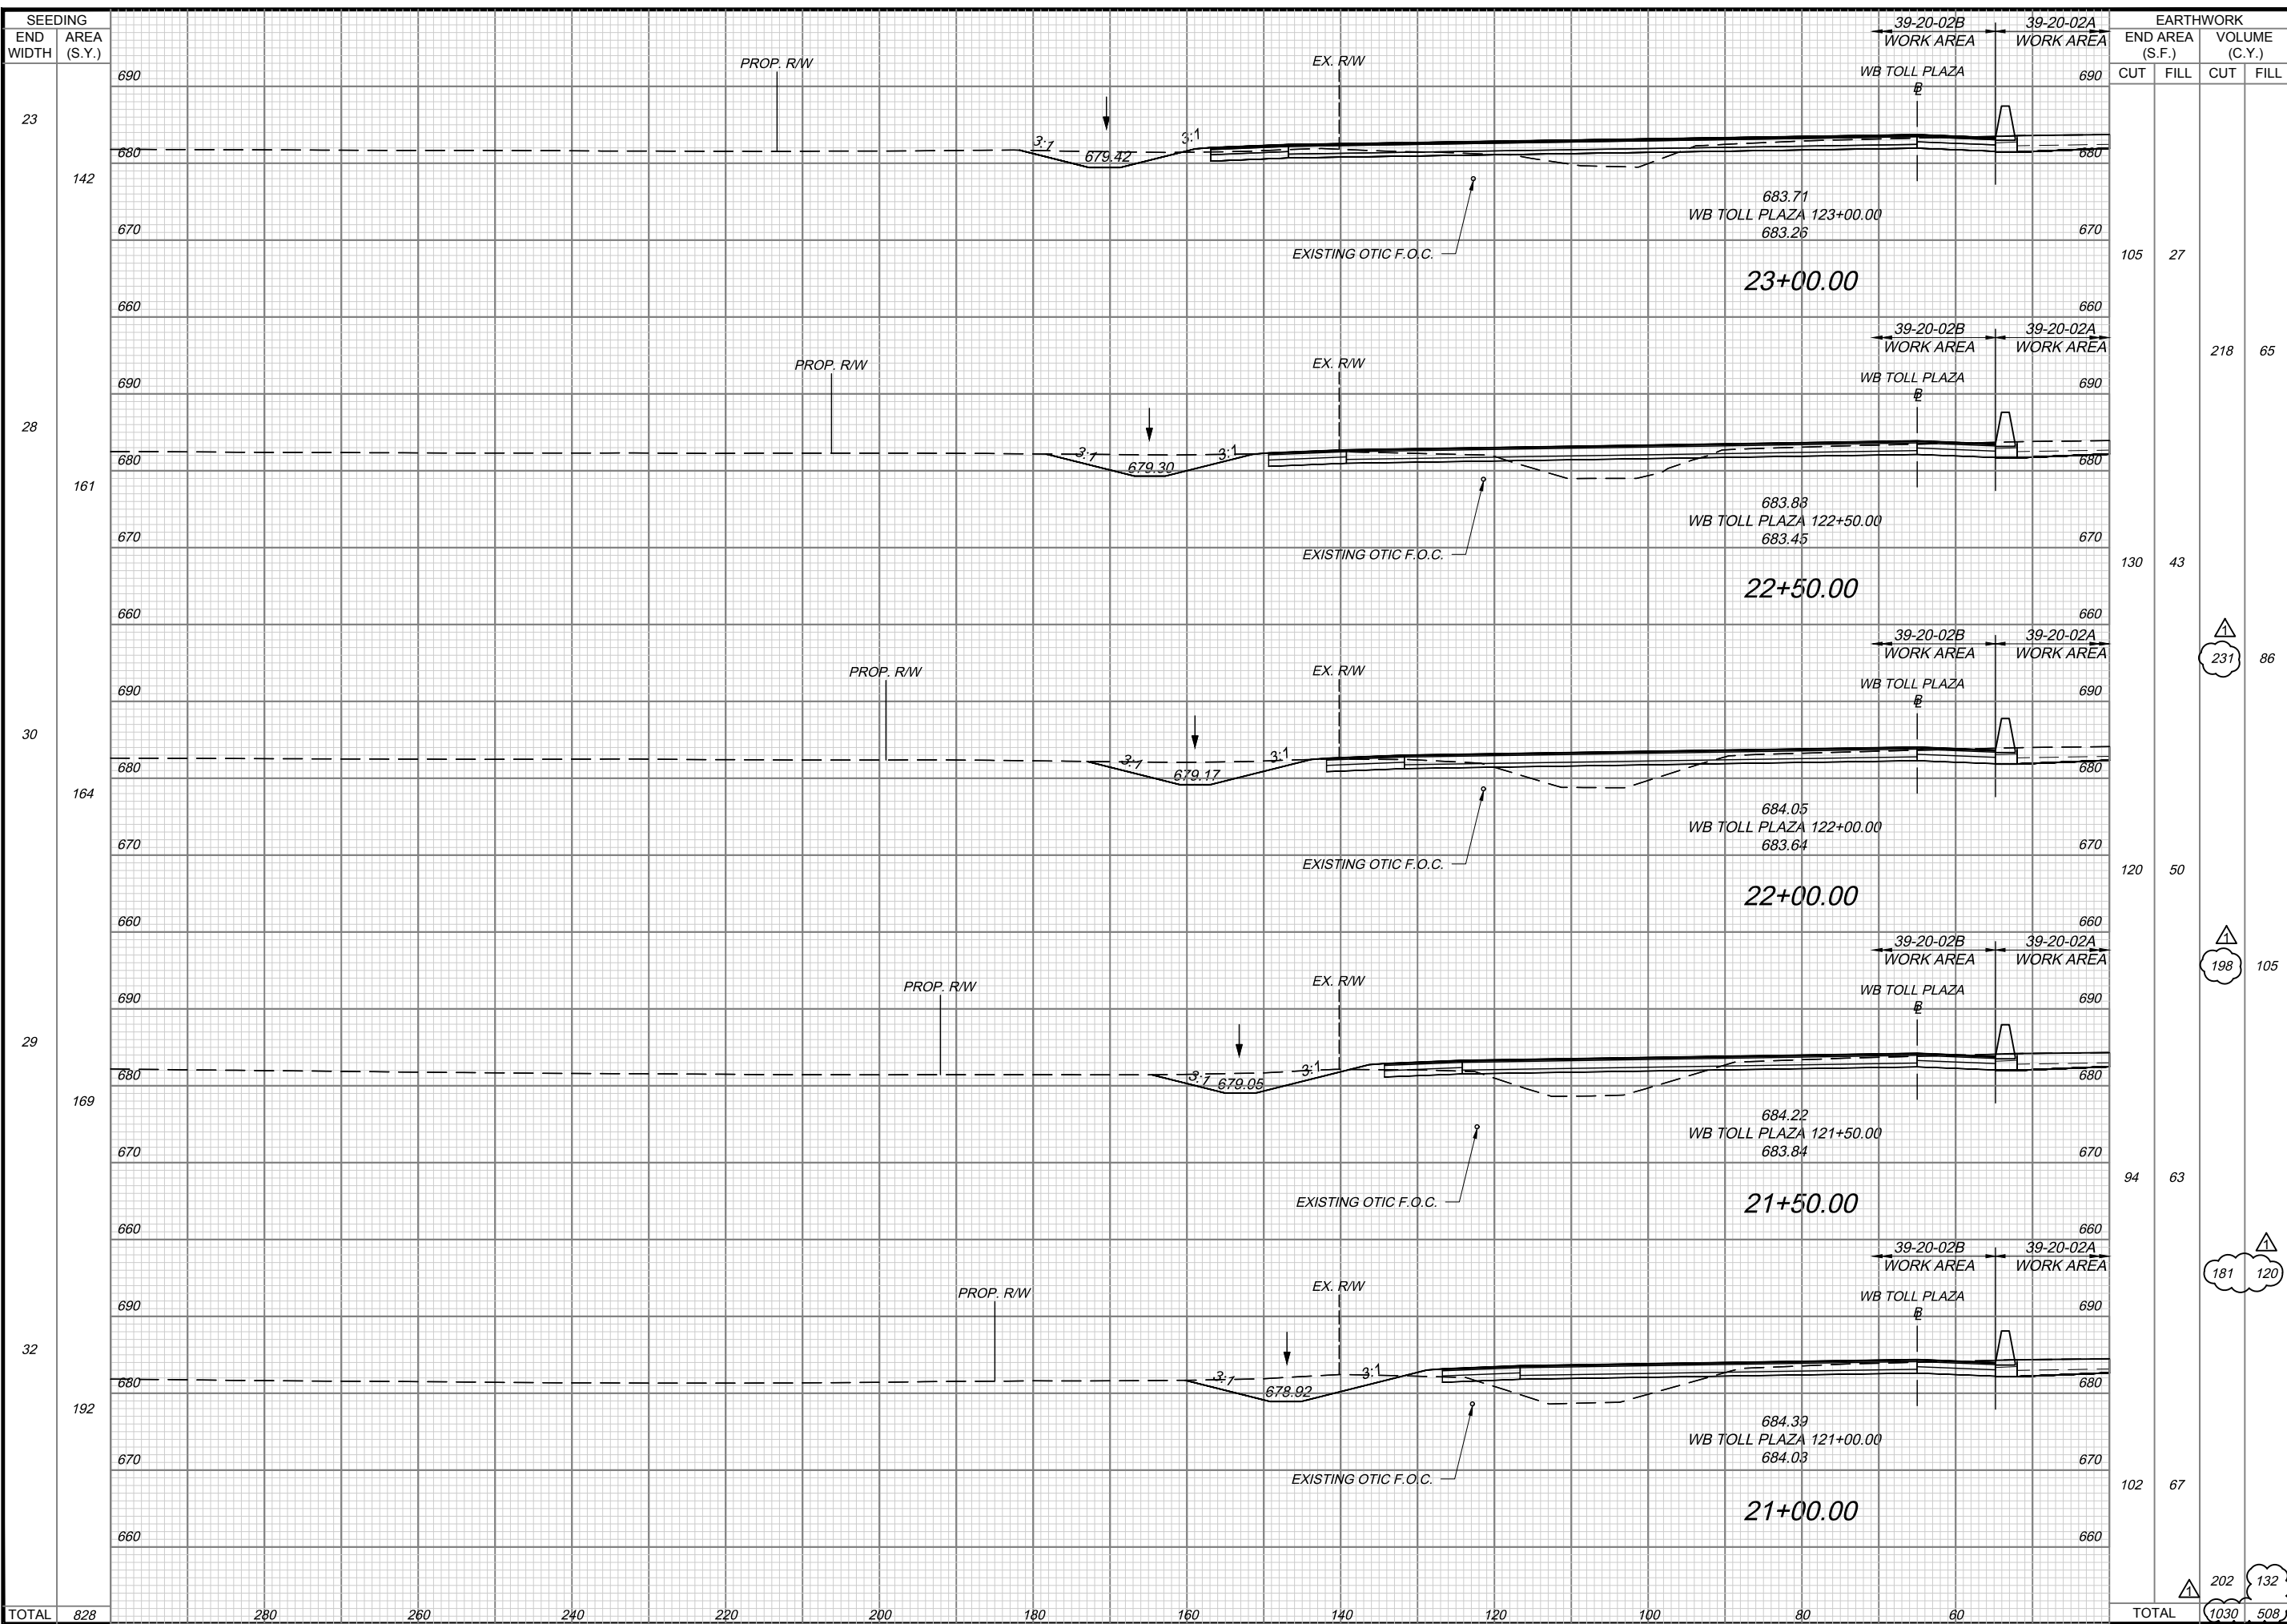

SEEDING END WIDTH	AREA (S.Y.)	EARTHWORK			
		END AREA (S.F.)	VOLUME (C.Y.)	CUT	FILL
23	142	690	690	105	27
28	161	690	690	130	43
30	164	690	690	120	50
29	169	690	690	94	63
32	192	690	690	102	67
TOTAL	828	280	260	202	132

DESIGN AGENCY: **JACOBS**
 1231 JAMES ARNOLD BLVD
 OFFICE #132322

NO.	BY	DATE
1	AMS	11/15/20

REVISIONS: ADDENDUM NO. 2

DESIGNED	CHECKED	NO.
AMS	AMS	1

PROJECT: **39-20-02B**
 DATE: 12/20/2019
 TP 49

OHIO TURNPIKE AND INFRASTRUCTURE COMMISSION


WESTBOUND TOLL PLAZA CROSS SECTIONS
 STA. 21+00 TO STA. 23+00
 LUCAS COUNTY

2 / 7
 38
 59

CHECKING PRINT

CHECKED: _____ DATE: _____
 BACKCHECKED: _____ DATE: _____
 CORRECTED: _____ DATE: _____
 APPROVED: _____ DATE: _____

nnnnXS02.dwg; 1/16/20 - 1:35pm

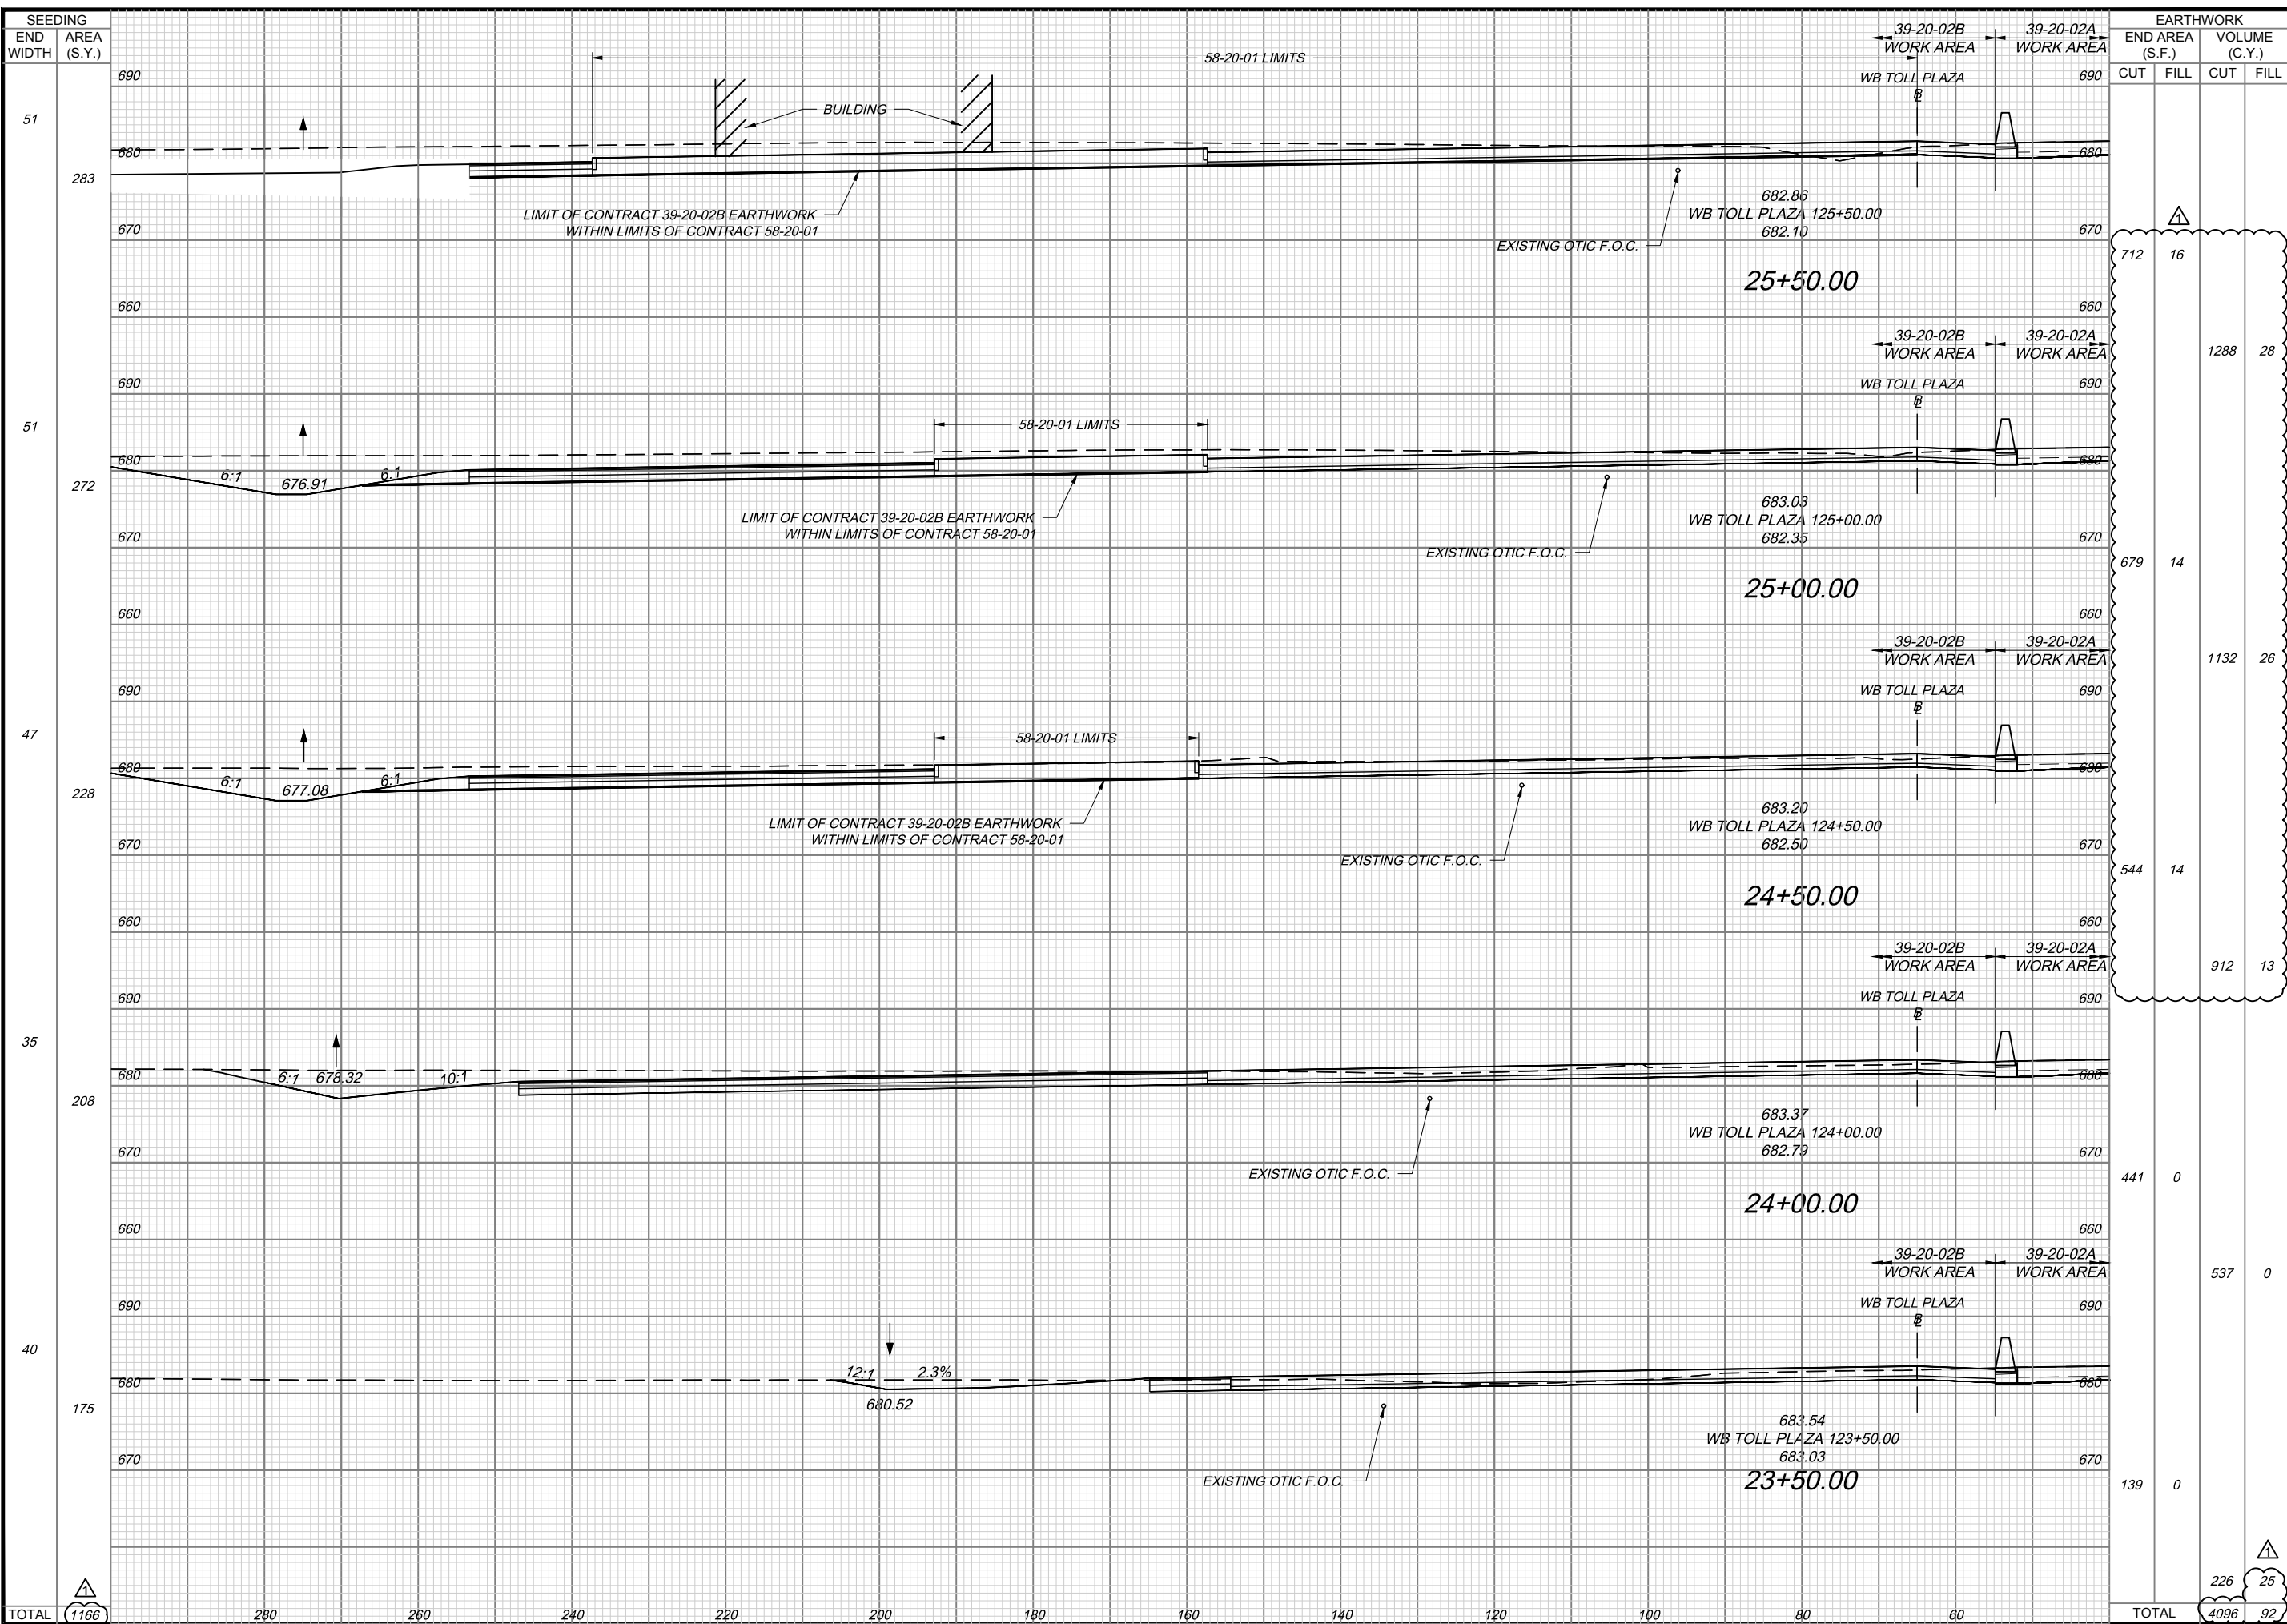


SEEDING		EARTHWORK	
END WIDTH	AREA (S.Y.)	END AREA (S.F.)	VOLUME (C.Y.)
		CUT	FILL
51	283	712	16
51	272	679	14
47	228	544	14
35	208	441	0
40	175	139	0
TOTAL	(1166)	226	25
		4096	92

DESIGN AGENCY: **JACOBS**
 PROJECT: **39-20-02B**
 DATE: **12/20/2019**
 WESTBOUND TOLL PLAZA CROSS SECTIONS
 STA. 23+50 TO STA. 25+50
 LUCAS COUNTY
 TP 49
 REVISIONS: 1
 ADDENDUM NO. 2
 CHECKED BY: AMS
 DESIGNED BY: AMS
 DRAWN BY: AMS
 IN CHARGE: CSM

CHECKING PRINT

CHECKED: DATE: CORRECTED: DATE: BACKCHECKED: DATE: APPROVED: DATE:


nnnnnXS02.dwg; 1/16/20 - 1:35pm

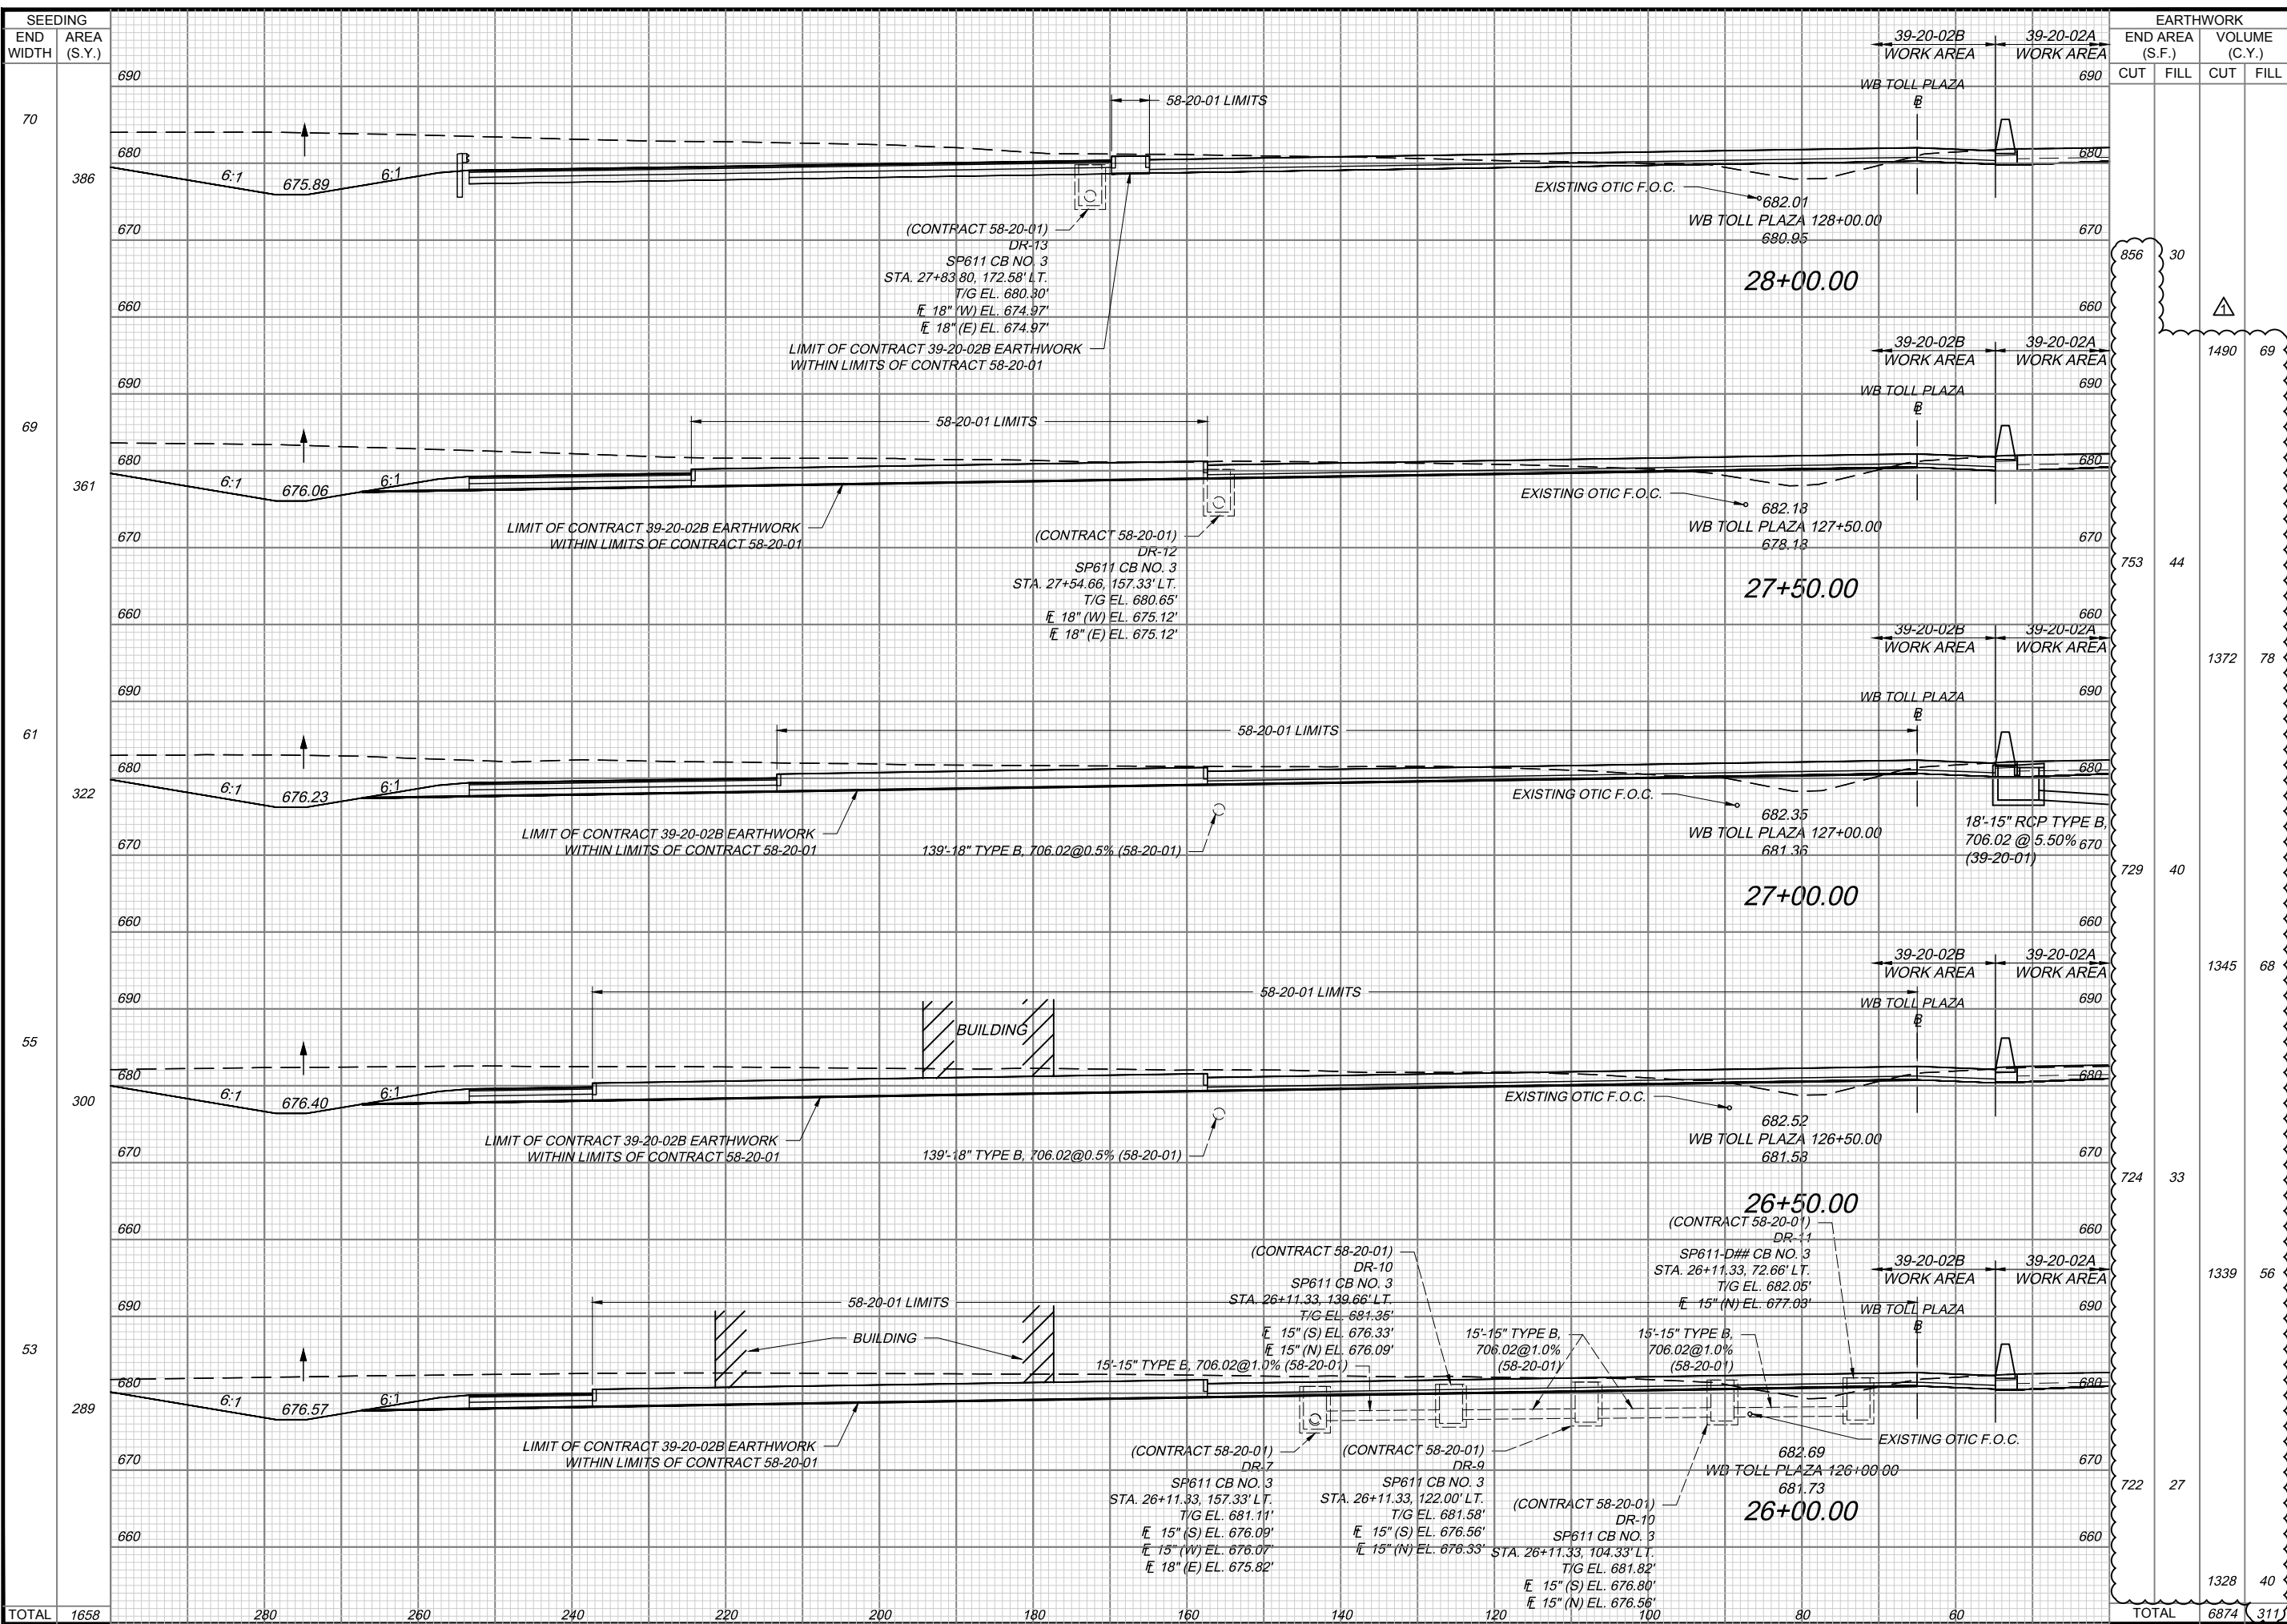

SEEDING		EARTHWORK	
END WIDTH	AREA (S.Y.)	END AREA (S.F.)	VOLUME (C.Y.)
		CUT	FILL
690			
70			
386			
670			
660			
690			
69			
361			
670			
660			
690			
61			
322			
670			
660			
690			
55			
300			
670			
660			
690			
53			
289			
670			
660			
TOTAL	1658		
	280		
	260		
	240		
	220		
	200		
	180		
	160		
	140		
	120		
	80		
	60		
TOTAL		6874	311

DESIGN AGENCY: **JACOBS**
 PROJECT: WESTBOUND TOLL PLAZA CROSS SECTIONS
 STA. 26+00 TO STA. 28+00
 LUCAS COUNTY
 DATE: 12/20/2019
 TP 49
 4 / 7
 40
 59

CHECKING PRINT
CHECKED: _____ DATE: _____
CORRECTED: _____ DATE: _____
BACKCHECKED: _____ DATE: _____
APPROVED: _____ DATE: _____

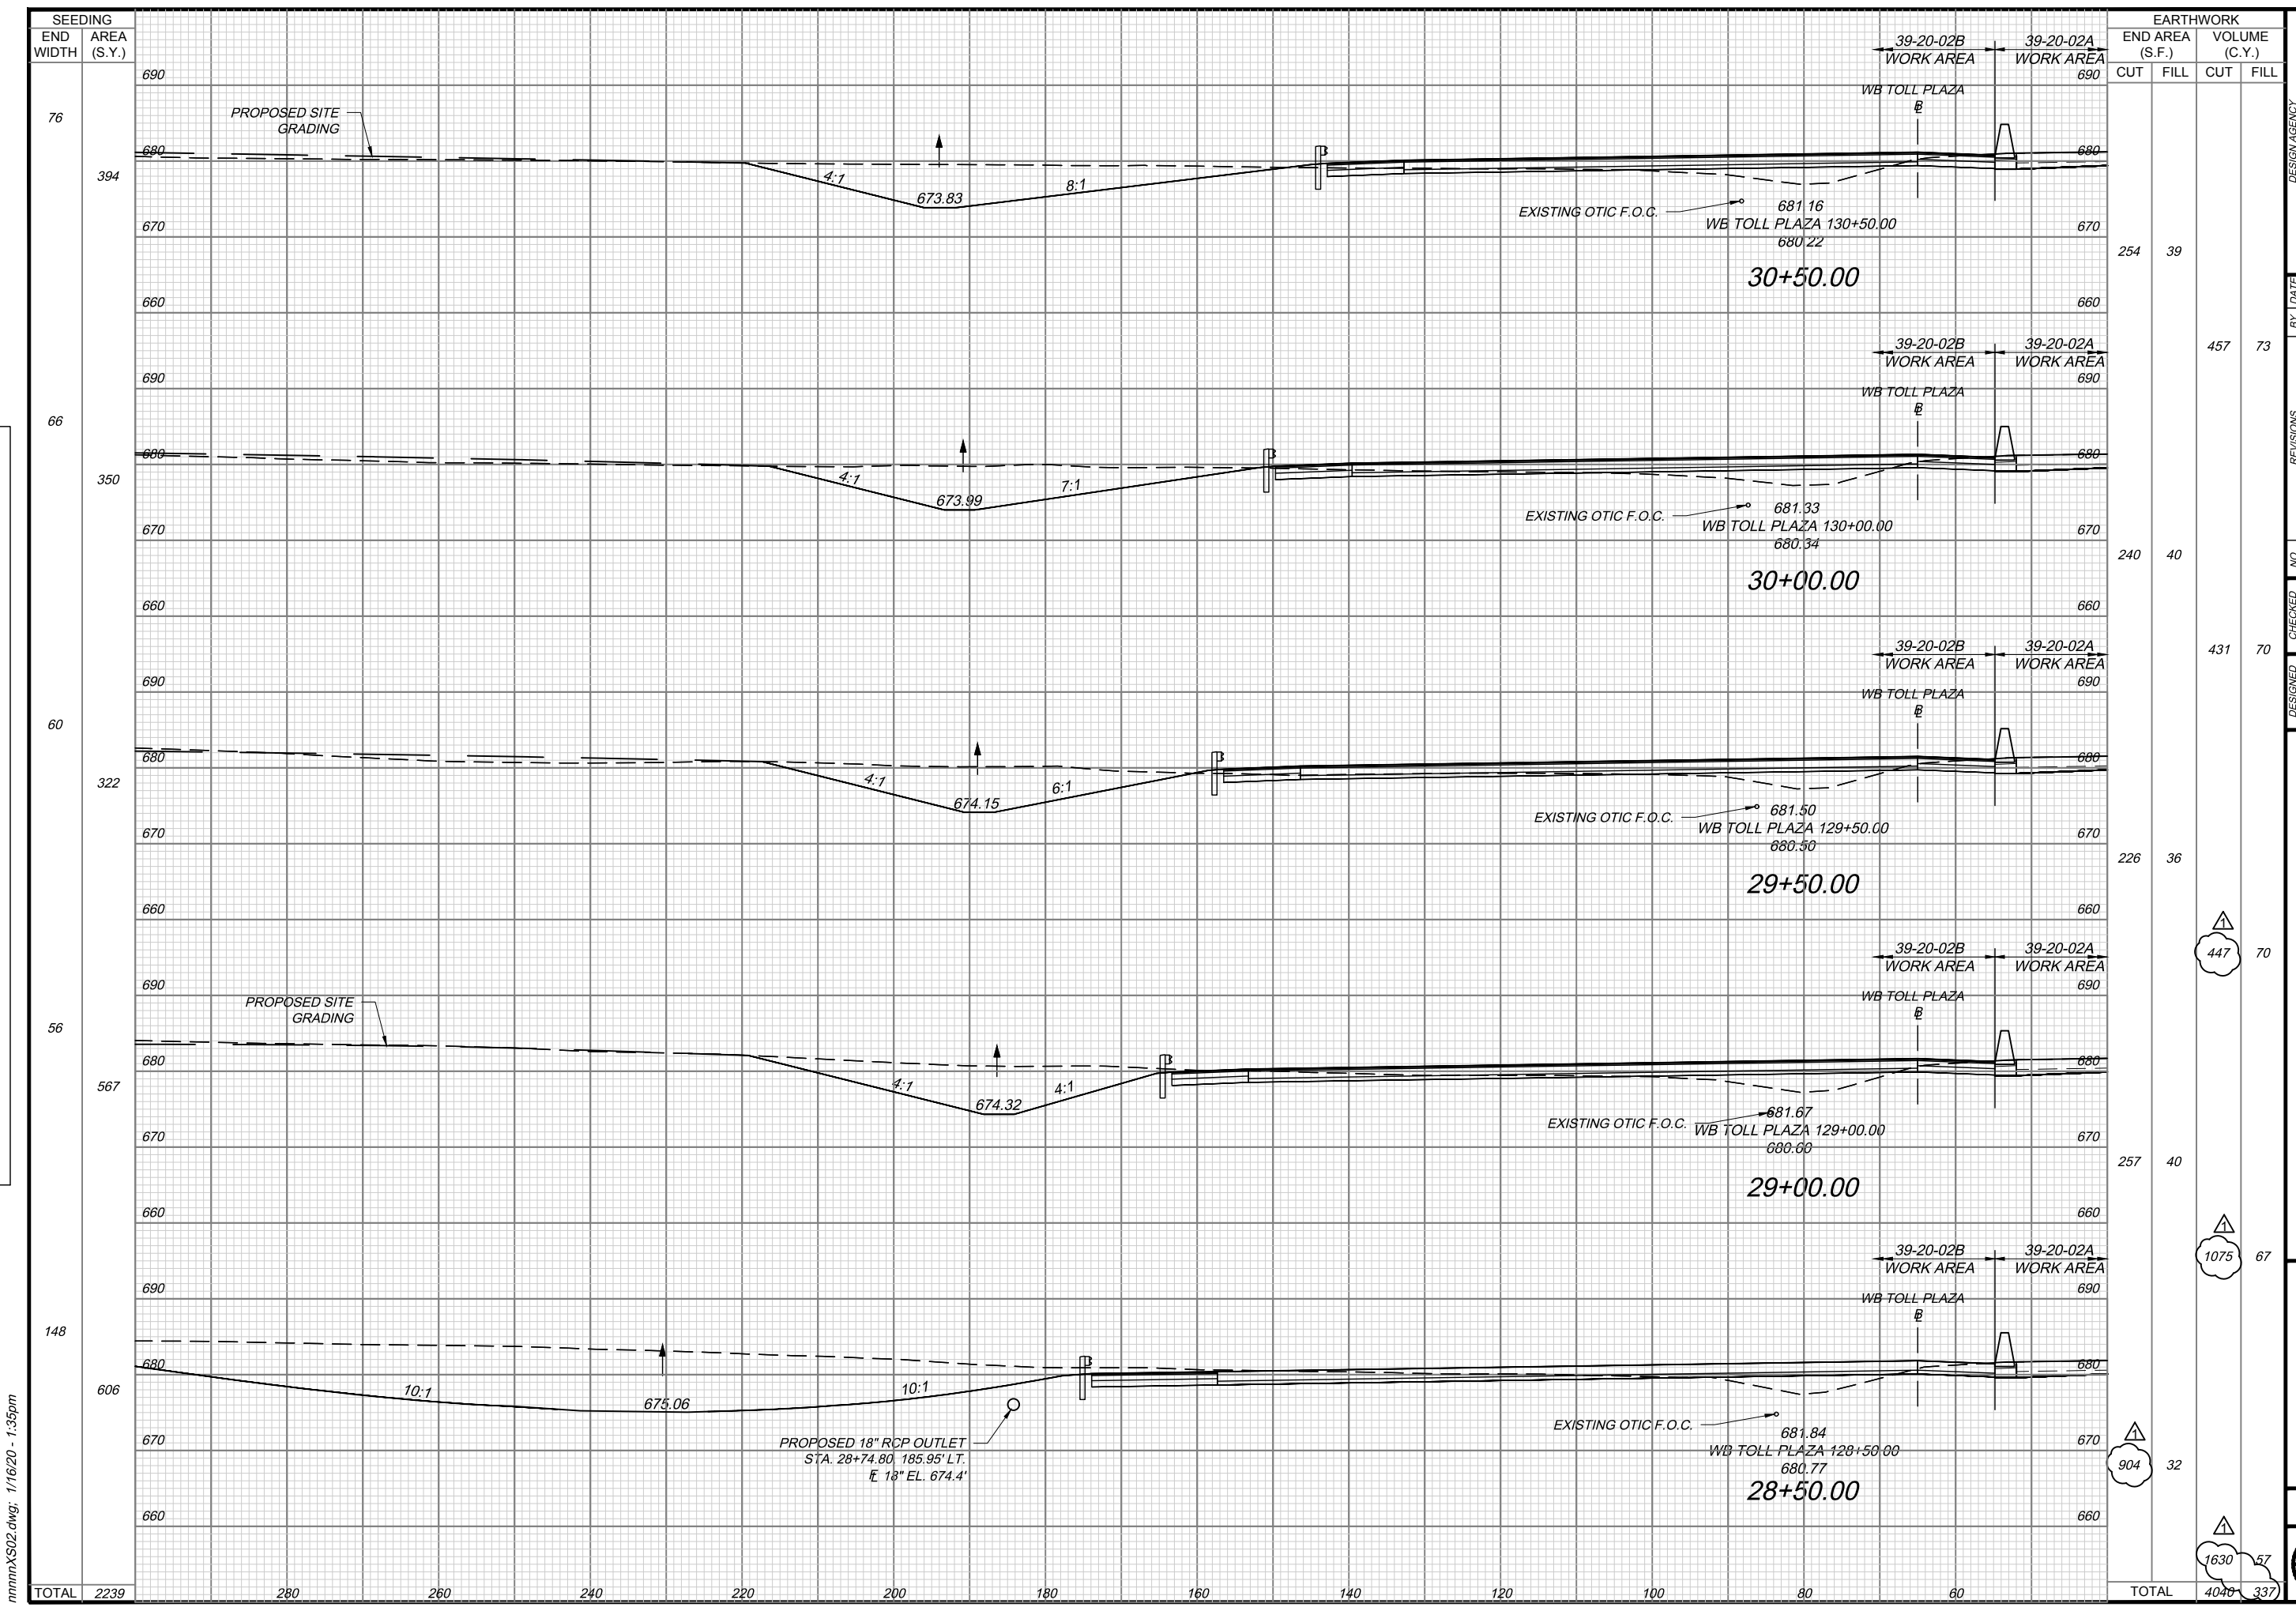

nnnnnXS02.dwg; 1/16/20 - 1:35pm

SEEDING		EARTHWORK	
END WIDTH	AREA (S.Y.)	END AREA (S.F.)	VOLUME (C.Y.)
CUT	FILL	CUT	FILL
	690		
76	394	254	39
	670		
	660		
66	350	240	40
	690		
	670		
	660		
60	322	226	36
	690		
	670		
	660		
56	567	257	40
	690		
	670		
	660		
148	606	904	32
	670		
	660		
TOTAL	2239	4048	337


447
1075
904
1630
57

DESIGN AGENCY: **JACOBS**
BY DATE: AMS 11/15/20
REVISIONS: ADDENDUM NO. 2
NO. 1
CHECKED: AMS
DESIGNED: AMS
DRAWN: AMS
WESTBOUND TOLL PLAZA CROSS SECTIONS
STA. 28+50 TO STA. 30+50
LUCAS COUNTY
PROJECT 39-20-02B
DATE: 12/20/2019
TP 49
5/7
41
59
OHIO TURNPIKE AND INFRASTRUCTURE COMMISSION

CHECKING PRINT

CHECKED: _____ DATE: _____
 BACKCHECKED: _____ DATE: _____
 CORRECTED: _____ DATE: _____
 APPROVED: _____ DATE: _____

nnnnXS02.dwg; 1/16/20 - 1:35pm

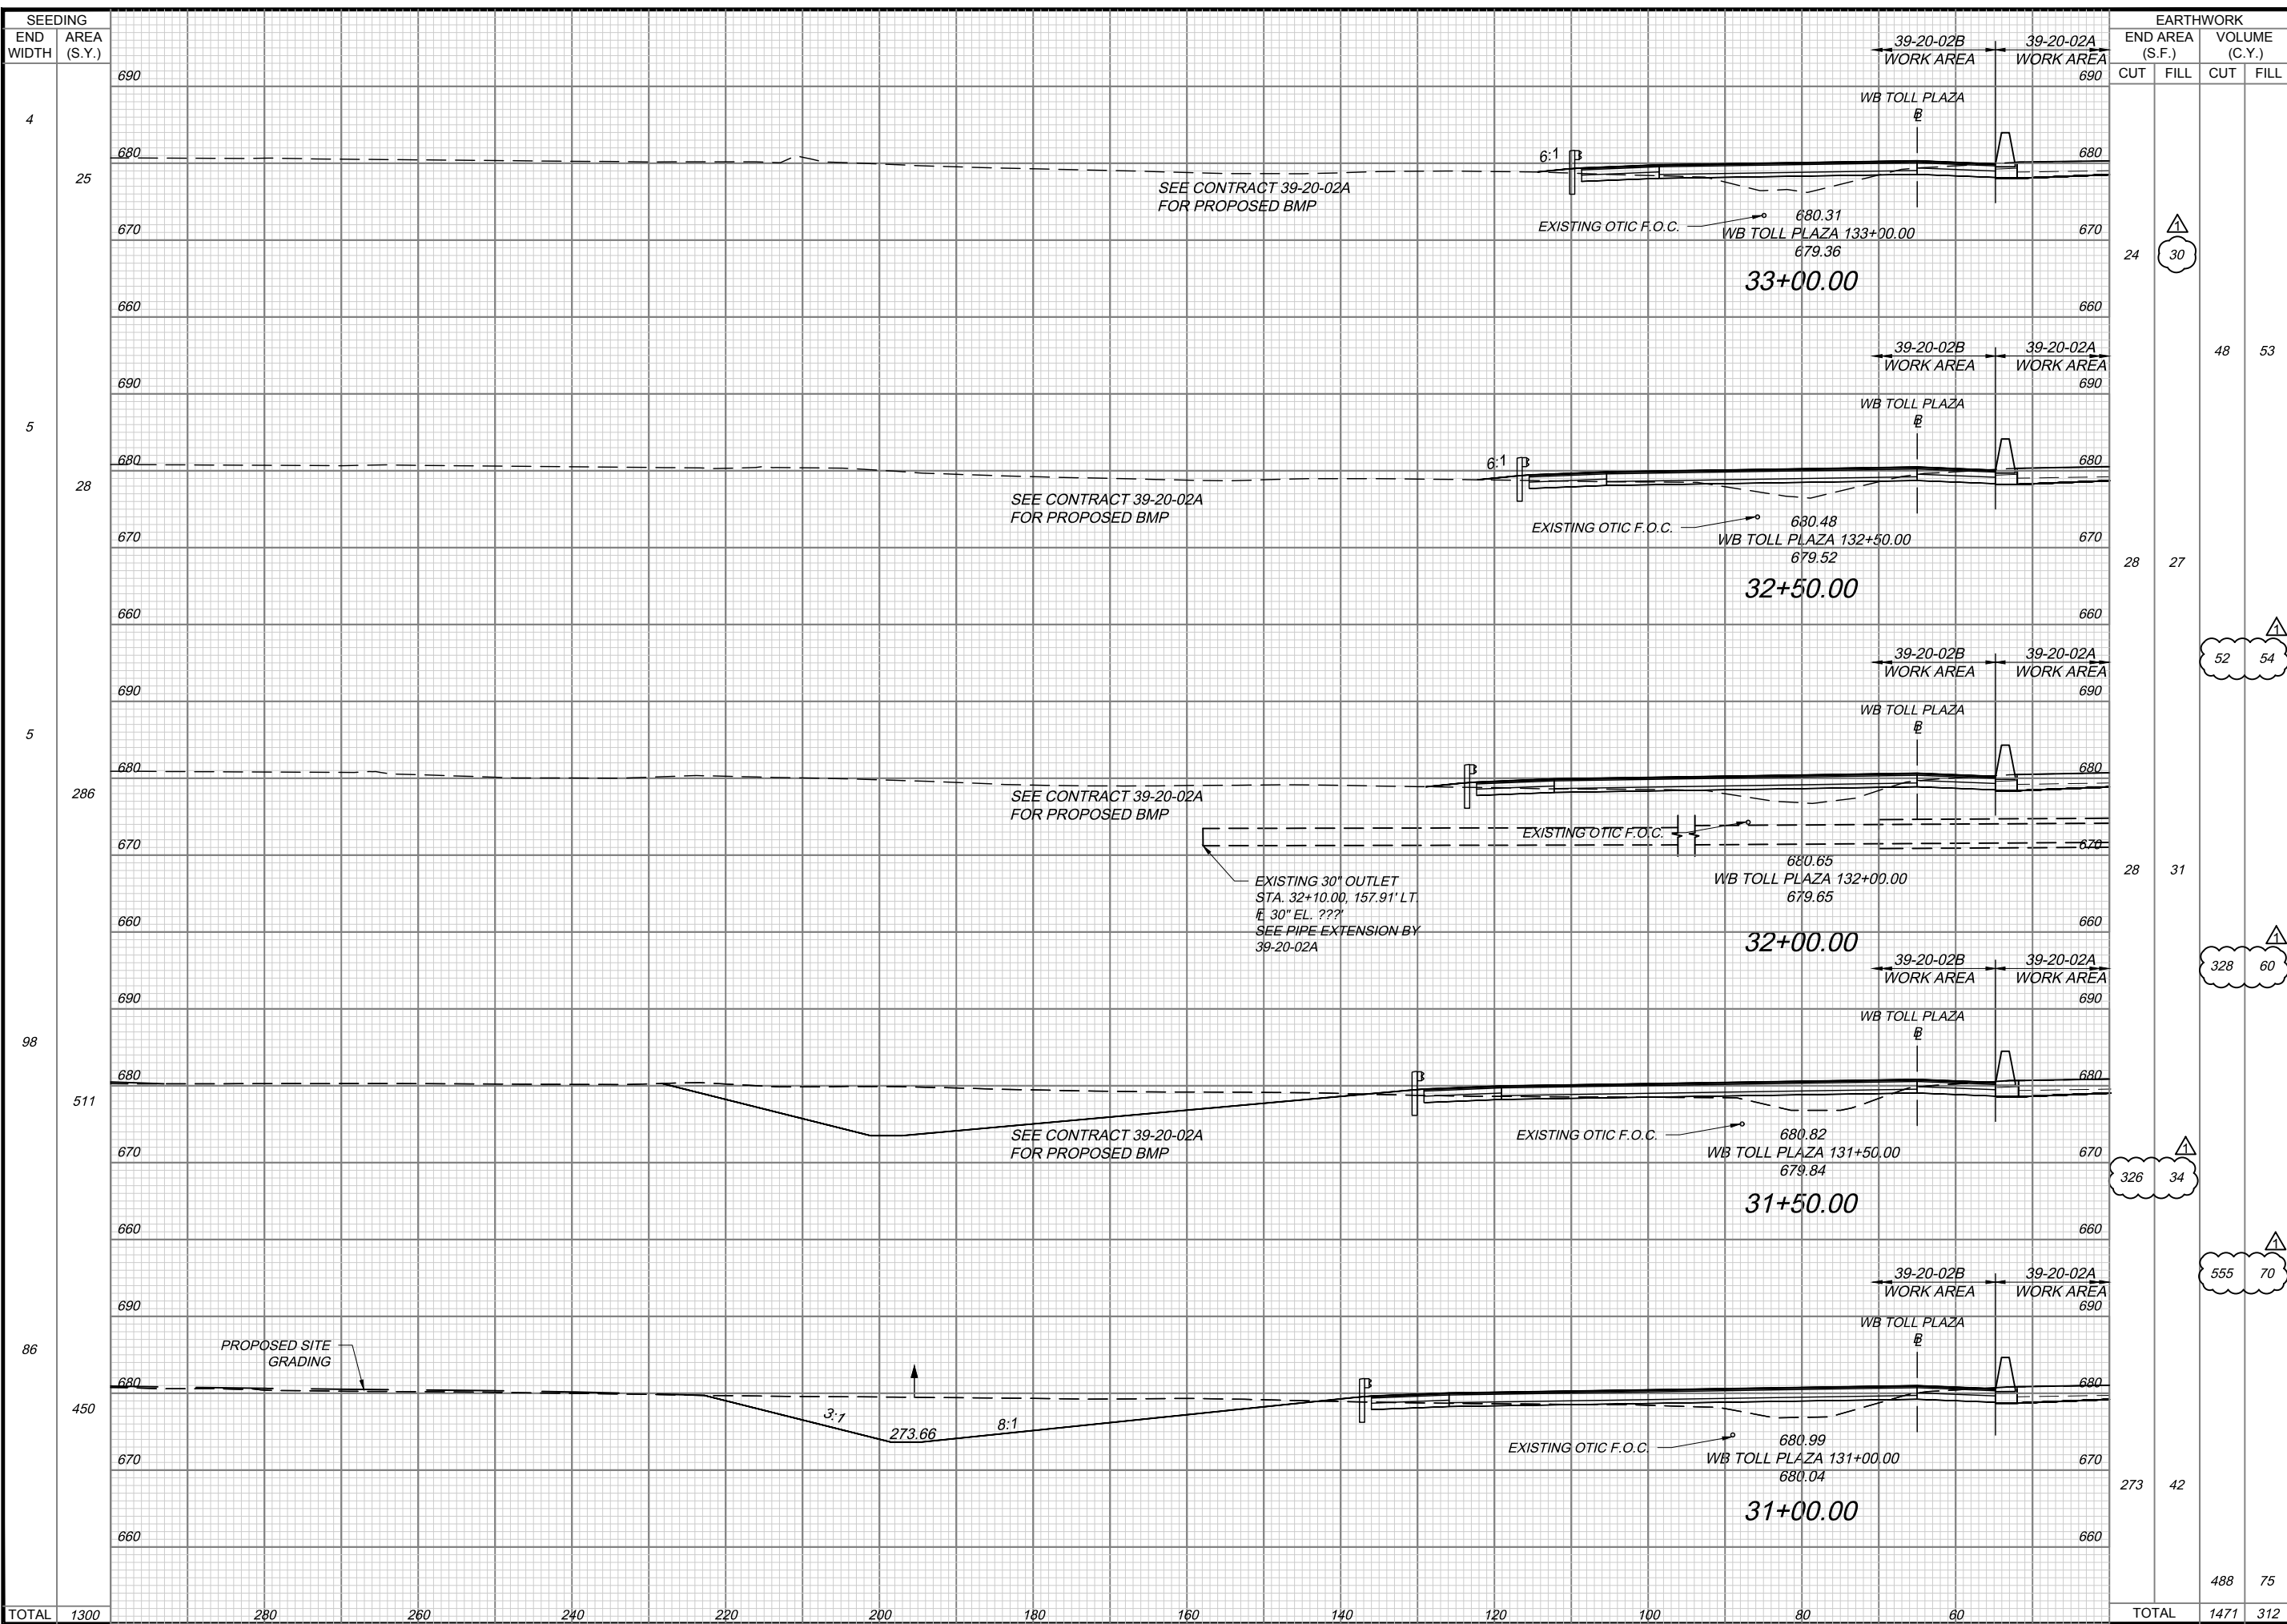


SEEDING		EARTHWORK	
END WIDTH	AREA (S.Y.)	END AREA (S.F.)	VOLUME (C.Y.)
		CUT	FILL
4	690		
25	680		
670	670		
660	660		
5	690		
28	680		
670	670		
660	660		
5	690		
286	680		
670	670		
660	660		
98	690		
511	680		
670	670		
660	660		
86	690		
450	680		
670	670		
660	660		
TOTAL	1300	280	260
		240	220
		200	180
		160	140
		120	100
		80	60
		TOTAL	1471
			312

DESIGN AGENCY: **JACOBS**
 PROJECT: **39-20-02B**
 DATE: **12/20/2019**
 WESTBOUND TOLL PLAZA CROSS SECTIONS
 STA. 31+00 TO STA. 33+00
 LUCAS COUNTY
 TP 49
 REVISIONS: 1
 ADDENDUM NO. 2
 BY DATE: AMS 1/15/20
 CHECKED: AMS
 DESIGNED: AMS
 DRAWN: AMS
 IN CHARGE: CSM

CHECKING PRINT

CHECKED: _____ DATE: _____ CORRECTED: _____ DATE: _____
BACKCHECKED: _____ DATE: _____ APPROVED: _____ DATE: _____

nnnmnXS02.dwg 1/16/20 - 1:36pm

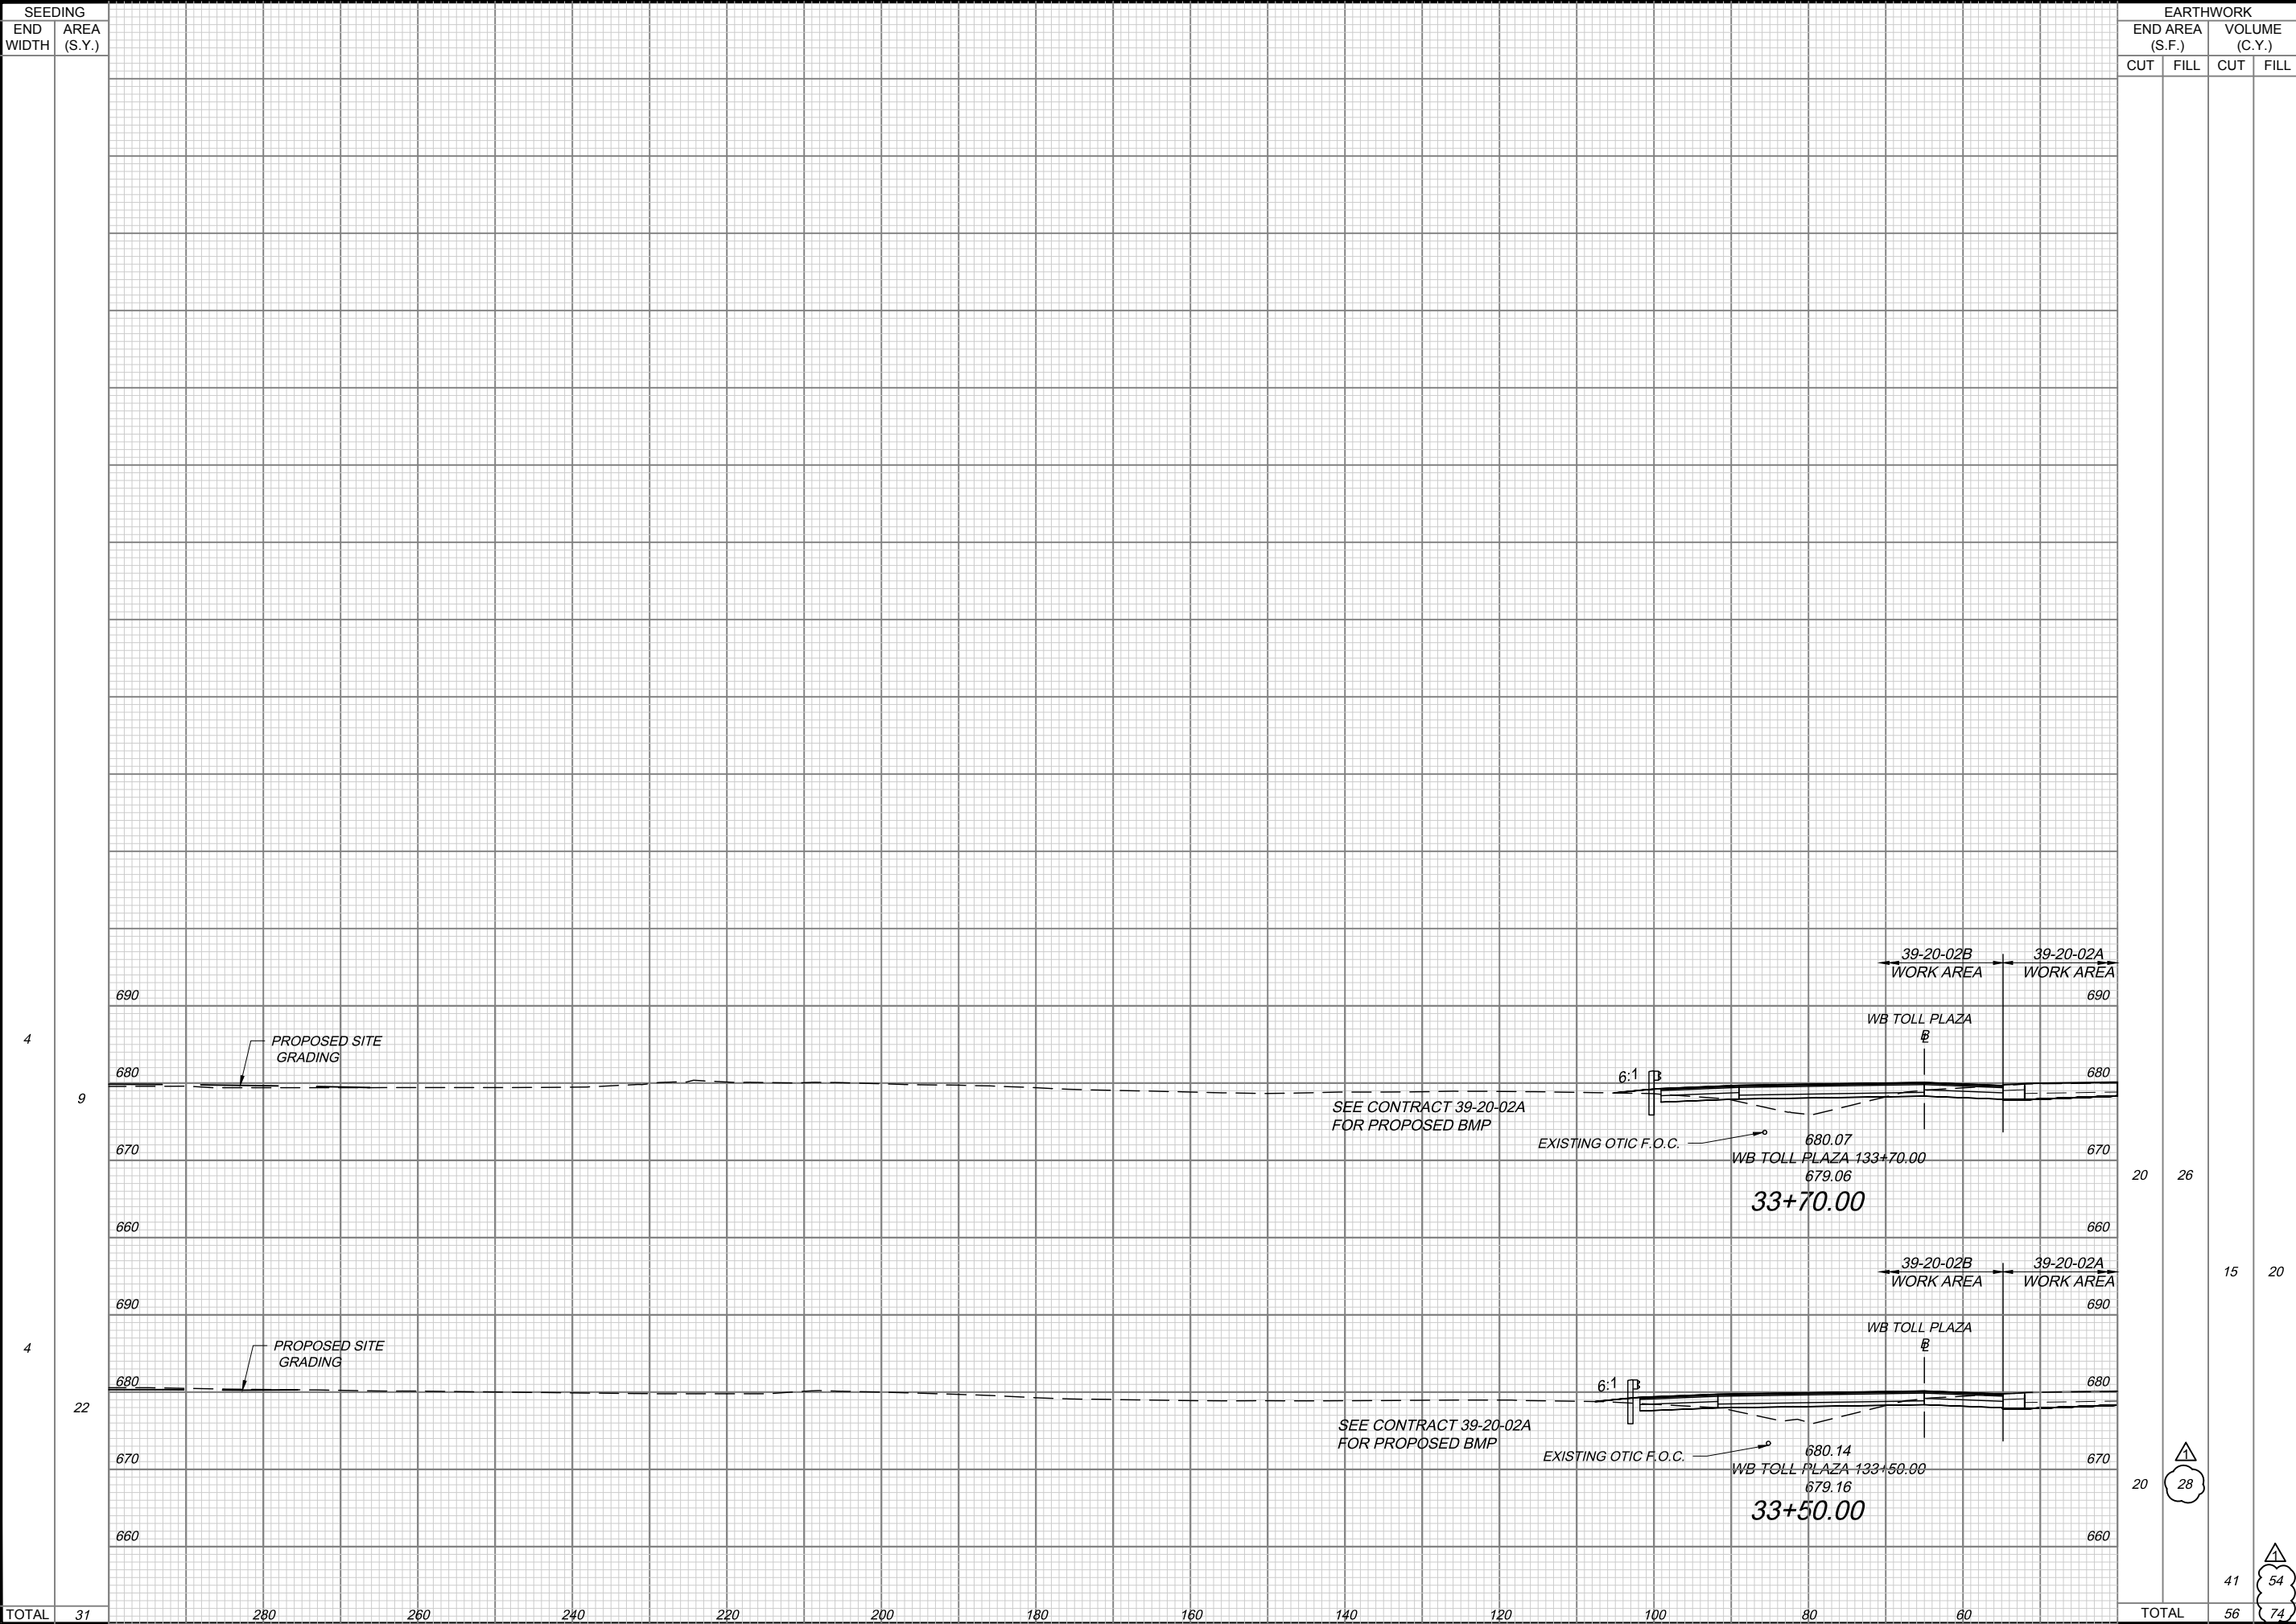

SEEDING		EARTHWORK			
END WIDTH	AREA (S.Y.)	END AREA (S.F.)		VOLUME (C.Y.)	
		CUT	FILL	CUT	FILL
4					
9					
4					
22					
TOTAL	31			20	26
	280			15	20
	260				
	240				
	220				
	200				
	180				
	160				
	140				
	120				
	100				
	80				
	60				
TOTAL				41	54

DESIGNED	AMS AMS	CHECKED	AMS AMS	NO.	1	BY DATE	AMS 11/15/20
REVISIONS	ADDENDUM NO. 2		BY DATE		AMS		

PROJECT 39-20-02B DATE: 12/20/2019 TP 49

WESTBOUND TOLL PLAZA CROSS SECTIONS STA. 33+50 TO STA. 33+70.00 LUCAS COUNTY

DESIGN AGENCY

1231 JAMES AVENUE # FLOOR
OFFICE #133-222


43
59
54
74

OHIO TURNPIKE AND INFRASTRUCTURE COMMISSION

CHECKING PRINT

CHECKED: _____ DATE: _____ CORRECTED: _____ DATE: _____
 BACKCHECKED: _____ DATE: _____ APPROVED: _____ DATE: _____

nnnnXS03.dwg; 1/16/20 - 1:36pm

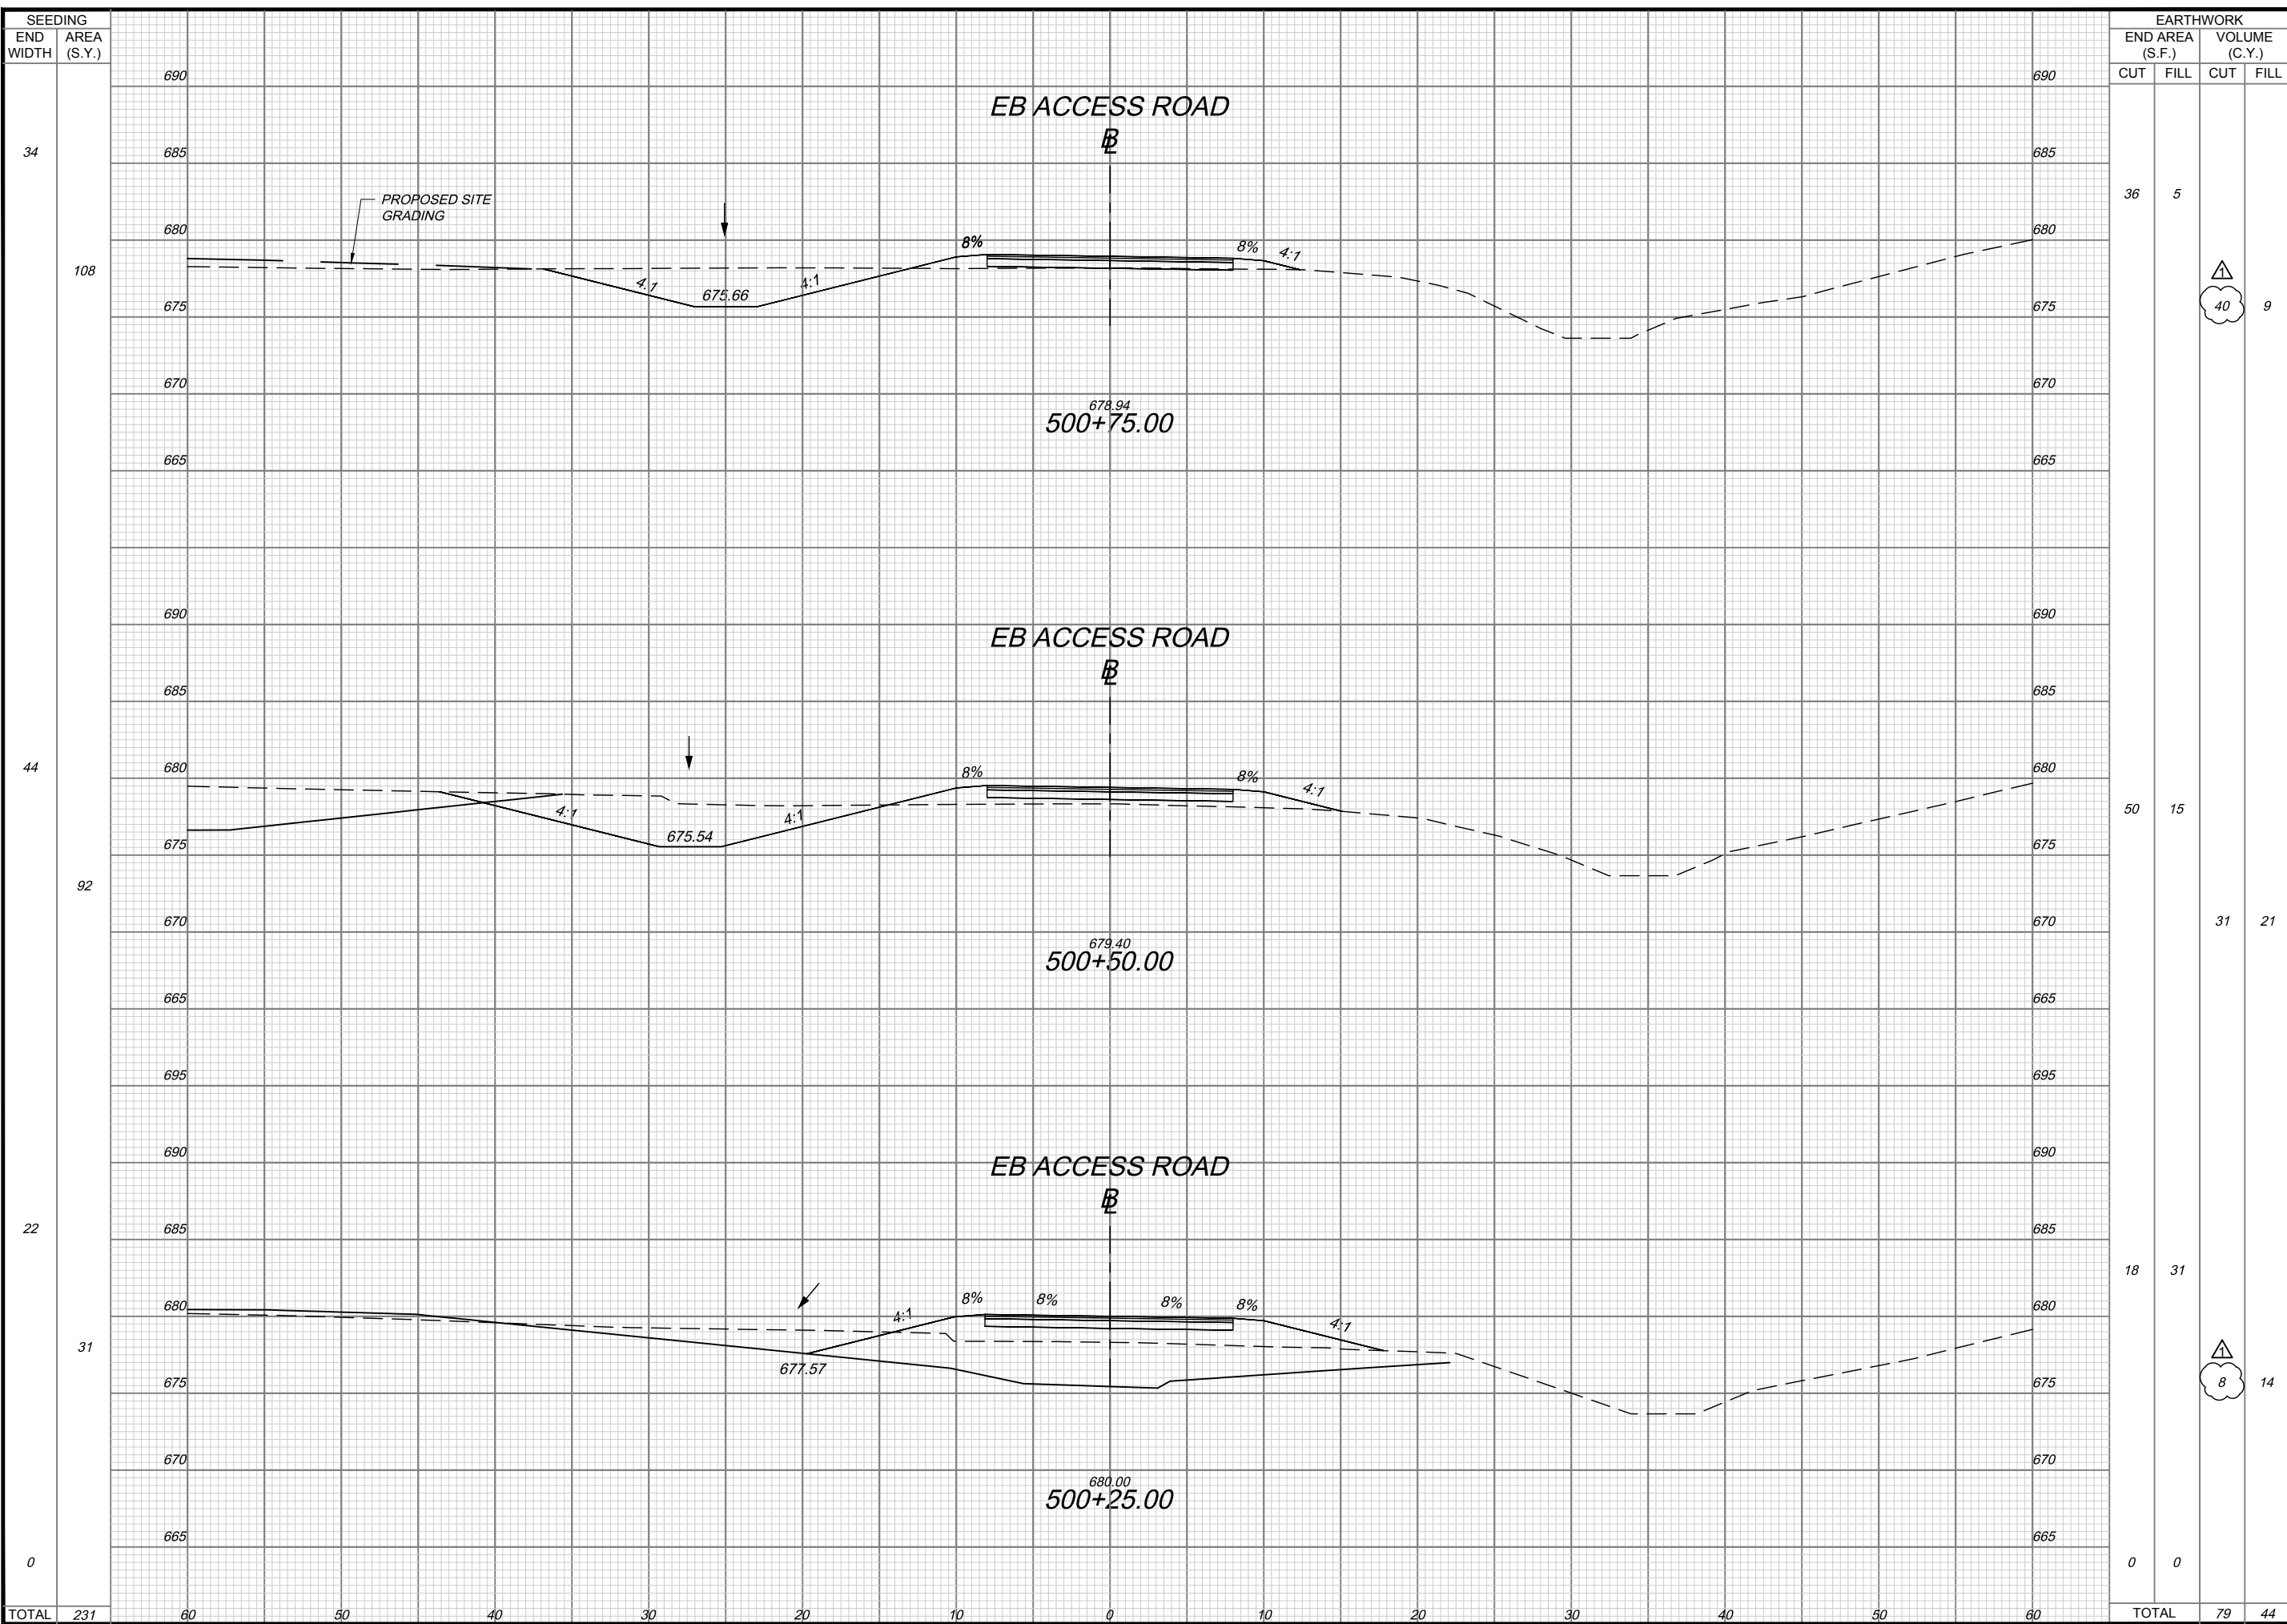

TOTAL	231	60	50	40	30	20	10	0	10	20	30	40	50	60
-------	-----	----	----	----	----	----	----	---	----	----	----	----	----	----


SEEDING		EARTHWORK			
END WIDTH	AREA (S.Y.)	END AREA (S.F.)		VOLUME (C.Y.)	
		CUT	FILL	CUT	FILL
34	108	36	5	9	9
44	92	50	15	31	21
22	31	18	31	8	14
0	0	0	0	0	0
TOTAL	231	104	51	79	44

DESIGN AGENCY: **JACOBS**
 PROJECT: 39-20-02B
 DATE: 12/20/2019
 EASTBOUND ACCESS ROAD CROSS SECTIONS
 STA. 500+25 TO STA. 500+75
 LUCAS COUNTY
 TP 49
 1/4
 44
 59

CHECKING PRINT

CHECKED: _____ DATE: _____ CORRECTED: _____ DATE: _____
 BACKCHECKED: _____ DATE: _____ APPROVED: _____ DATE: _____

nnnnXS03.dwg; 1/16/20 - 1:36pm

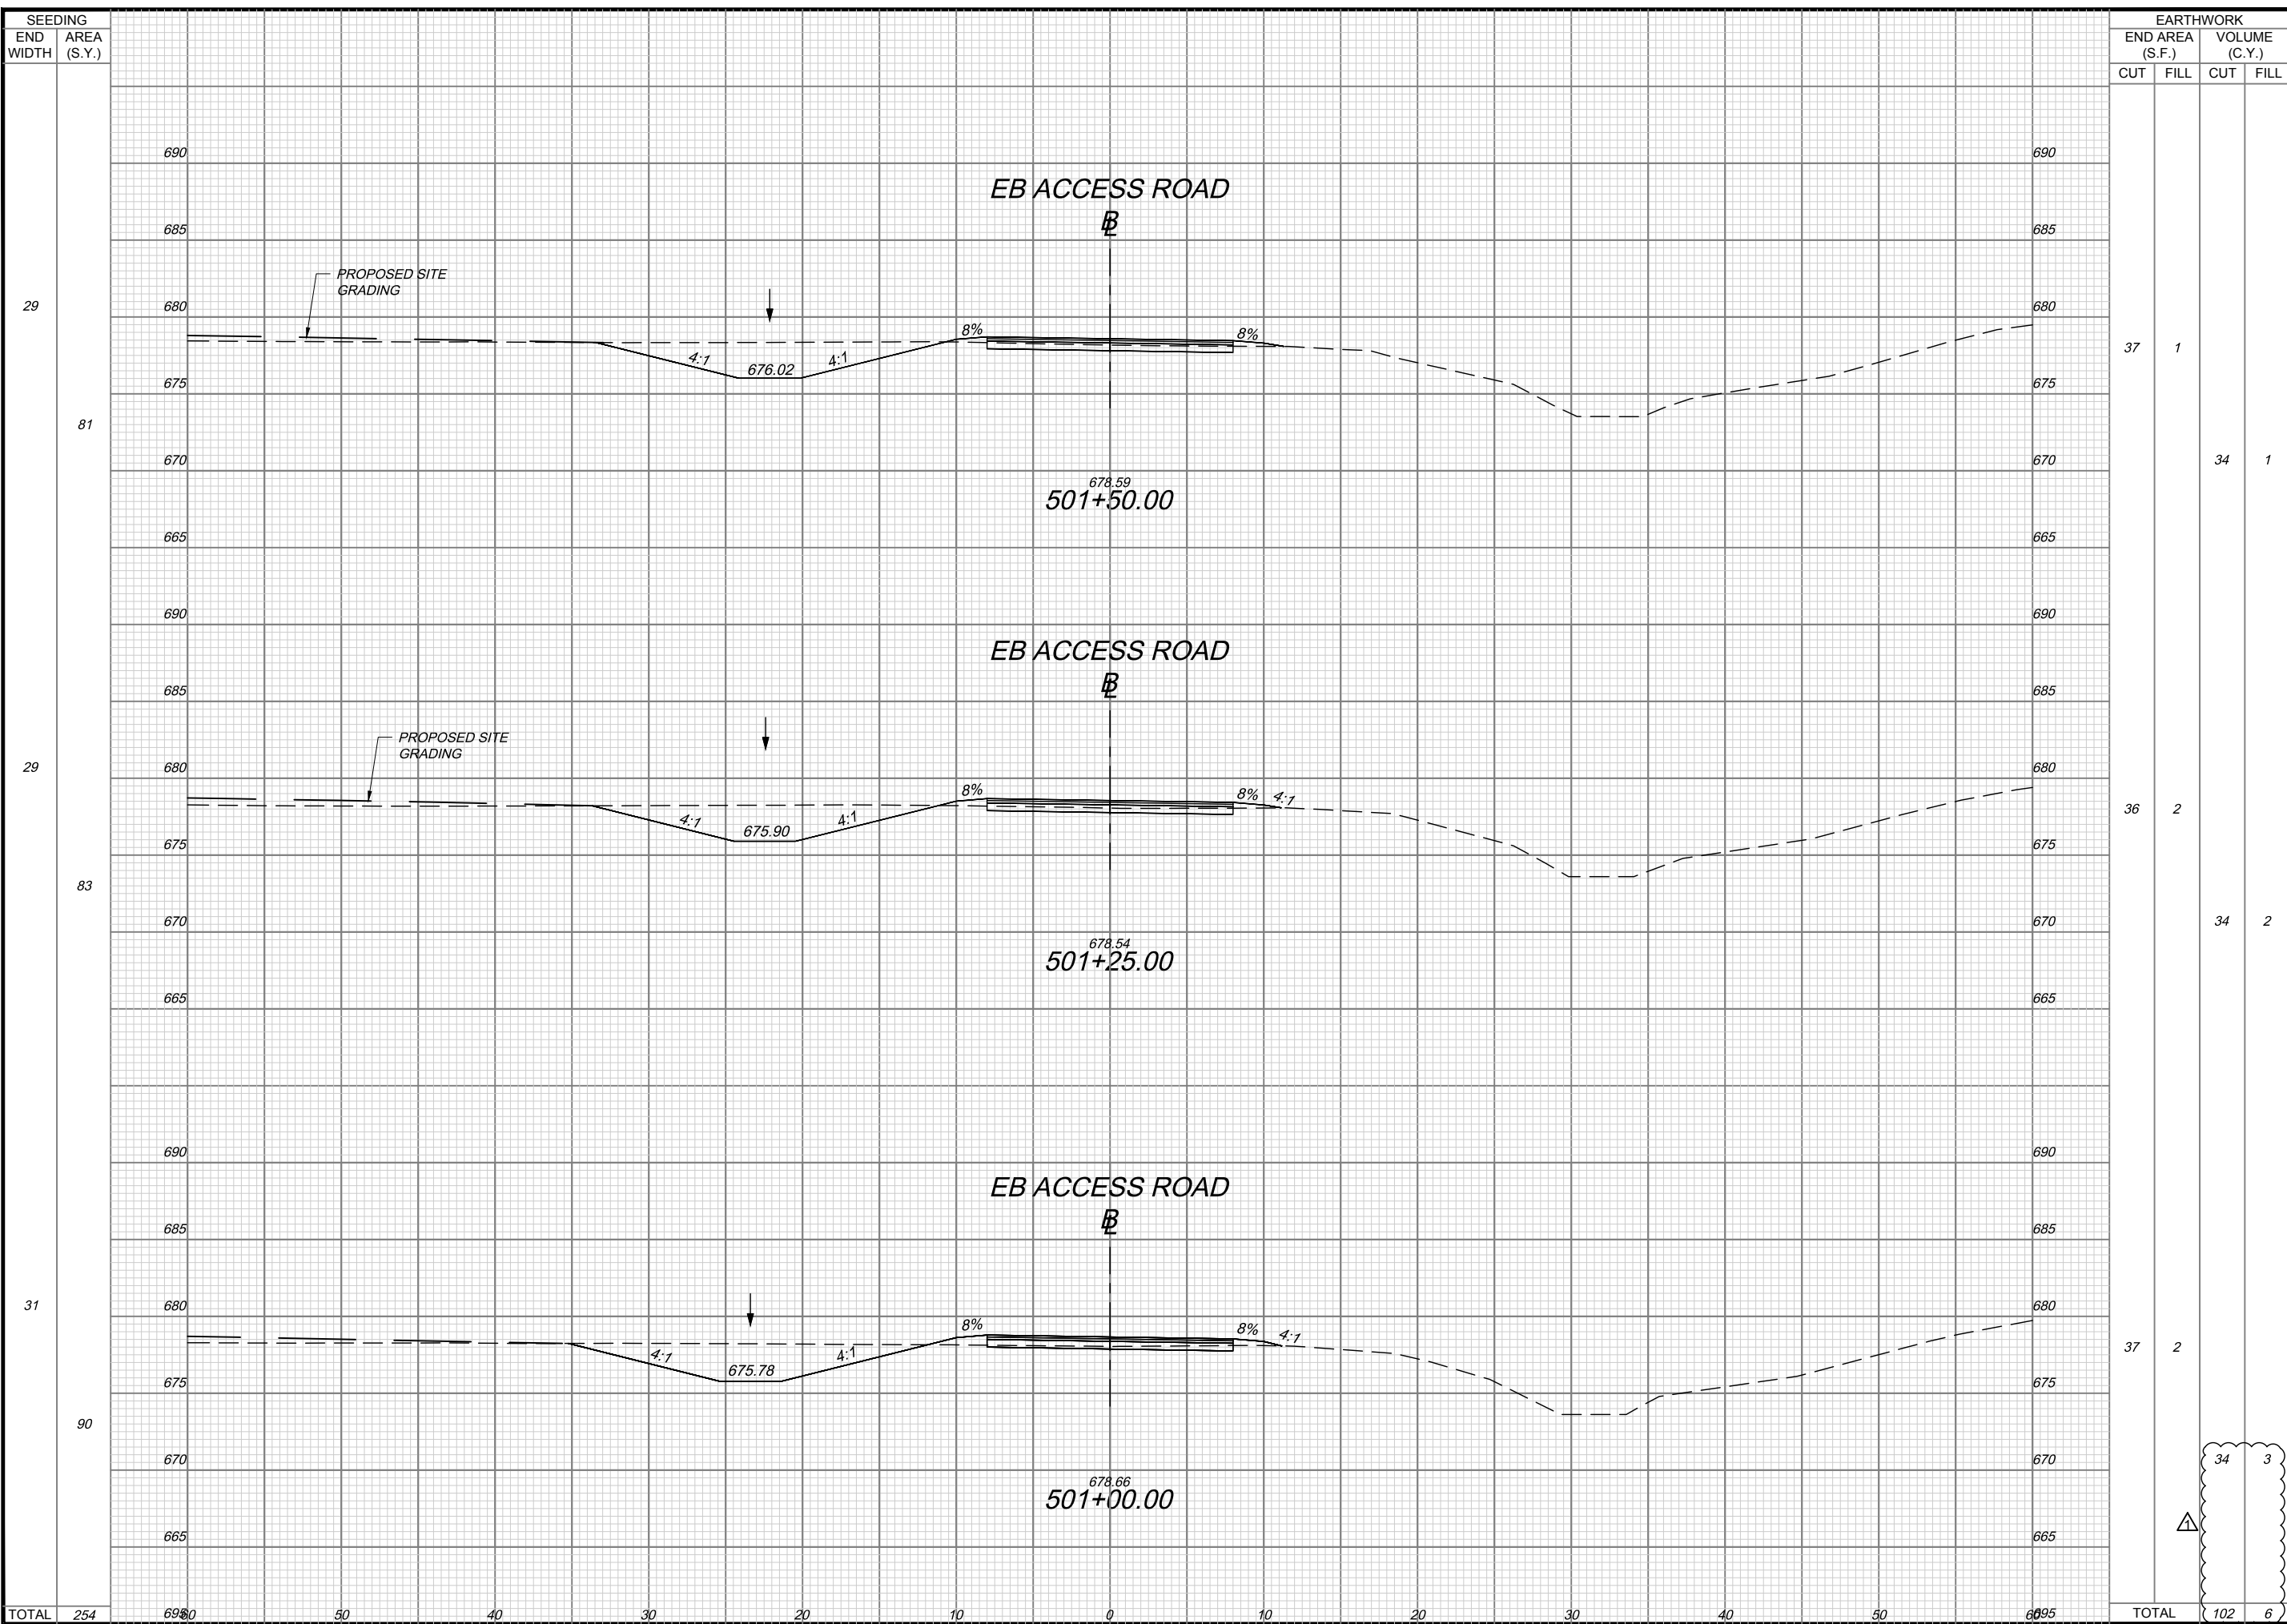

SEEDING	
END WIDTH	AREA (S.Y.)
29	81
29	83
31	90
TOTAL	254


EARTHWORK			
END AREA (S.F.)		VOLUME (C.Y.)	
CUT	FILL	CUT	FILL
37	1	34	1
36	2	34	2
37	2	34	2
TOTAL	102	6	6

DESIGN AGENCY: **JACOBS**
 PROJECT: 39-20-02B
 DATE: 12/20/2019
 EASTBOUND ACCESS ROAD CROSS SECTIONS
 STA. 501+00 TO STA. 501+50
 LUCAS COUNTY
 TP 49

CHECKING PRINT

CHECKED: _____ DATE: _____ CORRECTED: _____ DATE: _____
 BACKCHECKED: _____ DATE: _____ APPROVED: _____ DATE: _____

nnnnXS03.dwg; 1/16/20 - 1:36pm

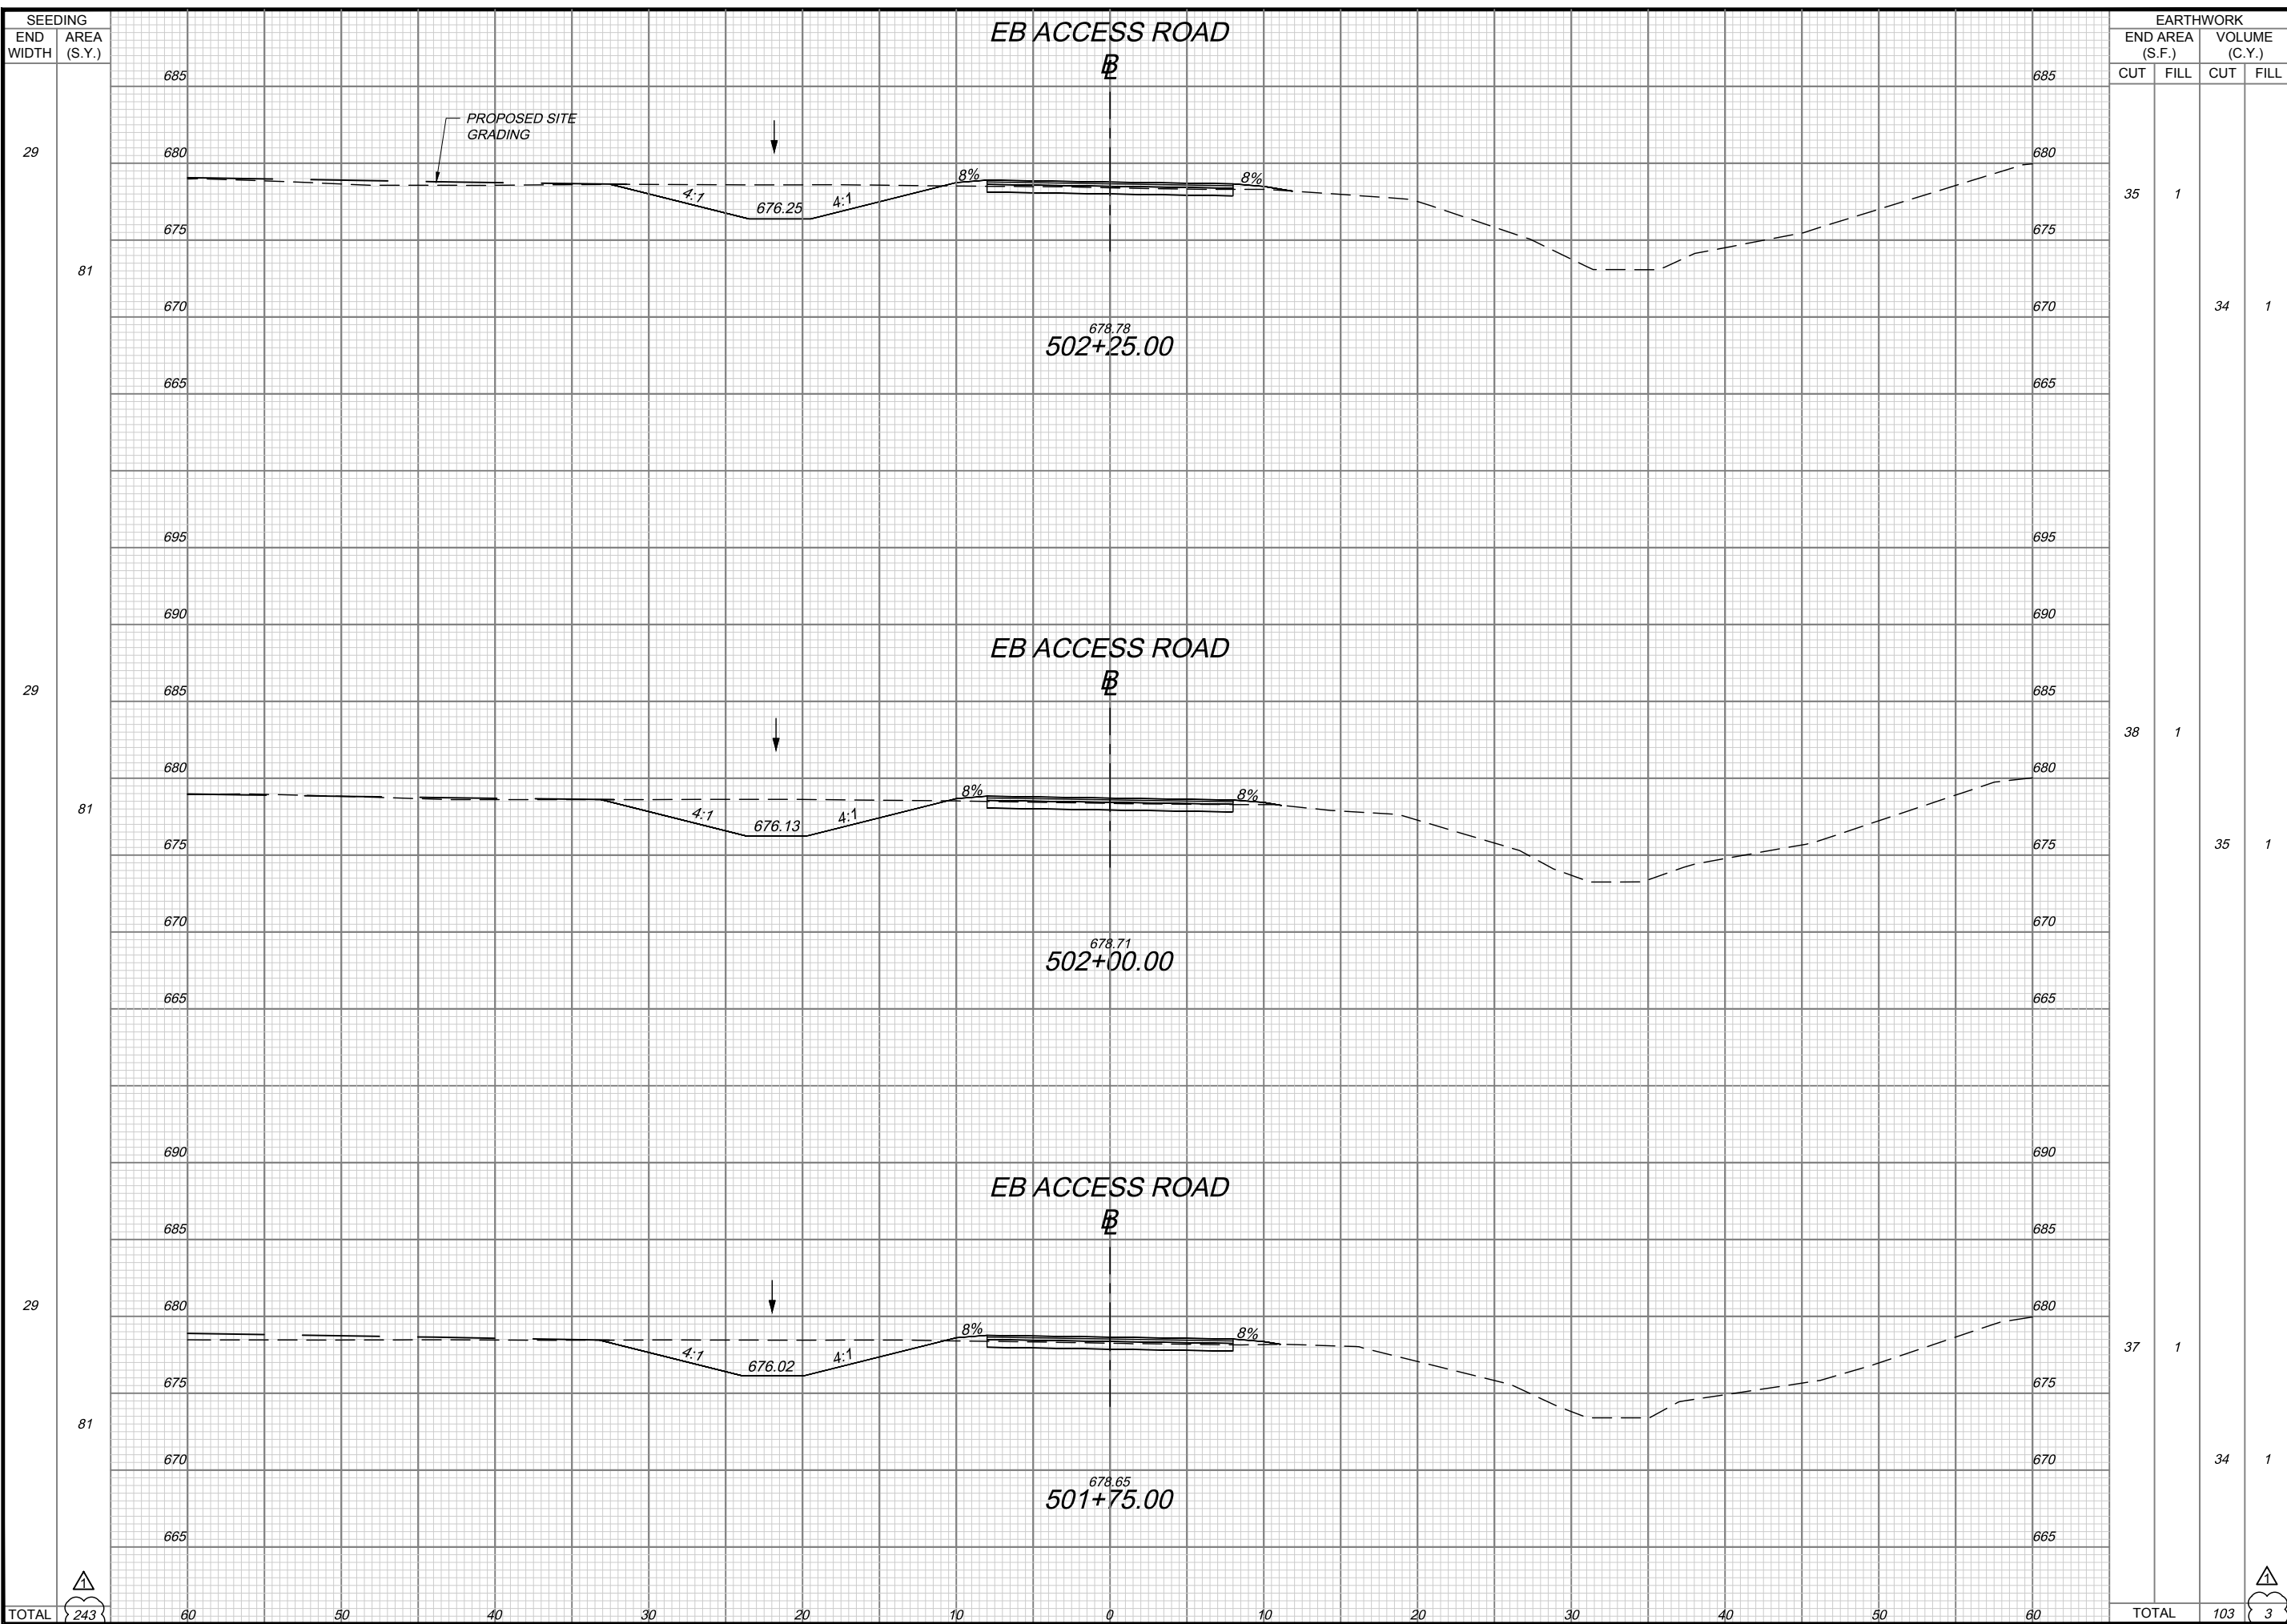


SEEDING		EARTHWORK			
END WIDTH	AREA (S.Y.)	END AREA (S.F.)		VOLUME (C.Y.)	
		CUT	FILL	CUT	FILL
29		35	1		
81				34	1
29		38	1		
81				35	1
29		37	1		
81				34	1
TOTAL		103	3	103	3

DESIGN AGENCY: **JACOBS**
 PROJECT: 39-20-02B
 DATE: 12/20/2019
 EASTBOUND ACCESS ROAD CROSS SECTIONS
 STA. 501+75 TO STA. 502+25
 LUCAS COUNTY
 TP 49

CHECKING PRINT

CHECKED: _____ DATE: _____ CORRECTED: _____ DATE: _____
 BACKCHECKED: _____ DATE: _____ APPROVED: _____ DATE: _____

nnnnXS03.dwg; 1/16/20 - 1:36pm

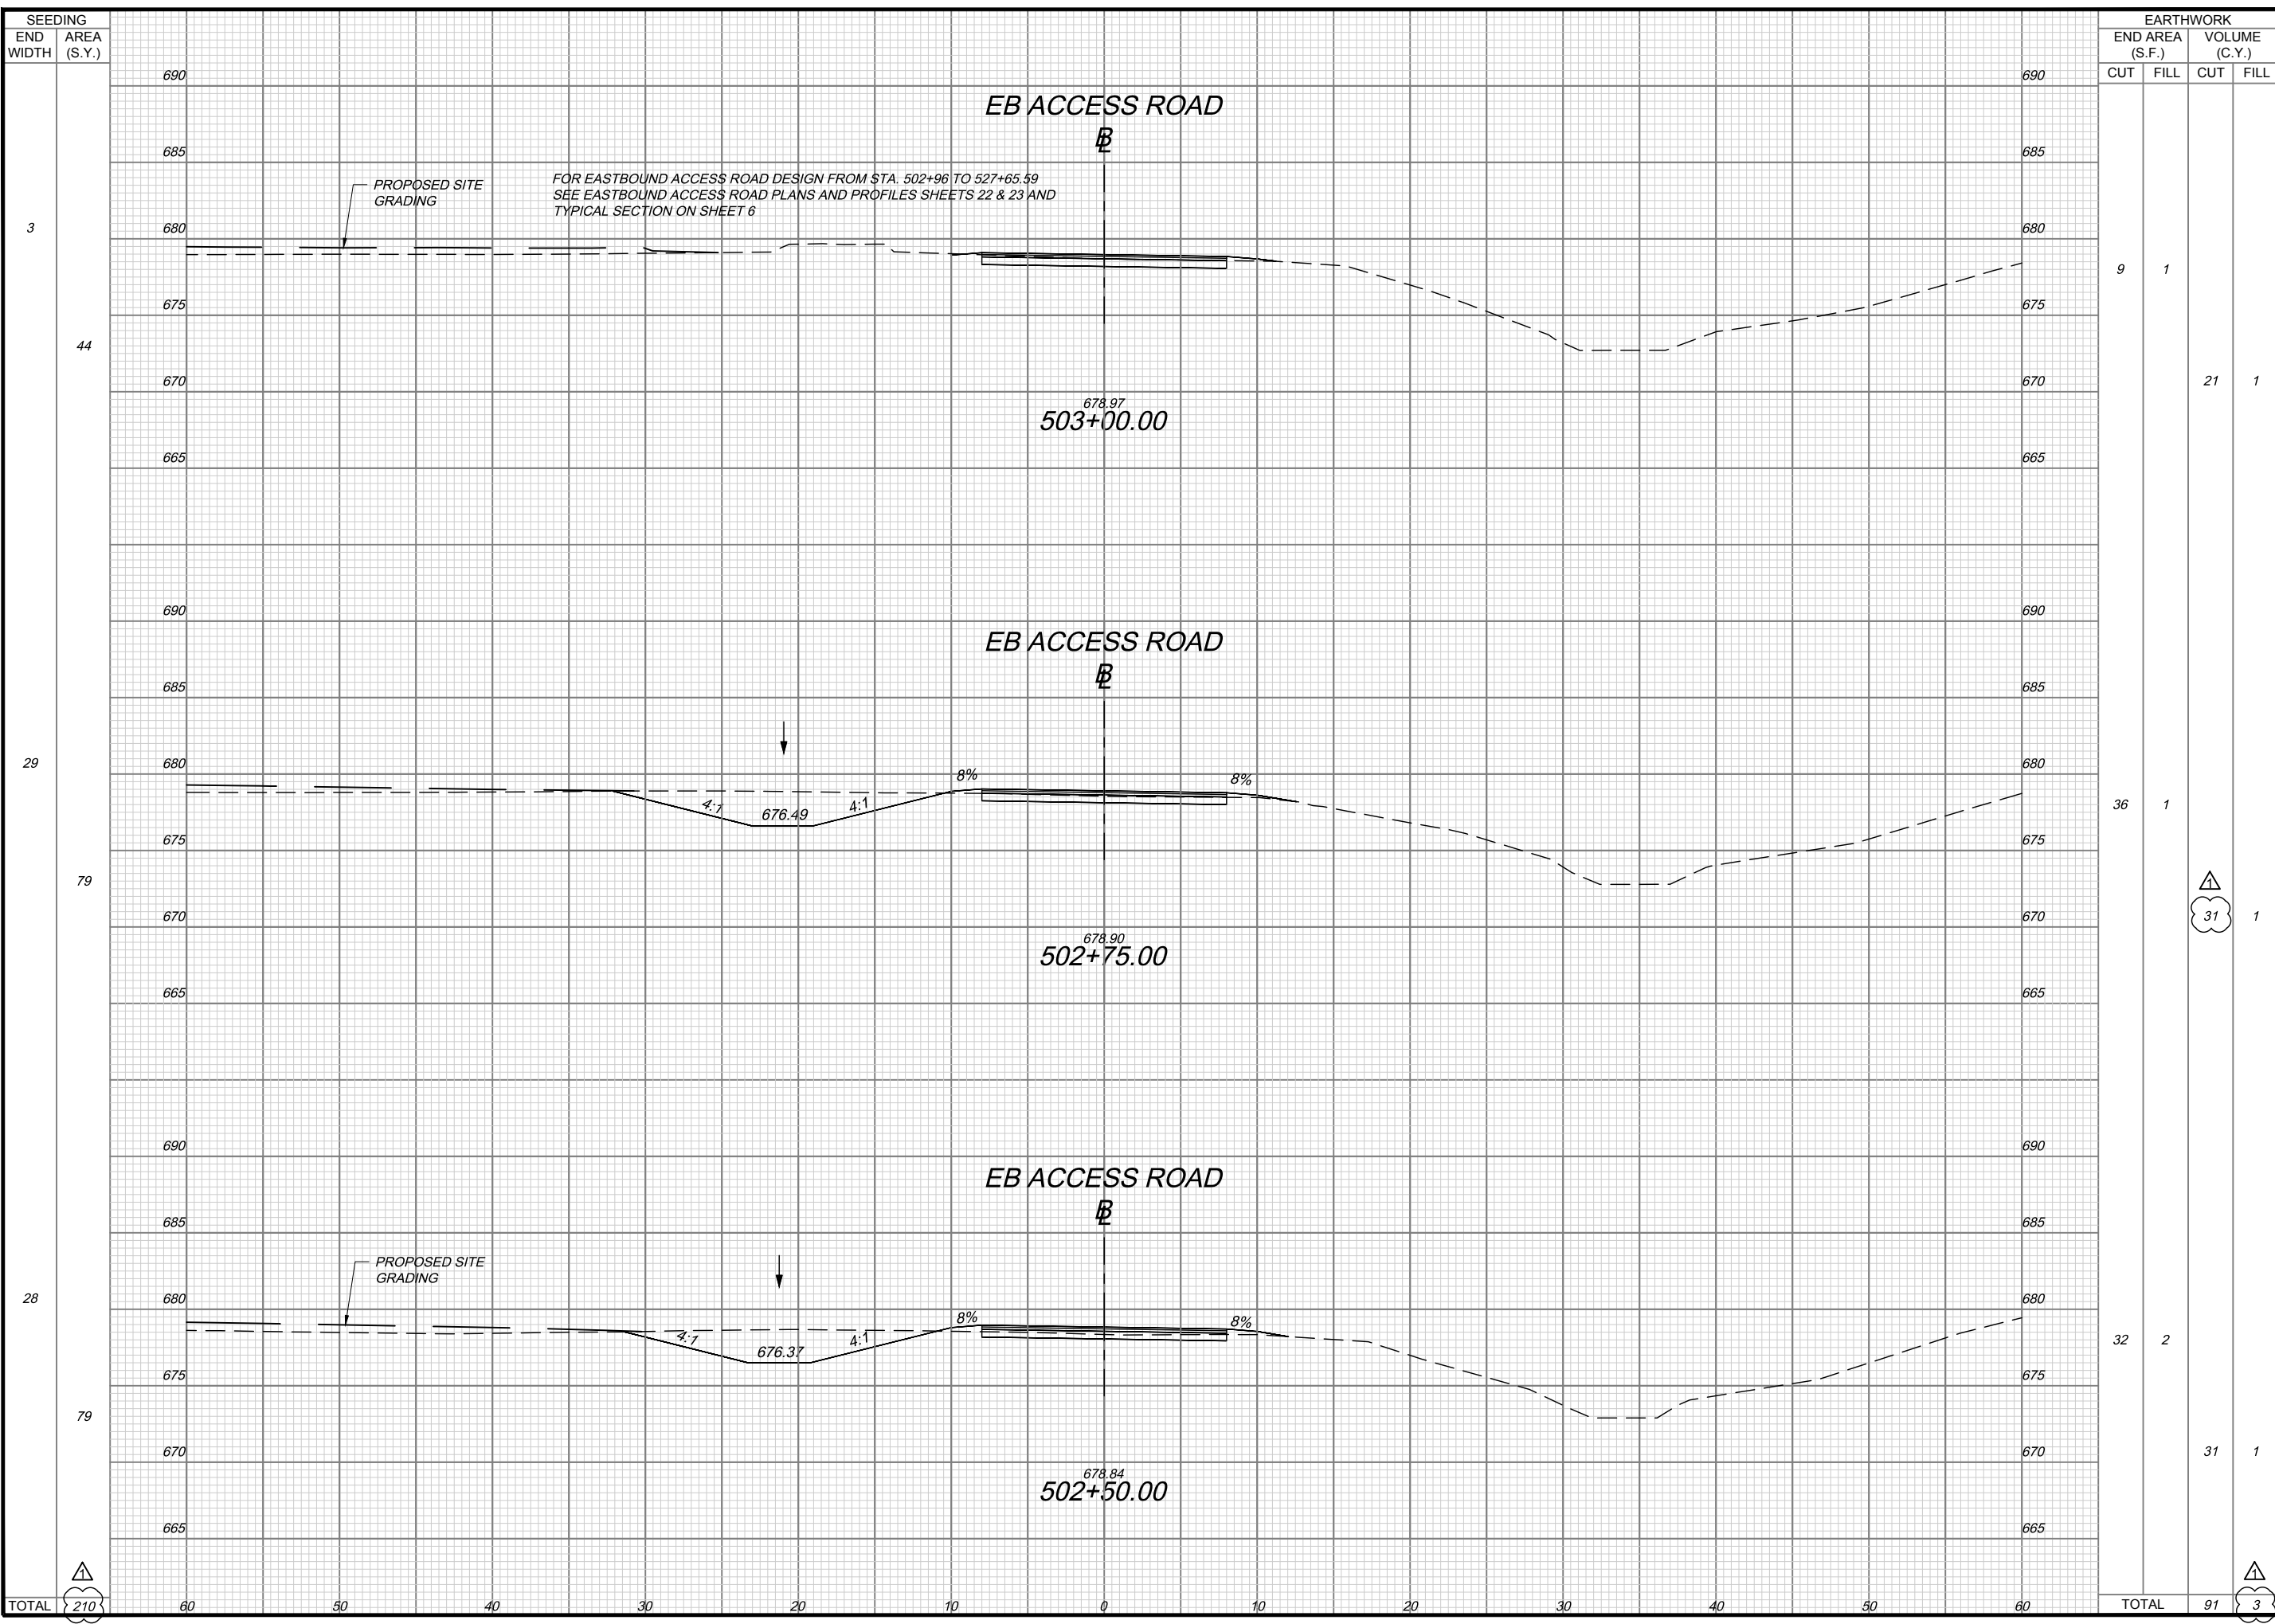

SEEDING	END WIDTH	AREA (S.Y.)	60	50	40	30	20	10	0	10	20	30	40	50	60	TOTAL
			3	44	29	79	28	79								210


EARTHWORK			
END AREA (S.F.)		VOLUME (C.Y.)	
CUT	FILL	CUT	FILL
9	1	21	1
36	1	31	1
32	2	31	1
TOTAL	91	31	3

DESIGN AGENCY: **JACOBS** (Logo)
 BY DATE: AMS 1/16/20
 REVISIONS: ADDENDUM NO. 2
 CHECKED: AMS
 DESIGNED: AMS
 DRAWN: AMS
 PROJECT: 39-20-02B
 DATE: 12/20/2019
 TP 49
 EASTBOUND ACCESS ROAD CROSS SECTIONS
 STA. 50+50 TO STA. 503+00
 LUCAS COUNTY

CHECKING PRINT

CHECKED: _____ DATE: _____ CORRECTED: _____ DATE: _____
 BACKCHECKED: _____ DATE: _____ APPROVED: _____ DATE: _____

nnnnXS04.dwg; 1/16/20 - 1:36pm

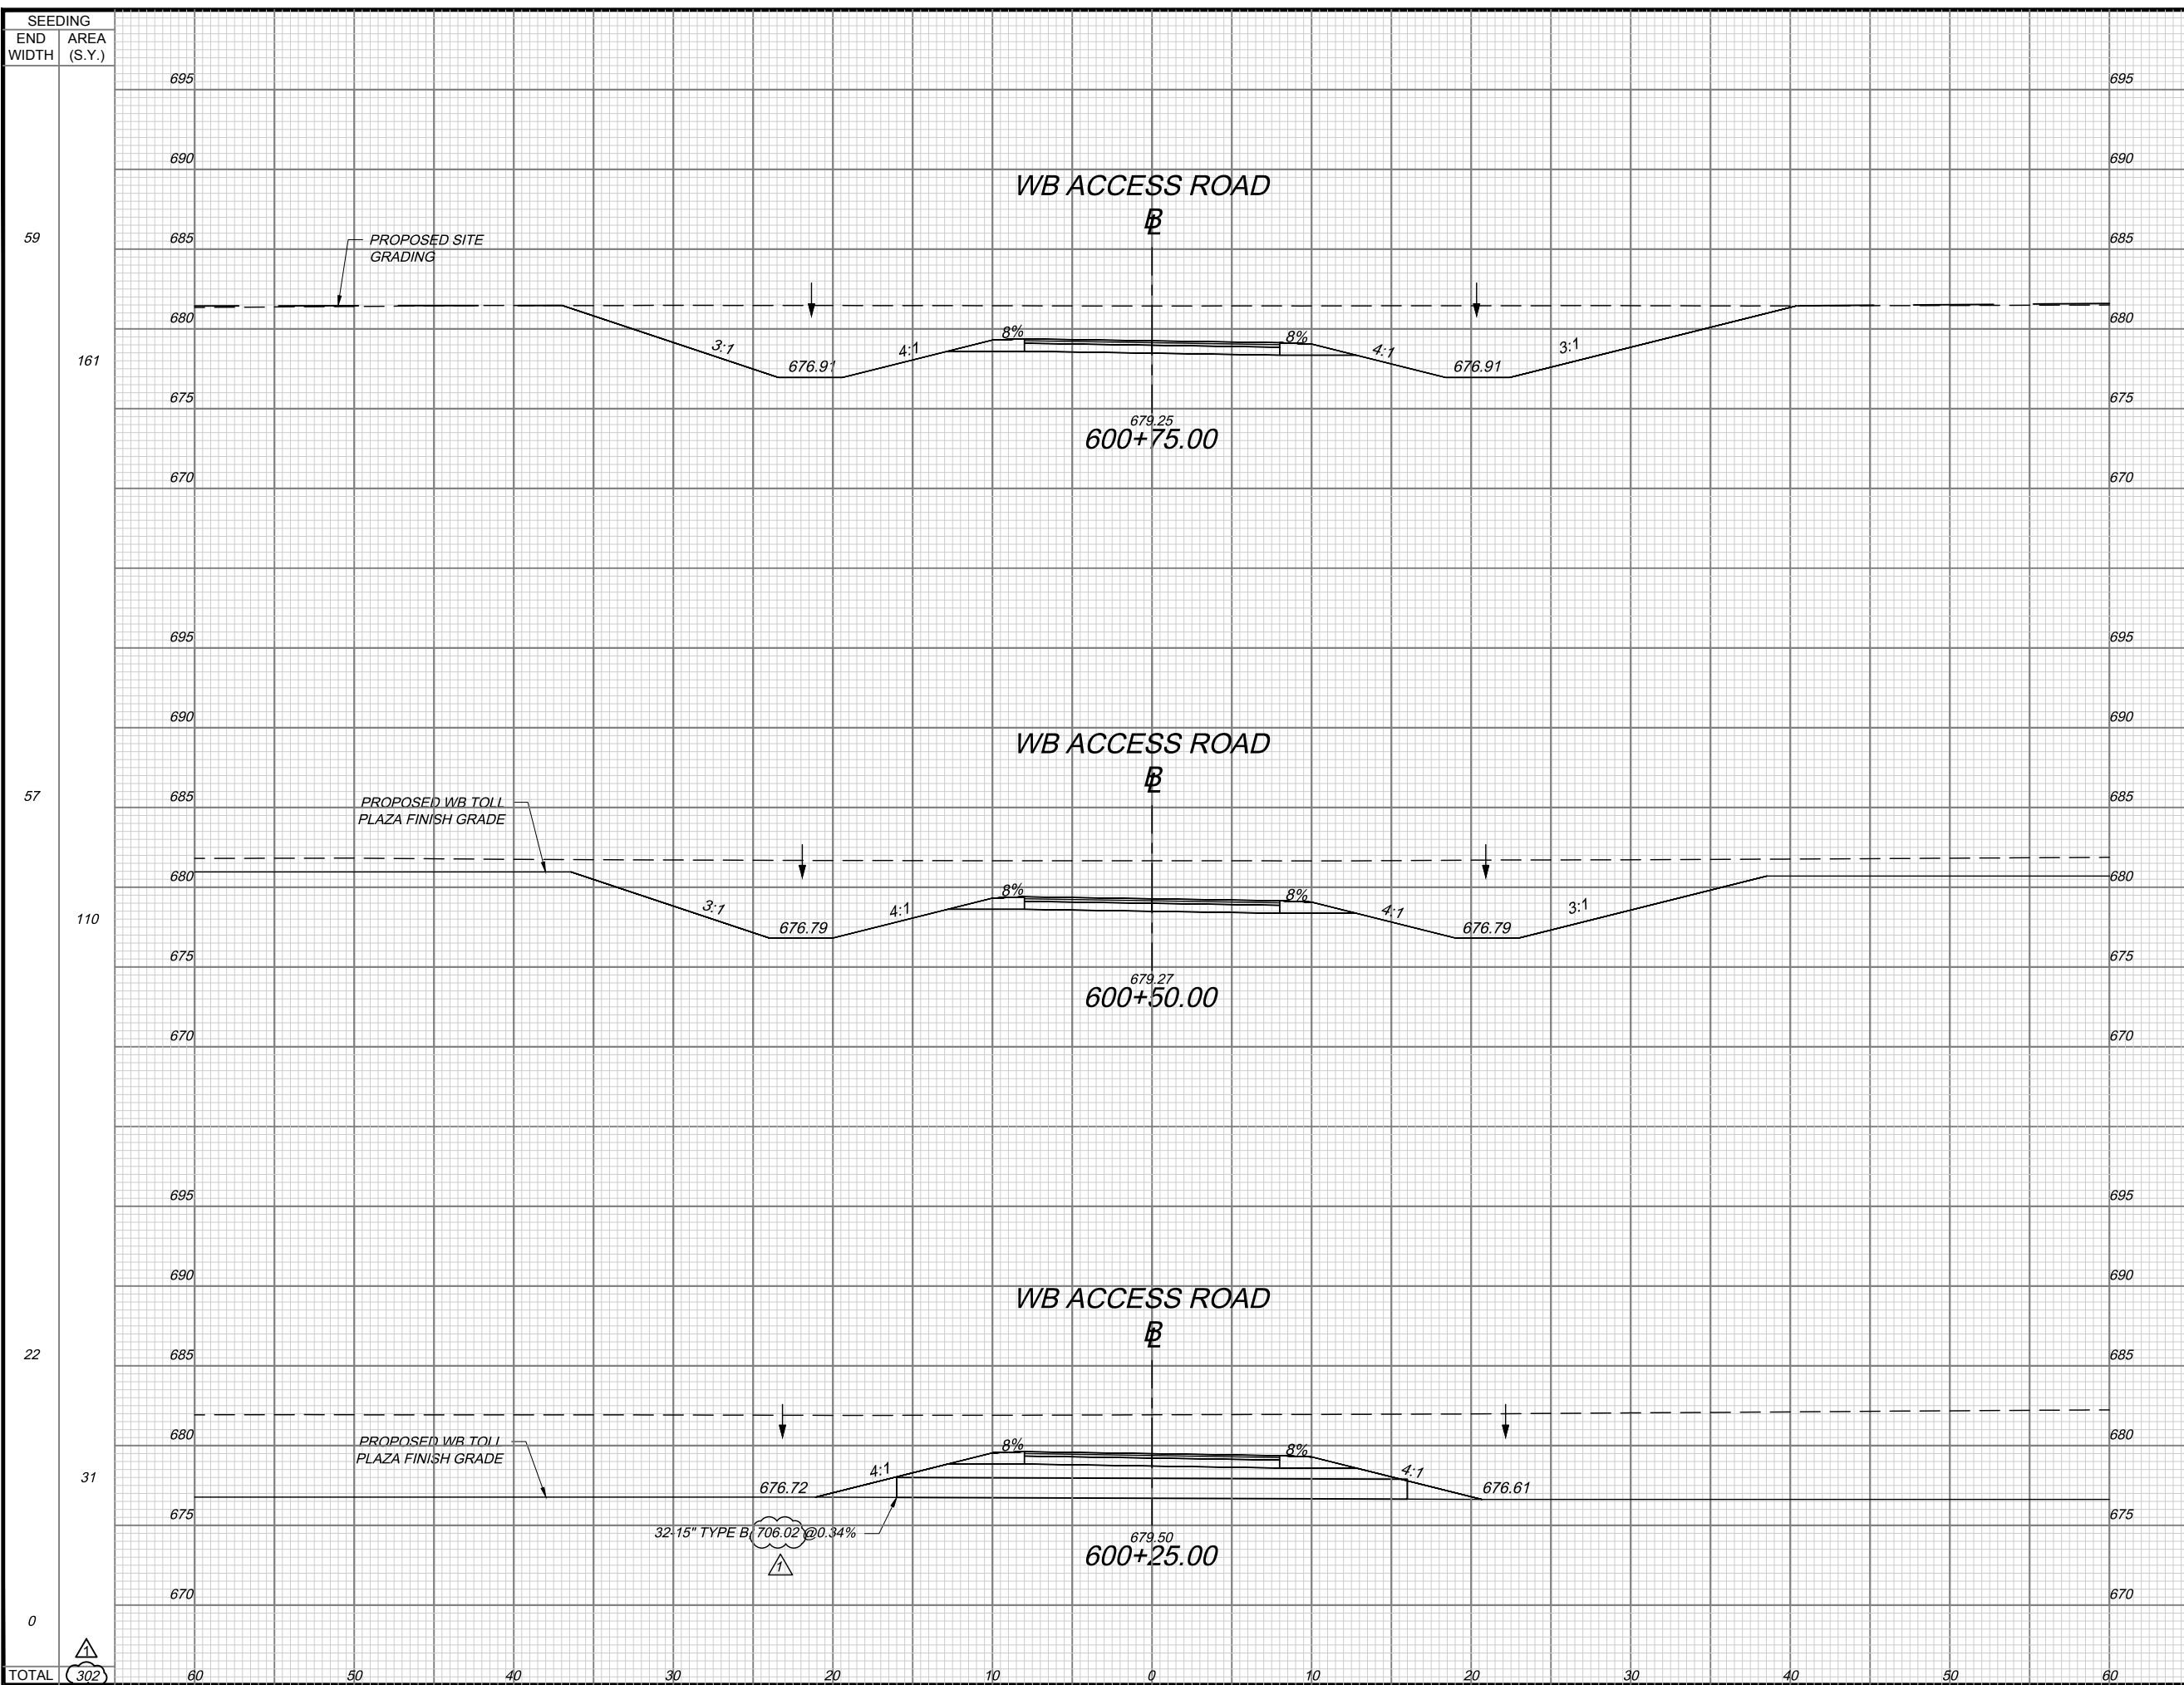


SEEDING		EARTHWORK			
END WIDTH	AREA (S.Y.)	END AREA (S.F.)		VOLUME (C.Y.)	
		CUT	FILL	CUT	FILL
695					
690					
685					
680		229	5		
675				194	5
670					
695					
690					
685					
680		191	5		
675				88	36
670					
695					
690					
685					
680		0	73		
675				0	34
670					
695					
690					
685					
680					
675					
670					
TOTAL	302			282	74

DESIGN AGENCY: **JACOBS**
 PROJECT: 39-20-02B
 DATE: 12/20/2019
 WESTBOUND ACCESS ROAD CROSS SECTIONS
 STA. 600+25 TO STA. 600+75
 LUCAS COUNTY
 TP 49
 1/7
 48
 59

CHECKING PRINT

CHECKED: _____ DATE: _____ CORRECTED: _____ DATE: _____
 BACKCHECKED: _____ DATE: _____ APPROVED: _____ DATE: _____

nnnnXS04.dwg; 1/16/20 - 1:37pm

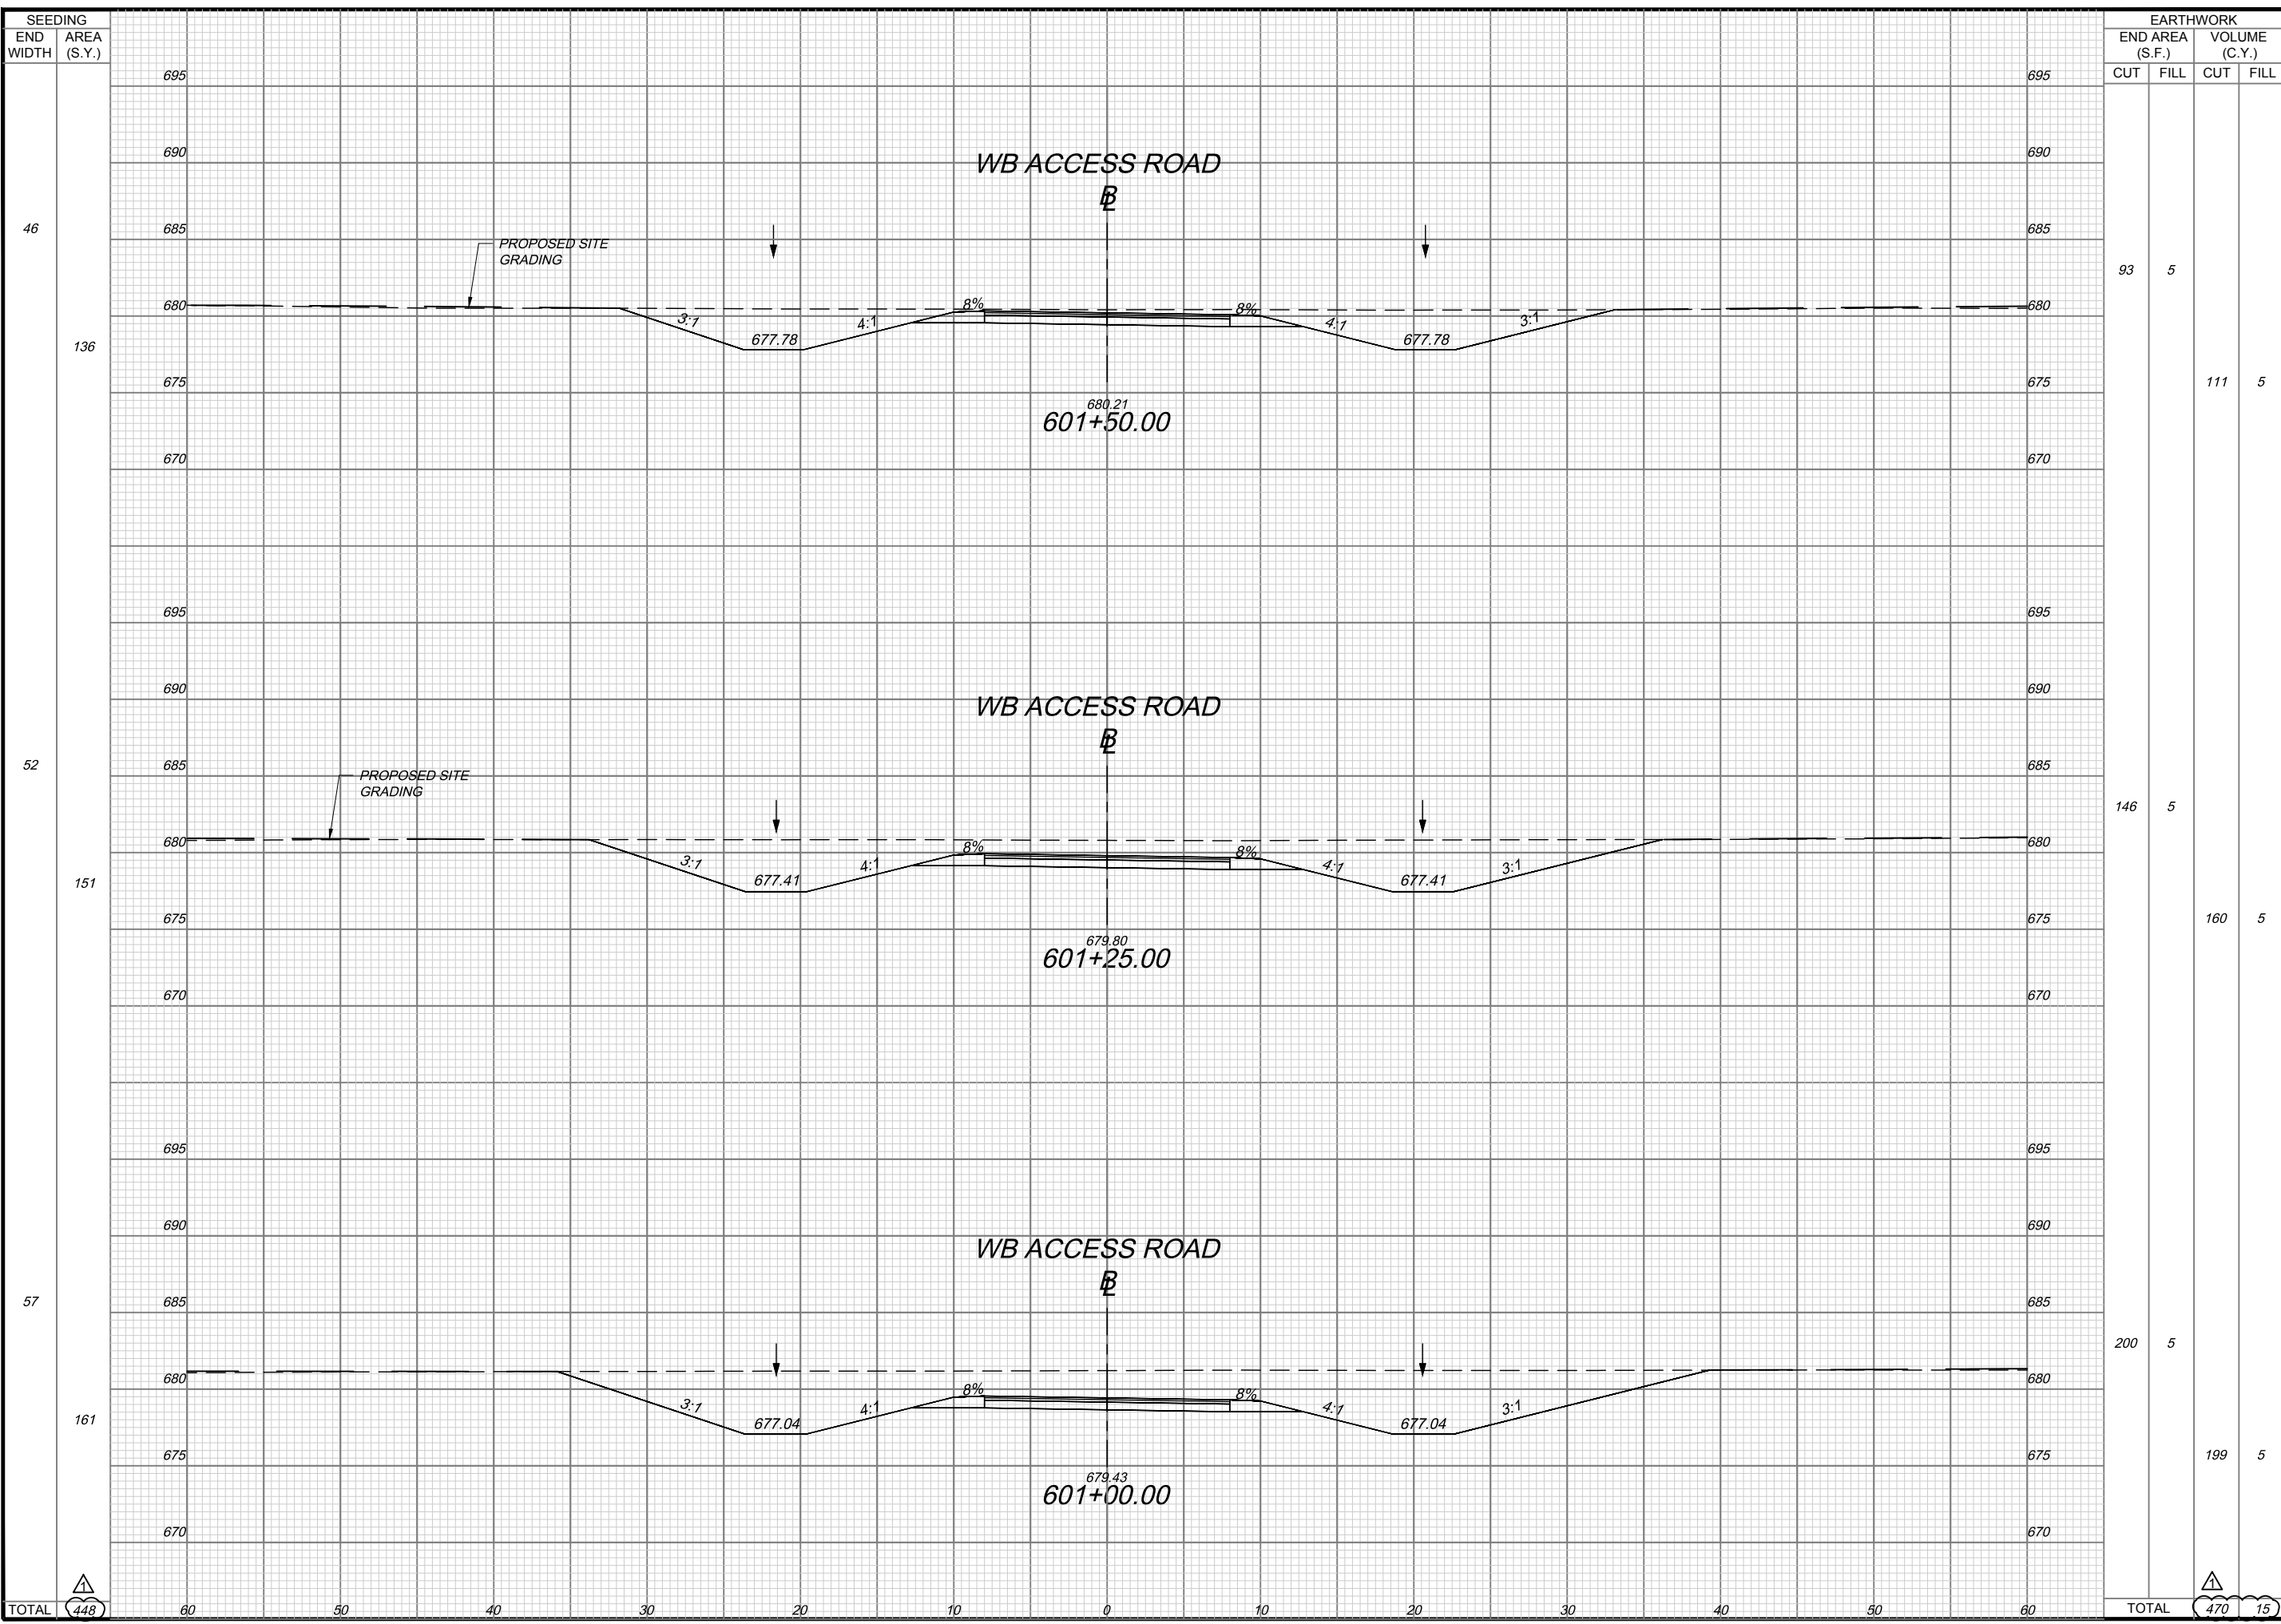


SEEDING		EARTHWORK			
END WIDTH	AREA (S.Y.)	END AREA (S.F.)		VOLUME (C.Y.)	
		CUT	FILL	CUT	FILL
695					
690					
685					
680		93	5		
675				111	5
670					
695					
690					
685					
680		146	5		
675				160	5
670					
695					
690					
685					
680		200	5		
675				199	5
670					
TOTAL	448			470	15

DESIGN AGENCY: **JACOBS**
 PROJECT: 39-20-02B
 DATE: 12/20/2019
 WESTBOUND ACCESS ROAD CROSS SECTIONS
 STA. 601+00 TO STA. 601+50
 LUCAS COUNTY
 TP 49
 2 / 7
 49
 59

CHECKING PRINT

CHECKED: _____ DATE: _____ CORRECTED: _____ DATE: _____
 BACKCHECKED: _____ DATE: _____ APPROVED: _____ DATE: _____

nnnnXS04.dwg; 1/16/20 - 1:37pm

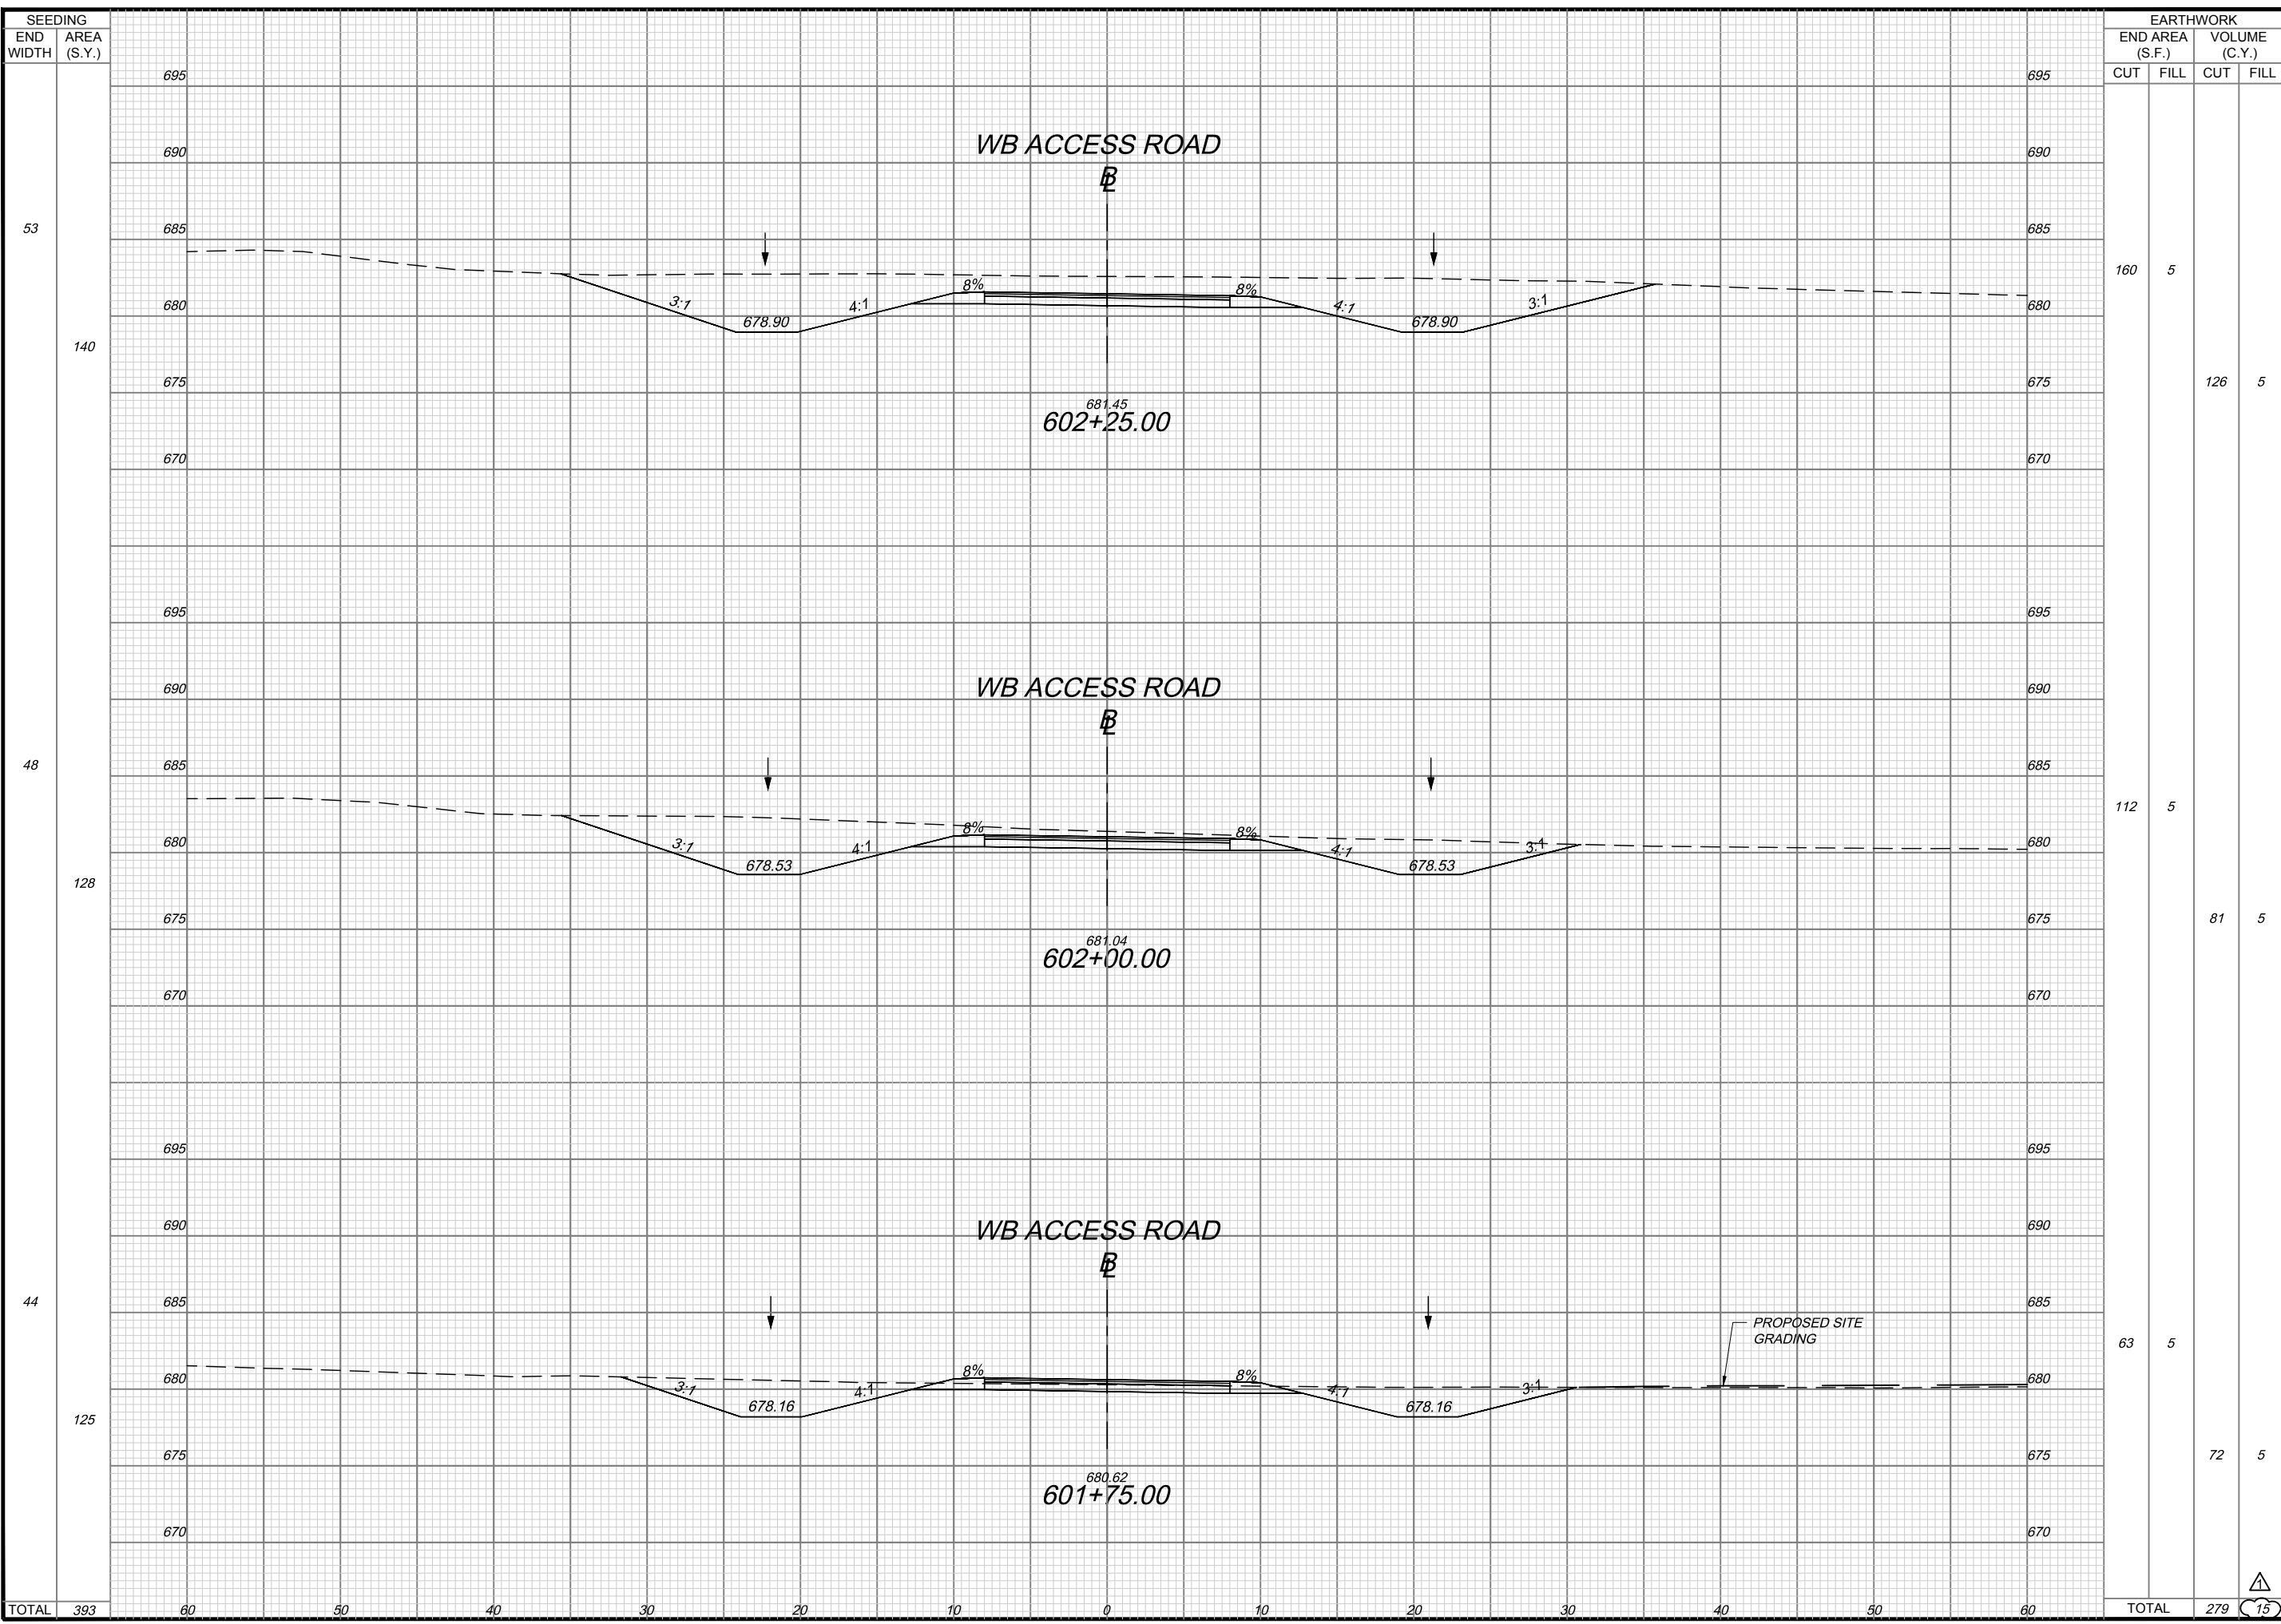

SEEDING		EARTHWORK			
END WIDTH	AREA (S.Y.)	END AREA (S.F.)		VOLUME (C.Y.)	
		CUT	FILL	CUT	FILL
60		160	5	126	5
50					
40					
30					
20					
10					
0					
10					
20					
30					
40					
50					
60					
TOTAL	393			279	15

DESIGN AGENCY: **JACOBS**
 1231 JAMES ARNOLD BLVD
 OFFICE #130322


BY	DATE	NO.	CHECKED	DESIGNED
AMS	1/16/20	1	AMS	AMS
AMS			#/CHARGE	DRAWN
			CSM	AMS

REVISIONS: ADDENDUM NO. 2
 WESTBOUND ACCESS ROAD CROSS SECTIONS
 STA. 601+75 TO STA. 602+25
 LUCAS COUNTY
 TP 49
 PROJECT 39-20-02B
 DATE: 12/20/2019
 3 / 7

CHECKING PRINT

CHECKED: _____ DATE: _____ CORRECTED: _____ DATE: _____
 BACKCHECKED: _____ DATE: _____ APPROVED: _____ DATE: _____

nnnnXS04.dwg; 1/16/20 - 1:37pm

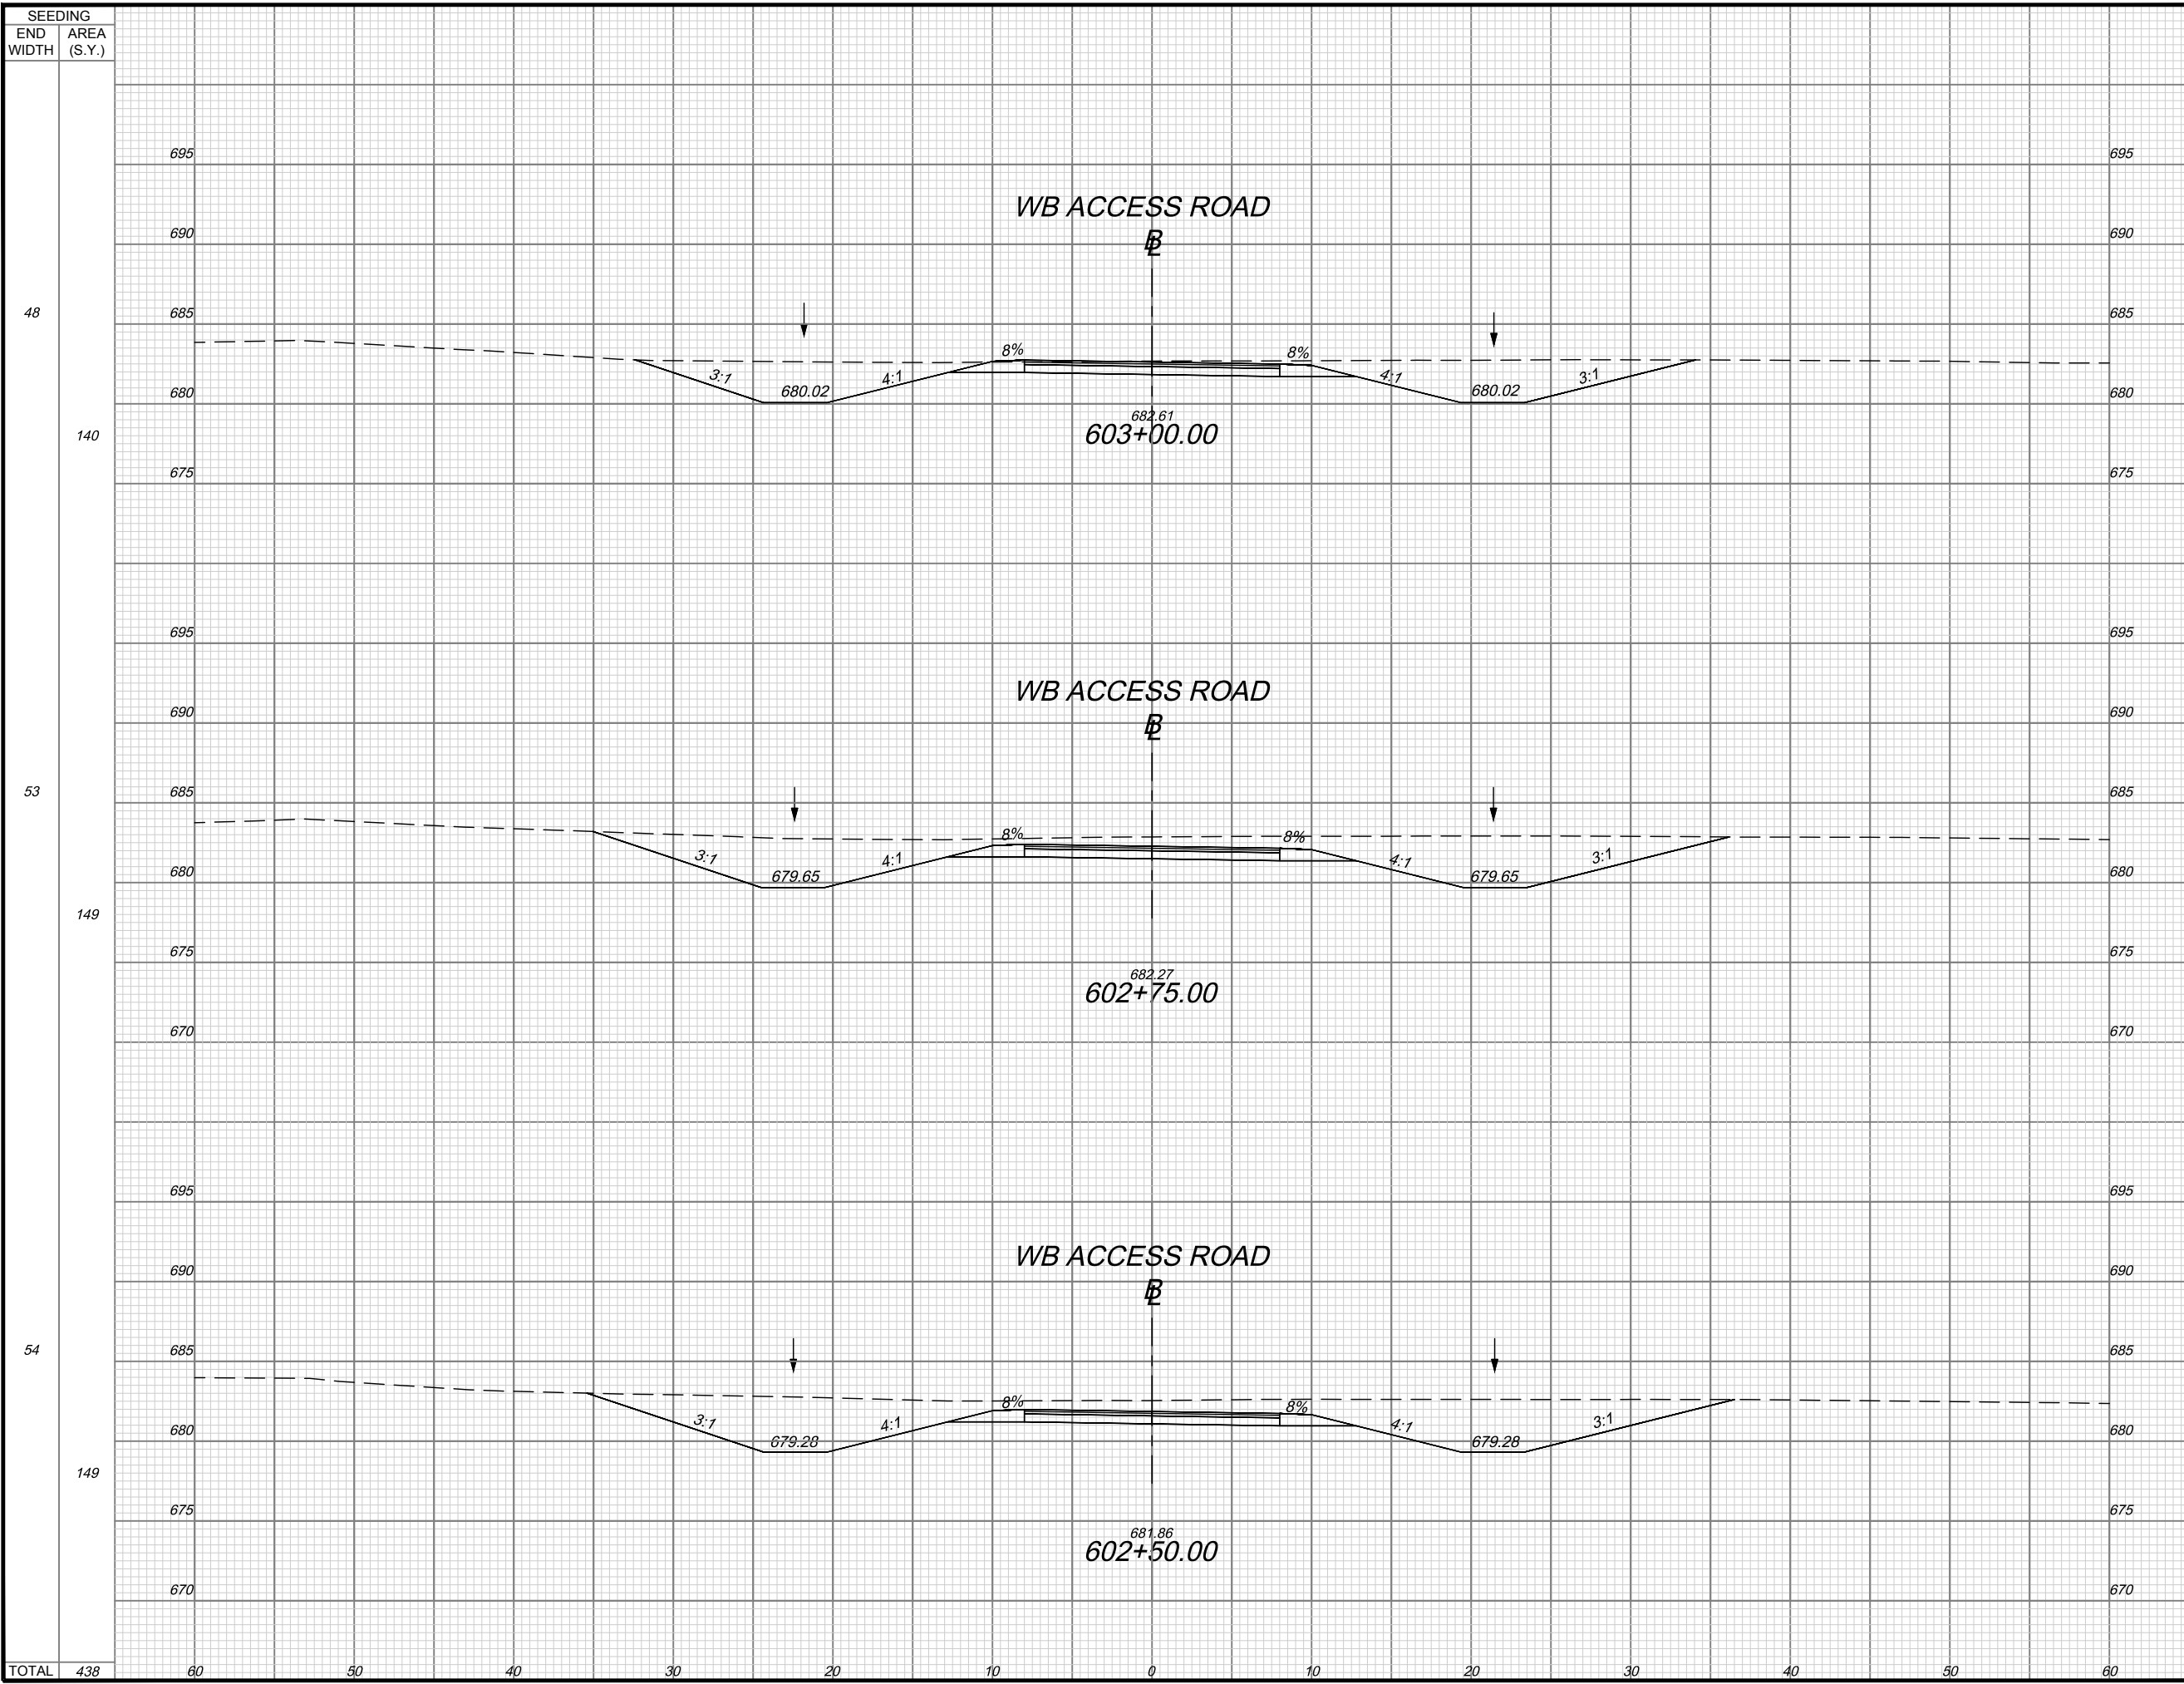

SEEDING		EARTHWORK			
END WIDTH	AREA (S.Y.)	END AREA (S.F.)		VOLUME (C.Y.)	
		CUT	FILL	CUT	FILL
48		91	5		
140				101	5
53		128	5		
149				124	5
54		140	5		
149				139	5
TOTAL	438			364	15

DESIGN AGENCY: **JACOBS**
 1231 JAMES AVENUE 6 FLOOR
 OFFICE #1303 222

BY	DATE	NO.	CHECKED	DESIGNED
AMS	1/16/20	1	AMS	AMS
			IN CHARGE	DRAWN
			CSM	AMS


PROJECT 39-20-02B
 DATE: 12/20/2019
 WESTBOUND ACCESS ROAD CROSS SECTIONS
 STA. 602+50 TO STA. 603+00
 LUCAS COUNTY
 TP 49

51
59

CHECKING PRINT

CHECKED: _____ DATE: _____ CORRECTED: _____ DATE: _____
 BACKCHECKED: _____ DATE: _____ APPROVED: _____ DATE: _____

nnnnXS04.dwg; 1/16/20 - 1:37pm

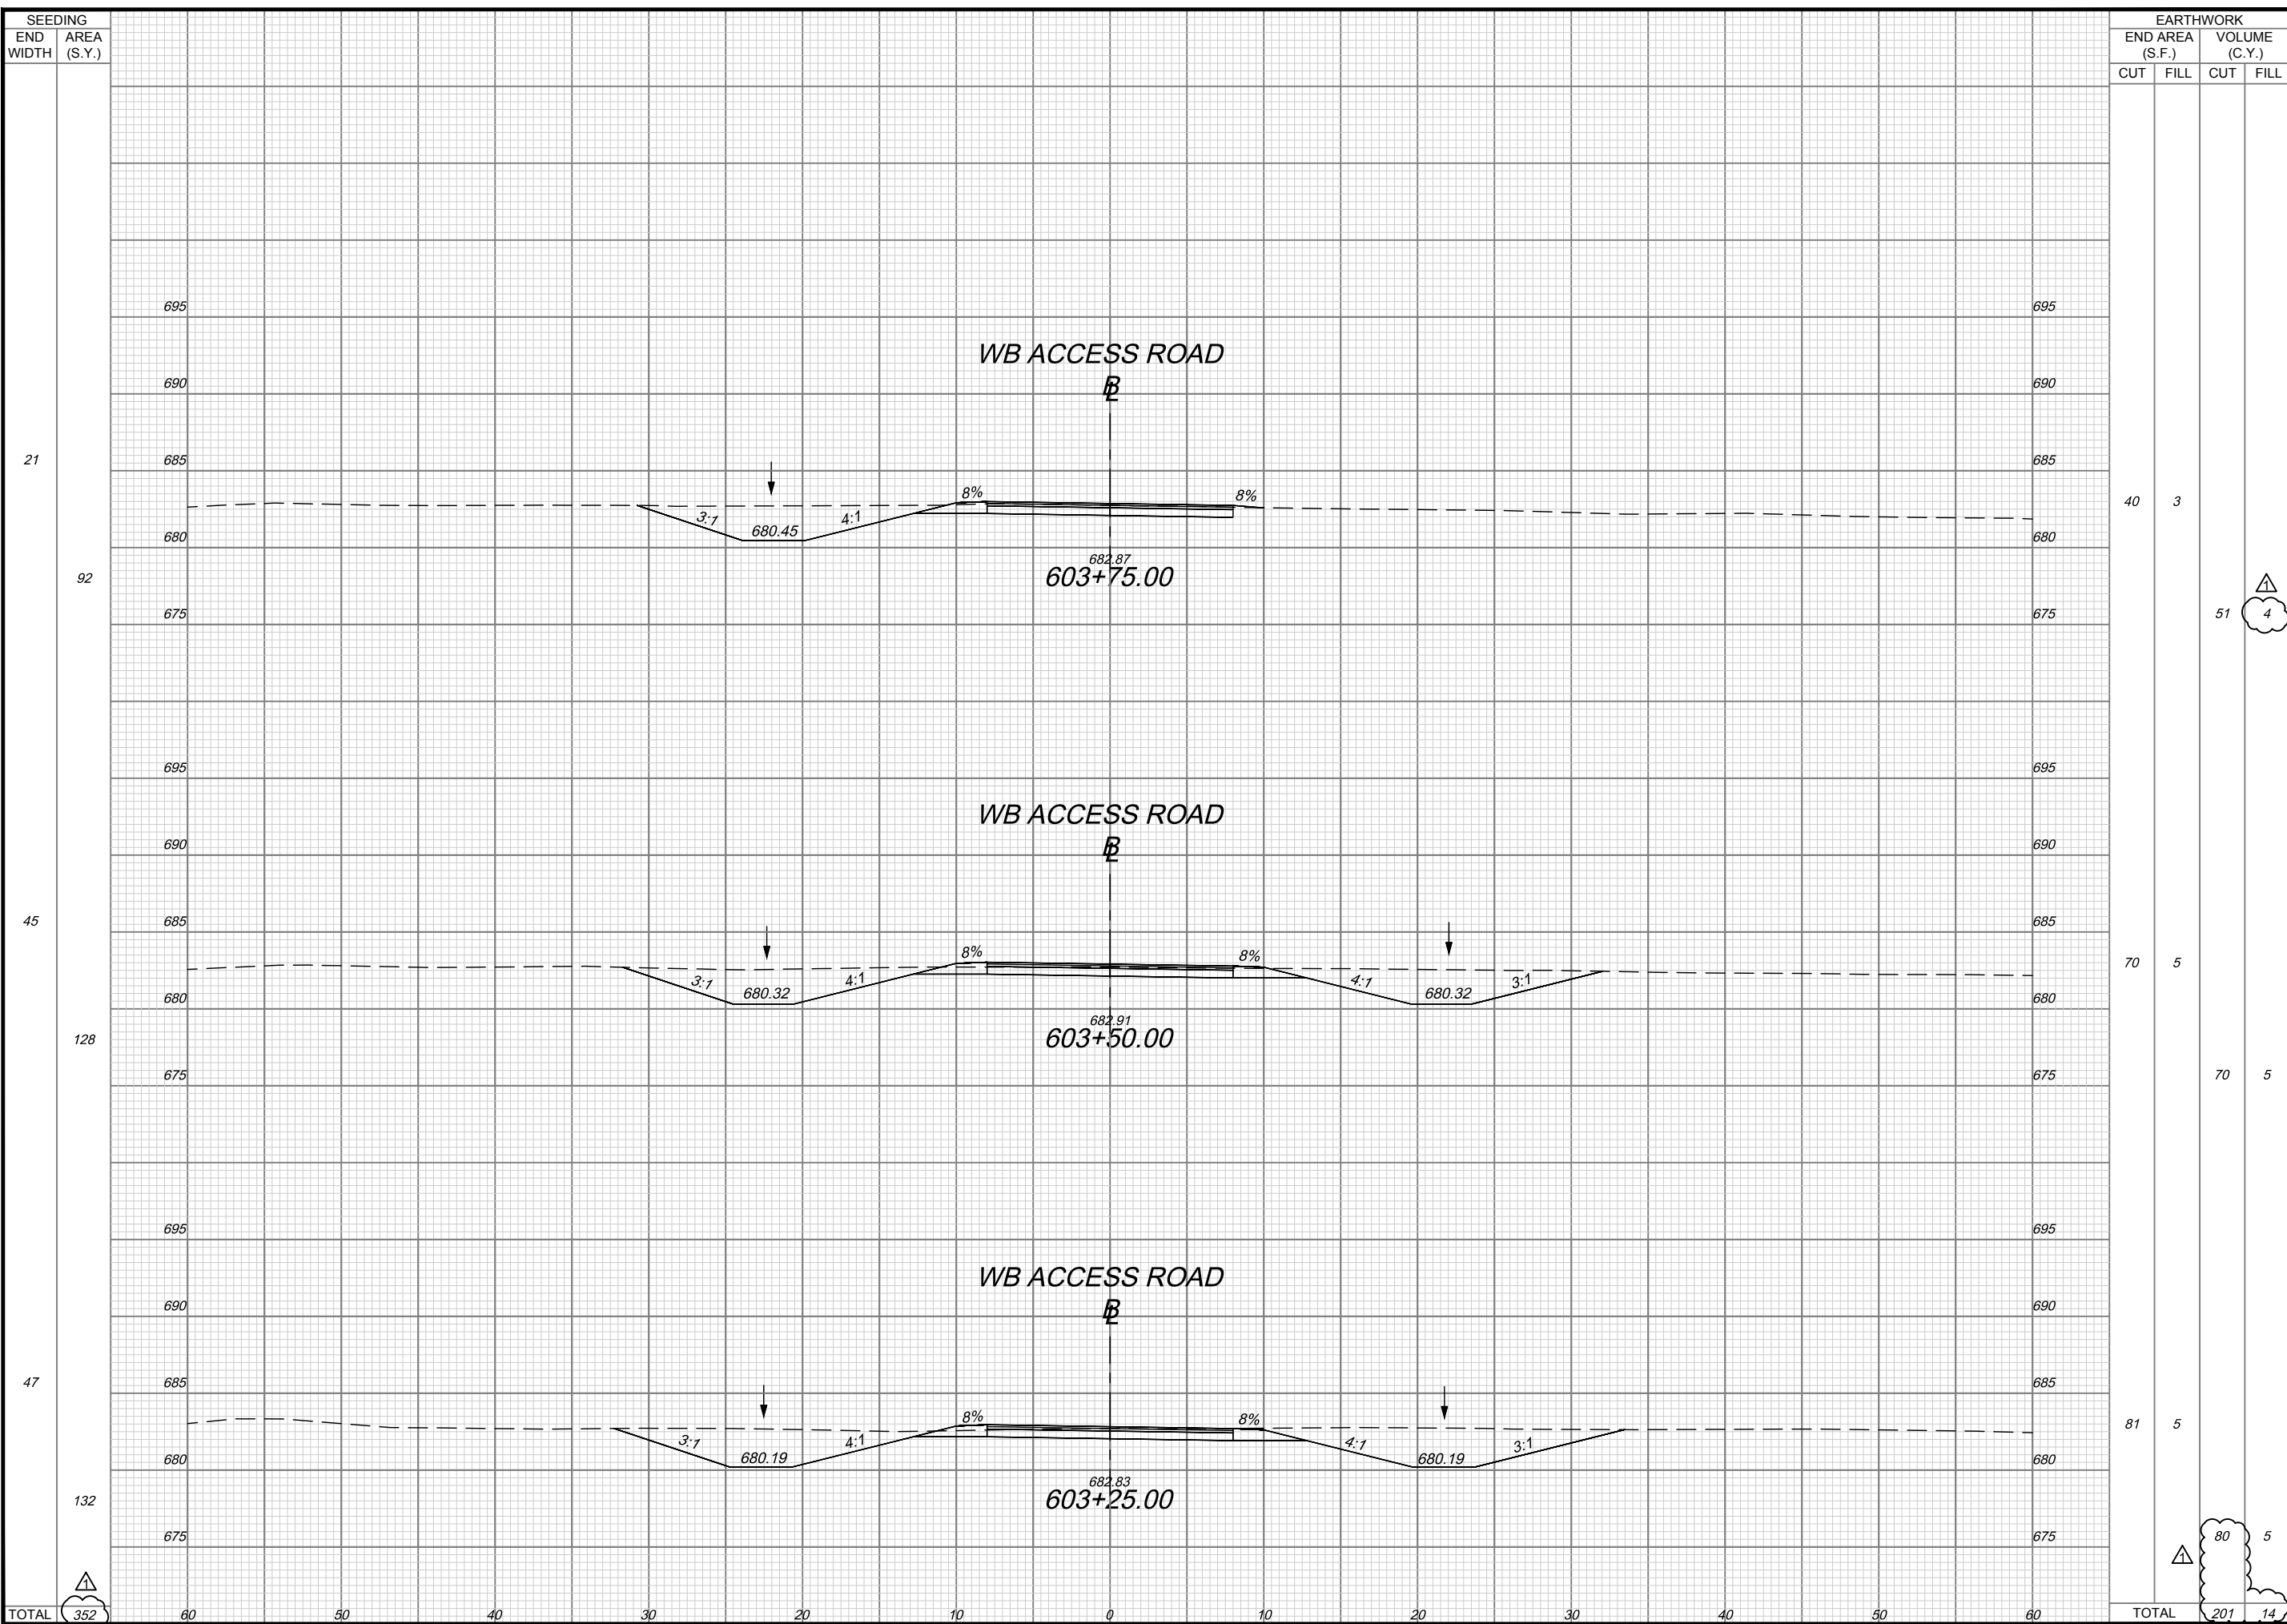

TOTAL	352	60	50	40	30	20	10	0	10	20	30	40	50	60
-------	-----	----	----	----	----	----	----	---	----	----	----	----	----	----

SEEDING		EARTHWORK			
END WIDTH	AREA (S.Y.)	END AREA (S.F.)		VOLUME (C.Y.)	
		CUT	FILL	CUT	FILL
		40	3		
				51	4
		70	5		
				70	5
		81	5		
				80	5
				201	14

DESIGN AGENCY: **JACOBS**
 1231 JAMES AVENUE 6 FLOOR
 OFFICE 613-332-8222


BY	DATE	REVISIONS	CHECKED	NO.
AMS	1/16/20	ADDENDUM NO. 2	AMS	1
			#/CHARGE	
			AMS	CSM

DESIGNED: JDS
 DRAWN: AMS
 WESTBOUND ACCESS ROAD CROSS SECTIONS
 STA. 603+25 TO STA. 603+75
 LUCAS COUNTY
 TP 49
 PROJECT 39-20-02B
 DATE: 12/20/2019

CHECKING PRINT

CHECKED: _____ DATE: _____ CORRECTED: _____ DATE: _____
 BACKCHECKED: _____ DATE: _____ APPROVED: _____ DATE: _____

nnnnXS04.dwg; 1/16/20 - 1:37pm

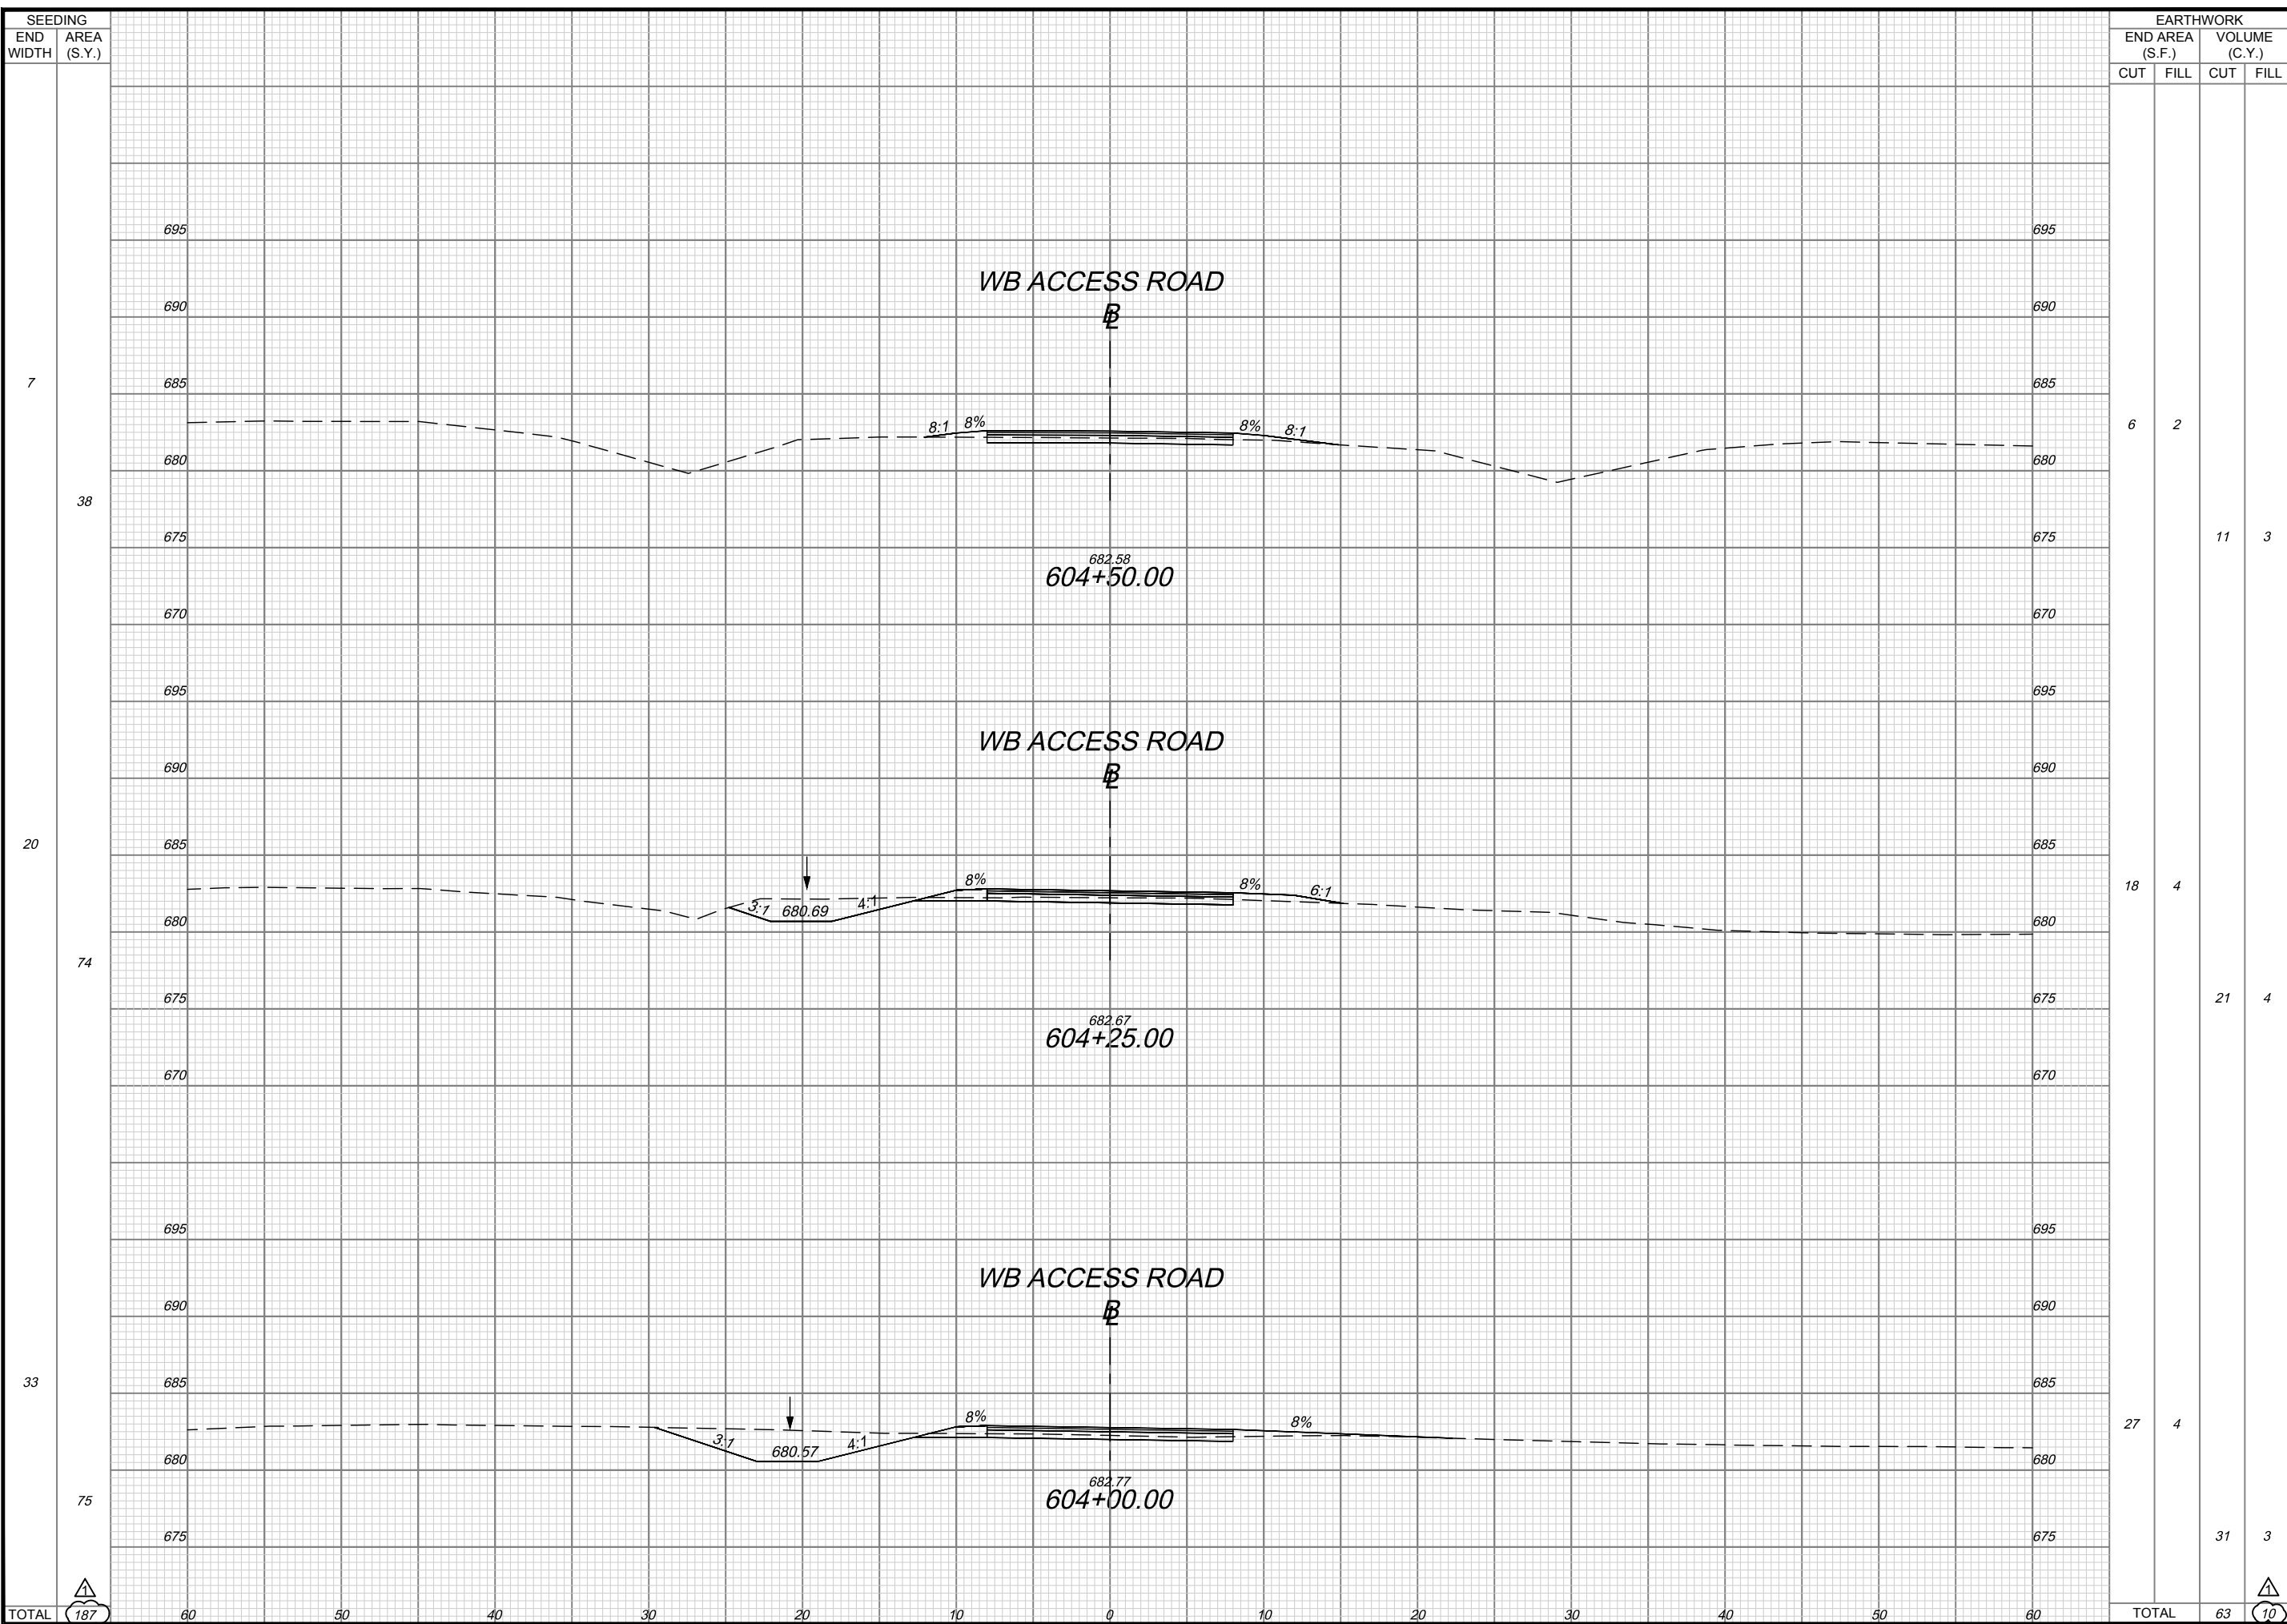

TOTAL	60	50	40	30	20	10	0	10	20	30	40	50	60
-------	----	----	----	----	----	----	---	----	----	----	----	----	----

SEEDING		EARTHWORK			
END WIDTH	AREA (S.Y.)	END AREA (S.F.)		VOLUME (C.Y.)	
		CUT	FILL	CUT	FILL
7		6	2		
38				11	3
20		18	4		
74				21	4
33		27	4		
75				31	3
TOTAL	187	TOTAL	63	TOTAL	10

PROJECT 39-20-02B
 DATE: 12/20/2019
 WESTBOUND ACCESS ROAD CROSS SECTIONS
 STA. 604+00 TO STA. 604+50
 LUCAS COUNTY
 TP 49

JACOBS
 DESIGN AGENCY
 1231 JAMES ARNOLD BLVD
 OFFICE #130222

NO.	BY	DATE	REVISIONS
1	AMS	1/16/20	ADDENDUM NO. 2
	AMS		
	AMS		

DESIGNED	CHECKED	NO.
AMS	AMS	1
AMS	AMS	
AMS	AMS	

6 / 7
 53
 59

PROJECT NO. 39-20-02 - ESTIMATED QUANTITIES WORKSHEET

Ref. No.	Item No.	Item Description	Approx. Quantity	Unit	Unit Cost	Extended Bid Amount
		39-20-02A - ROADWAY (Ref. Nos. 1 - 67)				
1	201	CLEARING AND GRUBBING, AS PER PLAN	1	LS		\$ -
2	201	TREE REMOVED, 18" SIZE	119	EACH		\$ -
3	201	TREE REMOVED, 30" SIZE	58	EACH		\$ -
4	201	TREE REMOVED, 48" SIZE	6	EACH		\$ -
5	202	HEADWALL REMOVED	44	EACH		\$ -
6	202	PIPE REMOVED, 24" AND UNDER	2,104	FT		\$ -
7	202	PIPE REMOVED, OVER 24"	280	FT		\$ -
8	202	CATCH BASIN OR INLET REMOVED	26	EACH		\$ -
9	202	FENCE REMOVED	49,266	FT		\$ -
10	202	GUARDRAIL REMOVED, AS PER PLAN	13,057	FT		\$ -
11	202	PAVEMENT REMOVED, AS PER PLAN	177,709	SY		\$ -
12	202	CONCRETE BARRIER REMOVED	386	FT		\$ -
13	202	STRUCTURE REMOVED	2	EACH		\$ -
14	202	PORTIONS OF STRUCTURES REMOVED, AS PER PLAN	10	CY		\$ -
15	202	REMOVAL MISC.: CONCRETE CHANNEL REMOVED	200	SY		\$ -
16	202	REMOVAL MISC.: STEEL PLATE REMOVED	1	EACH		\$ -
17	202	REMOVAL MISC.: TEMPORARY SHEETING REMOVED	1	LS		\$ -
18	SPECIAL	PIPE CLEANOUT, 24" DIA AND UNDER	124	FT		\$ -
19	SPECIAL	PIPE CLEANOUT, 27" TO 48"	662	FT		\$ -
20	203	EXCAVATION	84,108	CY		\$ -
21	203	EMBANKMENT, AS PER PLAN	16,539	CY		\$ -
22	203	ROADWAY EXCAVATION AND EMBANKMENT	1,800	CY		\$ -
23	203	EXCAVATION INCLUDING EMBANKMENT CONSTRUCTION, AS PER PLAN	19,812	CY		\$ -
24	203	BORROW	9,906	CY		\$ -
25	203	GRANULAR MATERIAL, TYPE C	145	CY		\$ -
26	203	GRANULAR EMBANKMENT, AS PER PLAN (SHEAR KEY)	1,873	CY		\$ -
27	203	GRANULAR EMBANKMENT, AS PER PLAN (NO. 8 AGGREGATE)	60	CY		\$ -
28	204	SUBGRADE COMPACTION	227	SY		\$ -
29	204	EXCAVATION	178	CY		\$ -
30	204	GEOTEXTILE FABRIC, 712.09, TYPE A	600	SY		\$ -
31	204	GEOTEXTILE FABRIC, TYPE B	4,795	SY		\$ -
32	204	GEOTEXTILE FABRIC, 712.09, TYPE D	227	SY		\$ -
33	206	CEMENT STABILIZED SUBGRADE, 14 INCHES DEEP, AS PER PLAN	216,545	SY		\$ -
34	206	CEMENT STABILIZED SUBGRADE, 16 INCHES DEEP	12,000	SY		\$ -
35	206	CEMENT	10,280	TON		\$ -
36	206	CURING COAT, AS PER PLAN	13,470	GAL		\$ -
37	206	TEST ROLLING	140	HOURL		\$ -
38	206	PRE-PULVERIZATION, 10 INCHES DEEP, AS PER PLAN	6,785	SY		\$ -
39	206	FULL-DEPTH RECLAMATION, 12 INCHES, AS PER PLAN	6,785	SY		\$ -
40	206	FULL DEPTH RECLAMATION CURING COAT, AS PER PLAN	2,040	GAL		\$ -
41	209	LINER GRADING, AS PER PLAN	42,608	FT		\$ -
42	209	DITCH CLEANOUT, AS PER PLAN	2,000	FT		\$ -

PROJECT NO. 39-20-02 - ESTIMATED QUANTITIES WORKSHEET

Ref. No.	Item No.	Item Description	Approx. Quantity	Unit	Unit Cost	Extended Bid Amount
43	SP 304	GRANULAR MATERIAL	178	CY		\$ -
44	606	GUARDRAIL, TYPE MGS, WITH LONG STEEL POSTS	10,135	FT		\$ -
45	606	ANCHOR ASSEMBLY, MGS TYPE T	15	EACH		\$ -
46	606	ANCHOR ASSEMBLY, MGS TYPE A	1	EACH		\$ -
47	606	MGS BRIDGE TERMINAL ASSEMBLY, TYPE 1, WITH LONG STEEL POSTS	11	EACH		\$ -
48	606	MGS BRIDGE TERMINAL ASSEMBLY, TYPE 2	7	EACH		\$ -
49	SP 606A	ANCHOR ASSEMBLY, MGS TYPE E	15	EACH		\$ -
50	SP 606B	IMPACT ATTENUATOR, TYPE 2 (BI-DIRECTIONAL)	2	EACH		\$ -
51	607	FENCE, TYPE 47, AS PER PLAN	45,569	FT		\$ -
52	607	FENCELINE SEEDING AND MULCHING	49,266	FT		\$ -
53	SP 607	FENCE, TYPE CL, AS PER PLAN	3,697	FT		\$ -
54	SPECIAL	FENCELINE CLEARING AND GRUBBING	49,266	FT		\$ -
55	609	ASPHALT CONCRETE CURB, TYPE 1, PG64-22	3,795	FT		\$ -
56	609	CURB, TYPE 4-C	135	FT		\$ -
57	622	CONCRETE BARRIER, SINGLE SLOPE, TYPE B-50, AS PER PLAN	227	FT		\$ -
58	622	CONCRETE BARRIER, END ANCHORAGE, REINFORCED, TYPE B-50, AS PER PLAN	4	EACH		\$ -
59	622	CONCRETE BARRIER, SINGLE SLOPE, TYPE C	3,248	FT		\$ -
60	622	CONCRETE BARRIER, END SECTION, TYPE C	2	EACH		\$ -
61	622	CONCRETE BARRIER, END ANCHORAGE, REINFORCED, TYPE C	6	EACH		\$ -
62	622	CONCRETE BARRIER, SINGLE SLOPE, TYPE D, AS PER PLAN	200	FT		\$ -
63	622	CONCRETE BARRIER, END SECTION, TYPE D, AS PER PLAN	14	EACH		\$ -
64	622	CONCRETE BARRIER, END ANCHORAGE, REINFORCED, TYPE D, AS PER PLAN	3	EACH		\$ -
65	SP 626	BARRIER REFLECTOR, TYPE A	175	EACH		\$ -
66	SP 626	BARRIER REFLECTOR, TYPE B	88	EACH		\$ -
67	861	GEOGRID FOR SUBGRADE STABILIZATION, AS PER PLAN, TENSAR TRIAX 160 GEOGRID	227	SY		\$ -
TOTAL - 39-20-02A - ROADWAY						\$ -

39-20-02A - EROSION CONTROL (Ref. Nos. 68-91)						
68	SP 113	SWPPP MANAGEMENT	1	LS		\$ -
69	601	ROCK CHANNEL PROTECTION, TYPE B WITH FILTER	224	CY		\$ -
70	601	ROCK CHANNEL PROTECTION, TYPE C WITH FILTER	800	CY		\$ -
71	601	TIED CONCRETE BLOCK MAT, TYPE 1	136	SY		\$ -
72	659	SOIL ANALYSIS TEST	10	EACH		\$ -
73	659	TOPSOIL	12,080	CY		\$ -
74	659	SEEDING AND MULCHING	108,911	SY		\$ -
75	659	REPAIR SEEDING AND MULCHING	4,970	SY		\$ -
76	659	INTER-SEEDING	4,970	SY		\$ -
77	659	COMMERCIAL FERTILIZER	13.42	TON		\$ -
78	659	LIME	20.54	ACRE		\$ -
79	659	WATER	537	MGAL		\$ -
80	659	MOWING, AS PER PLAN	21.60	MILE		\$ -
81	660	DITCH EROSION PROTECTION MAT TYPE A	3,506	SY		\$ -

PROJECT NO. 39-20-02 - ESTIMATED QUANTITIES WORKSHEET

Ref. No.	Item No.	Item Description	Approx. Quantity	Unit	Unit Cost	Extended Bid Amount
82	671	EROSION CONTROL MAT, TYPE B	9,511	SY		\$ -
83	832	EROSION CONTROL	1	LS		\$ -
84	832	INLET PROTECTION	1,732	FT		\$ -
85	832	SLOPE DRAIN	200	FT		\$ -
86	832	CONSTRUCTION SEEDING AND MULCHING	183,714	SY		\$ -
87	832	PERIMETER FILTER FABRIC FENCE	8,580	FT		\$ -
88	832	FILTER FABRIC DITCH CHECK	3,840	FT		\$ -
89	832	CONSTRUCTION ENTRANCE	500	CY		\$ -
90	832	ROCK CHANNEL PROTECTION, TYPE C OR D, WITH FILTER	250	CY		\$ -
91	832	MISCELLANEOUS SEDIMENT REMOVAL	2,000	CY		\$ -
TOTAL - 39-20-02A - EROSION CONTROL						\$ -

39-20-02A - DRAINAGE (Ref. Nos. 92-119)						
92	602	CONCRETE MASONRY	3.4	CY		\$ -
93	SP 605	6" BASE PIPE UNDERDRAIN, WITH FABRIC WRAP (18")	42,536	FT		\$ -
94	SP 605	6" SHALLOW PIPE UNDERDRAIN, WITH FABRIC WRAP (24")	1,707	FT		\$ -
95	SP 605	6" SHALLOW PIPE UNDERDRAIN, WITH FABRIC WRAP (30")	48,269	FT		\$ -
96	SP 605	6" UNDERDRAIN OUTLET PIPE	2,425	FT		\$ -
97	SP 605	AGGREGATE DRAIN, TYPE 1, WITH FABRIC WRAP	200	FT		\$ -
98	SP 605	AGGREGATE DRAIN, TYPE 2, WITH FABRIC WRAP	200	FT		\$ -
99	SP 611	4" CONDUIT, TYPE E, 707.31 (TYPE CP)	255	FT		\$ -
100	SP 611	4" CONDUIT, TYPE F, 707.33	120	FT		\$ -
101	SP 611	12" CONDUIT, TYPE F, 707.33	1,112	FT		\$ -
102	SP 611	15" CONDUIT, TYPE B, 706.02	523	FT		\$ -
103	SP 611	18" CONDUIT, TYPE B, 706.02	80	FT		\$ -
104	SP 611	24" CONDUIT, TYPE B, 706.02	126	FT		\$ -
105	SP 611	30" CONDUIT, TYPE B, 706.02	217	FT		\$ -
106	SP 611	48" CONDUIT, TYPE A, 706.02, AS PER PLAN	136	FT		\$ -
107	SP 611	PRECAST REINFORCED CONCRETE OUTLET	81	EACH		\$ -
108	SP 611	CATCH BASIN, NO. CB-1	7	EACH		\$ -
109	SP 611	CATCH BASIN, NO. CB-1, AS PER PLAN	17	EACH		\$ -
110	SP 611	CATCH BASIN, NO. 6	2	EACH		\$ -
111	SP 611	CATCH BASIN, AS PER PLAN	1	EACH		\$ -
112	SP 611	INLET, NO. I-3C (ODOT)	4	EACH		\$ -
113	SP 611	WATER QUALITY BASIN	2	EACH		\$ -
114	SP 611	MANHOLE, NO. 3	2	EACH		\$ -
115	SPECIAL	12" PRECAST CONCRETE END SECTION	25	EACH		\$ -
116	SPECIAL	15" PRECAST CONCRETE END SECTION	18	EACH		\$ -
117	SPECIAL	18" PRECAST CONCRETE END SECTION	8	EACH		\$ -
118	SPECIAL	30" PRECAST CONCRETE END SECTION	3	EACH		\$ -
119	SPECIAL	48" PRECAST CONCRETE END SECTION	2	EACH		\$ -
TOTAL - 39-20-02A - DRAINAGE						\$ -

PROJECT NO. 39-20-02 - ESTIMATED QUANTITIES WORKSHEET

Ref. No.	Item No.	Item Description	Approx. Quantity	Unit	Unit Cost	Extended Bid Amount
39-20-02A - PAVEMENT (Ref. Nos. 120-135)						
120	252	FULL DEPTH PAVEMENT SAWING	47,400	FT		\$ -
121	254	PAVEMENT PLANING, ASPHALT CONCRETE (VARIABLE DEPTH)	670	SY		\$ -
122	SP 302	ASPHALT CONCRETE BASE, PG64-22 (SHOULDER)	10,339	CY		\$ -
123	SP 302	ASPHALT CONCRETE BASE, PG64-22	46,100	CY		\$ -
124	SP 304	AGGREGATE BASE (SHOULDER)	16,913	CY		\$ -
125	SP 304	AGGREGATE BASE	24,009	CY		\$ -
126	SP 304	AGGREGATE BASE (VARIABLE THICKNESS)	2,439	CY		\$ -
127	SP 402	ASPHALT CONCRETE INTERMEDIATE COURSE OR RECYCLED ASPHALT CONCRETE INTERMEDIATE COURSE, PG64-22	2,811	CY		\$ -
128	SP 402	ASPHALT CONCRETE INTERMEDIATE COURSE OR RECYCLED ASPHALT CONCRETE INTERMEDIATE COURSE, PG76-22 (FR)	6,064	CY		\$ -
129	SP 404	ASPHALT CONCRETE SURFACE COURSE, USING CRUSHED STONE, PG64-22	2,421	CY		\$ -
130	SP 404	ASPHALT CONCRETE SURFACE COURSE, USING CRUSHED SLAG, PG76-22 (FR)	5,217	CY		\$ -
131	SP 404A	JOINT SEALER	112,944	FT		\$ -
132	407	NON -TRACKING TACK COAT	36,570	GAL		\$ -
133	452	15-1/4" NON-REINFORCED PORTLAND CEMENT CONCRETE PAVEMENT, CLASS QC 1, AS PER PLAN	752	SY		\$ -
134	SP 627	STONE SHOULDER PROTECTION	356	CY		\$ -
135	SPECIAL	SONIC NAP ALERT PATTERN	18.35	MILE		\$ -
TOTAL - 39-20-02A - PAVEMENT						\$ -

39-20-02A - MAINTENANCE OF TRAFFIC (Ref. Nos. 136-167)						
136	614	WORK ZONE CROSSOVER LIGHTING SYSTEM	2	EACH		\$ -
137	614	WORK ZONE IMPACT ATTENUATOR FOR 24" WIDE HAZARDS (UNIDIRECTIONAL)	8	EACH		\$ -
138	614	REPLACEMENT SIGN	20	EACH		\$ -
139	614	ASPHALT CONCRETE FOR MAINTAINING TRAFFIC	300	CY		\$ -
140	614	PORTABLE CHANGEABLE MESSAGE SIGN, AS PER PLAN	1,900	DAY		\$ -
141	614	WORK ZONE LANE LINE, CLASS I, 642 PAINT (4" WHITE)	6.44	MILE		\$ -
142	614	WORK ZONE EDGE LINE, CLASS I, 642 PAINT (4" WHITE)	23.71	MILE		\$ -
143	614	WORK ZONE EDGE LINE, CLASS I, 642 PAINT (4" YELLOW)	17.36	MILE		\$ -
144	614	WORK ZONE EDGE LINE, CLASS I, 642 PAINT (6" WHITE)	1.19	MILE		\$ -
145	614	WORK ZONE EDGE LINE, CLASS I, 642 PAINT (6" YELLOW)	7.64	MILE		\$ -
146	614	WORK ZONE EDGE LINE, CLASS I, 642 PAINT (8" WHITE)	3.95	MILE		\$ -
147	614	WORK ZONE EDGE LINE, CLASS I, 642 PAINT (8" YELLOW)	3.95	MILE		\$ -
148	614	WORK ZONE CHANNELIZING LINE, CLASS I, 642 PAINT (8" WHITE)	17,726	FT		\$ -
149	SP 614	ZONE PERSON	20,000	HOUR		\$ -
150	SP 614B	WORK ZONE WHITE LANE LINE, 4 INCH	0.08	MILE		\$ -
151	SP 614B	WORK ZONE WHITE EDGE LINE, 4 INCH	0.40	MILE		\$ -
152	SP 614B	WORK ZONE YELLOW EDGE LINE, 4 INCH	0.32	MILE		\$ -
153	SP 614B	WORK ZONE YELLOW EDGE LINE, 6 INCH	0.08	MILE		\$ -
154	SP 614C	REMOVAL OF PAVEMENT MARKING	94.78	MILE		\$ -
155	616	WATER	2,000	M GAL		\$ -
156	SP 621	RAISED PAVEMENT MARKER-STIMSONITE MODEL 101 LPCR	50	EACH		\$ -

PROJECT NO. 39-20-02 - ESTIMATED QUANTITIES WORKSHEET

Ref. No.	Item No.	Item Description	Approx. Quantity	Unit	Unit Cost	Extended Bid Amount
157	SP 621	REPLACEMENT PRISMATIC RETRO-REFLECTOR	50	EACH		\$ -
158	SP 621	REPLACEMENT RAISED PAVEMENT MARKER CASTING-STIMSONITE MODEL 101 LPCR	50	EACH		\$ -
159	SP 622	32" PORTABLE BARRIER (WITH GLARE SCREEN)	1	LS		\$ -
160	SP 622	32" PORTABLE BARRIER (WITHOUT GLARE SCREEN)	1	LS		\$ -
161	SP 626	BARRIER REFLECTOR, TYPE A (WHITE)	50	EACH		\$ -
162	SP 626	BARRIER REFLECTOR, TYPE B	450	EACH		\$ -
163	SP 626A	CONSTRUCTION ZONE MARKER, ONE-WAY MODEL, WHITE	5,406	EACH		\$ -
164	SP 626A	CONSTRUCTION ZONE MARKER, ONE-WAY MODEL, YELLOW	2,792	EACH		\$ -
165	630	SIGNING, MISC.: ADDITIONAL SIGNS WITH SUPPORTS, AS DIRECTED BY THE CHIEF ENGINEER	500	SF		\$ -
166	SPECIAL	EXISTING CROSSOVER TO BE CLOSED / RE-OPENED	2	LS		\$ -
167	SPECIAL	SPEED MEASUREMENT MARKING, AS PER PLAN	10	EACH		\$ -
TOTAL - 39-20-02A - MAINTENANCE OF TRAFFIC						\$ -

39-20-02A - TRAFFIC CONTROL (Ref. Nos. 168-214)						
168	620	REMOVAL OF DELINEATOR	178	EACH		\$ -
169	620	DELINEATOR, POST MOUNTED, AS PER PLAN	178	EACH		\$ -
170	621	RAISED PAVEMENT MARKER REMOVED	470	EACH		\$ -
171	SP 621	REPLACEMENT PRISMATIC RETRO-REFLECTOR	550	EACH		\$ -
172	SP 621	RAISED PAVEMENT MARKER - STIMSONITE MODEL 101 LPCR	1,225	EACH		\$ -
173	625	GROUND ROD	32	EACH		\$ -
174	625	CONDUIT, 1 1/2", 725.051	960	FT		\$ -
175	625	CONDUIT, 4", 725.051	360	FT		\$ -
176	625	JUNCTION BOX, 12"x18"x24"	12	EACH		\$ -
177	SP 626	BARRIER REFLECTOR, TYPE B	540	EACH		\$ -
178	630	GROUND MOUNTED STRUCTURAL BEAM SUPPORT, S4x7.7	70.3	FT		\$ -
179	630	GROUND MOUNTED STRUCTURAL BEAM SUPPORT, W6x9	88.8	FT		\$ -
180	630	GROUND MOUNTED STRUCTURAL BEAM SUPPORT, W10x12	82.3	FT		\$ -
181	630	BARRIER MOUNTED STRUCTURAL BEAM SUPPORT, W8x18	48.9	FT		\$ -
182	630	GROUND MOUNTED STRUCTURAL BEAM SUPPORT FOUNDATION	12	EACH		\$ -
183	630	BREAKAWAY STRUCTURAL BEAM CONNECTION	12	EACH		\$ -
184	630	SIGN ERECTED, FLAT SHEET, AS PER PLAN	183	EACH		\$ -
185	630	SIGN ERECTED, EXTRUSHEET, AS PER PLAN	40	EACH		\$ -
186	630	CONCRETE MEDIAN BARRIER OVERHEAD SIGN SUPPORT FOUNDATION, TYPE TC-21.50, AS PER PLAN	4	EACH		\$ -
187	630	RIGID OVERHEAD SIGN SUPPORT FOUNDATION, AS PER PLAN	22	EACH		\$ -
188	630	OVERHEAD SIGN SUPPORT, TYPE 7.65, DESIGN 8	8	EACH		\$ -
189	630	OVERHEAD SIGN SUPPORT, TYPE 7.65, DESIGN 8, AS PER PLAN	4	EACH		\$ -
190	630	OVERHEAD SIGN SUPPORT, TYPE 12.30, DESIGN 8	2	EACH		\$ -
191	630	OVERHEAD SIGN SUPPORT, TYPE 12.30, DESIGN 10	5	EACH		\$ -
192	630	OVERHEAD SIGN SUPPORT, TYPE 16.21, DESIGN 13	1	EACH		\$ -
193	630	SIGN POST REFLECTOR	82	EACH		\$ -
194	630	REMOVAL OF POLE MOUNTED SIGN AND DISPOSAL	5	EACH		\$ -
195	630	REMOVAL OF GROUND MOUNTED SIGN AND DISPOSAL	118	EACH		\$ -

PROJECT NO. 39-20-02 - ESTIMATED QUANTITIES WORKSHEET

Ref. No.	Item No.	Item Description	Approx. Quantity	Unit	Unit Cost	Extended Bid Amount
196	630	REMOVAL OF GROUND MOUNTED POST SUPPORT AND DISPOSAL	94	EACH		\$ -
197	630	REMOVAL OF GROUND MOUNTED MAJOR SIGN AND DISPOSAL	7	EACH		\$ -
198	630	REMOVAL OF GROUND MOUNTED STRUCTURAL BEAM SUPPORT AND DISPOSAL	12	EACH		\$ -
199	630	REMOVAL OF OVERHEAD SIGN SUPPORT AND DISPOSAL, TYPE TC-7.65	2	EACH		\$ -
200	630	REMOVAL OF OVERHEAD SIGN SUPPORT AND DISPOSAL, TYPE TC-12.30	5	EACH		\$ -
201	630	REMOVAL OF OVERHEAD SIGN SUPPORT AND DISPOSAL, TYPE TC-17.10	1	EACH		\$ -
202	630	REMOVAL OF OVERHEAD MOUNTED SIGN AND DISPOSAL	18	EACH		\$ -
203	630	SIGNING, MISC.: MILEPOST AND TENTH MILEPOST SIGNS REMOVED	178	EACH		\$ -
204	630	SIGNING, MISC.: TENTH MILEPOST SIGN ERECTED	160	EACH		\$ -
205	631	SIGN LIGHTING MISC.: REMOVE SIGN LIGHTING AND SIGN SERVICE	2	EACH		\$ -
206	632	SAW CUTTING FOR PAVEMENT LOOPS	1,220	FT		\$ -
207	642	EDGE LINE, 6", TYPE 1	58.54	MILE		\$ -
208	642	LANE LINE, 6", TYPE 1	31.75	MILE		\$ -
209	642	DOTTED LINE, 6", TYPE 1	4,440	FT		\$ -
210	642	CHANNELIZING LINE, 12", TYPE 1	12,197	FT		\$ -
211	642	CHEVRON MARKING, 24", TYPE 1	970	FT		\$ -
212	642	LANE REDUCTION ARROW, TYPE 1	6	EACH		\$ -
213	642	WORD ON PAVEMENT, 96", TYPE 1	14	EACH		\$ -
214	SPECIAL	SPEED MEASUREMENT MARKING	20	EACH		\$ -
TOTAL - 39-20-02A - TRAFFIC CONTROL						\$ -

39-20-02A - LIGHTING (Ref. Nos. 215-237)						
215	625	CONNECTION, UNFUSED, PERMANENT	102	EACH		\$ -
216	625	CONNECTION, FUSED, PULL APART	96	EACH		\$ -
217	625	PULL BOX 725.08, 24"	4	EACH		\$ -
218	625	GROUND ROD	49	EACH		\$ -
219	625	TRENCH, 24" DEEP	5,747	FT		\$ -
220	625	TRENCH IN PAVED AREA	436	FT		\$ -
221	625	MEDIAN JUNCTION BOX	6	EACH		\$ -
222	625	NO. 4 AWG 2400 VOLT DISTRIBUTION CABLE	20,610	FT		\$ -
223	625	NO. 4 AWG GROUND CONDUCTOR	9,928	FT		\$ -
224	625	NO. 10 AWG POLE AND BRACKET CABLE	7,000	FT		\$ -
225	625	2" CONDUIT	5,956	FT		\$ -
226	625	3" CONDUIT	120	FT		\$ -
227	625	3" CONDUIT, JACKED OR DRILLED	107	FT		\$ -
228	625	CONTROL CENTER CABINET, COMPLETE	1	EACH		\$ -
229	625	LIGHT POLE FOUNDATION, 24"X 10' DEEP	28	EACH		\$ -
230	625	MEDIAN LIGHT POLE FOUNDATION, 10' DEEP	20	EACH		\$ -
231	625	LIGHT POLE CONVENTIONAL, AT20B40	28	EACH		\$ -
232	625	LIGHT POLE CONVENTIONAL, A20BB40	20	EACH		\$ -
233	625	LUMINAIRE, CONVENTIONAL, 388W, LED, TYPE II, MVOLT, AS PER PLAN	10	EACH		\$ -
234	625	LUMINAIRE, CONVENTIONAL, 388W, LED, TYPE IV, MVOLT, AS PER PLAN	18	EACH		\$ -

PROJECT NO. 39-20-02 - ESTIMATED QUANTITIES WORKSHEET

Ref. No.	Item No.	Item Description	Approx. Quantity	Unit	Unit Cost	Extended Bid Amount
235	625	LUMINAIRE, CONVENTIONAL, 214W, LED, TYPE III, MVOLT, AS PER PLAN	20	EACH		\$ -
236	625	LUMINAIRE, CONVENTIONAL, 83W, LED, TYPE III, MVOLT, AS PER PLAN	20	EACH		\$ -
237	625	PLASTIC CAUTION TAPE	6,220	FT		\$ -
TOTAL - 39-20-02A - LIGHTING						\$ -

39-20-02A - STRUCTURES 20 FT SPAN AND UNDER (MP 48.7) (Ref. Nos. 238-258)						
238	202	PORTIONS OF STRUCTURE REMOVED	1	LS		\$ -
239	203	EXCAVATION	96	CY		\$ -
240	203	GRANULAR MATERIAL, TYPE C (703.16)	96	CY		\$ -
241	204	GEOTEXTILE FABRIC, TYPE A	256	SY		\$ -
242	204	GEOTEXTILE FABRIC, TYPE D	288	SY		\$ -
243	503	COFFERDAMS AND EXCAVATION BRACING	1	LS		\$ -
244	503	UNCLASSIFIED EXCAVATION (WINGWALL FOOTINGS)	150	CY		\$ -
245	SP509	EPOXY COATED REINFORCING STEEL	7,449	LB		\$ -
246	510	DOWEL HOLES WITH NON-SHRINK, NON-METALLIC GROUT	124	EACH		\$ -
247	511	CLASS QC1 CONCRETE, RETAINING/WINGWALL NOT INCLUDING FOOTING	23	CY		\$ -
248	511	CLASS QC1 CONCRETE, FOOTING	61	CY		\$ -
249	512	TYPE 2 MEMBRANE WATERPROOFING	350	SY		\$ -
250	512	SEALING OF CONCRETE SURFACES (NON-EPOXY)	48	SY		\$ -
251	516	1" PREFORMED EXPANSION JOINT FILLER	49	SF		\$ -
252	518	POROUS BACKFILL WITH FILTER FABRIC	30	CY		\$ -
253	SP519A	PATCHING CONCRETE, BOX STRUCTURES	5	SF		\$ -
254	601	ROCK CHANNEL PROTECTION, TYPE B WITH FILTER	30	CY		\$ -
255	602	CONCRETE MASONRY	18	CY		\$ -
256	611	12' X 6'-3" CONDUIT, TYPE A, 706.05, AS PER PLAN	96	FT		\$ -
257	613	LOW STRENGTH MORTAR BACKFILL (TYPE 2)	7	CY		\$ -
258	SPECIAL	PIPE CLEANOUT, 12' (SPAN) X 6'-3" (RISE)	173	FT		\$ -
TOTAL - 39-20-02A - STRUCTURES 20 FT SPAN AND UNDER (MP 48.7)						\$ -

39-20-02A - STRUCTURES OVER 20 FT SPAN (M.P. 47.4 AND M.P. 47.5) (Ref. Nos. 259-261)						
259	202	APPROACH SLAB REMOVED	494	SY		\$ -
260	526	APPROACH SLAB (T=12"), AS PER PLAN	529	SY		\$ -
261	SP536	CONCRETE WEATHERPROOFING, APPROACH SLABS	491	SY		\$ -
TOTAL - 39-20-02A - STRUCTURES OVER 20 FT SPAN (M.P. 47.4 AND M.P. 47.5)						\$ -

39-20-02B - ROADWAY (Ref. Nos. 262 - 277)						
262	201	CLEARING AND GRUBBING	1	LS		\$ -
263	202	HEADWALL REMOVED	1	EACH		\$ -
264	202	PIPE REMOVED, 4" AND UNDER, AS PER PLAN	1,480	FT		\$ -
265	202	PIPE REMOVED, 24" AND UNDER	70	FT		\$ -
266	202	PUMP STATION DEMOLISHED	1	LS		\$ -
267	202	CONCRETE CURB REMOVED	1,936	FT		\$ -
268	202	PAVEMENT REMOVED	2,176	SY		\$ -
269	202	REMOVAL MISC.: CONCRETE CHANNEL REMOVED	110	SY		\$ -

PROJECT NO. 39-20-02 - ESTIMATED QUANTITIES WORKSHEET

Ref. No.	Item No.	Item Description	Approx. Quantity	Unit	Unit Cost	Extended Bid Amount
270	202	REMOVAL MISC.	1	LS		\$ -
271	203	EXCAVATION	40,797	CY		\$ -
272	203	EMBANKMENT	24,119	CY		\$ -
273	606	GUARDRAIL, TYPE MGS, WITH LONG STEEL POSTS	1,313.25	FT		\$ -
274	606	ANCHOR ASSEMBLY, MGS TYPE T	2	EACH		\$ -
275	607	FENCE, TYPE 47, AS PER PLAN	491	FT		\$ -
276	SP 626	BARRIER REFLECTOR, TYPE A	16	EACH		\$ -
277	SP 627	STONE SHOULDER PROTECTION (T=3")	38	CY		\$ -
TOTAL - 39-20-02B - ROADWAY						\$ -

39-20-02B - EROSION CONTROL (Ref. Nos. 278-285)						
278	651	TOPSOIL STOCKPILED	4,663	CY		\$ -
279	652	PLACING STOCKPILED TOPSOIL	4,256	CY		\$ -
280	659	SEEDING AND MULCHING	73,433	SY		\$ -
281	659	REPAIR SEEDING AND MULCHING	3,672	SY		\$ -
282	659	INTER-SEEDING	5,000	SY		\$ -
283	659	COMMERCIAL FERTILIZER	6.60	TON		\$ -
284	659	LIME	15.20	ACRE		\$ -
285	659	WATER	398	MGAL		\$ -
TOTAL - 39-20-02B - EROSION CONTROL						\$ -

39-20-02B - DRAINAGE (Ref. Nos. 286-297)						
286	601	ROCK CHANNEL PROTECTION TYPE C WITH FILTER	10	CY		\$ -
287	SP 605	6" BASE PIPE UNDERDRAIN, WITH FABRIC WRAP (18")	3,127	FT		\$ -
288	SP 605	6" SHALLOW PIPE UNDERDRAIN, WITH FABRIC WRAP (30")	5,804	FT		\$ -
289	SP 611	PRECAST REINFORCED CONCRETE OUTLET, AS PER PLAN	6	EACH		\$ -
290	SP 611	15" CONDUIT, TYPE B, 706.02	32	FT		\$ -
291	SP 611	12" CONDUIT, TYPE C, 707.33	145	FT		\$ -
292	SP 611	6" CONDUIT, TYPE B	200	FT		\$ -
293	SP 611	6" CONDUIT, TYPE E	200	FT		\$ -
294	SP 611	6" CONDUIT, TYPE F	200	FT		\$ -
295	611	MANHOLE, CATCH BASIN OR INLET ADJUST TO GRADE	2	EACH		\$ -
296	SPECIAL	12" PRECAST CONCRETE END SECTION	1	EACH		\$ -
297	SPECIAL	15" PRECAST CONCRETE END SECTION	2	EACH		\$ -
TOTAL - 39-20-02B - DRAINAGE						\$ -

39-20-02B - PAVEMENT (Ref. Nos. 298-309)						
298	209	LINEAR GRADING	5,981	FT		\$ -
299	SP 302	ASPHALT CONCRETE BASE, PG64-22 (SHOULDER)	1,955	CY		\$ -
300	SP 302	ASPHALT CONCRETE BASE, PG64-22	5,100	CY		\$ -
301	SP 302	ASPHALT CONCRETE BASE, PG64-22	787	CY		\$ -
302	SP 304	AGGREGATE BASE (SHOULDER)	2,674	CY		\$ -
303	SP 304	AGGREGATE BASE	2,550	CY		\$ -
304	SP 402	ASPHALT CONCRETE INTERMEDIATE COURSE OR RECYCLED ASPHALT CONCRETE INTERMEDIATE COURSE, PG64-22	423	CY		\$ -

PROJECT NO. 39-20-02 - ESTIMATED QUANTITIES WORKSHEET

Ref. No.	Item No.	Item Description	Approx. Quantity	Unit	Unit Cost	Extended Bid Amount
305	SP 402	ASPHALT CONCRETE INTERMEDIATE COURSE OR RECYCLED ASPHALT CONCRETE INTERMEDIATE COURSE, PG76-22 (FR)	744	CY		\$ -
306	SP 404	ASPHALT CONCRETE SURFACE COURSE, USING CRUSHED STONE, PG64-22	658	CY		\$ -
307	SP 404	ASPHALT CONCRETE SURFACE COURSE, USING CRUSHED SLAG, PG76-22 (FR)	637	CY		\$ -
308	SP 404A	JOINT SEALER	5,026	FT		\$ -
309	407	NON -TRACKING TACK COAT	4,813	GAL		\$ -
TOTAL - 39-20-02B - PAVEMENT						\$ -

39-20-02B - TRAFFIC CONTROL (Ref. Nos. 310)						
310	SP 642	EDGE LINE, 6", TYPE 1	1.12	MILE		\$ -
TOTAL - 39-20-02B - TRAFFIC CONTROL						\$ -

39-20-02 - GENERAL (Ref. Nos. 311-315)						
311	IB,ART.6	PREMIUM FOR CONTRACT PERFORMANCE BOND AND PAYMENT BOND	1	LS		\$ -
312	SP 614	MAINTAINING TRAFFIC	1	LS		\$ -
313	SP 619	FIELD OFFICE	1	LS		\$ -
314	SP 623	CONSTRUCTION LAYOUT SURVEY	1	LS		\$ -
315	624	MOBILIZATION	1	LS		\$ -
TOTAL - 39-20-02 - GENERAL						\$ -

PROJECT 39-20-02 - TOTAL BASE BID (REF. No. 1 THRU REF. No. 315)						
---	--	--	--	--	--	--

PROJECT NO. 39-20-02 - ESTIMATED QUANTITIES WORKSHEET

Ref. No.	Item No.	Item Description	Approx. Quantity	Unit	Unit Cost	Extended Bid Amount
-------------	-------------	------------------	---------------------	------	--------------	------------------------

NOTE: Bidders must complete following information below.

WASTE SITE 1 DEDUCT ALTERNATE

The Bidder may deposit waste material on the westbound side for the 39-20-02 Project as described on Plan Sheet 496 - 2/3. Such deduct alternate must be submitted with the Bidder's Bid, and all the requirements to fulfill the Alternate Work as described in the Plans. The Bidder must fill in "yes" or "no" in the space provided below as to whether a Waste Site Proposal is included with the Bid and must also enter an amount to be deducted from the Total Base Bid as a credit due to the Commission, should this Proposal be approved. (Refer to Articles 2.6.3 and 3.5.1 of the INSTRUCTIONS TO BIDDERS)

A **Waste Site 1 Deduct Alternate** Proposal is included in the Bid Submittal: _____ (yes or no)

Amount of **WASTE SITE 1 DEDUCT ALTERNATE**: _____

WASTE SITE 2 DEDUCT ALTERNATE

The Bidder may deposit waste material on the eastbound side for the 39-20-02 Project as described on Plan Sheet 497 - 3/3. Such deduct alternate must be submitted with the Bidder's Bid, and all the requirements to fulfill the Alternate Work as described in the Plans. The Bidder must fill in "yes" or "no" in the space provided below as to whether a Waste Site Proposal is included with the Bid and must also enter an amount to be deducted from the Total Base Bid as a credit due to the Commission, should this Proposal be approved. (Refer to Articles 2.6.3 and 3.5.1 of the INSTRUCTIONS TO BIDDERS)

A **Waste Site 2 Deduct Alternate** Proposal is included in the Bid Submittal: _____ (yes or no)

Amount of **WASTE SITE 2 DEDUCT ALTERNATE**: _____

TEMPORARY ACCESS DEDUCT ALTERNATE

The Bidder may request permission to construct one (1) or more Temporary Access entrances or exits at a site, sites of its own choice or either abandoned Service Plaza 2 (MP49). Such Deduct Alternate request must be submitted with the Bidder's Bid, and must include the information specified in SP 104 and will be considered subject to the conditions and provisions contained in said SP 104.

The Bidder must fill in "yes" or "no" in the space provided below as to whether a Temporary Access Proposal is included with the Bid and must also enter an amount to be deducted from the Total Base Bid as a credit due to the Commission, should this Proposal be approved. (Refer to Articles 2.6.3 and 3.5.1 of the INSTRUCTIONS TO BIDDERS)

A **Temporary Access Deduct Alternate** Proposal is included in the Bid Submittal: _____ (yes or no)

Amount of **TEMPORARY ACCESS DEDUCT ALTERNATE**: _____

PROJECT 39-20-02 - TOTAL BASE BID (REF. No. 1 THRU REF. No. 315) MINUS DEDUCT ALTERNATES				
---	--	--	--	--