
No Date/Description 7/6/12 BID & PERMIT 1 07.24.12 ADDENDUM 2

DATES AND REVISIONS

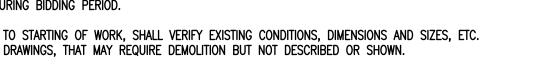


GENERAL CONTRACTOR SHALL MAKE PROVISIONS FOR TEMPORARY PROTECTION AND OR BARRIERS NECESSARY TO

4. EACH CONTRACTOR SHALL FIELD VERIFY ALL EXISTING CONDITIONS AND BE FAMILIAR WITH THE RULES AND REGULATIONS OF THE FEDERAL, STATE, COUNTY AND CITY. REPORT ALL DISCREPANCIES TO THE ARCHITECT.


5. SHUTDOWNS OF BUILDING SYSTEMS ARE NOT ACCEPTABLE. GENERAL CONTRACTOR MUST PROVIDE TEMPORARY UTILITIES TO THE PORTIONS BEING OCCUPIED. IF TEMPORARY SHUTDOWN IS REQUIRED, THE GENERAL CONTRACTOR MUST COORDINATE WITH THE ARCHITECT AND RECEIVE APPROVAL FROM THE OWNER PRIOR TO EACH DISRUPTION EVENT.

9. DEMOLITION OF STRUCTURAL, MECHANICAL, PLUMBING, FIRE PROTECTION OR ELECTRICAL ITEMS ENCOUNTERED IN AREAS INTENDED TO BE DEMOLISHED ARE DESCRIBED IN RESPECTIVE DRAWINGS AND SPECIFICATIONS. EACH CONTRACTOR

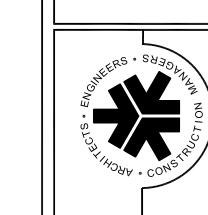

THIS ARCHITECTURAL AND

ENGINEERING DRAWING IS GIVEN IN CONFIDENCE. NO USE OR DISSEMINATION MAY BE MADE WITHOUT PRIOR WRITTEN CONSENT OF THE ARCHITECT. ALI RIGHTS ARE HEREBY SPECIFICALLY RESERVED.

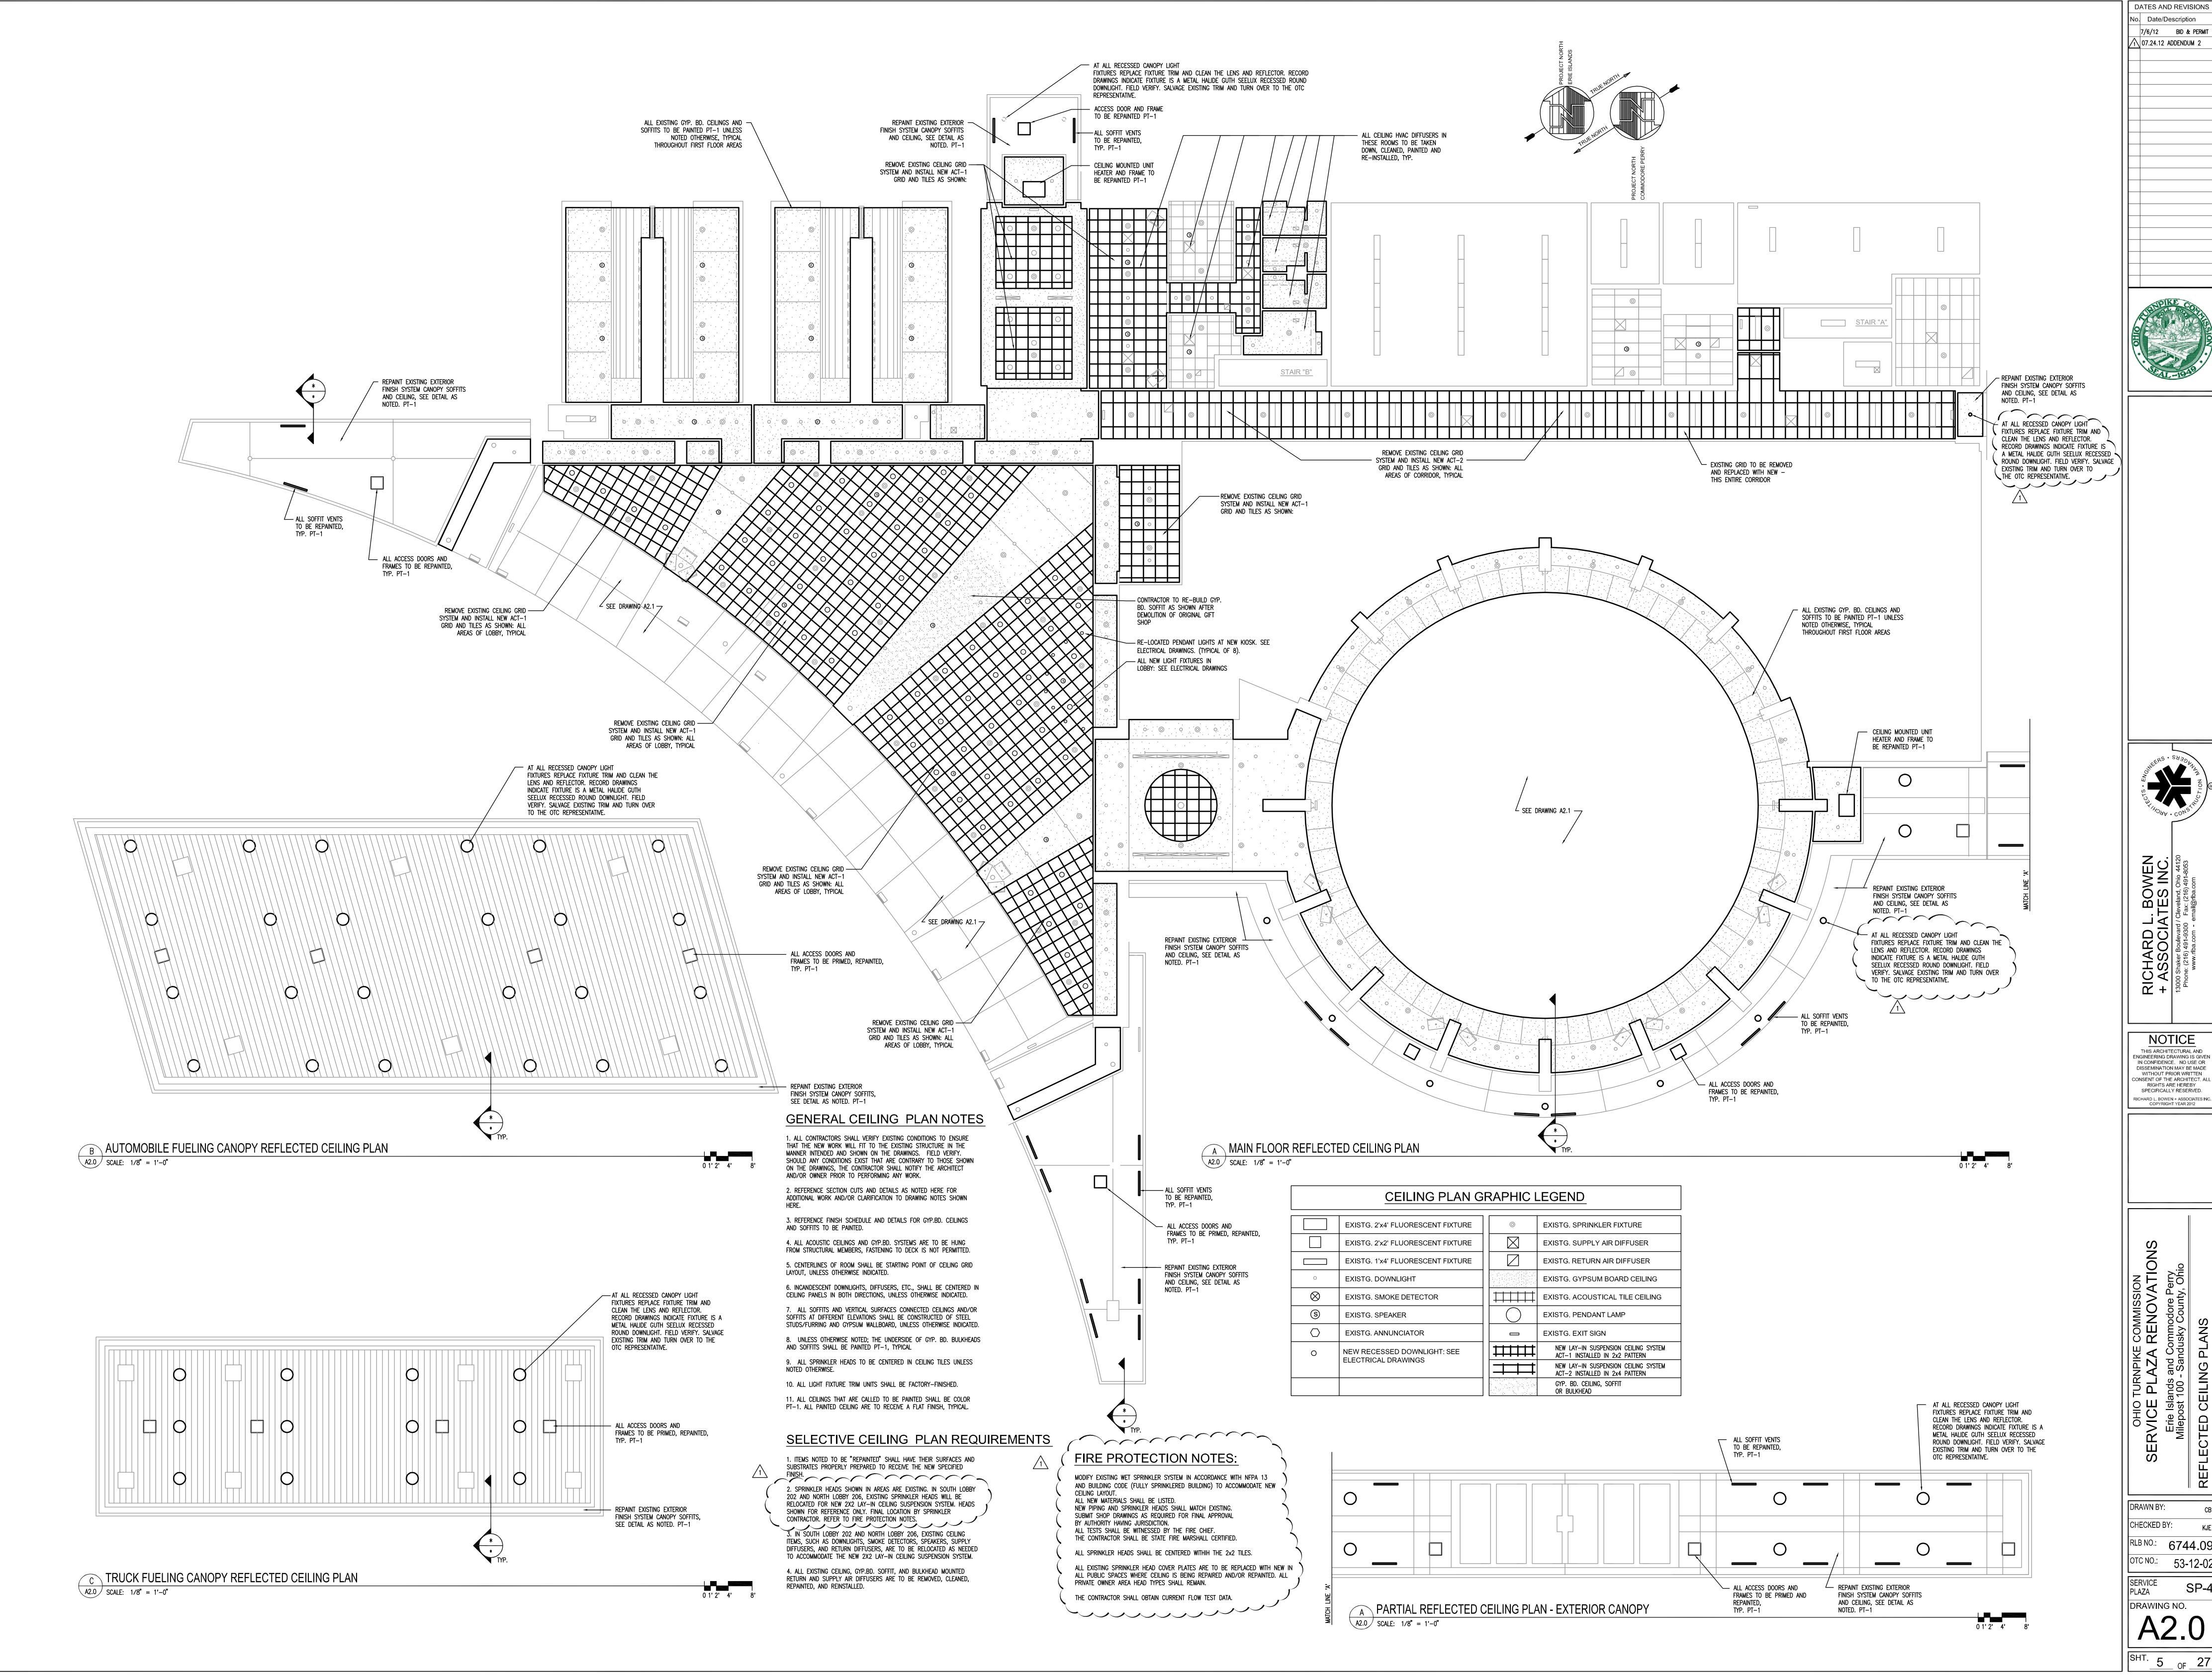


THIS ARCHITECTURAL AND ENGINEERING DRAWING IS GIVE IN CONFIDENCE. NO USE OR DISSEMINATION MAY BE MADE WITHOUT PRIOR WRITTEN CONSENT OF THE ARCHITECT. A SPECIFICALLY RESERVED.

| RLB NO.: 6744.09

OTC NO.: 53-12-02 SP-4


DRAWING NO.

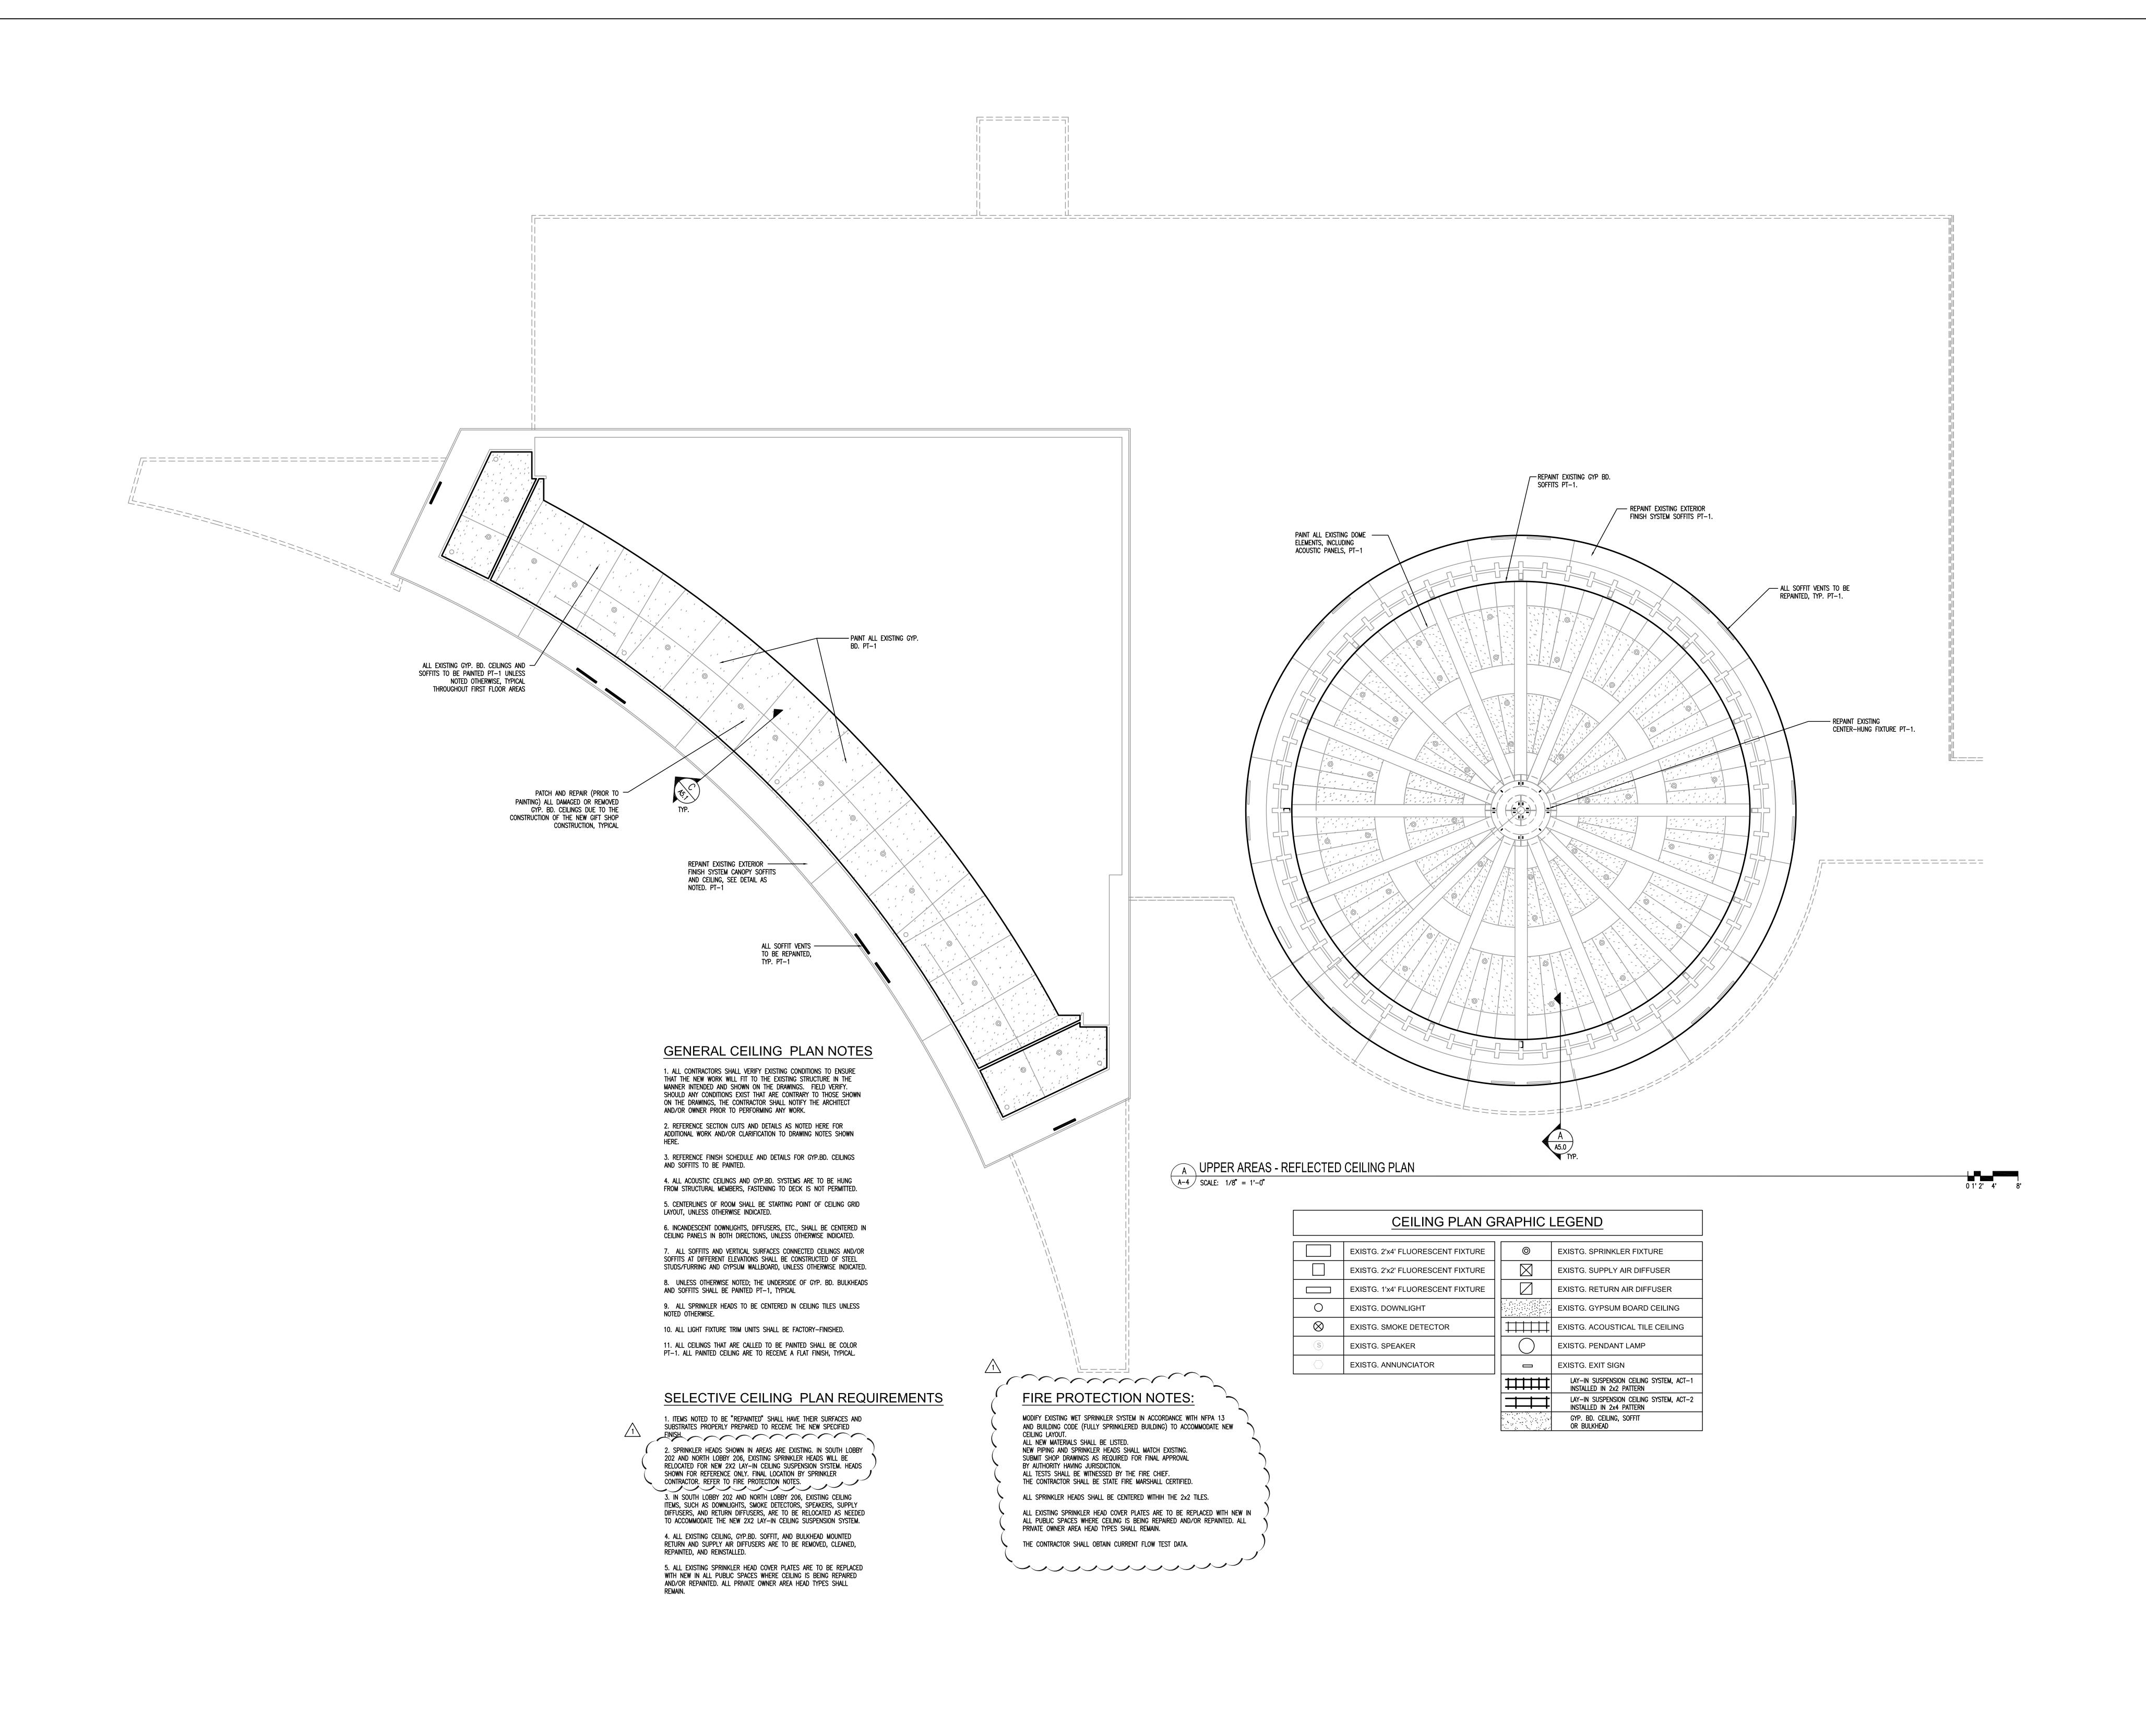


DATES AND REVISIONS

7/6/12 BID & PERMIT 1 07.24.12 ADDENDUM 2

No Date/Description

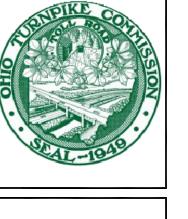

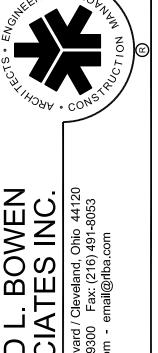

THIS ARCHITECTURAL AND

IN CONFIDENCE. NO USE OR
DISSEMINATION MAY BE MADE
WITHOUT PRIOR WRITTEN
CONSENT OF THE ARCHITECT. ALL RIGHTS ARE HEREBY

DRAWN BY: CHECKED BY: RLB NO.: 6744.09 OTC NO.: 53-12-02

SERVICE

PLAZA DRAWING NO.