* VARIES BASED ON LIMITS DESCRIBED BELOW

** WESTBOUND ⚠
VARIES FROM 9.5' @ STA. 298+65 TO 25.7' @ STA. 310+00 BK
VARIES FROM 26.7' @ STA. 310+00 AH TO 28.5' @ STA. 312+49 BK
VARIES FROM 19.8' @ STA. 312+49 AH TO 18.8' @ STA. 313+56.5
VARIES 18.8' @ STA. 321+71.5 TO 20.5' STA. 323+36 BK
STA. 323+36 AH TO STA. 325+00 BK = 28.5'
STA. 325+00 AH TO STA. 325+70 = 28.9'
VARIES 28.9' @ STA. 325+70 TO 17.0' @ STA. 334+05 BK
VARIES 15.0' @ STA. 334+05 AH TO 10.5' @ STA. 337+19.5
STA. 337+19.5 TO STA. 343+50 = 10.5'

** EASTBOUND ⚠
STA. 292+95 TO STA. 297+15 = 8.5'
VARIES FROM 8.5' @ STA. 297+15 TO 15.6' @ STA. 302+15 BK
VARIES FROM 17.6' @ STA. 302+15 AH TO 28.8' @ STA. 310+00 BK
STA. 310+00 TO STA. 312+51 BK = 28.5'
VARIES 20.0' @ STA. 312+51 AK TO 18.8' STA. 313+56.5
VARIES 19.0' @ STA. 321+71.50 TO 20.3' STA. 323+08 BK
323+08 AH TO STA. 325+00 BK = 28.5'
VARIES 26.8' @ STA. 325+00 AH TO 8.8' @ STA. 337+55

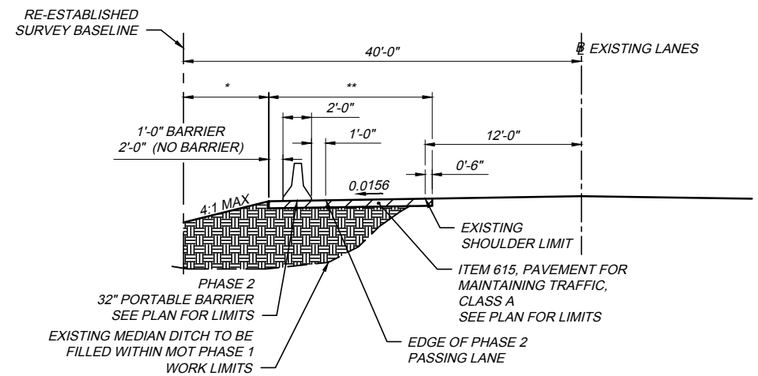

PHASE 2 TEMPORARY PAVEMENT TYPICAL SECTION

1. TO BE INSTALLED DURING PHASE 1.
2. EASTBOUND SHOWN, WESTBOUND OPPOSITE.
3. USE STANDARD SINGLE LANE CLOSURE PER STANDARD DRAWING TCR-2 UNDER PHASE 1 TO COMPLETE INSTALLATION AS NEEDED

TEMPORARY TRAFFIC CONTROL LEGEND

A	ITEM 614	WORK ZONE LANE LINE, CLASS 1, 642 PAINT
B	ITEM 614	WORK ZONE EDGE LINE, CLASS 1, 642 PAINT (WHITE)
C	ITEM 614	WORK ZONE EDGE LINE, CLASS 1, 642 PAINT (YELLOW)
D	ITEM 614	BARRIER REFLECTOR, TYPE B, YELLOW, PER ODOT STANDARD CONSTRUCTION DRAWING MT-101.70
E	ITEM 614	BARRIER REFLECTOR, TYPE B, WHITE, PER ODOT STANDARD CONSTRUCTION DRAWING MT-101.70
F	ITEM 614	OBJECT MARKER, TWO-WAY, PER ODOT STANDARD CONSTRUCTION DRAWING MT-101.70
G	ITEM SP 626A	CONSTRUCTION ZONE MARKER, EVERY 10' PER OTIC STANDARD CONSTRUCTION DRAWING TCR-12

Thomas Fok & Associates, Inc. 1976
Consulting Engineers & Surveyors
ASSOCIATED SBE & EDGE CERTIFIED
3896 Mahoning Avenue Youngstown OH 44515

NO.	REVISIONS	BY	DATE
1	ADDENDUM 5	SL	10/20
-	-	-	-
-	-	-	-

DESIGNED SDL | CHECKED WHT
DRAWN SDL | IN CHARGE SDL

MAINTENANCE OF TRAFFIC
TYPICAL SECTIONS

PROJECT 43-20-03
DATE: 11-27-19

OHIO TURNPIKE AND INFRASTRUCTURE COMMISSION