

OHIO TURNPIKE AND
INFRASTRUCTURE COMMISSION

ADDENDUM NO. 2

PROJECT NO. 56-16-03
CASTALIA MAINTENANCE BUILDING
SITE IMPROVEMENTS
MILEPOST 106.70
ERIE COUNTY, OHIO

OPENING DATE *PREVIOUSLY EXTENDED*: 2:00 P.M. (EASTERN TIME), JUNE 2, 2016

ALL BIDS MUST BE ELECTRONICALLY SUBMITTED THROUGH BID EXPRESS

ATTENTION OF BIDDERS IS DIRECTED TO:

ANSWERS TO QUESTIONS RECEIVED THROUGH 3:00PM ON MAY 26, 2016


-AND-


REVISIONS TO PLAN SHEETS 2 AND 3 OF 6

-AND-

MODIFICATIONS TO THE BID FORM AND ESTIMATED QUANTITIES WORKSHEET

Issued by the Ohio Turnpike and Infrastructure Commission on May 27, 2016. Issuance authorized by Anthony D. Yacobucci, Chief Engineer, and Mark R. Musson, Director of Contract Administration.

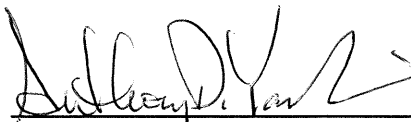
Anthony D. Yacobucci 5/27/16
Date

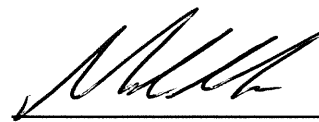
Mark R. Musson 5/27/16
Date

**OHIO TURNPIKE AND INFRASTRUCTURE COMMISSION
ADDENDUM NO. 2
PROJECT NO. 56-16-03**

QUESTIONS AND ANSWERS THROUGH 3:00 PM ON MAY 26, 2016

Q#2 There is a discrepancy between the unit of measure for the estimated quantity of Item No. 201 on the Bid Form (870 CU. YD.) and on Plan Sheet 2 of 6 under the General Note for Clearing Grubbing, Excavation and Embankment (870 SQ. YD). Please advise which unit of measure is correct.

A#2 The unit of measure for Bid Item 201 – CLEARING & GRUBBING, AS PER PLAN is modified to a lump sum pay item. This Addendum No. 2 revises the General Note (Plan Sheet 2 of 6) to provide that clearing and grubbing is estimated to require an area of approximately 870 square yards at a depth of 6 inches, and that it is to be a lump sum pay item. Further, the Bid Item 201 – CLEARING & GRUBBING, AS PER PLAN referenced in the General Summary (Plan Sheet 3 of 6) and Estimated Quantities Worksheet (Excel spreadsheet) is revised to a lump sum quantity. The Bid Schedule of Items is similarly modified to reflect the lump sum method of payment for Ref. No. 2, Item No. 201 Clearing & Grubbing, As Per Plan.

Q#3 Has the engineer taken into account the 6” topsoil strip in the Excavation and embankment qty’s for the detention Basin?

A#3 Yes, to the extent that the approximately 150 Cu. Yds. (870 Sq. Yds. x 6 inches deep) of excavated topsoil is to be placed as topsoil over the constructed embankment for the Equalization Pond. Also, the General Notes state that an additional 5 Cu. Yds. Of topsoil will be required to bring the existing surface to final grade in the equalization pond area.

Q#4 Where are we to put the costs for re-grading NW slope behind the Salt dome? Is there a qty of excavation for this work?

A#4 Based upon comparing the proposed grading plan to existing elevations in the area NW of the salt dome, the estimated quantities of excavation and embankment are provided in the General Notes. Additionally, as provided in the General Notes, “THE COST FOR ANY ONSITE EXCAVATION AND INSTALLATION OF SUITABLE EMBANKMENT MATERIAL GENERATED FROM THE SITE SHALL BE CONSIDERED INCIDENTAL TO THE PROJECT.” Therefore, the cost to move excavated material to areas onsite requiring embankment should be incorporated into with the selected bidder’s unit prices bid for Item 203 - EXCAVATION, AS PER PLAN.

MODIFIED CONTRACT DOCUMENTS

With this Addendum No. 2, the Commission substitutes the revised Plan Sheets 2 and 3 of 6 for the respective Plan Sheets originally included with the bid.

Additions to the Drawings are called out with a cloud and deletions are marked with a revision triangle as thus:



This Addendum No. 2 further modifications to the Bid Form and Estimated Quantities worksheet in the manner described in the reponse to Q#2.

Bidders Acknowledgment of Addendum No. 2
to Contract No. 56-16-03:

(Firm Name)

(Signature)






(Printed Name)

Date: _____

GENERAL SUMMARY

REF.	ITEM	ITEM	APPROX.	
No.	No.	DESCRIPTION	QUANTITY	UNIT
1	IB. ART.6	PREMIUM FOR CONTRACT PERFORMANCE BOND AND PAYMENT BOND	1	LUMP
2	201	CLEARING & GRUBBING, AS PER PLAN	870 1	CU. YD. LUMP
* 3	203	EXCAVATION, AS PER PLAN	3,487	CU. YD.
* 4	203	EMBANKMENT, AS PER PLAN	20	CU. YD.
5	204	PROOF ROLLING	2	HOUR
6	207	PERIMETER FILTER FABRIC FENCE	200	FOOT
7	207	INLET PROTECTION	75	FOOT
8	208	FILTER FABRIC DITCH CHECK	20	FOOT
9	302	ASPHALT CONCRETE BASE	1,984	CU. YD.
* 10	SP 304	AGGREGATE BASE (CONTINGENCY)	33	CU. YD.
11	448	ASPHALT CONCRETE INTERMEDIATE COURSE, TYPE 2 MEDIUM	741	CU. YD.
12	448	ASPHALT CONCRETE SURFACE COURSE, TYPE 1 MEDIUM	467	CU. YD.
13	451	6" REINFORCED CONCRETE PAVEMENT	40	SQ. YD.
* 14	601	DUMP ROCK FILL, AS PER PLAN (CONTINGENCY)	33	CU. YD.
15	601	ROCK CHANNEL PROTECTION, TYPE C WITH FILTER	30	CU. YD.
16	603	6" CONDUIT, TYPE C, 707.33	31	FOOT
17	603	12" CONDUIT, TYPE B, 707.33	195	FOOT
18	603	18" CONDUIT, TYPE B, 707.33	155	FOOT
19	603	18" CONDUIT, TYPE C, 707.33	16	FOOT
20	604	CATCH BASIN, AS PER PLAN	3	EACH
21	604	PRECAST REINFORCED CONCRETE OUTLET, AS PER PLAN (6" CONDUIT)	1	EACH
22	604	PRECAST REINFORCED CONCRETE OUTLET, AS PER PLAN (18" CONDUIT)	1	EACH
23	605	4" UNCLASSIFIED PIPE UNDERDRAINS, AS PER PLAN	765	FOOT
24	623	CONSTRUCTION LAYOUT STAKES	1	LUMP
25	624	MOBILIZATION	1	LUMP
26	659	SEEDING AND MULCHING, AS PER PLAN	900	SQ. YD.
27	671	EROSION CONTROL MAT, TYPE B, AS PER PLAN	660	SQ. YD.
28	SPECIAL	TRACKLESS TACK	2,505	GALLON
* 29	SPECIAL	GEOGRID, AS PER PLAN, TENSAR TRIAX 160 (CONTINGENCY)	100	SQ. YD.

* THE INDICATED BID ITEMS INCLUDE A CONTINGENCY QUANTITY. THE USE OF THESE QUANTITIES ARE DETAIL IN THE GENERAL NOTES ON SHEET 2 OF 2.

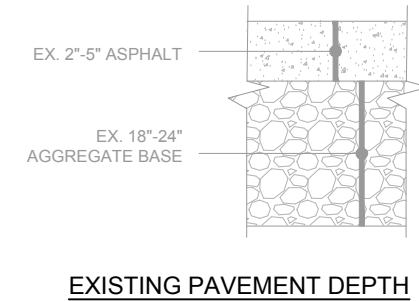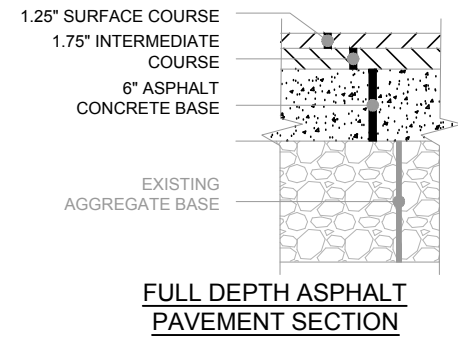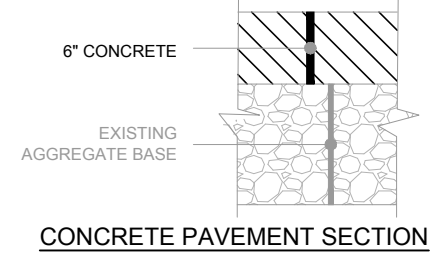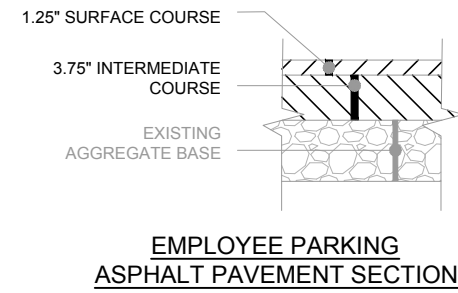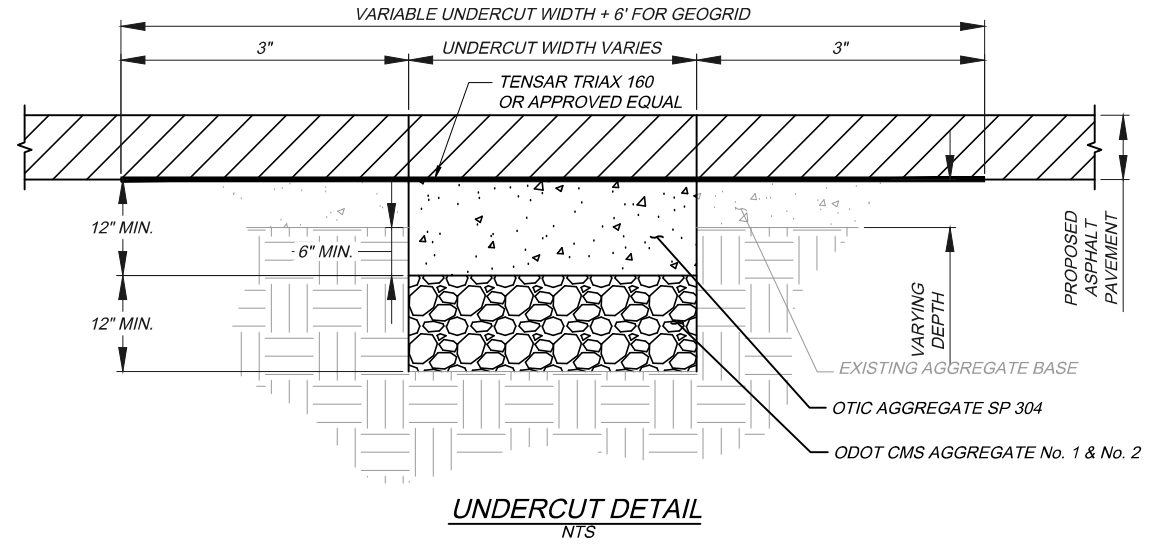

NOTE
THE CONTRACTOR SHALL EXCAVATE TO THE PROPER DEPTH TO INSTALL PROPOSED PAVEMENT AND ACHIEVE POSITIVE DRAINAGE.

	DESIGN AGENCY	BY DATE	A/JC	5/26
	REVISIONS	NO.	CHECKED	IN CHARGE
	CLEARING & GRUBBING TO LUMP SUM	1	JJS	DCA
DESIGNED	DRAWN	ERIC COUNTY		
A/JC	A/JC	M.P. 106.7 WESTBOUND		
GENERAL SUMMARY & DETAILS		CASTALIA MAINTENANCE BUILDING		
PROJECT 56-16-03		DATE: 4/29/2016		
3				
6				
OHIO TURNPIKE	OHIO TURNPIKE AND INFRASTRUCTURE COMMISSION			