MAINTENANCE OF TRAFFIC LEGEND

- DRUMS
- 32" PORTABLE BARRIER
- 32" BRIDGE-MOUNTED PORTABLE BARRIER
- IMPACT ATTENUATOR
- PHASE 1 WORK ZONE
- PHASE 2 WORK ZONE
- PHASE 2 TEMPORARY PAVEMENT (ITEM 615, CLASS A)
- TP - # TEMPORARY PAVEMENT
- PB - # PORTABLE BARRIER
- PBB - # BRIDGE-MOUNTED PORTABLE BARRIER
- CB - # TEMPORARY DRAINAGE STRUCTURE AND CONDUITS
- W8 - # WORK ZONE EDGE LINE, WHITE 8"
- Y8 - # WORK ZONE EDGE LINE, YELLOW 8"
- LL - # WORK ZONE LANE LINE, 6"
- W - # WORK ZONE EDGE LINE, WHITE 6"
- Y - # WORK ZONE EDGE LINE, YELLOW 6"
- CL - # WORK ZONE CHANNELIZING LINE, 8"
- CZM CONSTRUCTION ZONE MARKERS PER STANDARD CONSTRUCTION DRAWING TCR-12
- DIRECTION OF TRAVEL
- SIGN SUPPORT
- 223 MILEPOST REFERENCE
- .1 TENTH OF MILEPOST REFERENCE

MAINTENANCE OF TRAFFIC NOTES:

1. THE CONTRACTOR SHALL COVER OR REMOVE EXISTING CONFLICTING SIGNING AND COVER OR REMOVE EXISTING CONFLICTING PAVEMENT MARKING PRIOR TO CONSTRUCTION. PAVEMENT MARKINGS SHALL BE REMOVED UNLESS COVERED WITH NEW PAINTED LINES.
2. THE CONTRACTOR SHALL MAINTAIN ACCESS TO ALL RESIDENTIAL AND COMMERCIAL PROPERTIES AT ALL TIMES.
3. ALL MAINTENANCE OF TRAFFIC SIGNS SHALL BE SUPPLIED AND INSTALLED BY THE CONTRACTOR.
4. ALL TRAFFIC CONTROL DEVICES SHALL CONFORM TO THE CURRENT EDITION OF THE "OHIO MANUAL OF UNIFORM TRAFFIC CONTROL DEVICES"
5. THE CONTRACTOR SHALL FURNISH, ERECT, MAINTAIN AND SUBSEQUENTLY REMOVE ALL BARRICADES, SIGNS, SIGN SUPPORTS AND INCIDENTALS AS SHOWN
6. PAYMENT FOR ALL LABOR, EQUIPMENT AND MATERIALS SHALL BE CONSIDERED INCIDENTAL TO SP 614 MAINTAINING TRAFFIC UNLESS ITEMIZED SEPARATELY.
7. SEE SHEET 1 OF 15 FOR NOTICE OF CLOSURE SIGNING INFORMATION.
8. ROAD CLOSURE USING TYPE III BARRICADES, INCLUDING ADVANCE WARNING SIGNS, SHALL BE SET AS SHOWN ON ODOT STANDARD CONSTRUCTION DRAWING MT.-101.60.
9. INSTALL CONSTRUCTION ZONE MARKERS THROUGH SHIFTS PER TCR-12.
10. DRUMS ARE NOT REQUIRED WHERE TRAFFIC IS ADJACENT TO EXISTING GUARDRAIL DURING PHASE 1.
11. SEE PHASE 2 PLANS FOR TERMPORARY DRAINAGE WORK REQUIRED TO BE CONSTRUCTED UNDER PHASE 1.

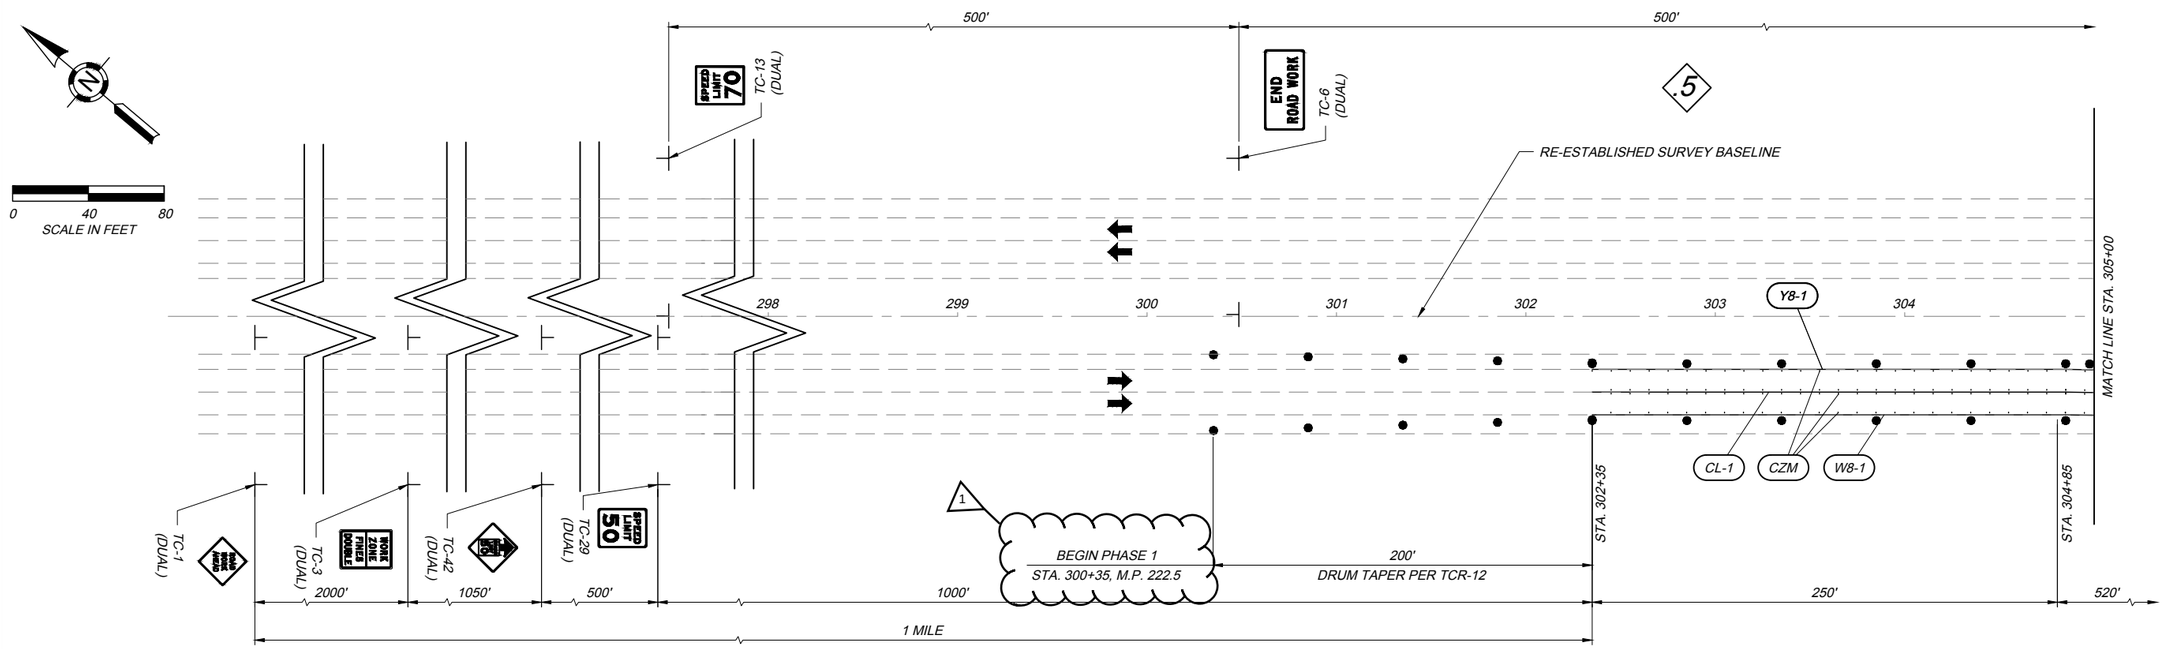

NO.	REVISIONS	BY	DATE
1	ADDENDUM 1	SL	9/20
-	-	-	-
-	-	-	-

DESIGNED SDL | CHECKED WHT | IN CHARGE SDL | DRAWN MBM

Thomas Fok & Associates, Inc. EST. 1976 — Consulting Engineers & Surveyors — SBE & EDGE CERTIFIED — ASSOCIATES — NORTHEASTERN OHIO — 3896 Mahoning Avenue Youngstown OH 44515

MAINTENANCE OF TRAFFIC PHASE 1
BEGIN PROJECT TO STA. 305+00

PROJECT 43-20-03
DATE: 11-27-19

9 / 15

14 / 105

OHIO TURNPIKE AND INFRASTRUCTURE COMMISSION

**SEE SHEET 9 OF 15 FOR MAINTENANCE OF TRAFFIC LEGEND AND NOTES

DESIGNED	CHECKED	NO.	REVISIONS	BY	DATE
SDL	WHT	1	ADDENDUM 1	SL	9/20
DRAWN	IN CHARGE	-	-	-	-
MBM	SDL	-	-	-	-

Thomas Fok & Associates, Inc. 1976
Consulting Engineers & Surveyors
SBE & EDGE CERTIFIED
3896 Mahoning Avenue Youngstown OH 44515

MAINTENANCE OF TRAFFIC PHASE 1
STA. 305+00 TO STA. 325+00

PROJECT 43-20-03
DATE: 11-27-19

10 / 15

15 / 105

OHIO TURNPIKE AND INFRASTRUCTURE COMMISSION

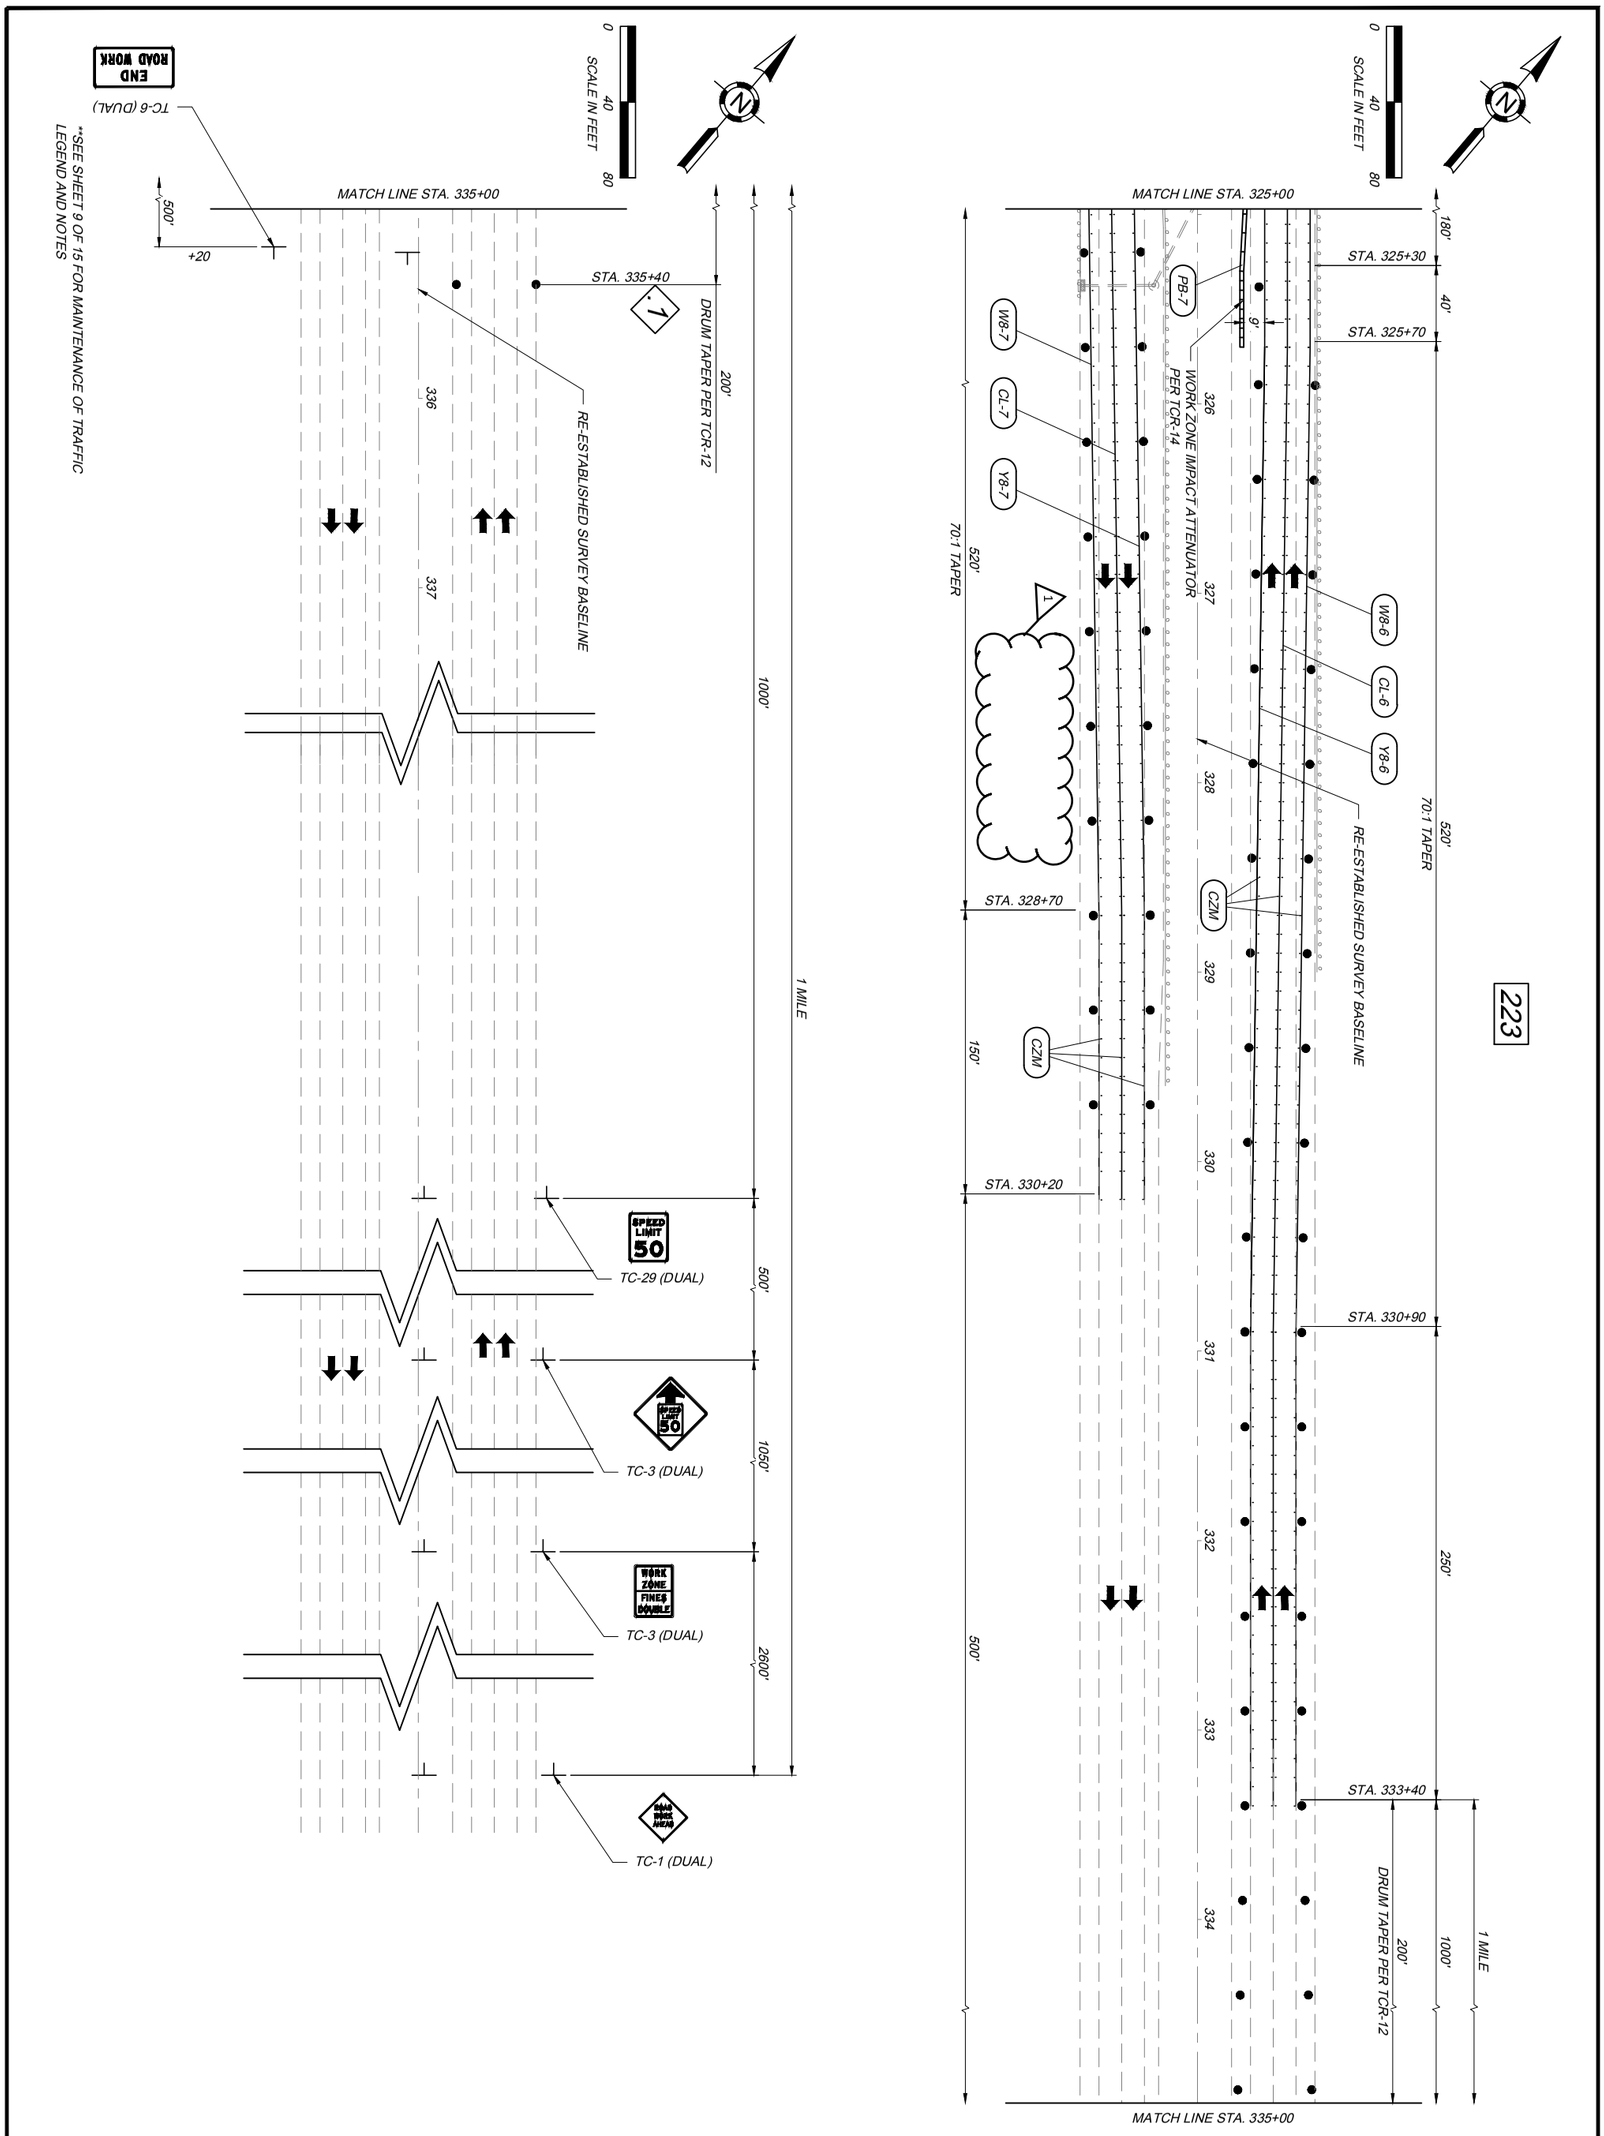

16/105	11/15	PROJECT 43-20-03	MAINTENANCE OF TRAFFIC PHASE 1	DESIGNED SDL	CHECKED WHT	NO. 1	REVISIONS ADDENDUM 1	BY SL	DATE 9/20
		DATE: 11-27-19	STA. 325+00 TO END PROJECT	DRAWN MBM	IN CHARGE SDL	-	-	-	-
						-	-	-	-

Thomas Fok & Associates, Inc. Consulting Engineers & Surveyors SBE & EDGE CERTIFIED CONSULTANT
3896 Mahoning Avenue Youngstown OH 44515

OHIO TURNPIKE AND INFRASTRUCTURE COMMISSION

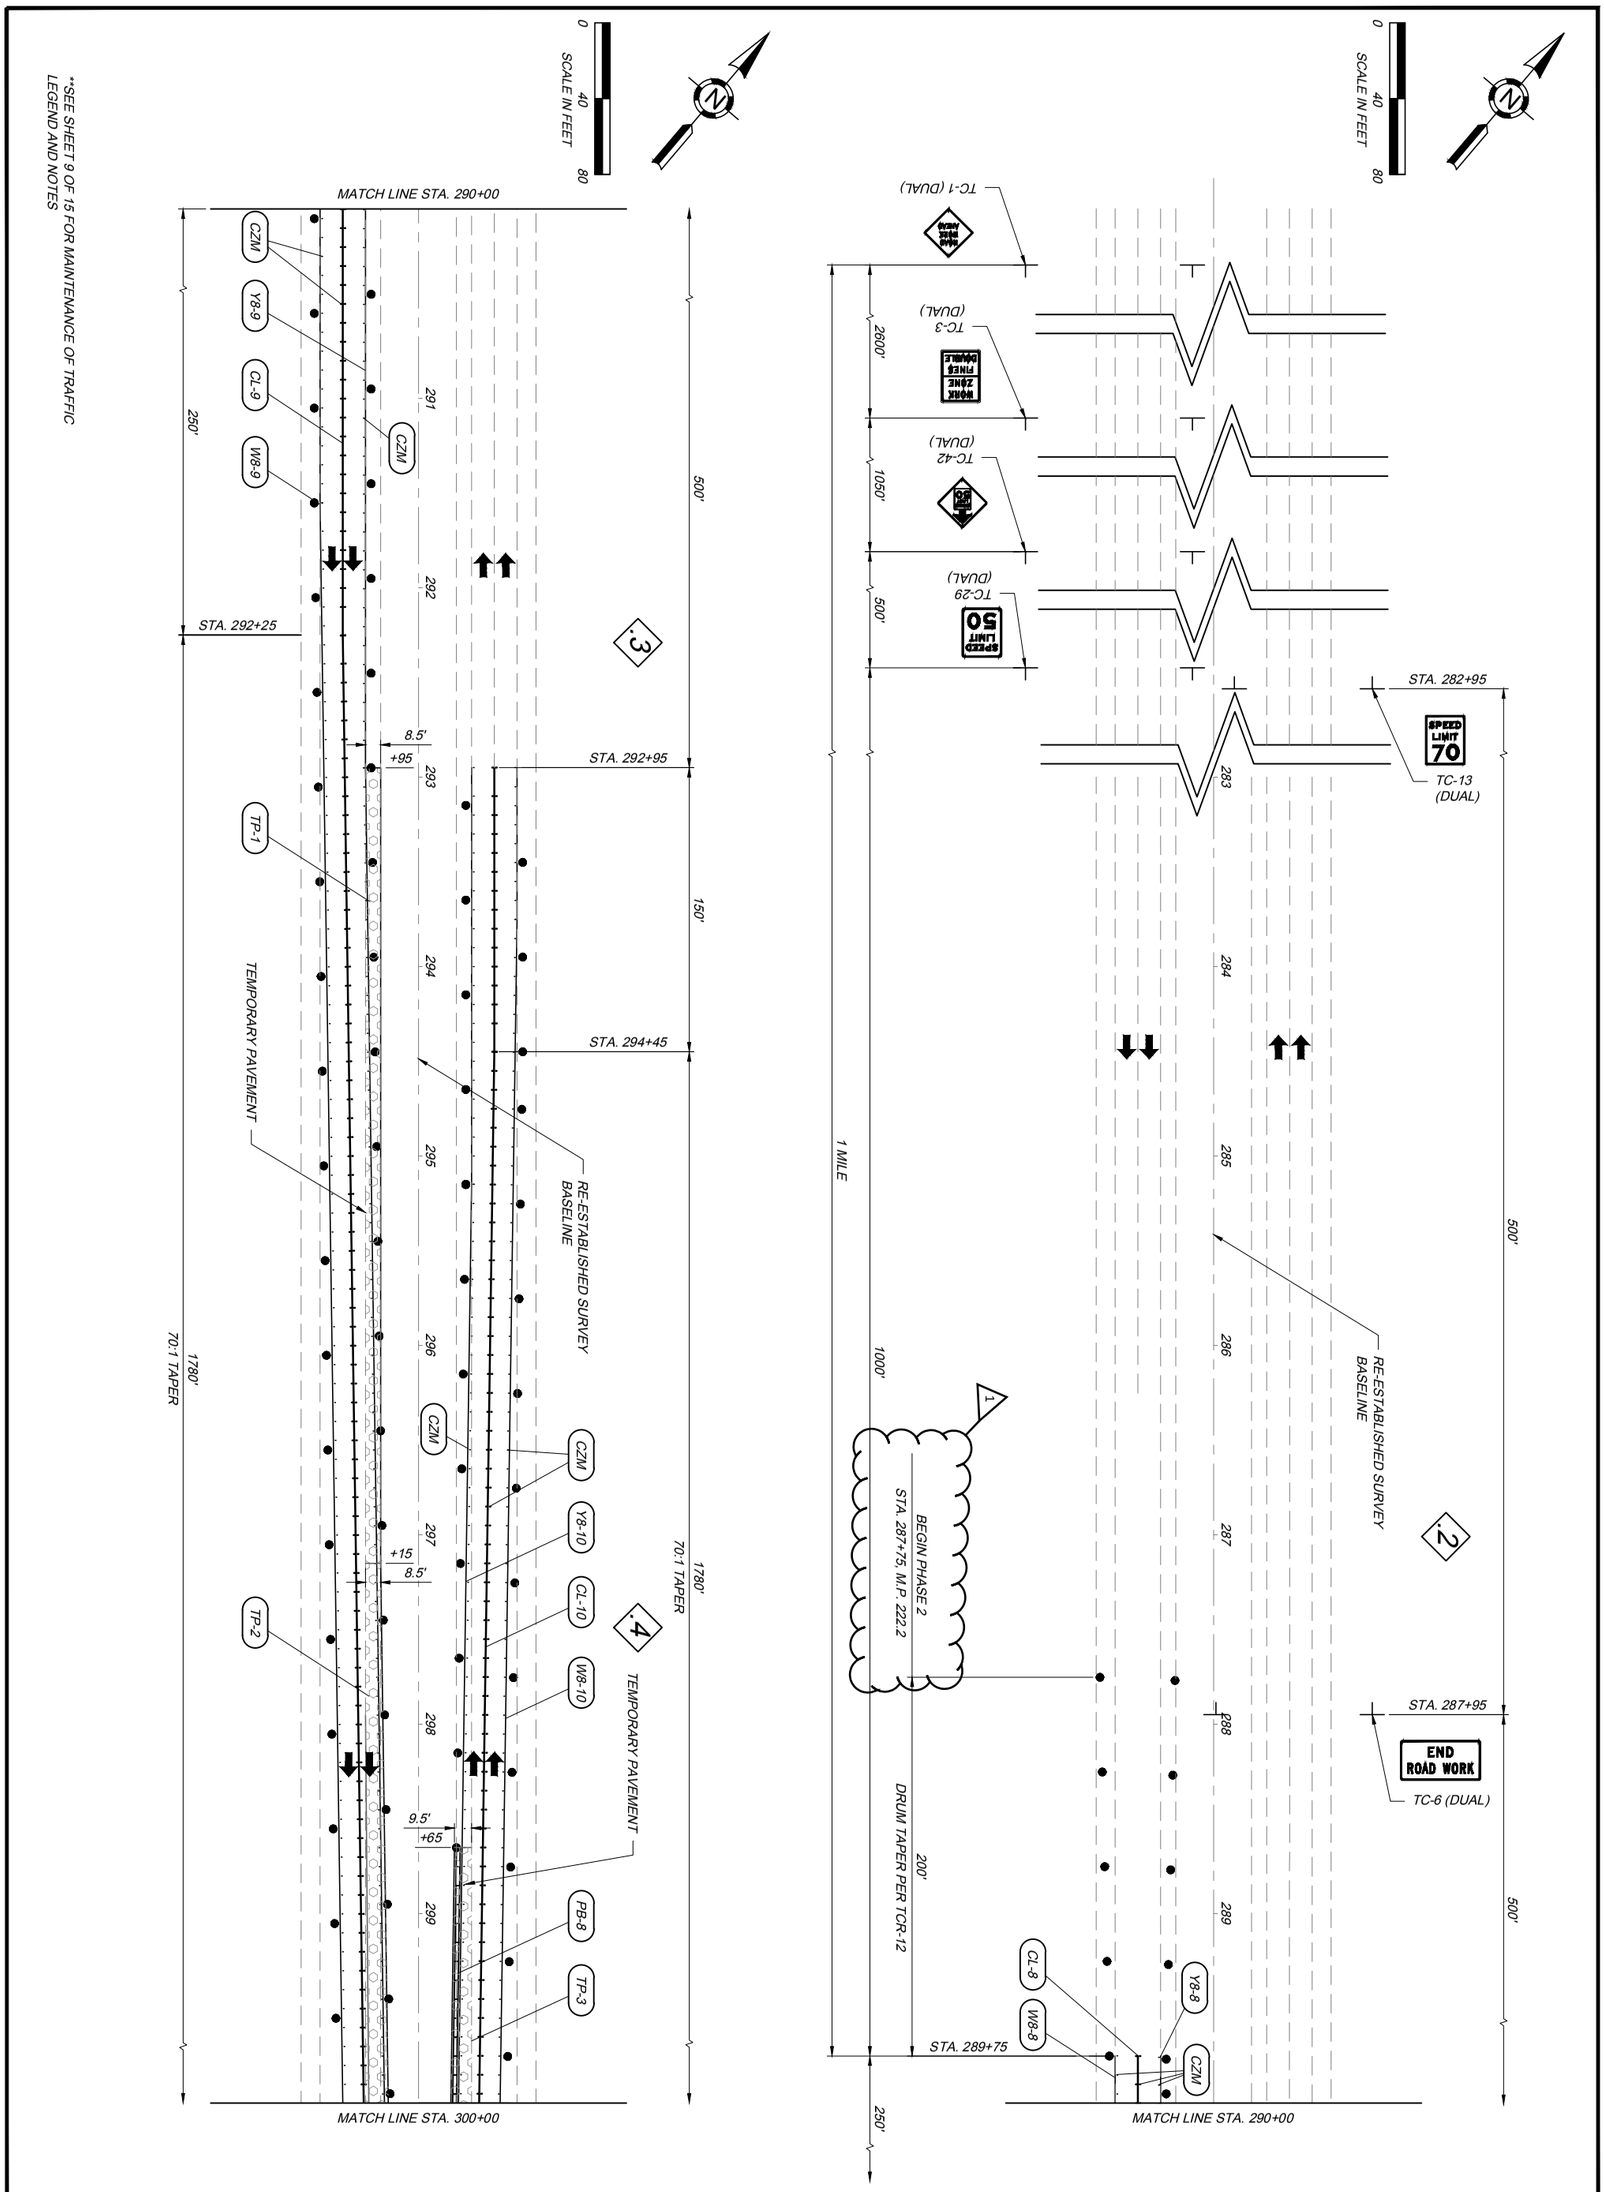

**SEE SHEET 9 OF 15 FOR MAINTENANCE OF TRAFFIC LEGEND AND NOTES

17/105	12/15	PROJECT 43-20-03	MAINTENANCE OF TRAFFIC PHASE 2	DESIGNED SDL	CHECKED WHT	NO.	REVISIONS	BY	DATE	Thomas Fok & Associates, Inc. Consulting Engineers & Surveyors SBE & EDGE CERTIFIED CONSULTANT	EST. 1976 NINETEEN SEVENTY SIX
		DATE: 11-27-19	BEGIN PROJECT TO STA. 300+00	DRAWN MBM	IN CHARGE SDL	1	ADDENDUM 1	SL	9/20	3896 Mahoning Avenue Youngstown OH 44515	

OHIO TURNPIKE AND INFRASTRUCTURE COMMISSION