



PHOTO 4



PHOTO 3

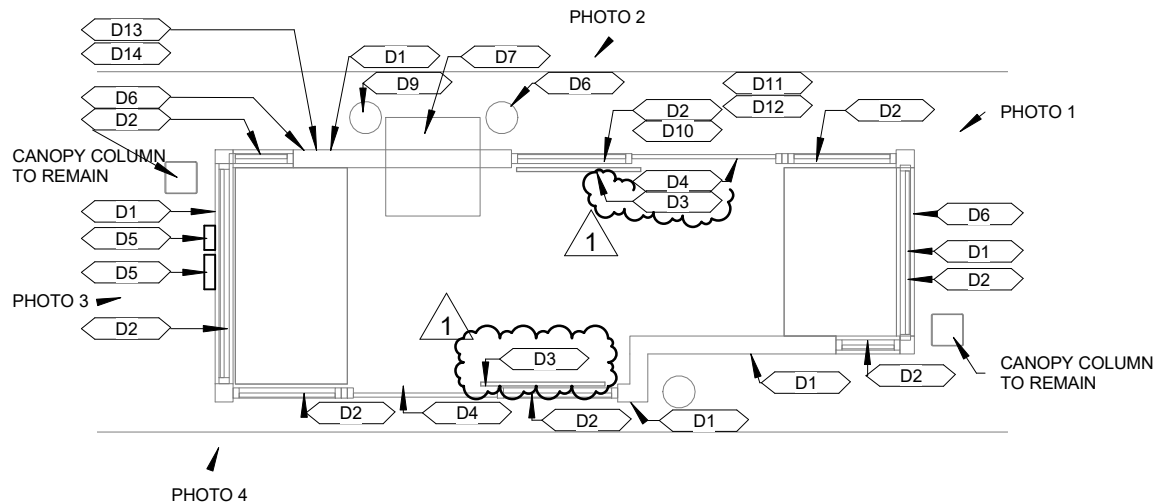


PHOTO 2



PHOTO 1

DEMOLITION NOTES			
D1	REMOVE ALL METAL SIDING, FLASHING, AND TRIM FROM EXTERIOR OF BOOTH UP TO CANOPY ABOVE	CHECKED	DATE
D2	REMOVE ALUM. FRAMED WINDOW SYSTEM AND GLAZING	MWM	5/13/20
D3	REMOVE DOOR AND HARDWARE	IN CHARGE	21
D4	REMOVE THRESHOLD	DRAWN	
D5	REMOVE JUNCTION BOX - CONDUIT TO REMAIN - PROTECT FROM WEATHER	MAK	
D6	REMOVE SIGNAGE - SALVAGE FOR REUSE		
D7	REMOVE TICKET PRINTING MACHINE - COORDINATE DISCONNECTION w/ OWNER		
D9	CUT DOWN BOLLARD TO + 6'-4" A.F.F. - REMOVE HORIZONTAL SECTION - CAP TOP OF VERTICAL PORTION TO REMAIN		
D10	REMOVE RAIN DIVERTER ABOVE DOOR		
D11	REMOVE DRIP EDGE AT ROOF		
D12	REMOVE BOOTH ROOFING		
D13	REMOVE METAL SIDING UP TO CANOPY ABOVE		
D14	REMOVE SHEATHING AND INSULATION - FRAMING TO REMAIN		



1 BOOTH PLAN
SCALE: 1/4" = 1'-0"