


4/19/2021 5:30:51 PM

GENERAL NOTES:

1. TERMINATIONS AT INDIVIDUAL DEVICES AND BOXES SHALL BE PERFORMED BY TCS INTEGRATOR.
2. DVAS CAMERA AND MOUNTING HARDWARE SHALL BE PROVIDED AND INSTALLED BY THE TCS INTEGRATOR. PULL CAT6 WIRE. ALL POLE MOUNTS SHALL HAVE 6' ADDITIONAL CAT6 WIRE COILED UP IN POLE AT CAMERA LOCATION.
3. DASHED ITEMS BY TCS INTEGRATOR. ALL OTHER ITEMS BY CONTRACTOR.
4. CAT6 CABLE BY CONTRACTOR SHALL BE COILED UP AT CAMERA MOUNT LOCATION ON POLE.
5. NEW DVAS CAMERA INSTALLED BY TCS INTEGRATOR AND ROTATED IN FIELD AS REQUIRED TO MEET OPERATIONAL SPECIFICATIONS.
6. TCS INTEGRATOR IS RESPONSIBLE FOR MOUNTING CAMERA ON POLE AND TERMINATING. PELCO MOUNT AND DVAS CAMERA PROVIDED BY TCS INTEGRATOR.
7. CONTRACTOR SHALL ROUTE DVAS COMMUNICATIONS CABLE TO J2 LANE CABINET THEN TO BUILDING COMMS ROOM.

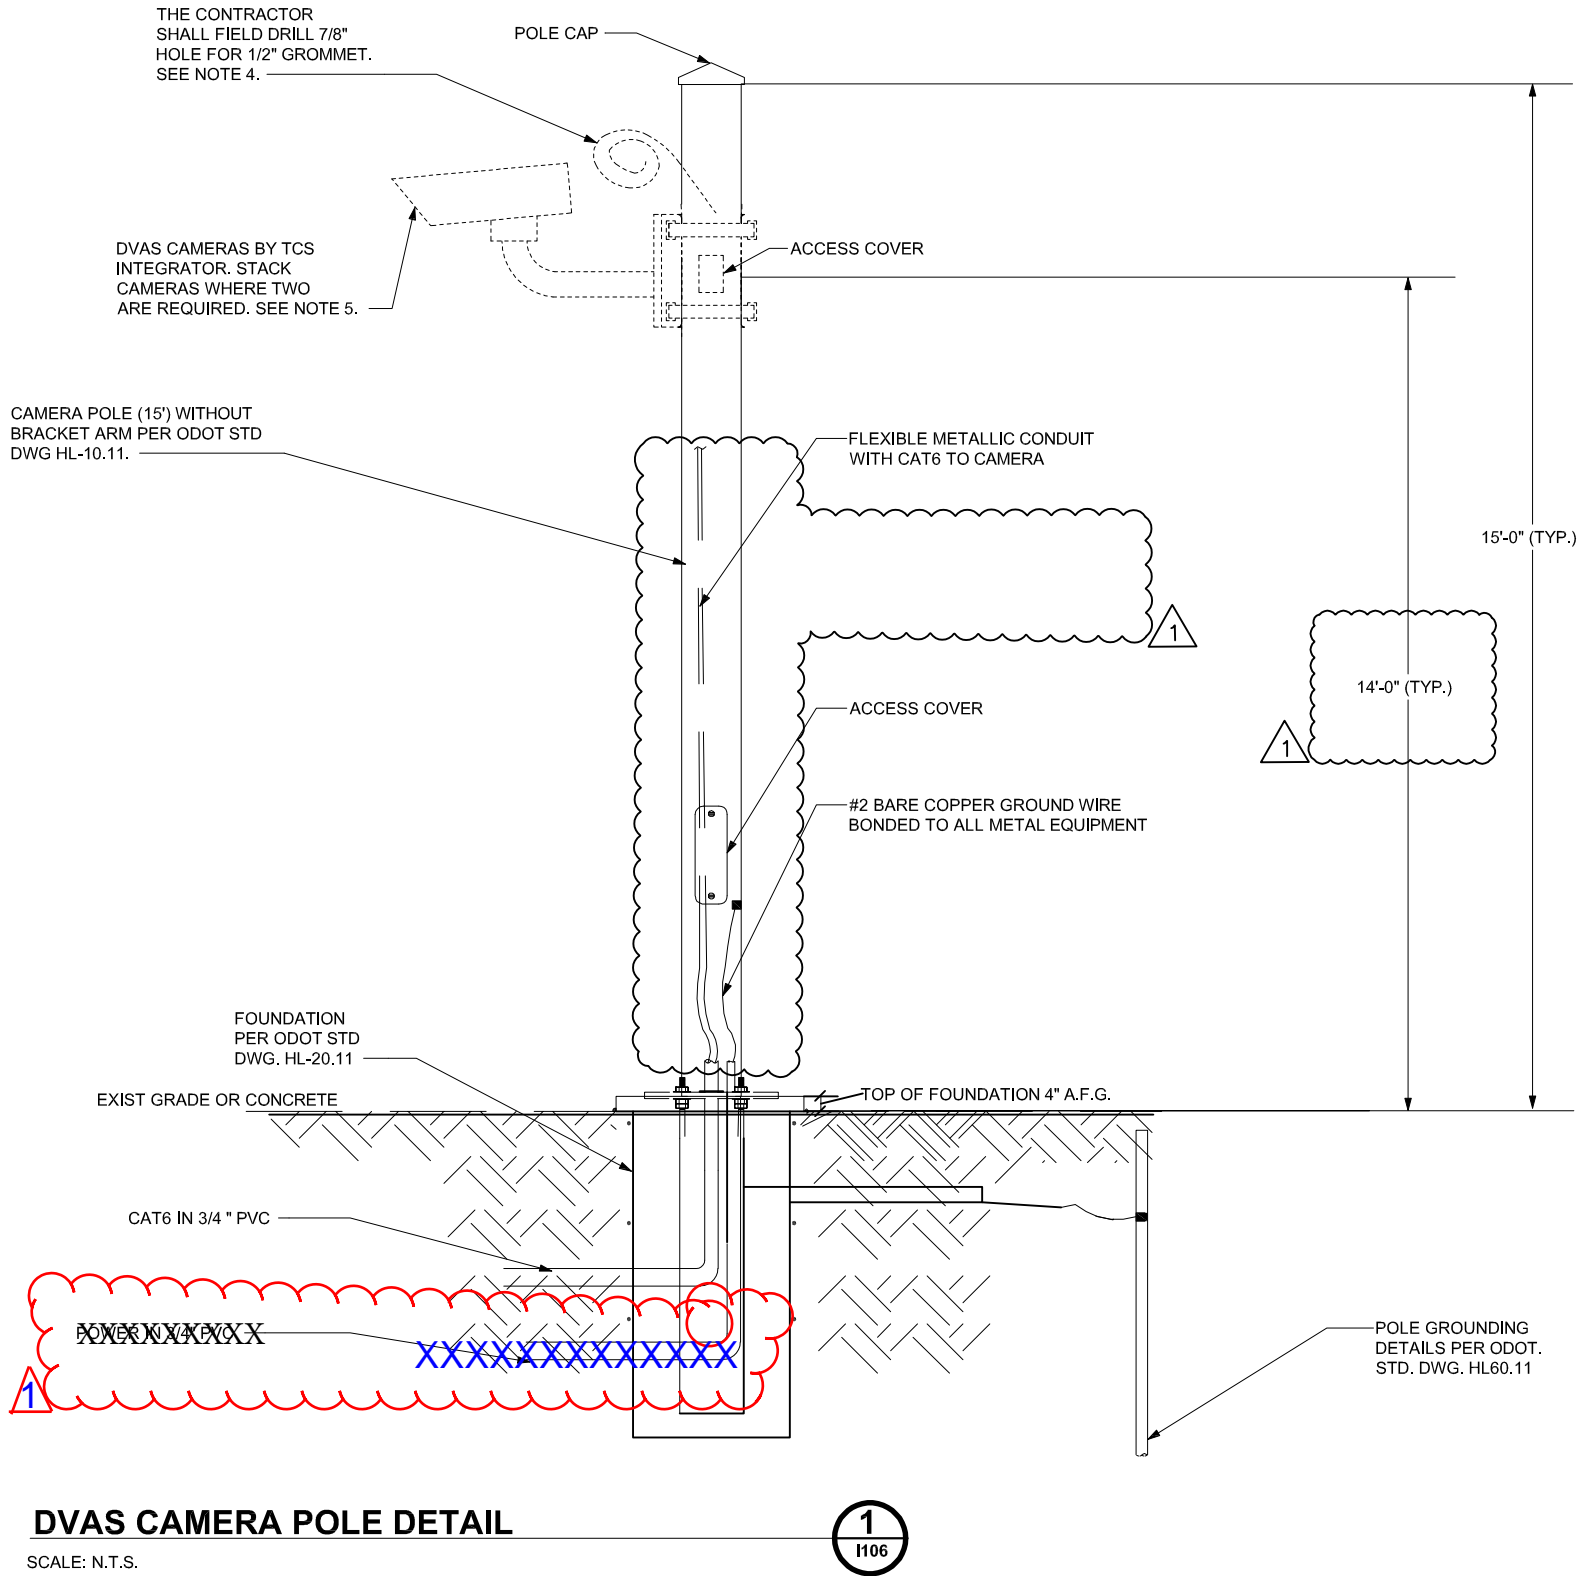

<div>189</div> <div>236</div>		1106	PROJECT 58-21-01	CAMERA POLE DETAIL		DESIGNED		CHECKED	NO.	REVISIONS	BY	DATE	DESIGN AGENCY	
			DATE: 4/19/2021	TOLL PLAZA 211		RNS		CEK	1	ADDENDUM #1		5/13/2021	PRIMEK* 540 White Pond Drive, Ste. E 3401 Old Orchard Rd (330)-884-7755	
				TRUMBULL COUNTY		DRAWN		IN CHARGE					OHIO TURNPIKE	
						RNS		CEK					OHIO TURNPIKE	