


CHECKING PRINT

CHECKED: _____ DATE: _____ CORRECTED: _____ DATE: _____


BACKCHECKED: _____ DATE: _____ APPROVED: _____ DATE: _____

1/10/2020 12:51:29 PM

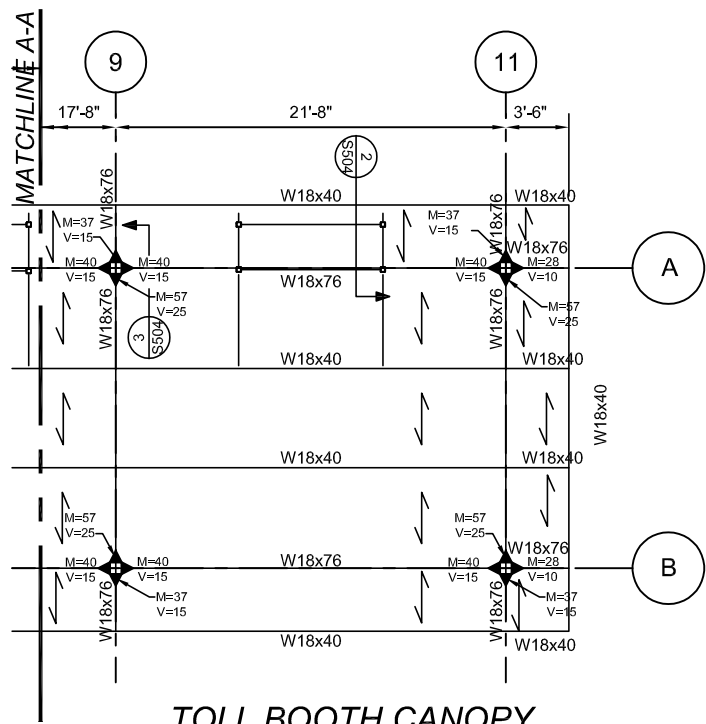


1 TOLL BOOTH CANOPY FRAMING PLAN (CONT.)

S104 SCALE: 3/32" = 1'-0"

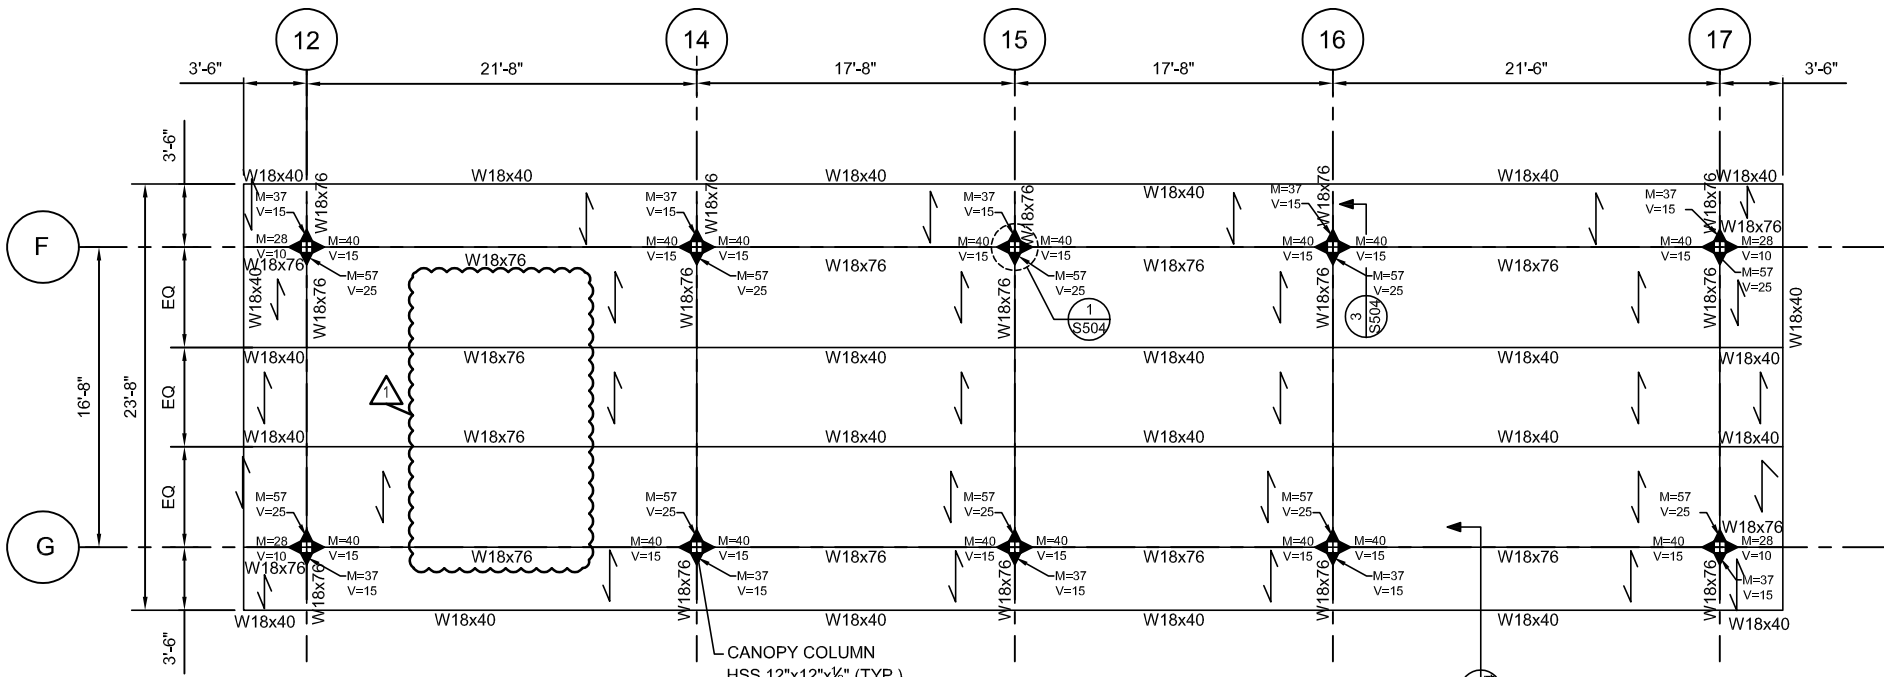

2 TOLL BOOTH CANOPY FRAMING PLAN


S104 SCALE: 3/32" = 1'-0"

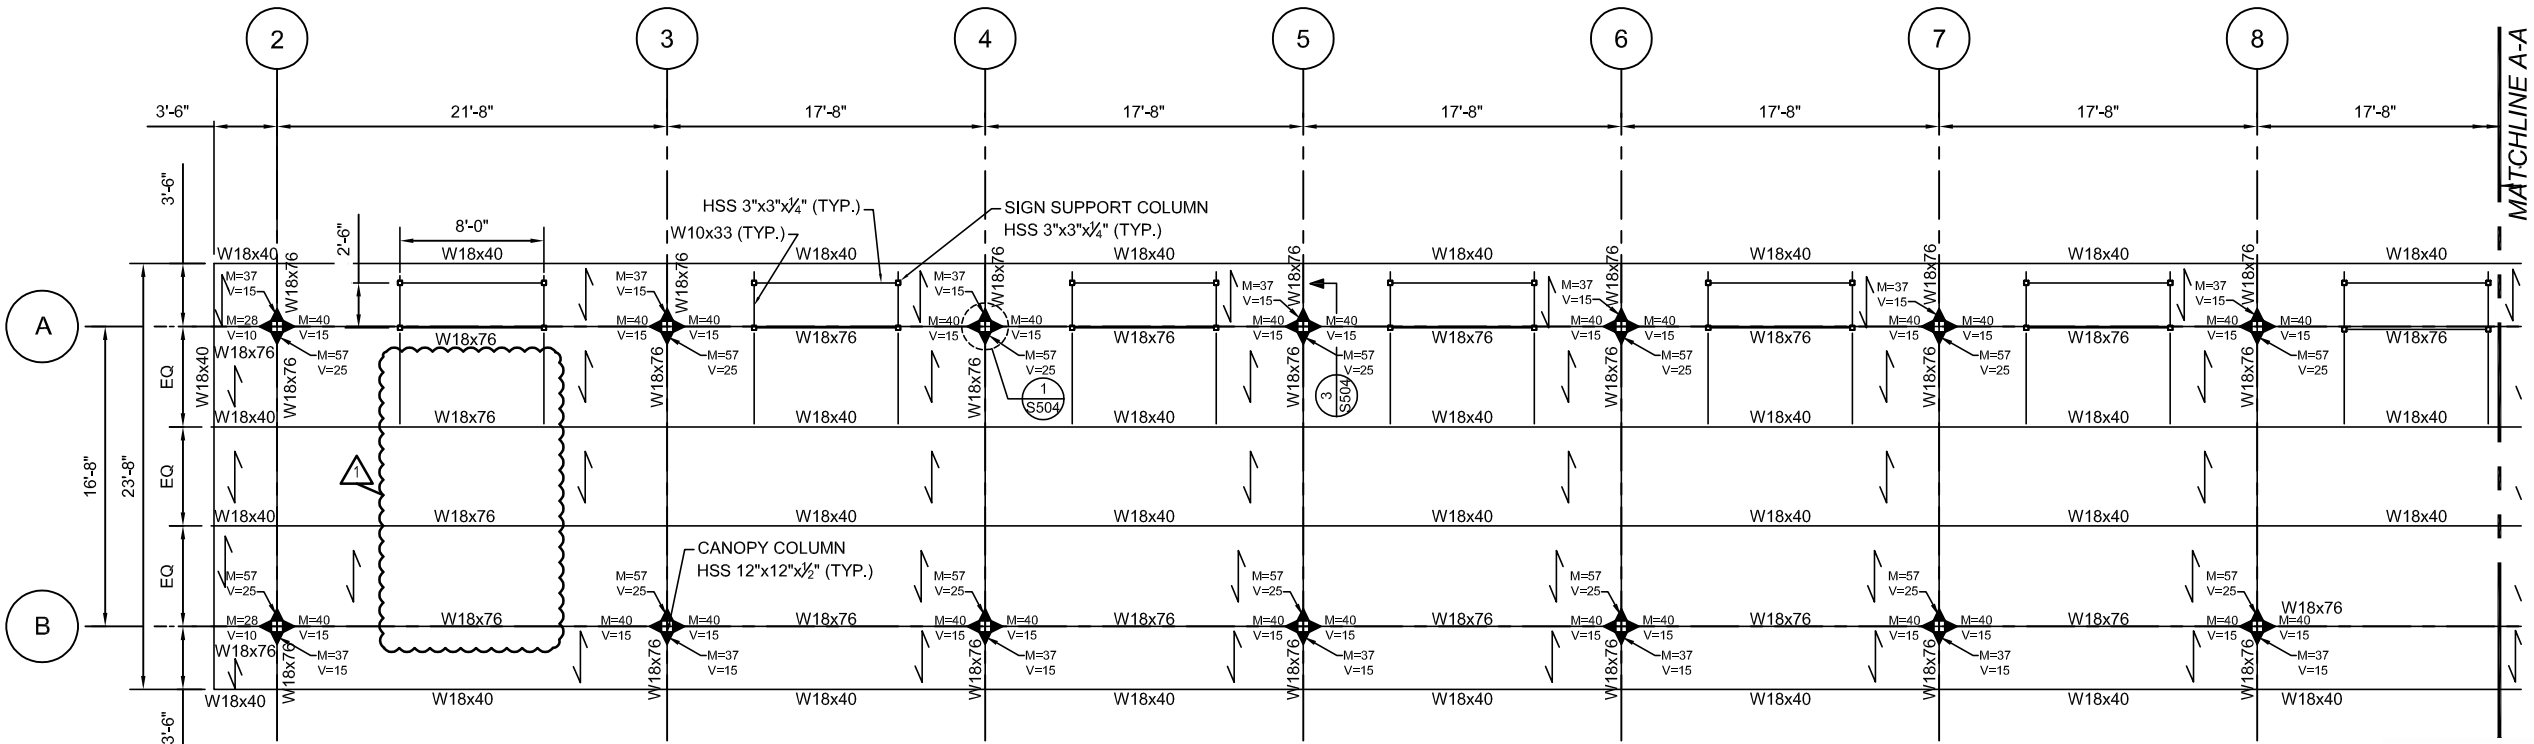

1 TOLL BOOTH CANOPY FRAMING PLAN

S104 SCALE: 3/32" = 1'-0"

- NOTES:
1. REFERENCE GENERAL NOTES AND DRAWING FOR ADDITIONAL INFORMATION REGARDING MOMENT CONNECTION. PROVIDE NUMBER OF BOLTS, PLATES AND ANGLE SIZE AS REQUIRED FOR LOADS INDICATED.
 2. ALL LOAD SHOWN ON FRAMING MEMBERS INDICATE SERVICE (ASD) LOADS.
 3. INDICATES 1 1/2" STEEL ROOF DECK
 4. INDICATES MOMENT CONNECTION
 5. ALL EXPOSED STEEL TO BE GALVANIZED INCLUDING BOLTS, NUTS, ETC.
 6. ALL BOLTS SHALL BE CRITICALLY TIGHTENED.
 7. TOP OF STEEL ELEVATION = 949.5' EXCEPT AS NOTED.

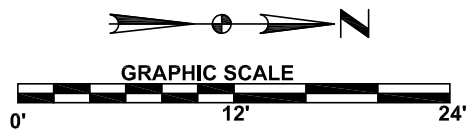

| DESIGN AGENCY | | BY | | DATE | |
|----------------------|--|-----------------|--|---------|--|
| PRIME | | CM | | 5/13/21 | |
| PROJECT 58-21-02 | | REVISIONS | | NO. | |
| DATE: 04-19-2021 | | ADDENDUM NO. 1 | | 1 | |
| S104 | | CHECKED | | CAM | |
| 43 | | DESIGNED | | NN | |
| 236 | | DRAWN | | DPF | |
| CANOPY FRAMING PLANS | | IN CHARGE | | CAM | |
| TOLL PLAZA 211 | | TRUMBULL COUNTY | | | |