


5/12/2021 7:43:31 PM


SECONDARY UTILITY BUILDING SECOND FLOOR PLAN FIRE ALARM

1/16" = 1'-0"

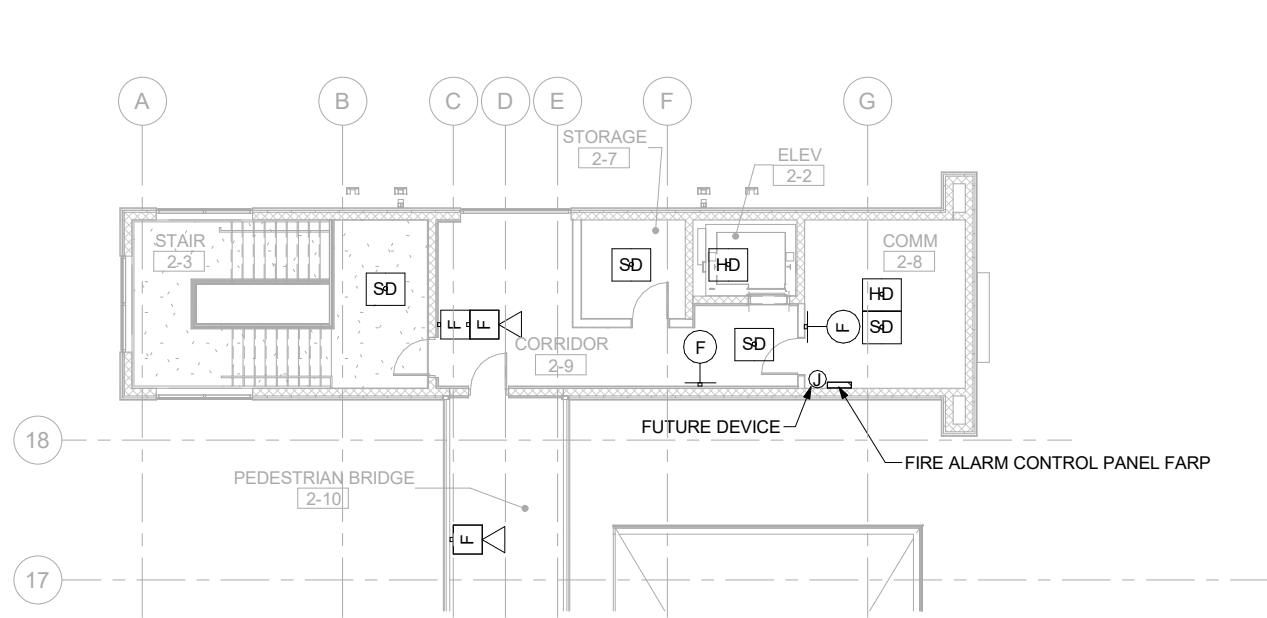


CENTER OF BRIDGE FLOOR PLAN FIRE ALARM

1/16" = 1'-0"

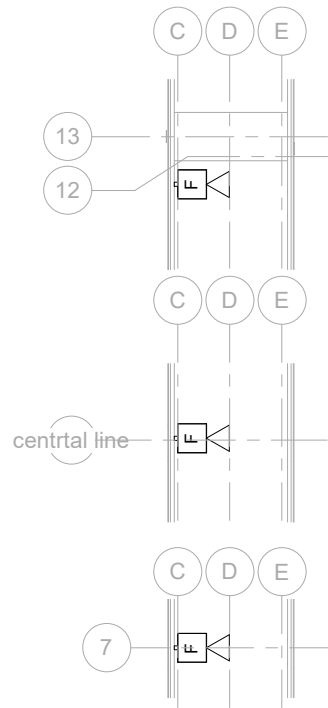


MAIN UTILITY BUILDING SECOND FLOOR PLAN FIRE ALARM

1/16" = 1'-0"

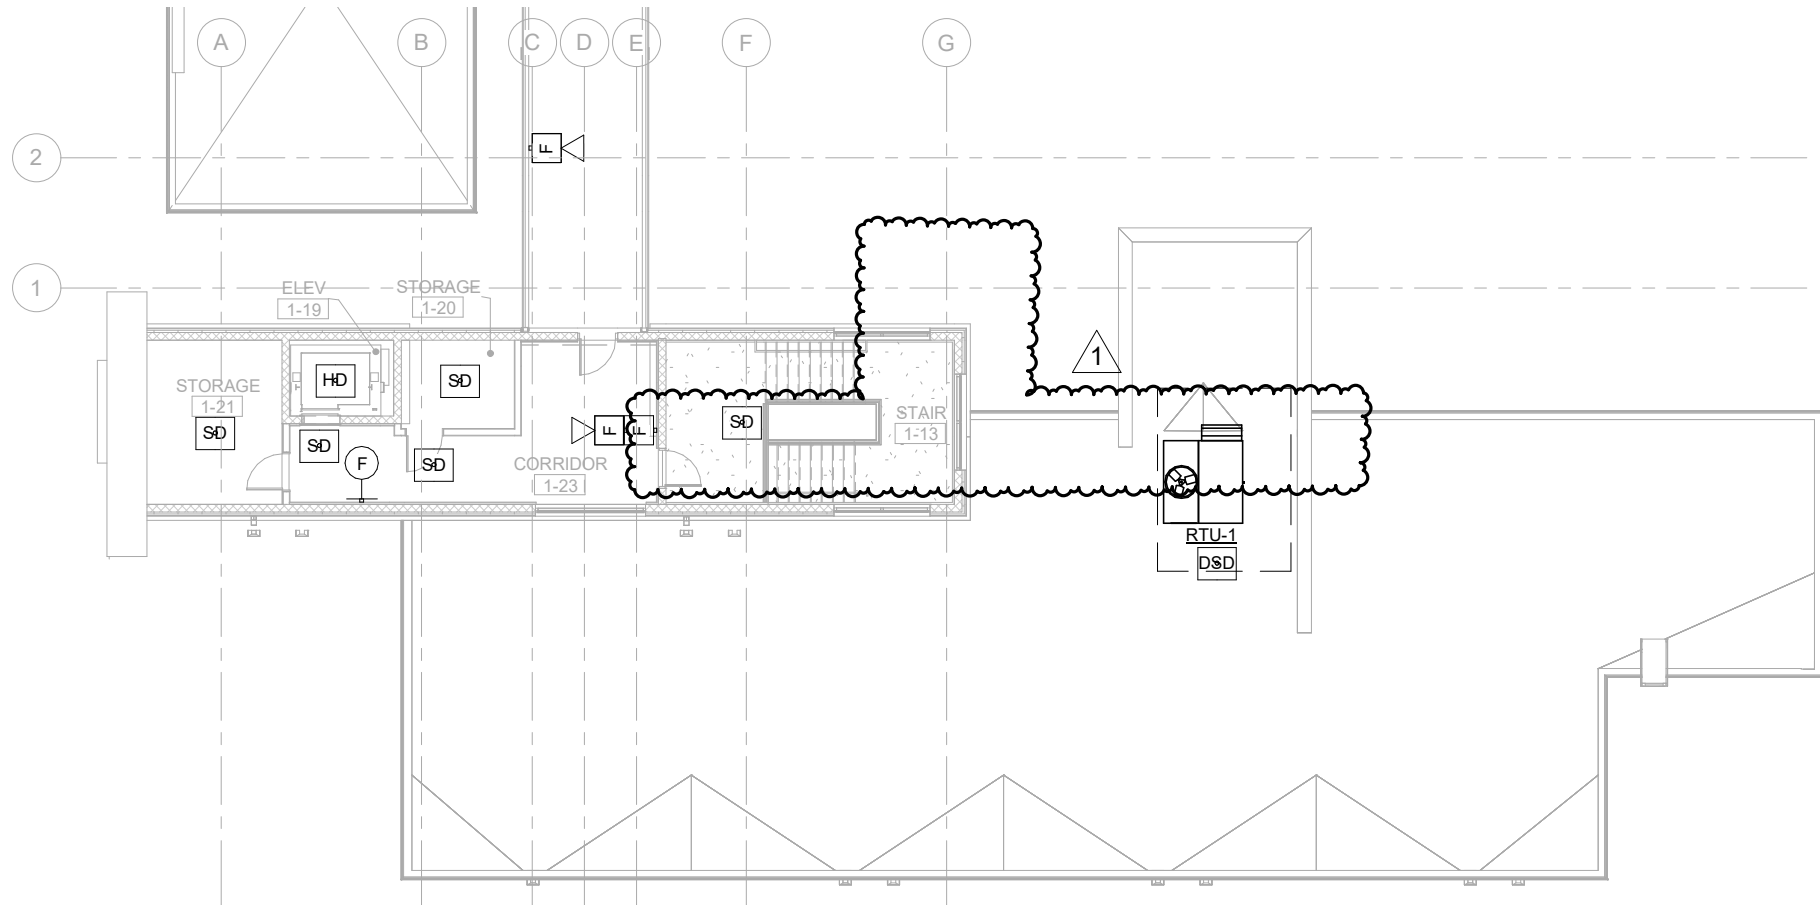

GENERAL NOTES

- BOTH FIRE ALARM HORN/STROBES CLOSEST TO THE DOORS ON THE BRIDGE SHALL BE PLACE 14' 6" AWAY FROM THE DOOR.

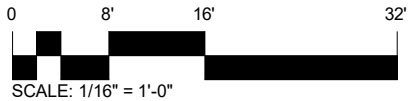

| | | | | | | | | | | | |
|-----------------------------------------|--|------|-----------------------------------------|-------------------------|-----------------|----------------|------------------|-------------------------|----|-------------------|---|
| <div><div>161</div><div>236</div></div> | | E113 | PROJECT 58-21-01 DATE: 4/16/2021 | FIRE ALARM SECOND FLOOR | DESIGNED RNS | CHECKED CEK | NO. 1 | REVISIONS ADDENDUM 1 | BY | DATE 4/30/2021 | DESIGN AGENCY <div><div>PRIMEVA</div><div> 540 White Pond Drive, Ste. E Akron, Ohio 44320 (330)-864-7755</div></div> |
| | | | | | | DRAWN RNS | IN CHARGE CEK | | | | |
| | | | | TOUL PLAZA 211 | TRUMBULL COUNTY | | | | | | |