


4/3/2019 10:19:50 AM

C:\Users\lowm\Documents\My Documents\Prime Projects\18418_TP4 TP48 TP211 TP238 - 18458\TP211\Design\Sheets\3-9_11-12_20-21_TP211_XG001.DWG 5/14/2021 8:50 AM low bowms

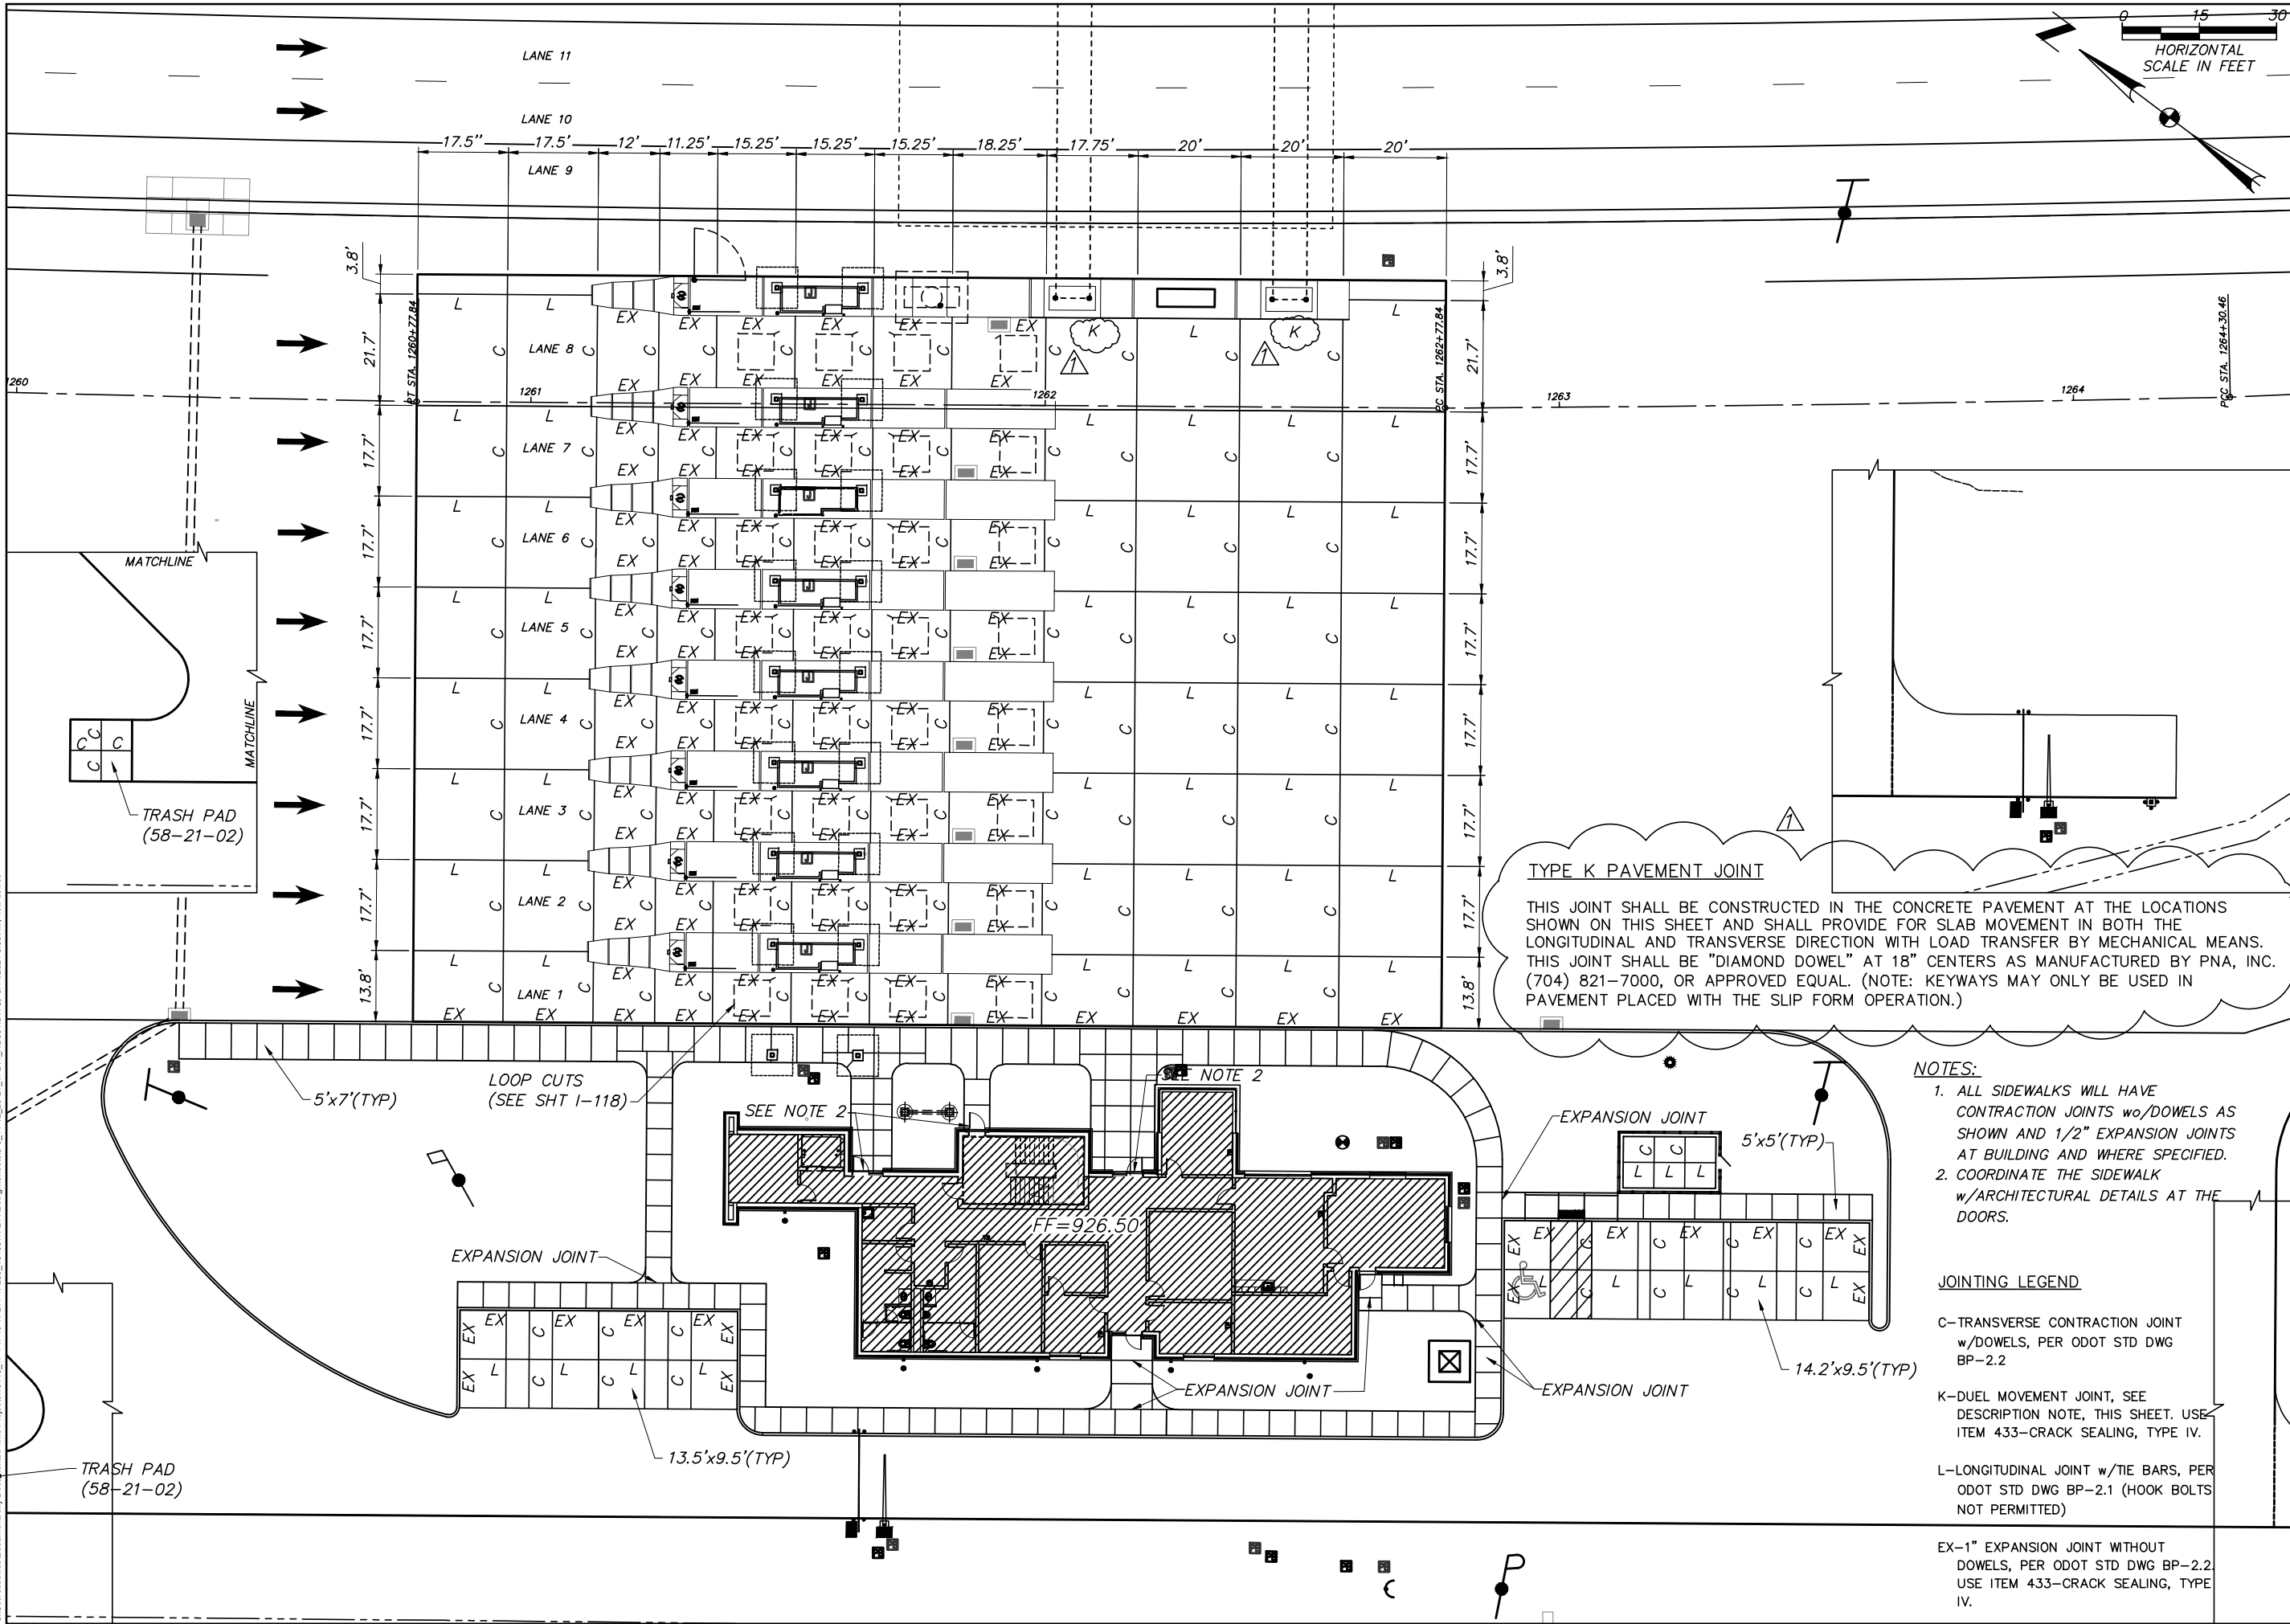

NOTES:

1. ALL SIDEWALKS WILL HAVE CONTRACTION JOINTS w/o DOWELS AS SHOWN AND 1/2" EXPANSION JOINTS AT BUILDING AND WHERE SPECIFIED.
2. COORDINATE THE SIDEWALK w/ARCHITECTURAL DETAILS AT THE DOORS.

JOINING LEGEND

- C-TRANSVERSE CONTRACTION JOINT w/DOWELS, PER ODOT STD DWG BP-2.2
- K-DUEL MOVEMENT JOINT, SEE DESCRIPTION NOTE, THIS SHEET. USE ITEM 433-CRACK SEALING, TYPE IV.
- L-LONGITUDINAL JOINT w/TIE BARS, PER ODOT STD DWG BP-2.1 (HOOK BOLTS NOT PERMITTED)
- EX-1" EXPANSION JOINT WITHOUT DOWELS, PER ODOT STD DWG BP-2.2 USE ITEM 433-CRACK SEALING, TYPE IV.



DESIGN AGENCY		BY	DATE
PRIME		LHB	5-14-21
540 White Pond Drive, Ste. E Westerville, OH 43081 (330) 864-7755			
REVISIONS		NO.	DATE
Addendum 1		1	
CHECKED		SMM	
DESIGNED		LHB	
DRAWN		LHB	
SITE JOINING PLAN - SOUTH SITE		TRUMBULL COUNTY	
PROJECT 58-21-02		TP211	
DATE: 04/19/2021			
C112			
24			
236			