


5/14/2021 8:43:09 AM

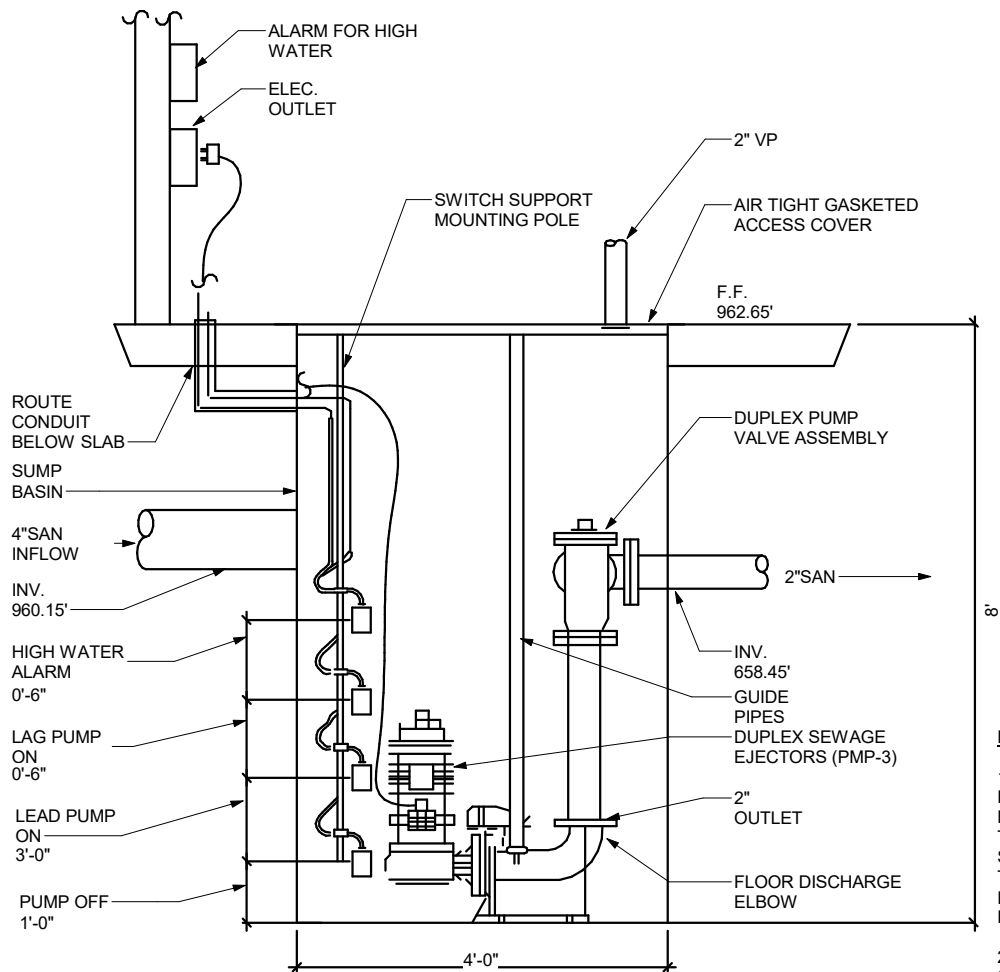


- NOTES:**
1. WHERE EXTERIOR WALL PENETRATIONS OCCUR, PROVIDE MACHINE CUT SLEEVES 2" LARGER THAN THE OUTSIDE DIAMETER OF ASSOCIATED SERVICE PIPE. SEAL OPENING WATER TIGHT WITH MECHANICAL INTERLOCKING RUBBER WATER STOP RATED FOR 20 PSIG.
  2. SEE MANUFACTURER'S MANUAL FOR INFORMATION ON DUPLEX PUMP VALVE ASSEMBLY

### DUPLEX SEWAGE PUMP DETAIL

1  
P401


NONE

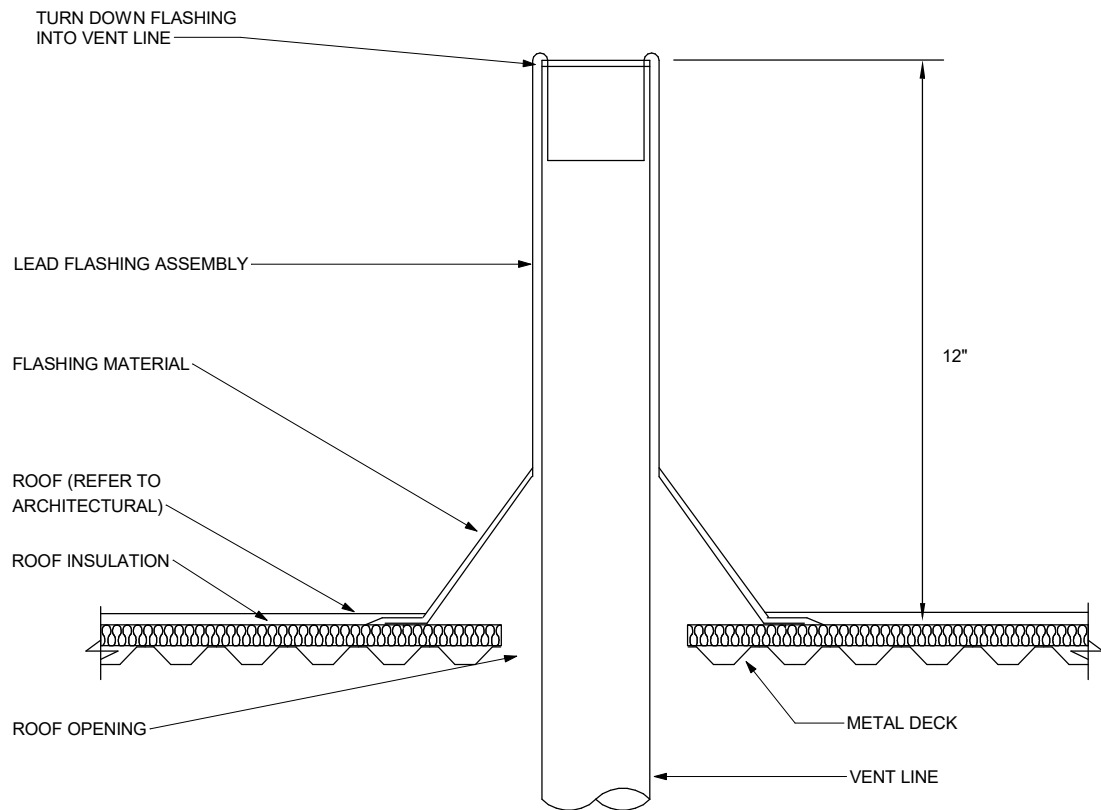

### VENT THROUGH ROOF

NTS


2  
P401

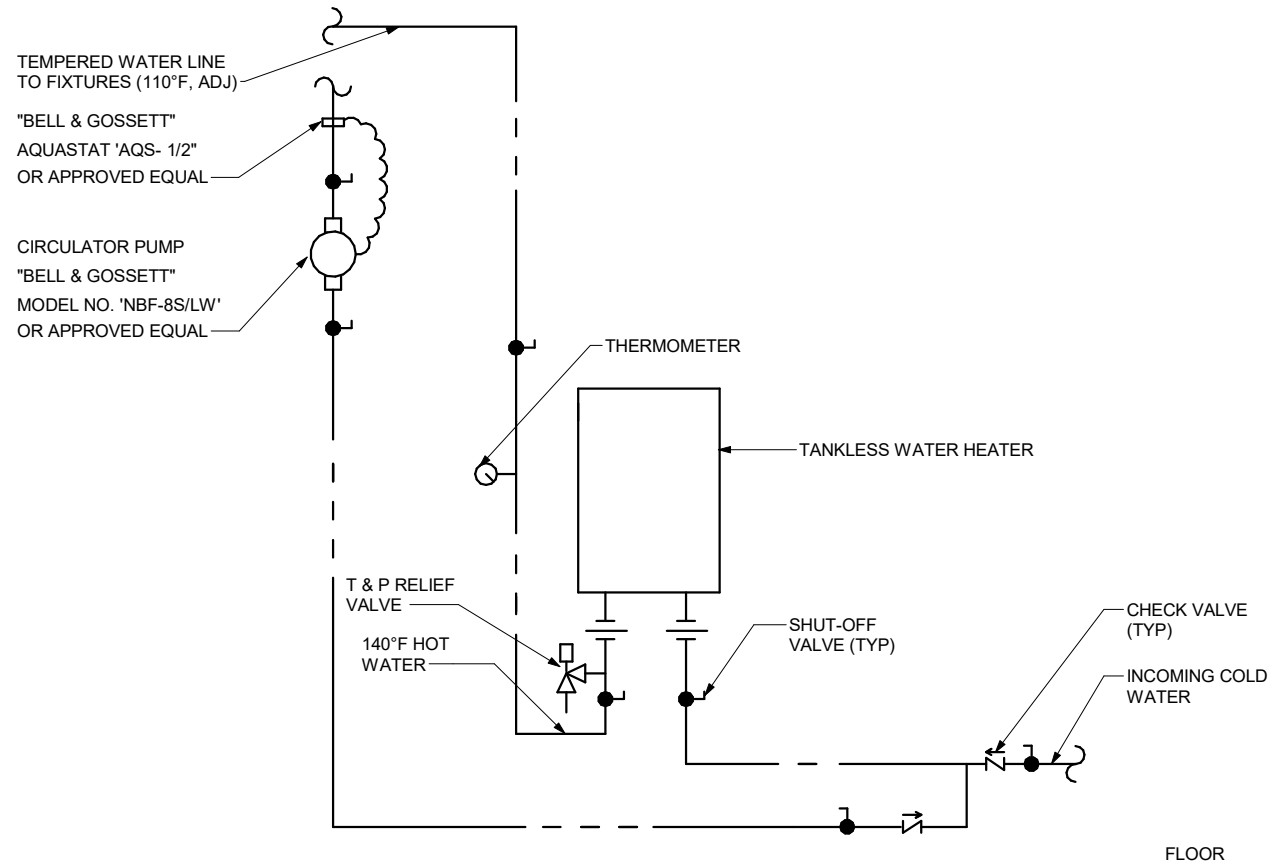

- NOTES:**
1. PROVIDE WITH KIT FOR WALL MOUNTED CONFIGURATION

### TANKLESS WATER HEATER DETAIL

4  
P401

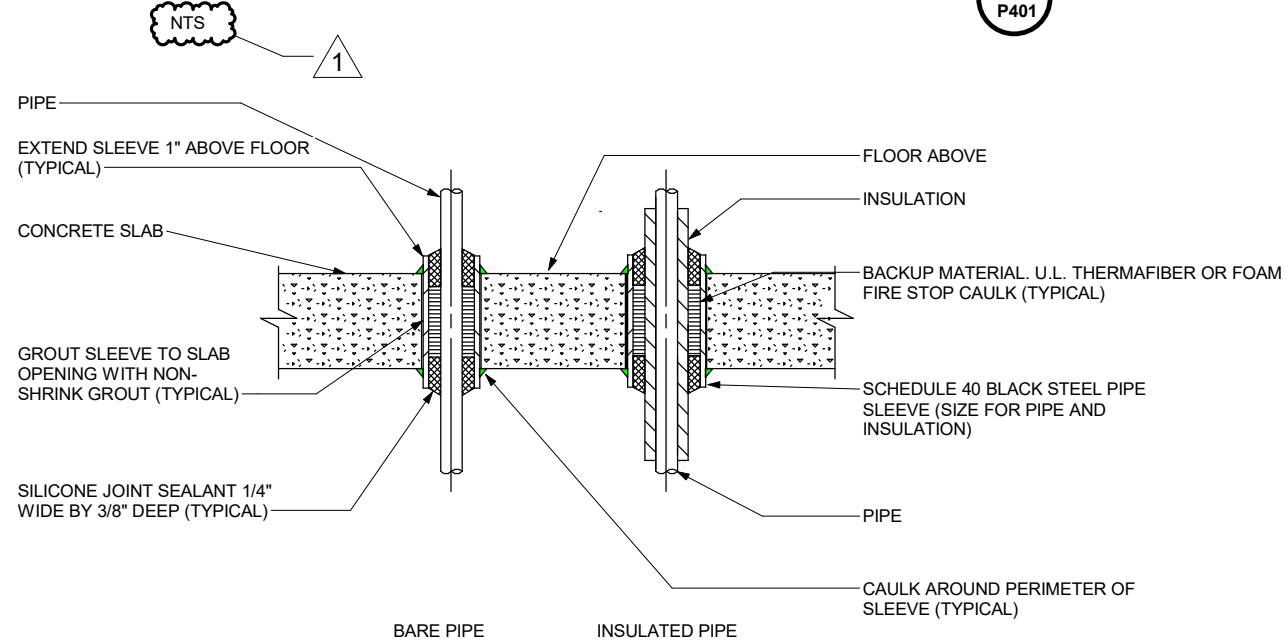

- NOTES:**
1. AT THE CONTRACTORS' OPTION A U.L. LISTED/APPROVED FIRE STOP PIPE SLEEVE ASSEMBLY MAY BE SUBMITTED FOR APPROVAL.
  2. FOR EXISTING FLOOR SLABS, CORE DRILL OR STAR DRILL OPENING THRU EXISTING FLOOR SLAB FOR PIPE SLEEVES AS DIRECTED.
  3. GALVANIZED SLEEVE SHALL BE CAST INTO NEW CONCRETE SLAB POURS.

### PIPE SLEEVE THROUGH CONCRETE SLAB

NTS

3  
P401

DESIGN AGENCY	PRIMEVER	PROJECT	58-21-01	DATE:	4/16/2021	TOLL PLAZA 211	TRUMBULL COUNTY	NO.	1	ADDENDUM	1	BY	JSF	CHECKED	JSF	IN CHARGE	JSF	REVISIONS	1	DATE	5/13/2021	540 White Pond Drive, Ste. E Akron, Ohio 44320 (330) 664-7755	OHIO TURNPIKE