



5/12/2021 7:43:29 PM

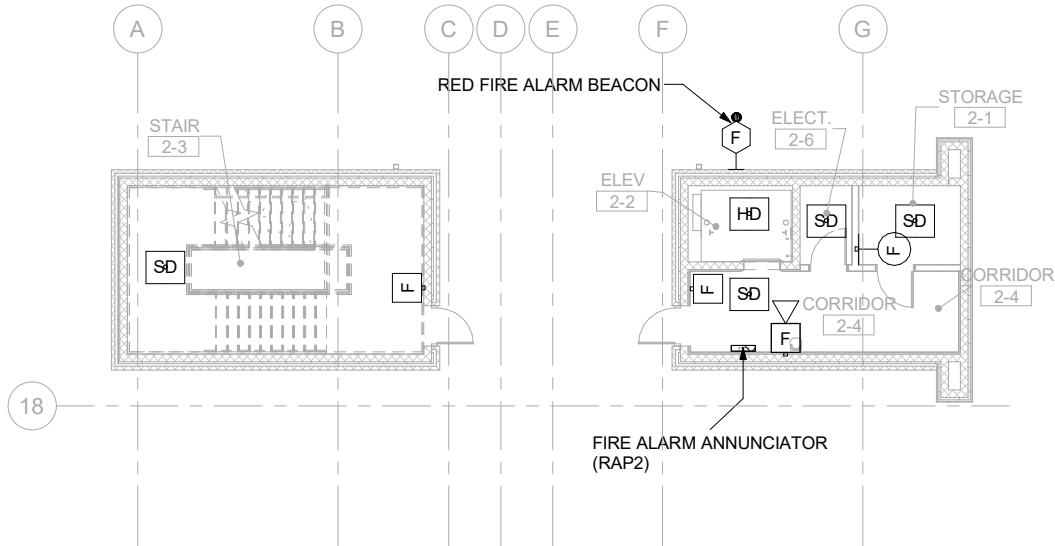

SECONDARY BUILDING FIRST FLOOR FIRE ALARM

1/16" = 1'-0"

2
E112

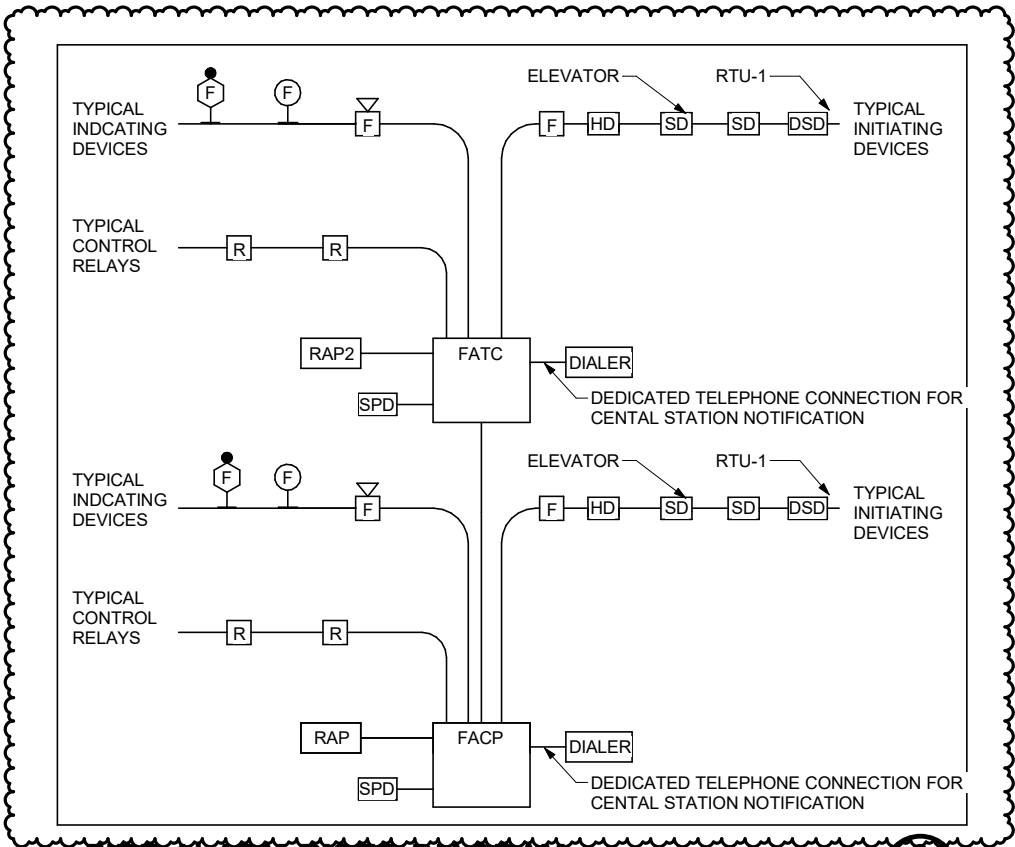


FIRE ALARM RISER DIAGRAM

SCALE: N.T.S.

3
E112

GENERAL NOTES


1. FACP AND FARP SHALL COMMUNICATE TO FUNCTION AS ONE SYSTEM. BOTH PANELS SHALL REPORT ALL TROUBLE SIGNALS AND ALARMS BACK TO THE CENTRAL STATION AT BERE.

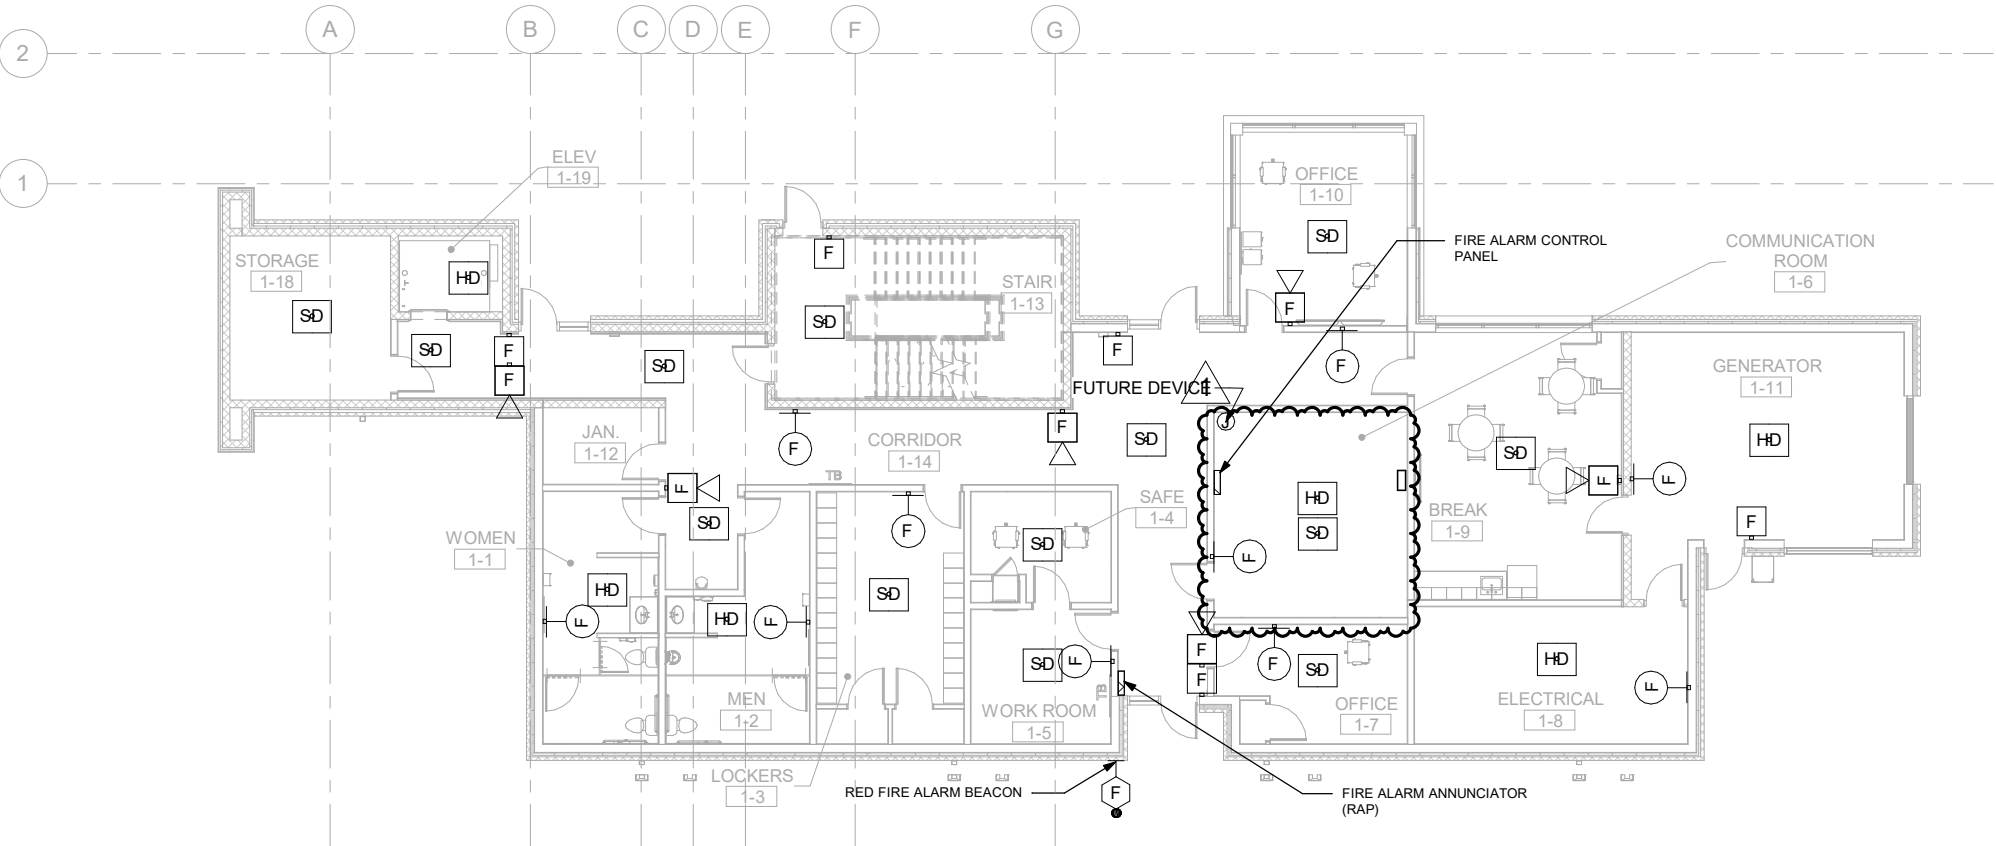

MAIN UTILITY BUILDING FIRST FLOOR POWER PLAN FIRE ALARM

1/16" = 1'-0"

1
E112

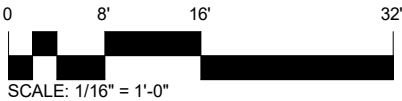

<div><div>160</div><div>236</div></div> <div>E112</div>	PROJECT 58-21-01	FIRE ALARM FIRST FLOOR			DESIGNED			CHECKED			NO.			REVISIONS			BY			DATE			DESIGN AGENCY		
	DATE: 4/16/2021	TOULI PLAZA 211 TRIUMBUILL COUNTY			RNS			CEK			1			ADDENDUM 1									<div><div>PRIME</div><div>540 White Pond Drive, Ste E Akron, Ohio 44320 (330)-864-7755</div></div>		
					DRAWN			IN CHARGE																	
					RNS			CEK																	