08350_GP001.dwg; 10/03/20 - 2:57pm

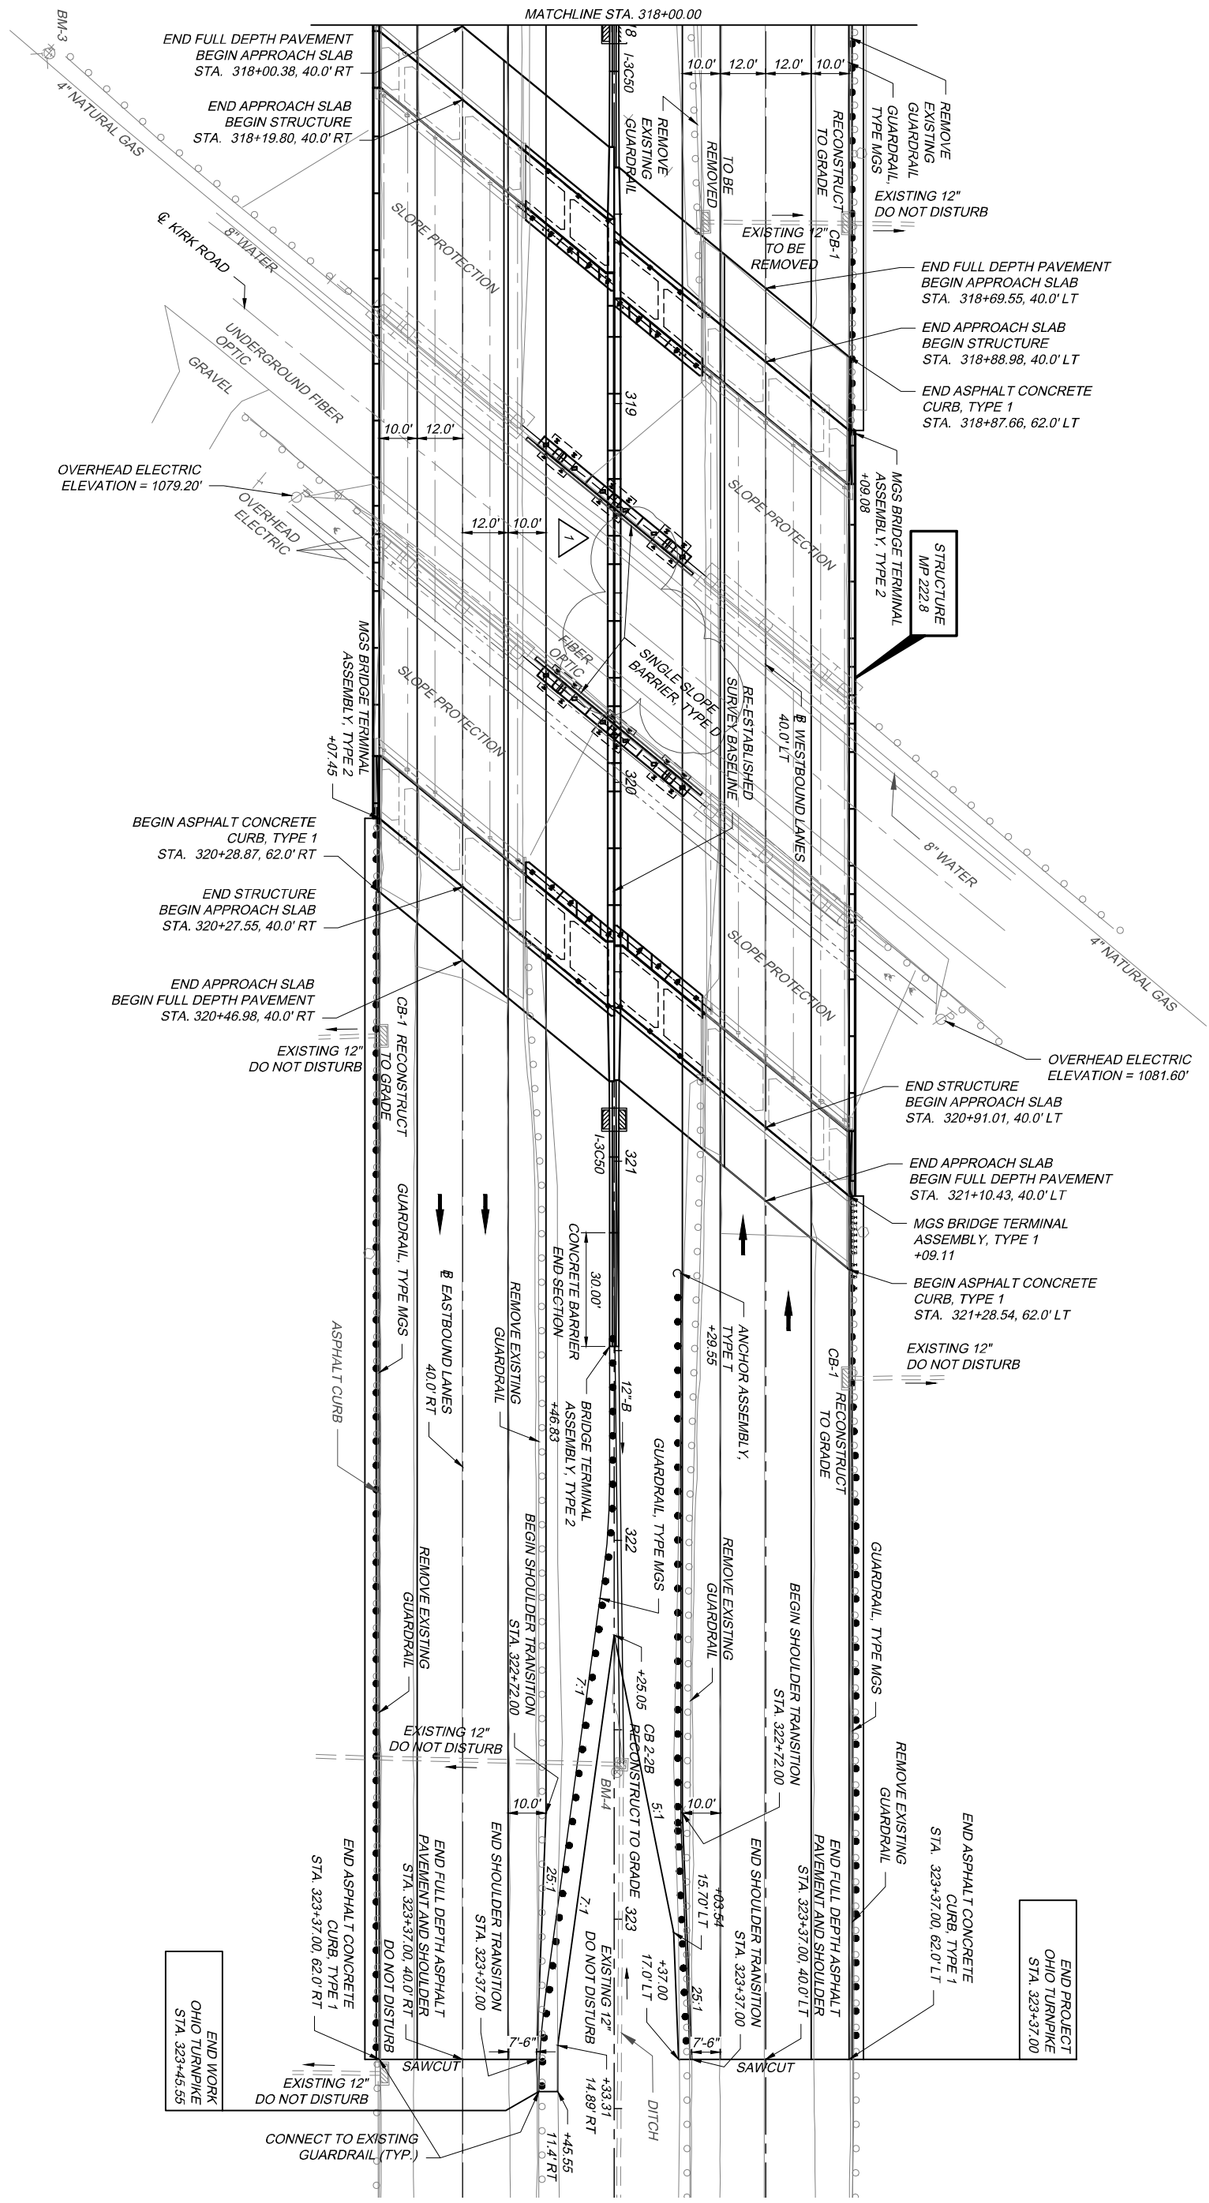

24 / 105	PROJECT 43-20-03	ROADWAY PLAN	DESIGNED JAP	CHECKED HRB	NO.	REVISIONS	BY	DATE	DESIGN AGENCY
	DATE: 07/2019	STA. 318+00 TO STA. 323+45.55	DRAWN JDK	IN CHARGE HRB	1	ADDENDUM 5	JAP	10/20	ms consultants, inc.
					-	-	-	-	2221 Schrock Road Columbus, Ohio 43229
					-	-	-	-	

OHIO TURNPIKE AND INFRASTRUCTURE COMMISSION