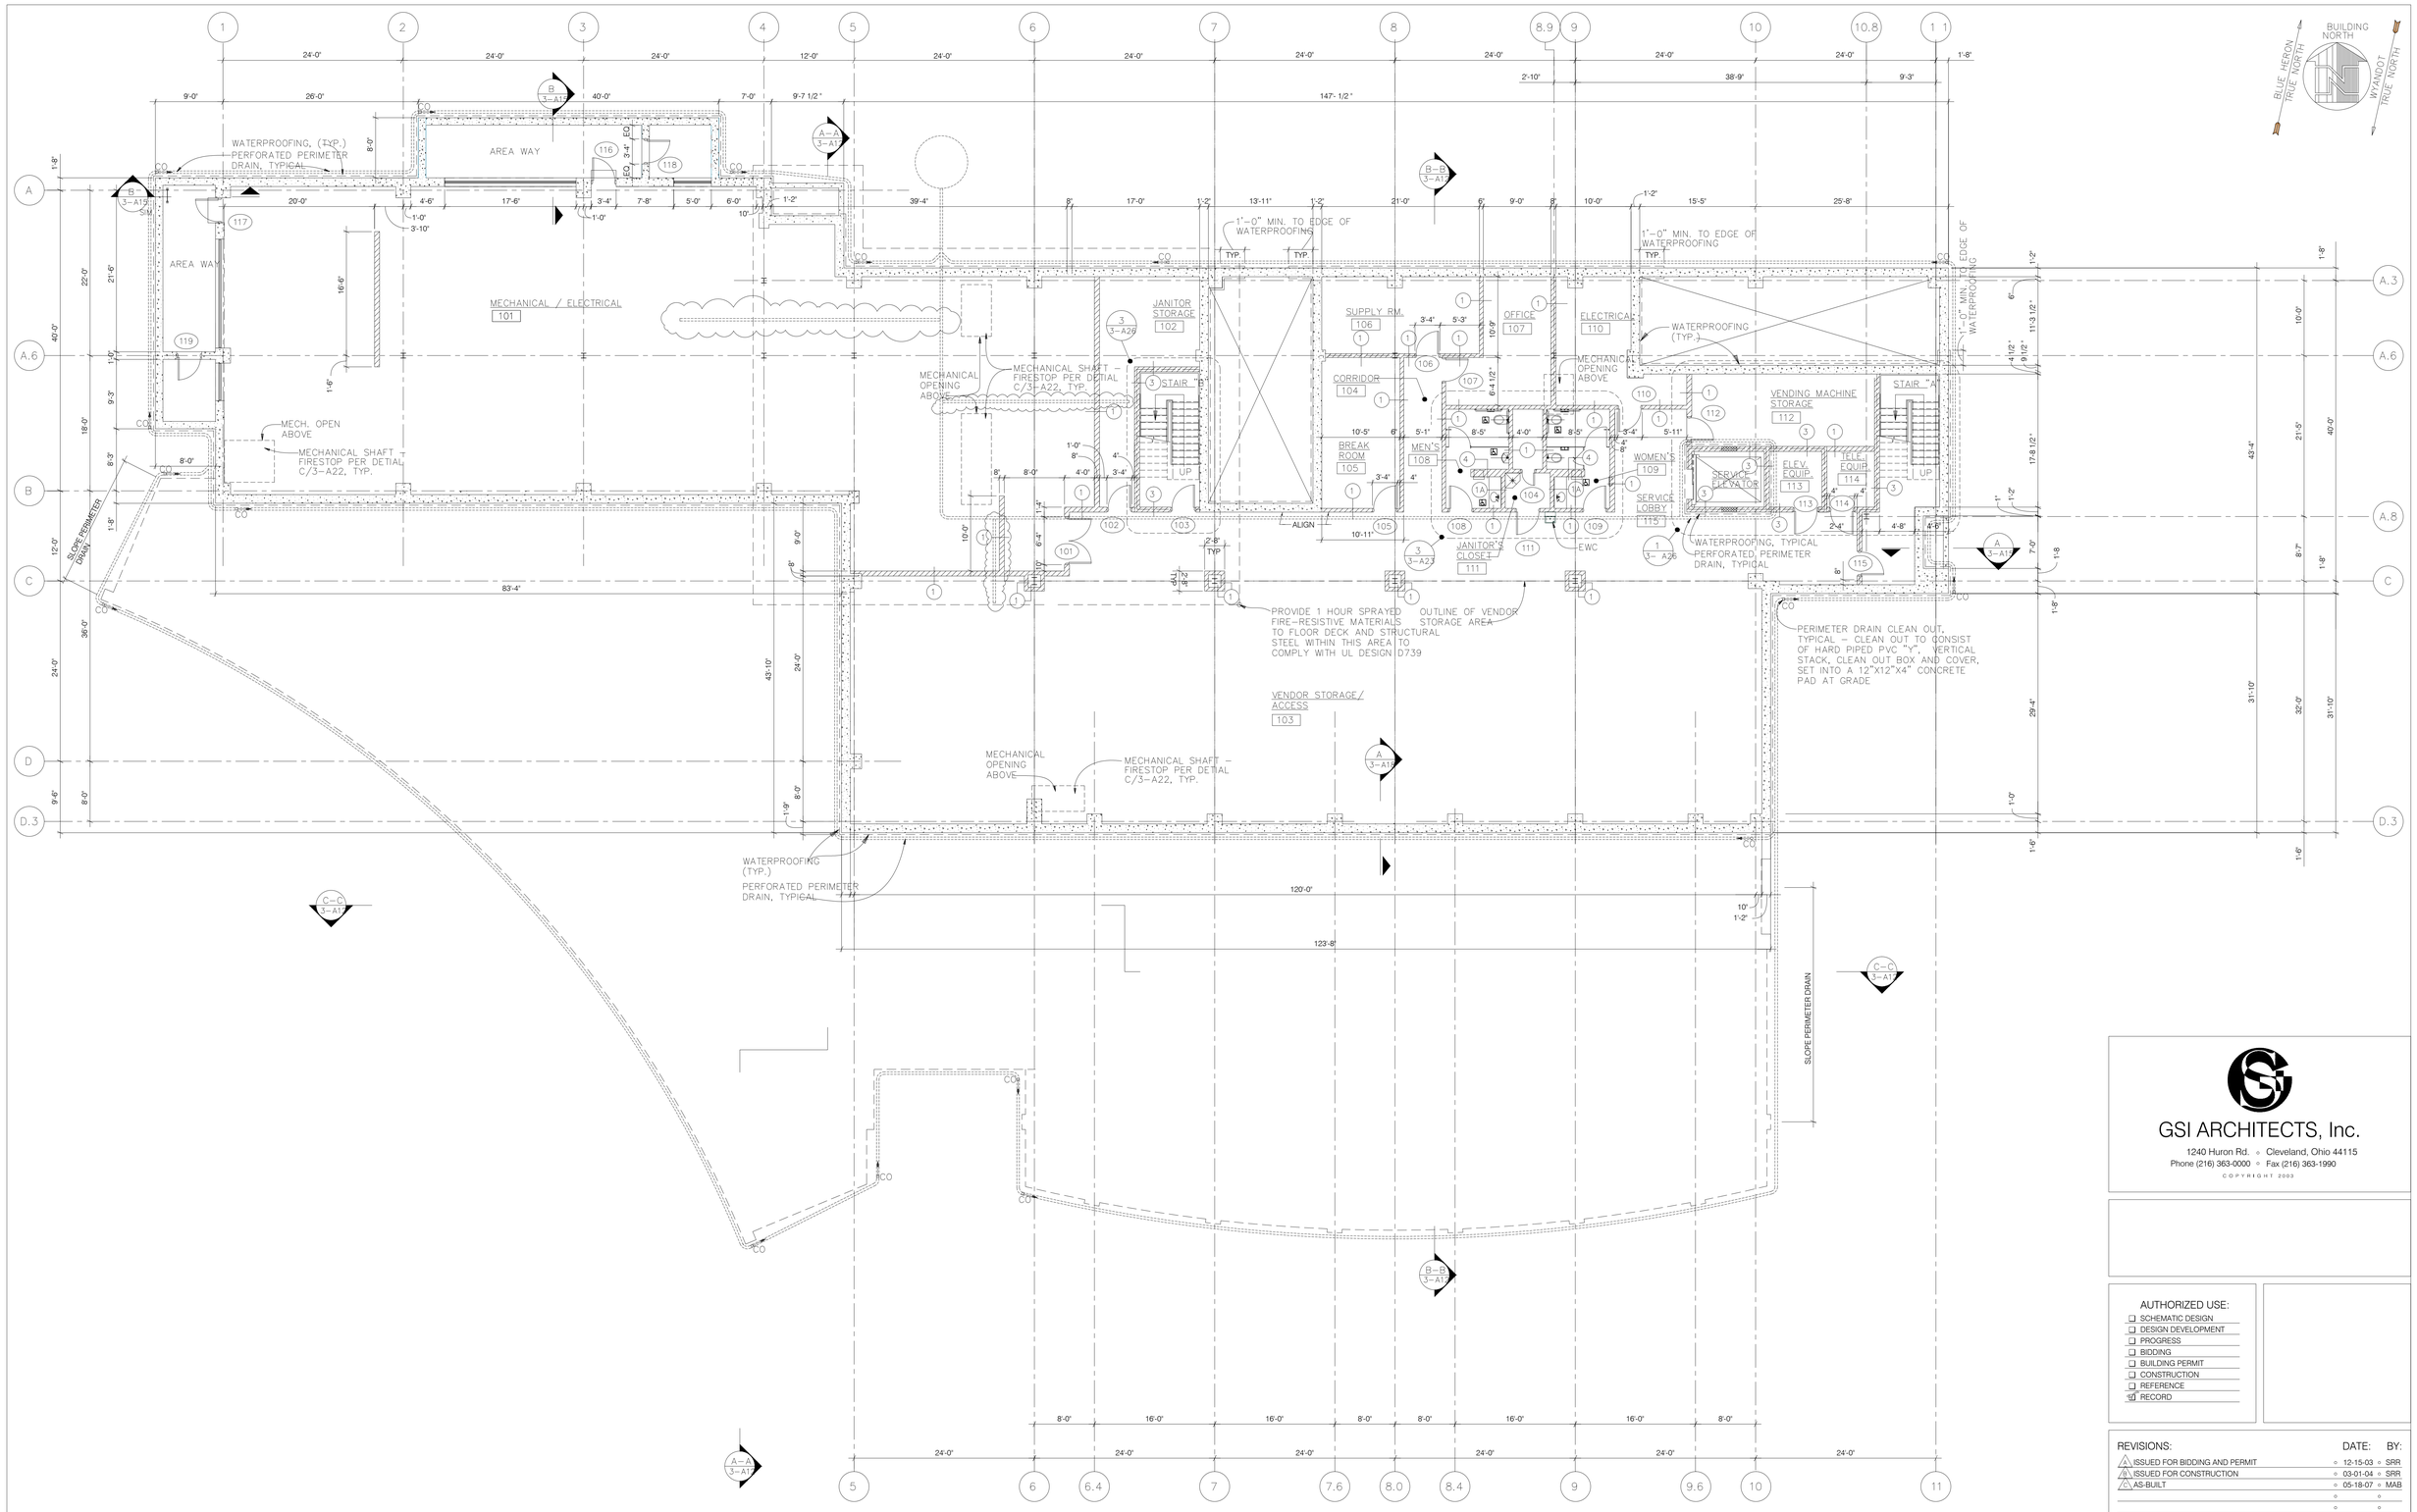

STANDARD ARCHITECTURAL WALL TYPES

TYPE	WALL COMPOSITION
1	6" OR 8" CONCRETE MASONRY UNITS, TO UNDERSIDE OF ROOF DECK OR FLOOR SLAB, RUNNING BOND. SEE 14 / 3-A19 FOR TOP OF WALL DETAIL.
1A	6" OR 8" CONCRETE MASONRY UNITS, TO 6" ABOVE CEILING, RUNNING BOND.
2	ONE (1) LAYER OF 5 / 8" GYPSUM BOARD ON 7 / 8" METAL "HAT" CHANNELS AT 16" O/C ON ONE (1) SIDE OF 8" CONCRETE MASONRY UNITS, FROM FINISH FLOOR TO 6" ABOVE FINISH CEILING. CONCRETE MASONRY UNITS TO UNDERSIDE OF STRUCTURE ABOVE. SEE 15/3-A19 FOR TOP OF WALL DETAIL (1 HOUR RATED WALL - U.L. DESIGN NO. U905).
3	8" CONCRETE MASONRY UNITS, TO UNDERSIDE OF ROOF DECK OR FLOOR SLAB, RUNNING BOND. SEE 15 / A-19 FOR TOP OF WALL DETAIL. (1 HOUR RATED WALL - U.L. DESIGN NO. U905)
4	12" CONCRETE MASONRY UNITS, TO 6" ABOVE CEILING, RUNNING BOND.
5	NOT USED.
6	ONE (1) LAYER OF 5 / 8" GYPSUM BOARD EACH SIDE OF 3 5 / 8" METAL STUDS AT 16" O/C, FROM FINISH FLOOR TO UNDERSIDE OF STRUCTURE ABOVE. INSTALL DEFLECTION TRACK PER FLEXIBLE TRACK DETAIL 2/3-A38.
7	ONE (1) LAYER OF 5 / 8" GYPSUM BOARD EACH SIDE OF 3 5 / 8" METAL STUDS AT 16" O/C, WITH SOUND ATTENUATION BATTS, FROM FINISH FLOOR TO UNDERSIDE OF STRUCTURE ABOVE. INSTALL DEFLECTION TRACK PER FLEXIBLE TRACK DETAIL 2/3-A38.
8	ONE (1) LAYER OF 5/8" GYPSUM BOARD ON 3 5/8" METAL STUDS @ 8" O/C ON THE (1) SIDE OF 8" CONCRETE MASONRY UNITS, FROM FINISH FLR. TO 6" ABOVE FINISH CEILING. CONCRETED MASONRY UNITS TO UNDERSIDE OF STRUCTURE ABOVE. SEE 15/A-19 FOR TOP OF WALL DETAIL (1 HOUR RATED WALL U.L. DESIGN NO. u905)
9	ONE (1) LAYER OF 5 / 8" GYPSUM BOARD EACH SIDE OF 3 5 / 8" METAL STUDS AT 16" O/C, FROM FINISH FLOOR TO 6" ABOVE FINISH CEILING.
10	ONE (1) LAYER OF 5 / 8" GYPSUM BOARD EACH SIDE OF 3 5 / 8" METAL STUDS AT 16" O/C WITH SOUND ATTENUATION BATTS, FROM FINISH FLOOR TO 6" ABOVE FINISH CEILING.
11	ONE (1) LAYER OF 5 / 8" GYPSUM BOARD ON ONE (1) SIDE OF 3 5 / 8" METAL STUDS AT 16" O/C, FROM FINISH FLOOR TO 6" ABOVE FINISH CEILING.
12	ONE (1) LAYER OF 5 / 8" GYPSUM BOARD ON ONE (1) SIDE OF 3 5 / 8" METAL STUDS AT 16" O/C WITH SOUND ATTENUATION BATTS, FROM FINISH FLOOR TO STRUCTURE ABOVE. INSTALL DEFLECTION TRACK PER FLEXIBLE TRACK DETAIL 2/3-A38
13	ONE (1) LAYER OF 5 / 8" GYPSUM BOARD ON 7 / 8" METAL "HAT" CHANNELS AT 16" O/C ON ONE (1) SIDE OF 8" CONCRETE MASONRY UNITS, FROM FINISH FLOOR TO 6" ABOVE FINISH CEILING. CONCRETE MASONRY UNITS TO UNDERSIDE OF STRUCTURE ABOVE.

NOTE A: CEMENT BACKER BOARD TO BE USED IN LIEU OF GYPSUM BOARD FOR ALL TILE INSTALLATIONS (TYPICAL)

NOTE B: REFER TO SPECIFICATION FOR MOISTURE RESISTANT GYPSUM BOARD REQUIREMENTS IN WET AREAS NOT COVERED BY TILE

NOTE C: ZZZZ INDICATES 1 HOUR RATED WALL CONSTRUCTION

GSI ARCHITECTS, Inc.
1240 Huron Rd. ◇ Cleveland, Ohio 44115
Phone (216) 363-0000 ◇ Fax (216) 363-1990

COPYRIGHT 2003

AUTHORIZED USE:
- ☐ SCHEMATIC DESIGN
- ☐ DESIGN DEVELOPMENT
- ☐ PROGRESS
- ☐ BIDDING
- ☐ BUILDING PERMIT
- ☐ CONSTRUCTION
- ☐ REFERENCE
- ☑ RECORD

REVISIONS:	DATE:	BY:
A ISSUED FOR BIDDING AND PERMIT	12-15-03	SRR
B ISSUED FOR CONSTRUCTION	03-01-04	SRR
C AS-BUILT	05-18-07	MAB

PREPARED FOR:
OHIO TURNPIKE COMMISSION

DRAWING TITLE:
BASEMENT FLOOR PLAN
BLUE HERON / WYANDOT

SERVICE PLAZA 3

DWG. NO. 3-A1 OF

ISSUE: C

DATE: 12-15-03 BY: JLR
SCALE: 1 / 8" = 1'-0"
OTC CONTRACT #: 53-03-01 & 02
GSI CONTRACT #: 03-510

FILE NAME: 510-3A001.DGN